



PLAN  
 DATE FROM ALL UP TO DATE  
 DRAWN BY  
 CHECKED BY  
 APPROVED BY

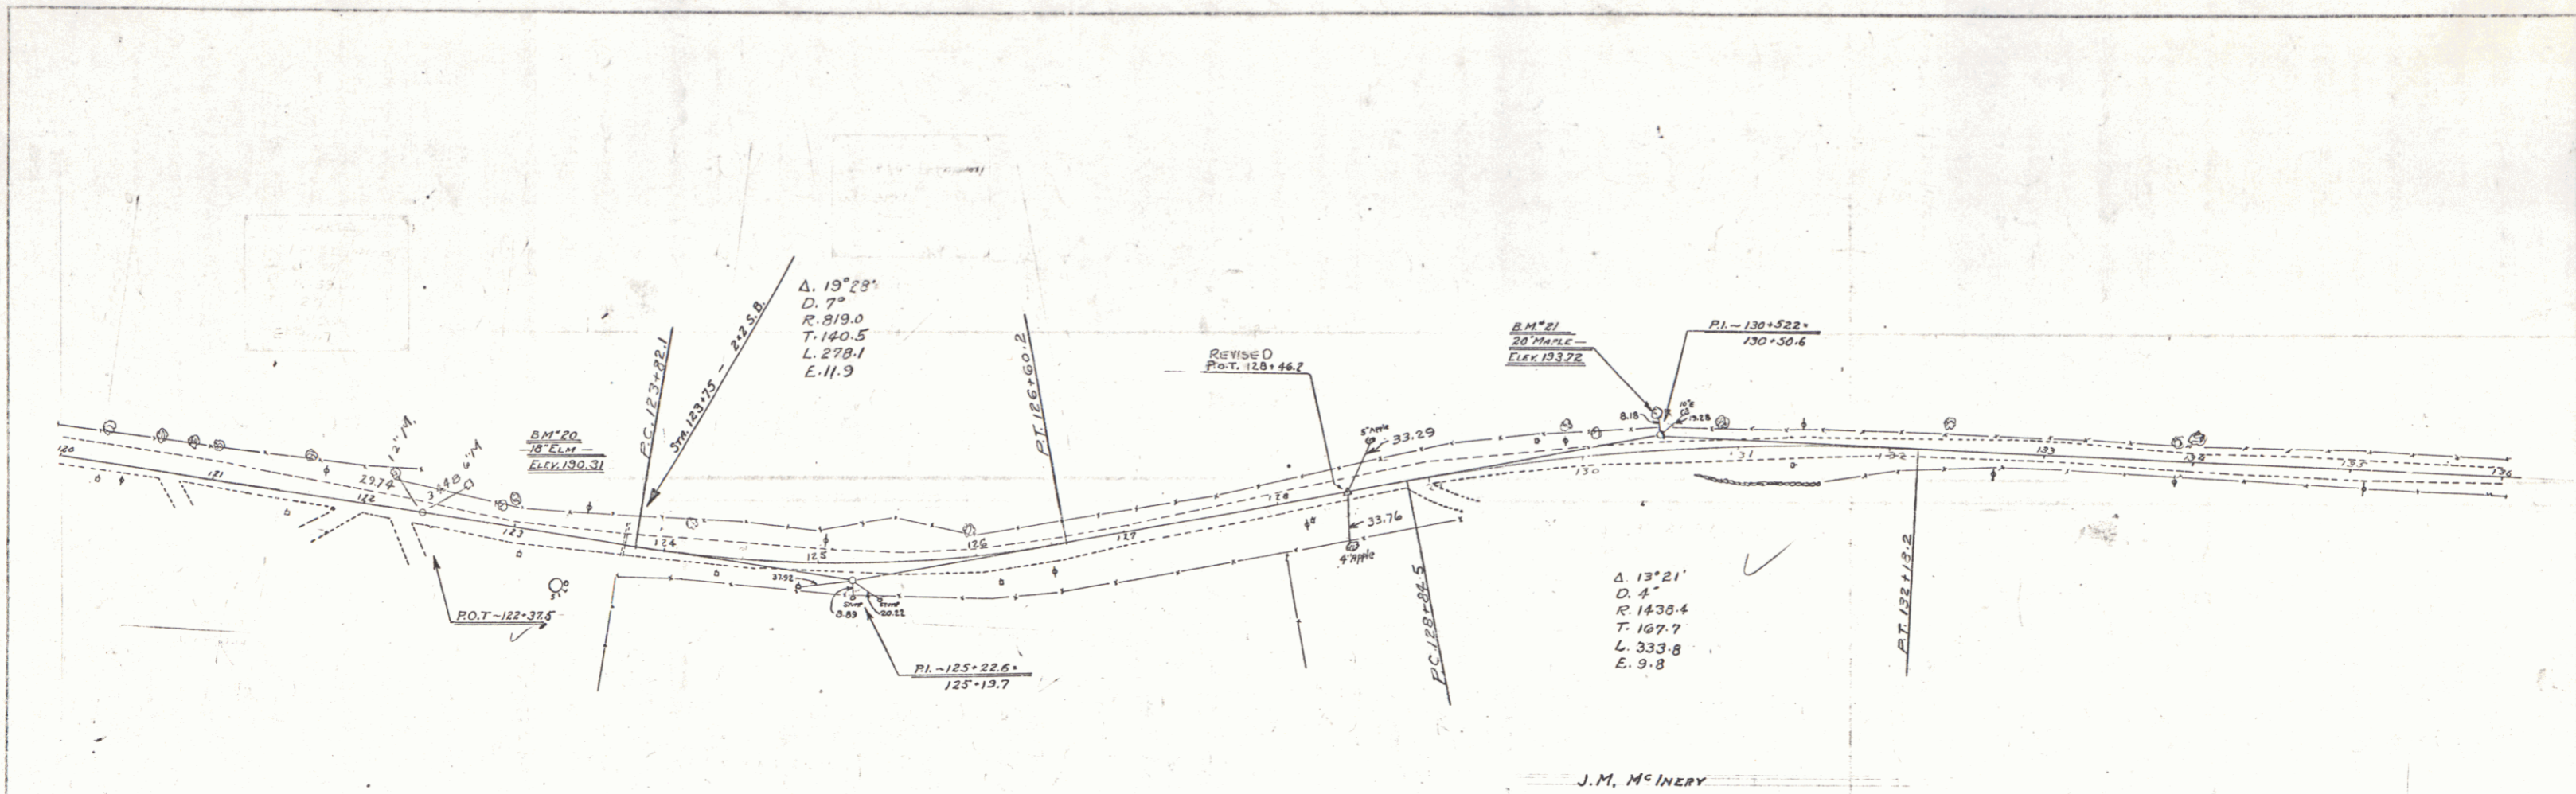

J. M. McINERY

FILE  
 5-1057  
 DATE FROM ALL UP TO DATE  
 DRAWN BY  
 CHECKED BY  
 APPROVED BY

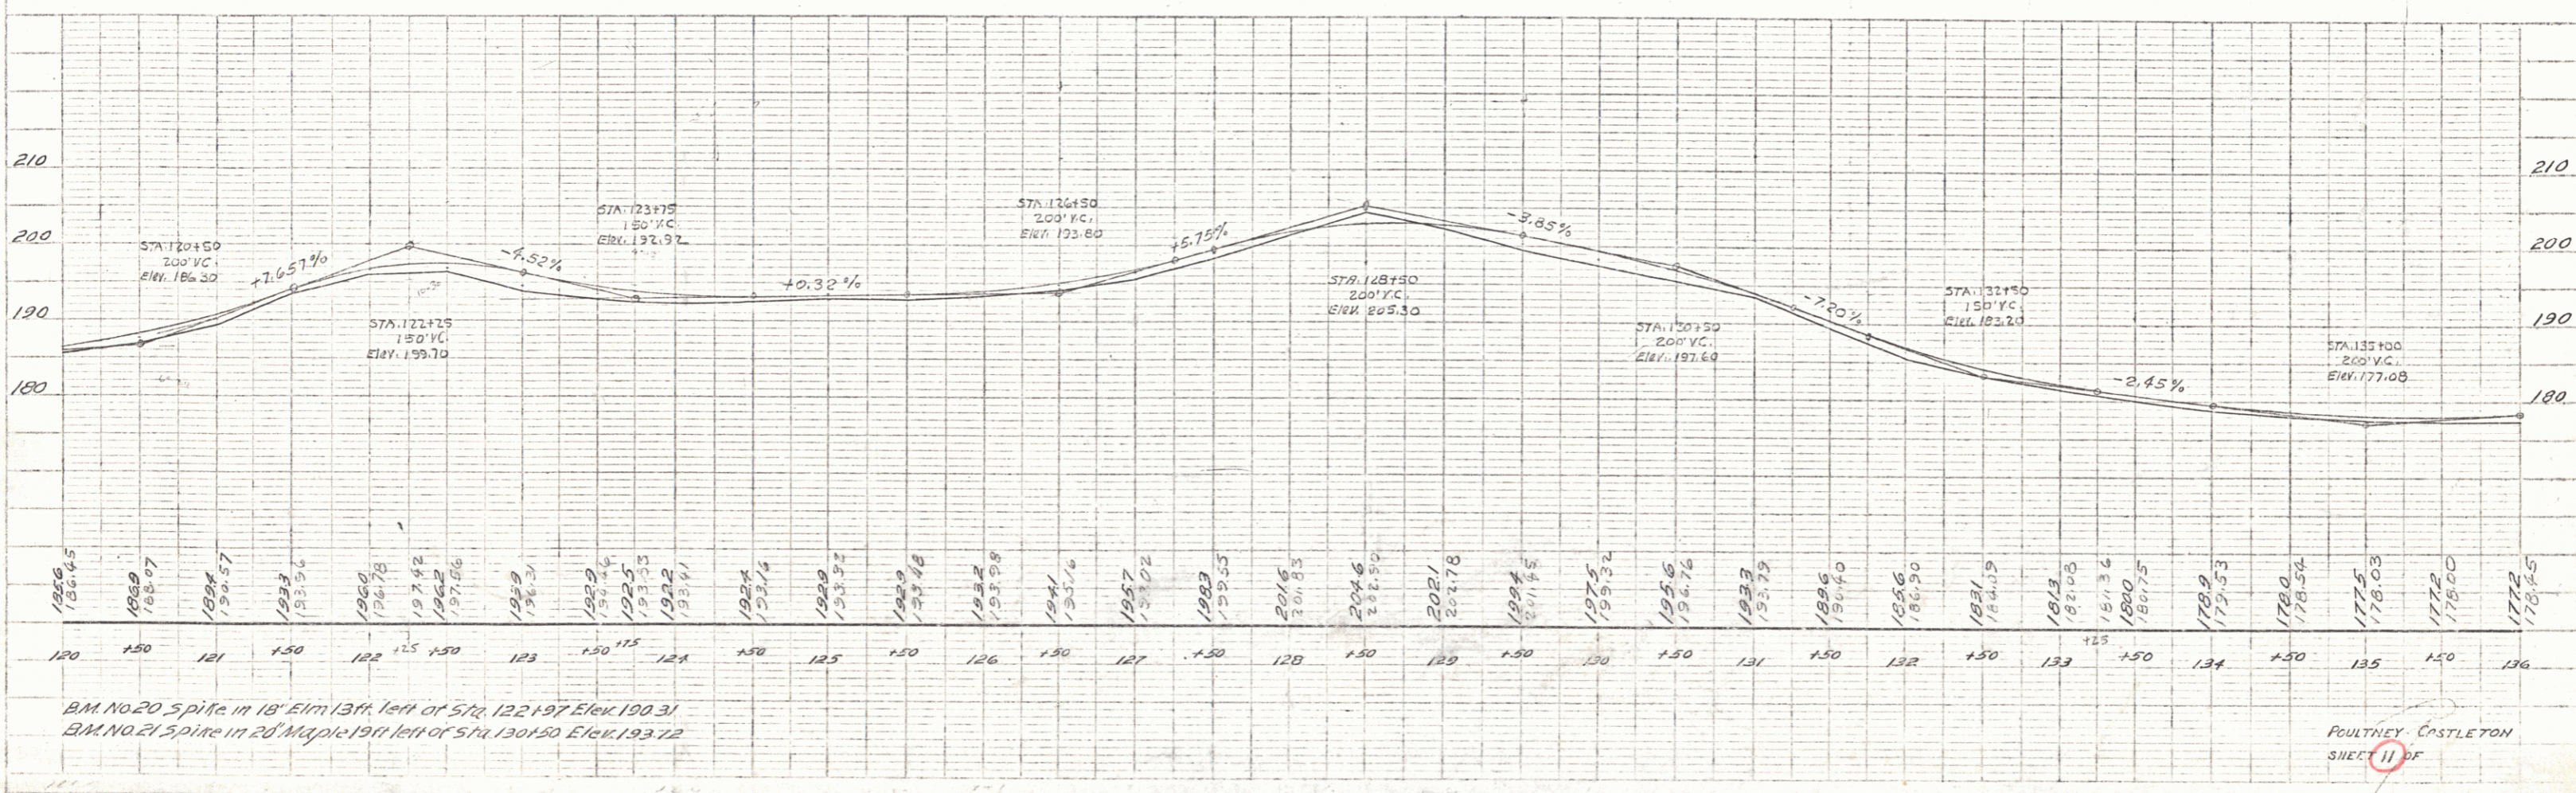

BM No 20 spike in 18" Elm 13ft left of Sta 122+97 Elev 190.31  
 BM No 21 spike in 20" Maple 19ft left of Sta 130+50 Elev 193.72

POULTNEY - CASTLETON  
 SHEET 11 OF