
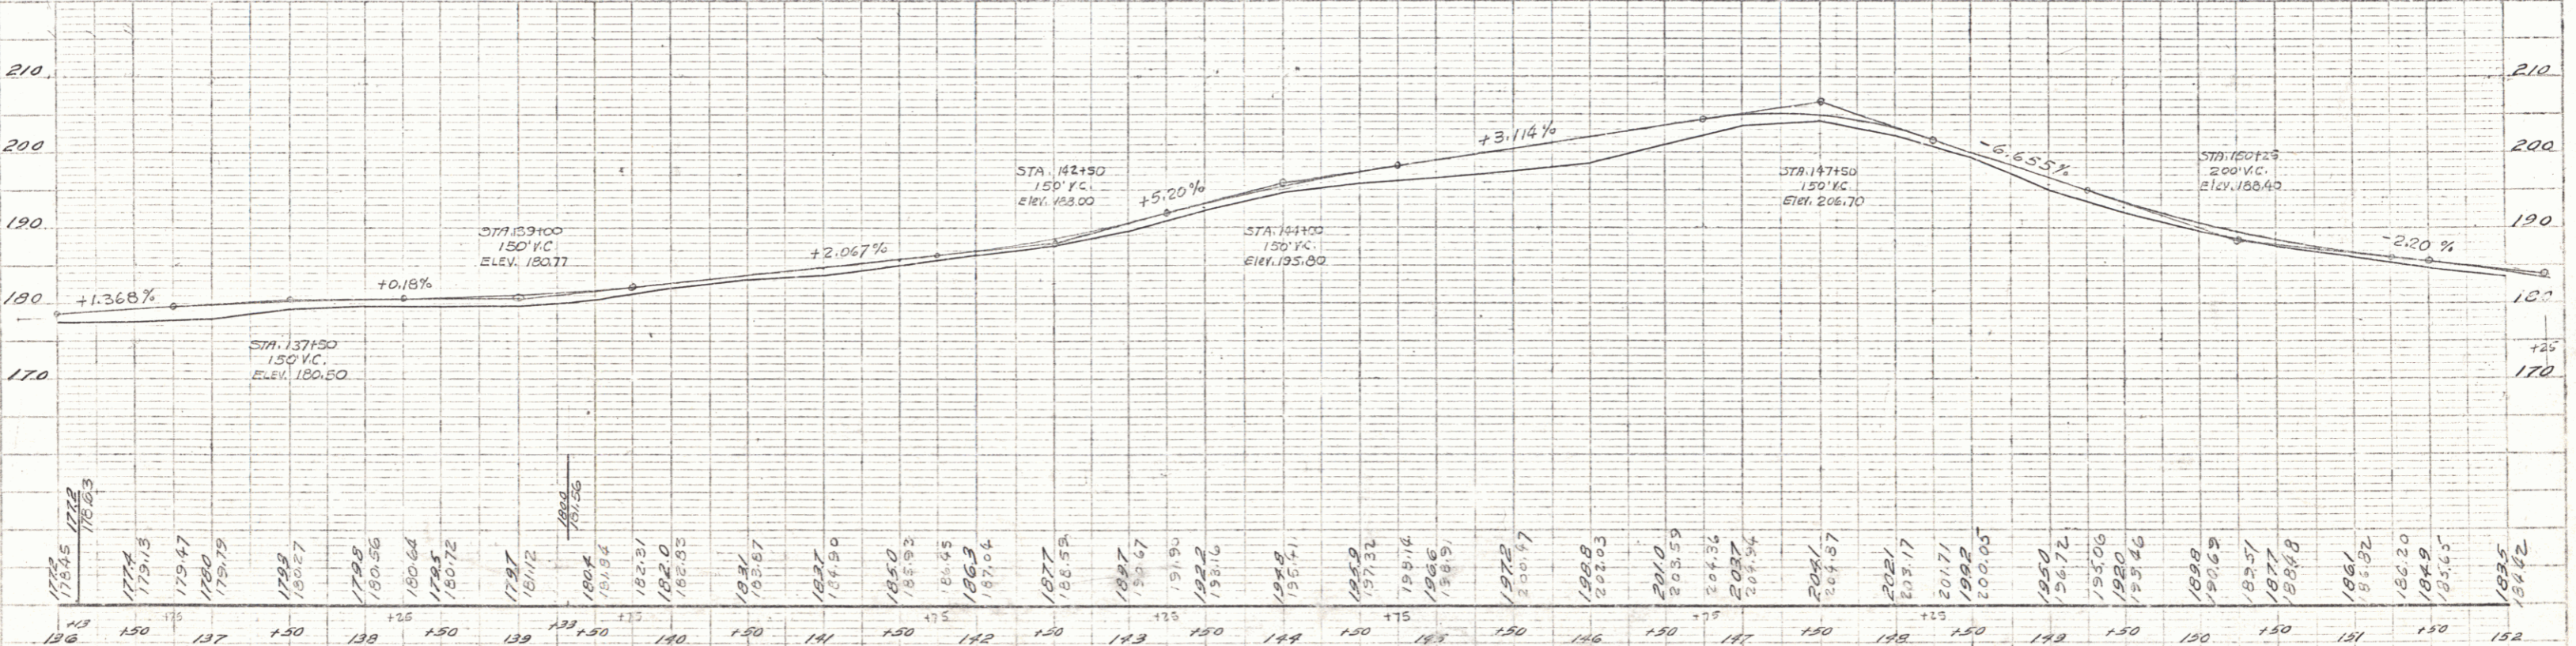


PLAN	DATE	BY
DATE	BY	BY
DATE	BY	BY
DATE	BY	BY
DATE	BY	BY

DATE	BY
DATE	BY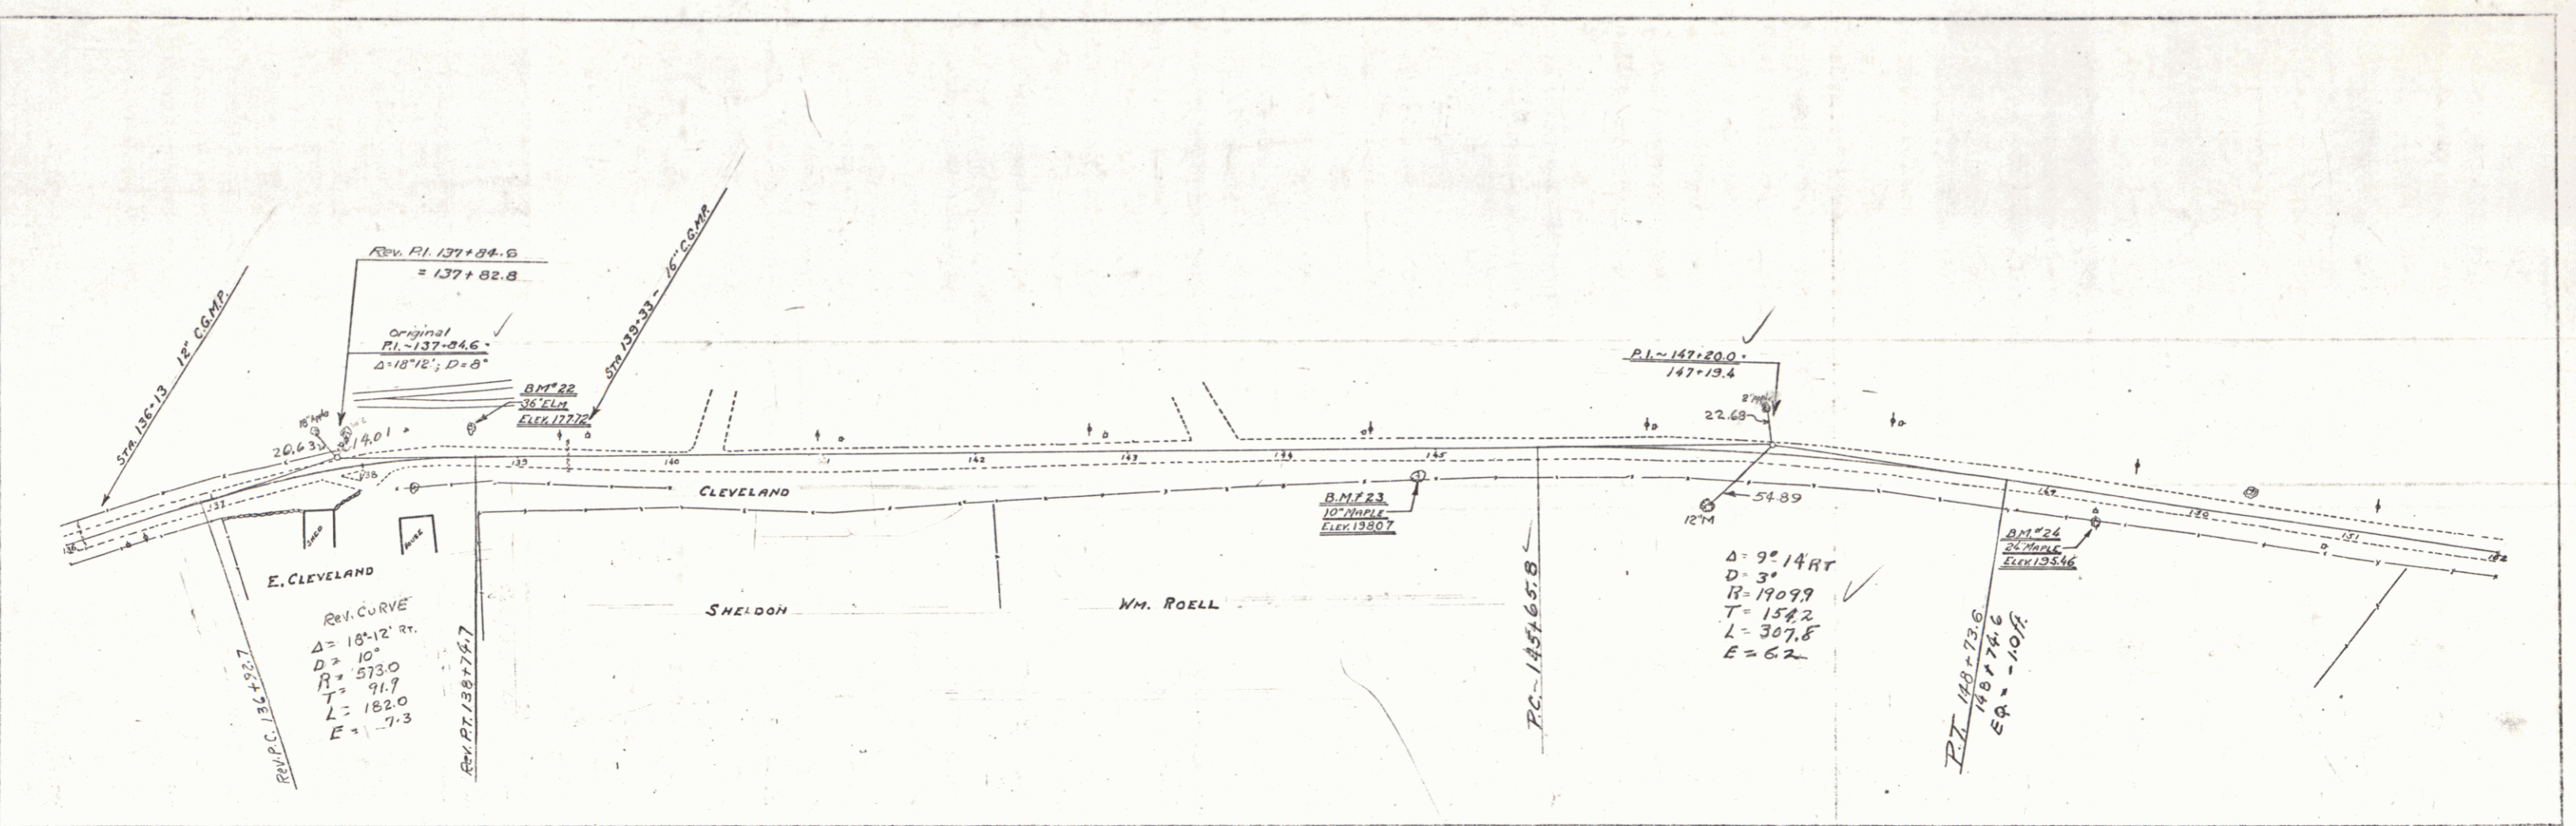
BM NO. 22 spike in 36" Elm 21ft left of STA 137+93 Elev 177.72  
 BM NO. 23 spike in 10" Maple 16ft right of STA 144+87 Elev 198.01  
 BM NO. 24 spike in 24" Maple 13ft right of STA 143+34 Elev 195.46

FOULTNEY-CASTLETON SHEET 12 OF