
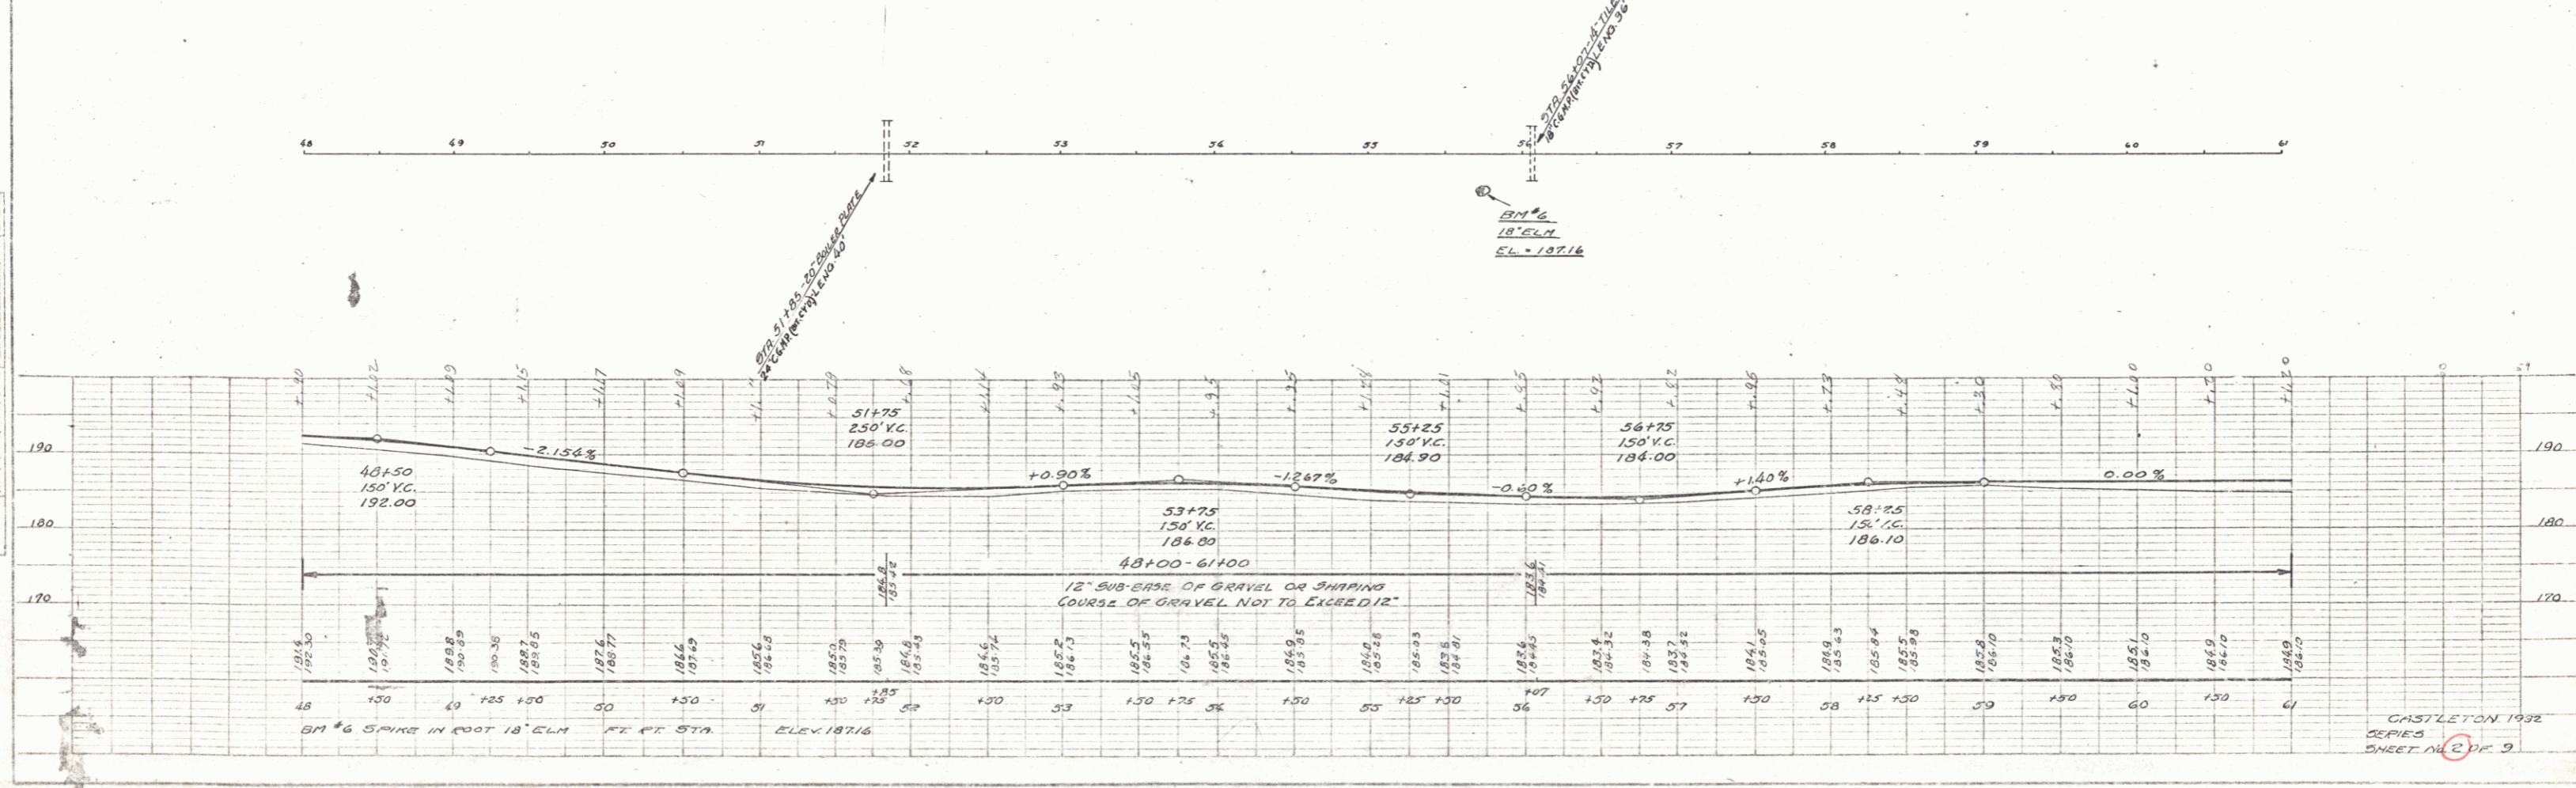


PLAN
 SURVEYED BY: [unclear]
 DRAWN BY: [unclear]
 CHECKED BY: [unclear]
 DATE: [unclear]

PROFILE
 SURVEYED BY: [unclear]
 DRAWN BY: [unclear]
 CHECKED BY: [unclear]
 DATE: [unclear]

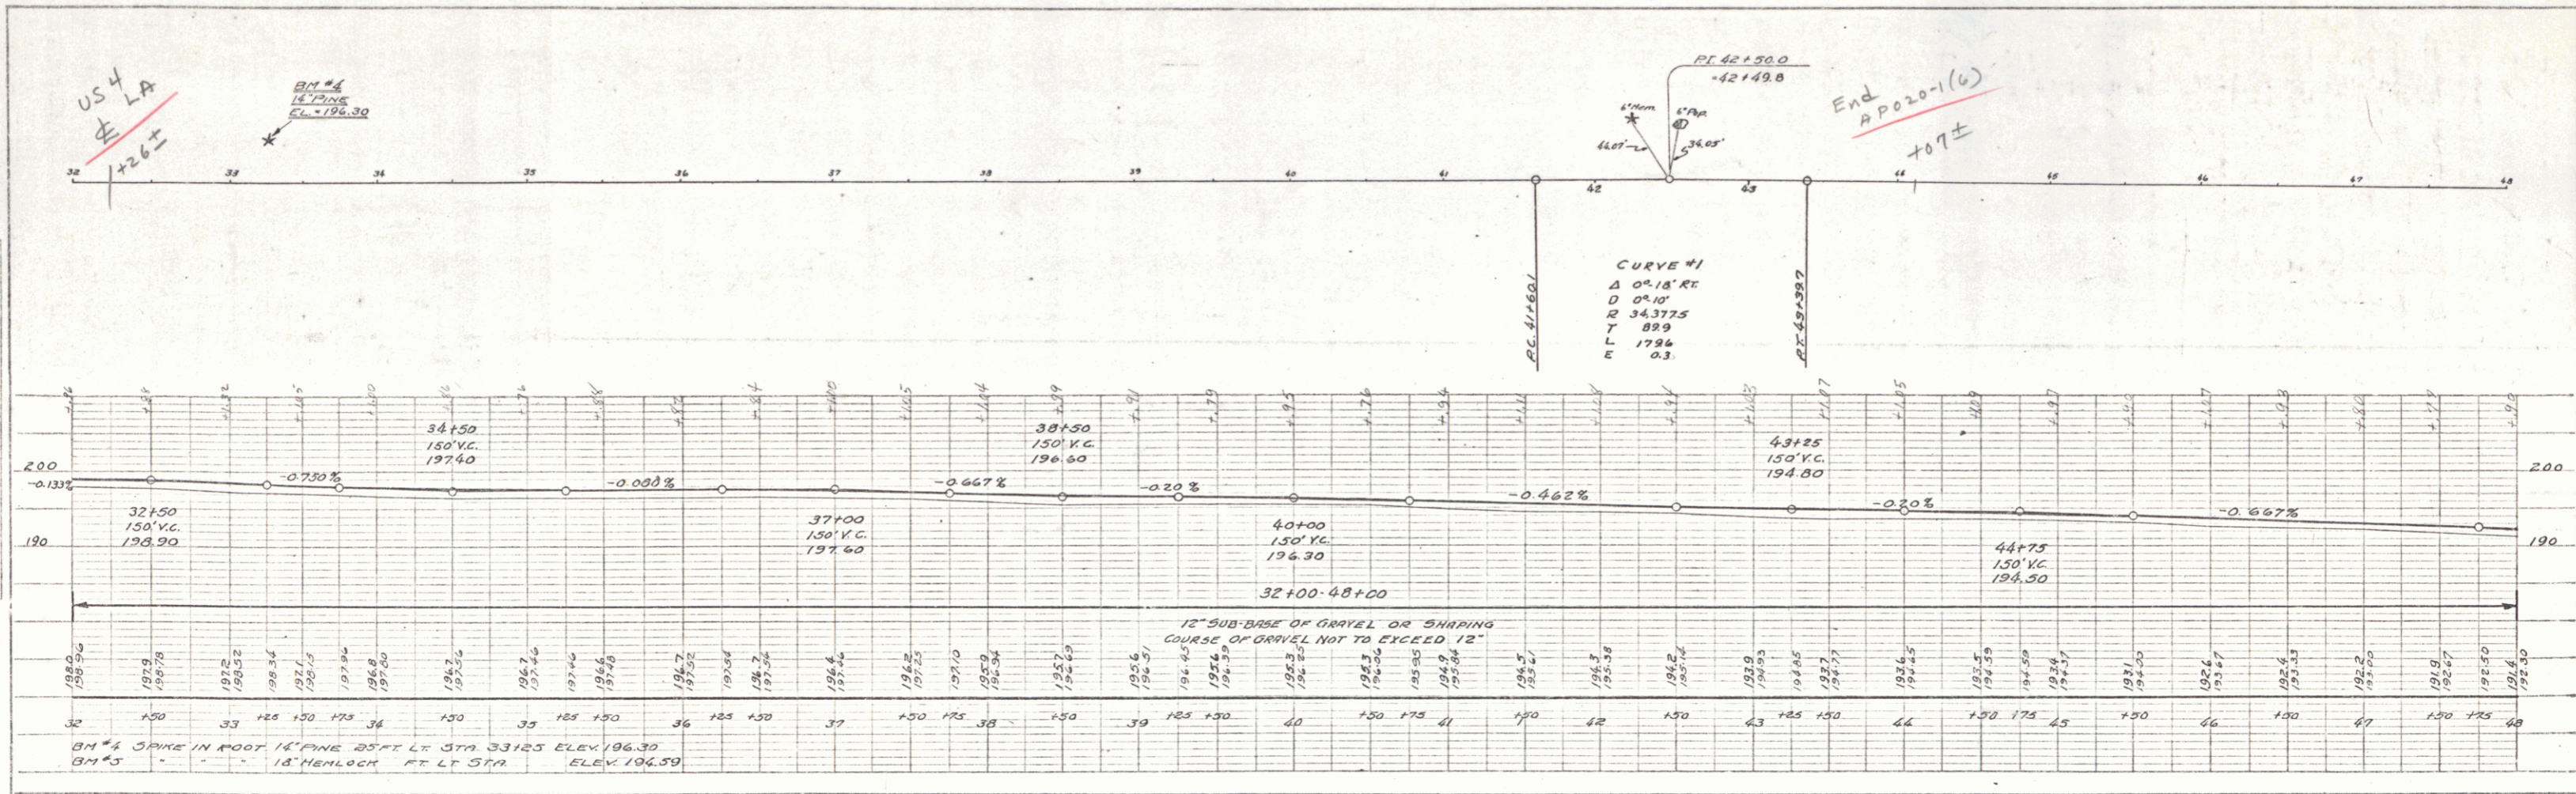

CASTLETON 1932
 SERIES
 SHEET NO. 2 OF 3