
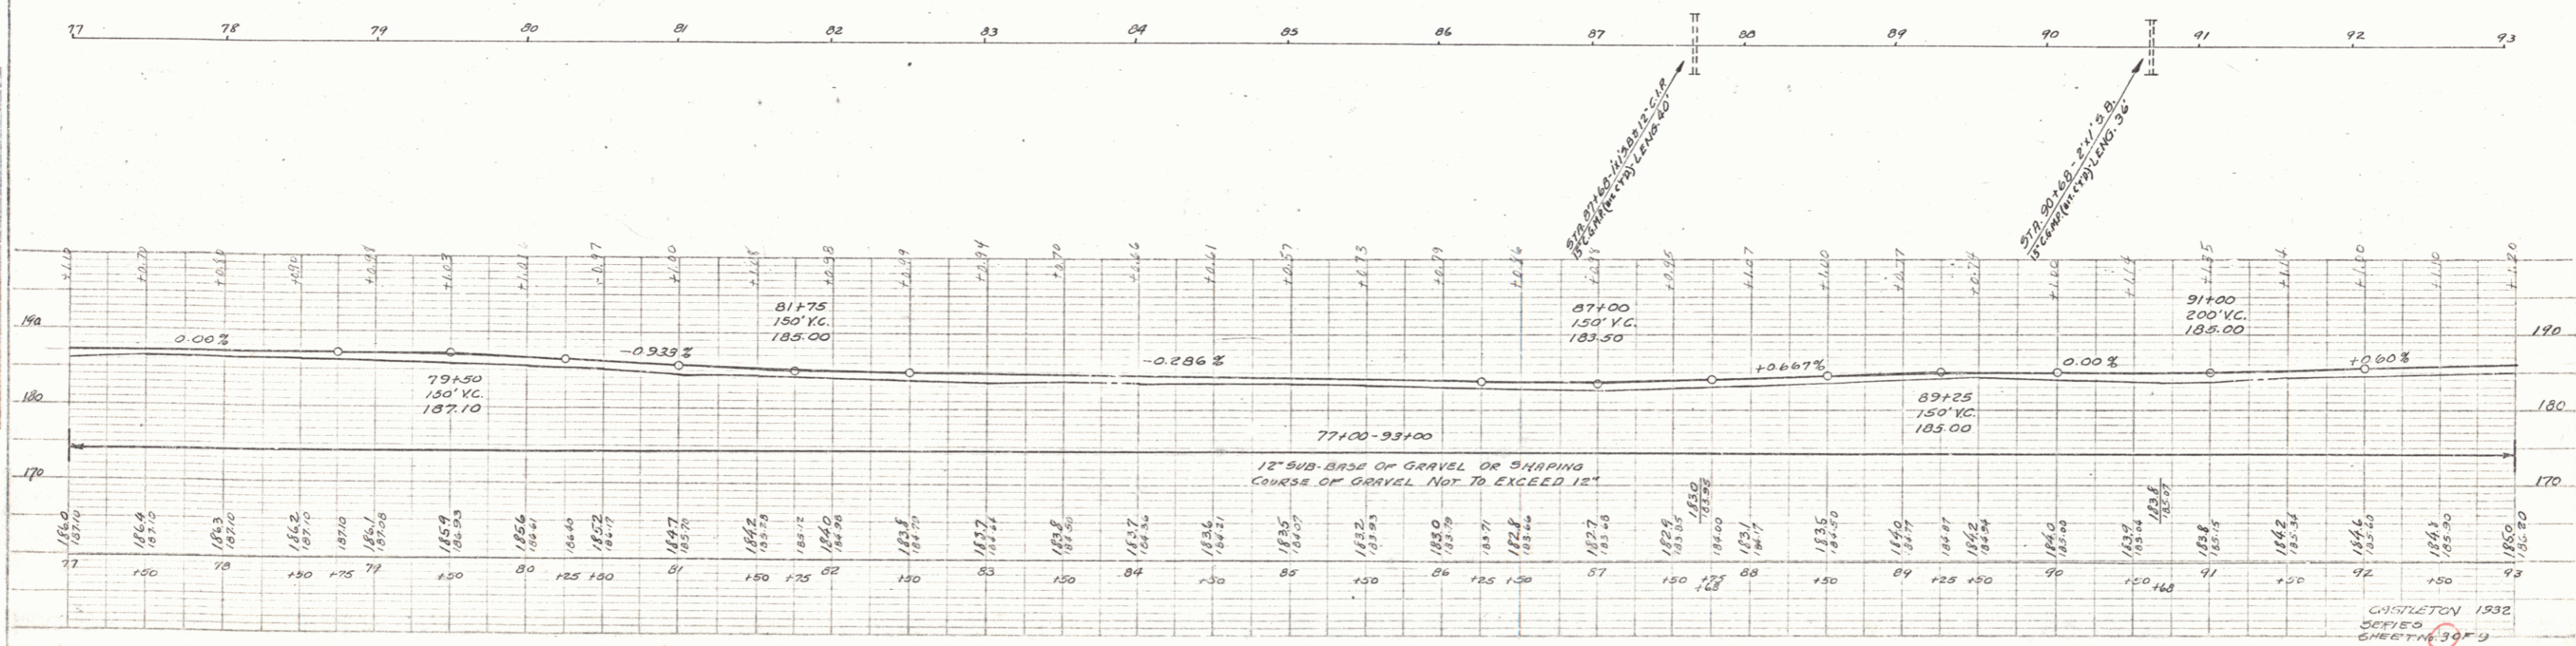


PLAN  
 DATE: 10/15/32  
 DRAWN BY: J. H. BENTLEY  
 CHECKED BY: J. H. BENTLEY  
 NO. 10

PROFILE  
 DATE: 10/15/32  
 DRAWN BY: J. H. BENTLEY  
 CHECKED BY: J. H. BENTLEY  
 NO. 10

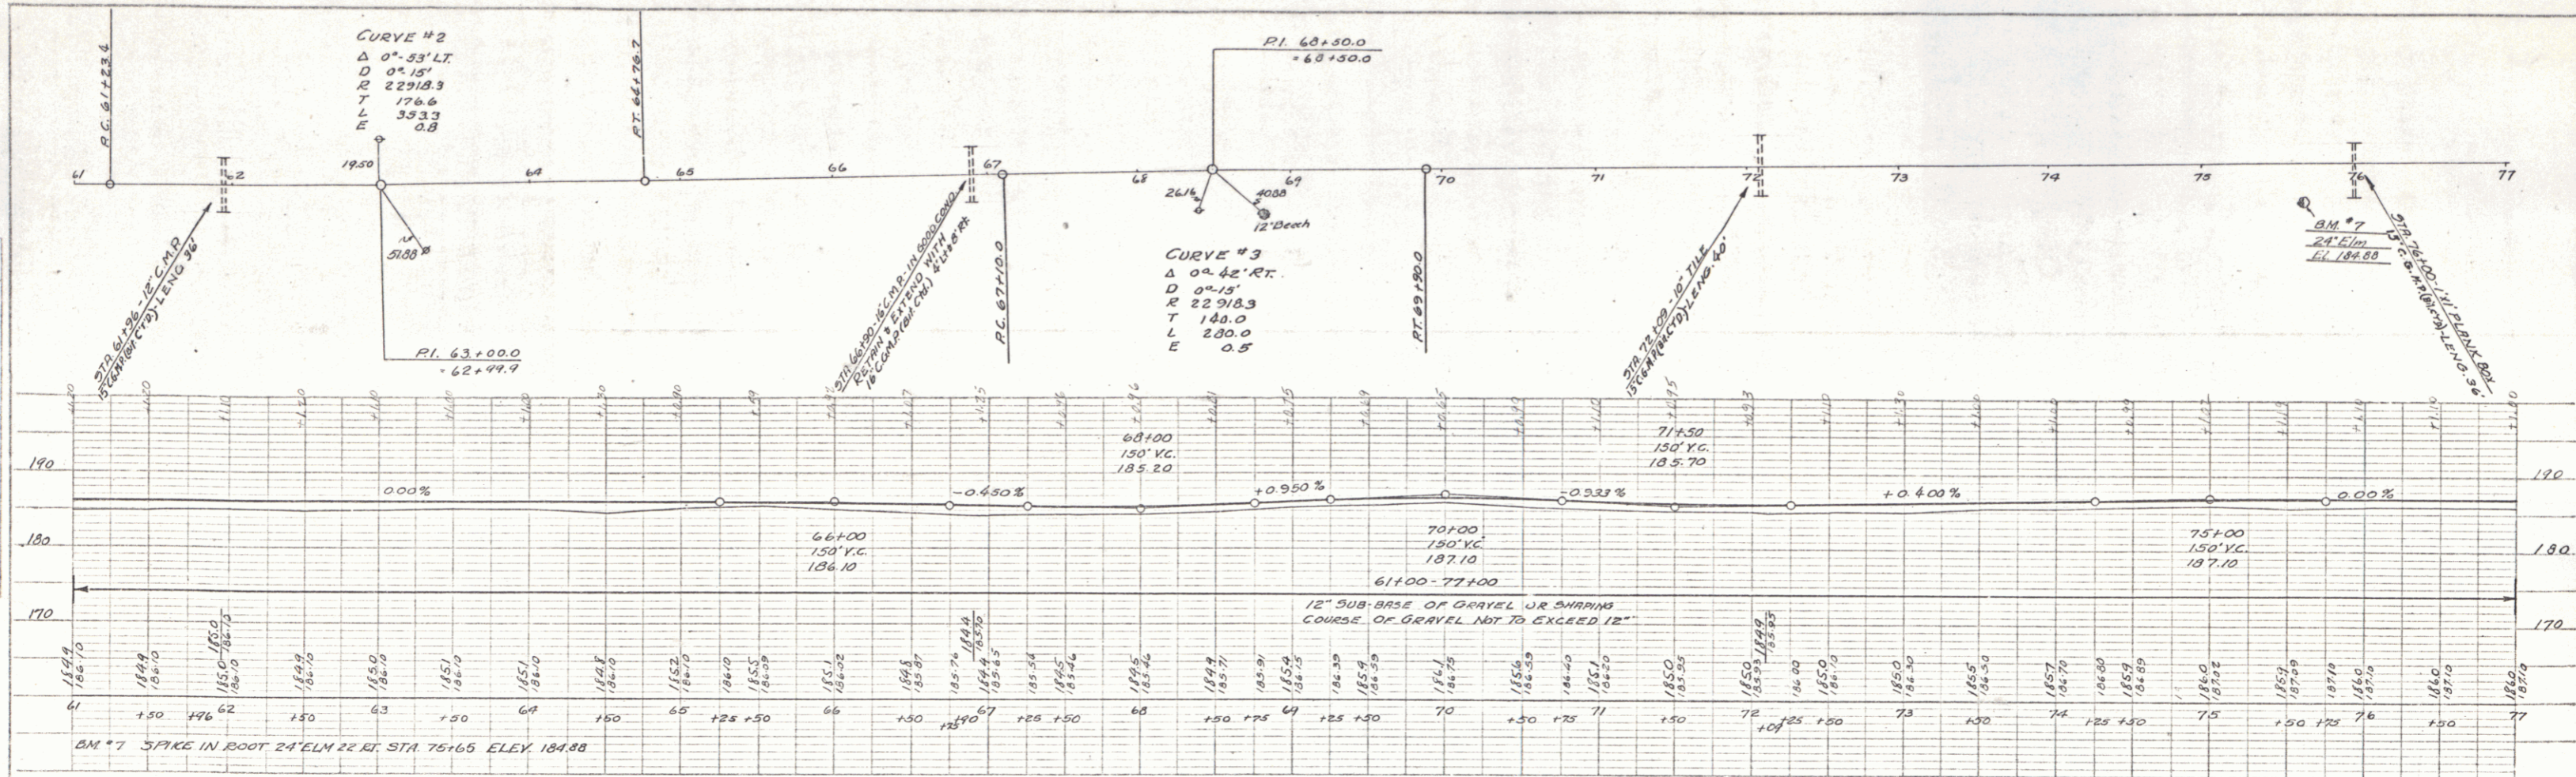

GUSTAFSON 1932  
 SERIES  
 SHEET 19 OF 30