
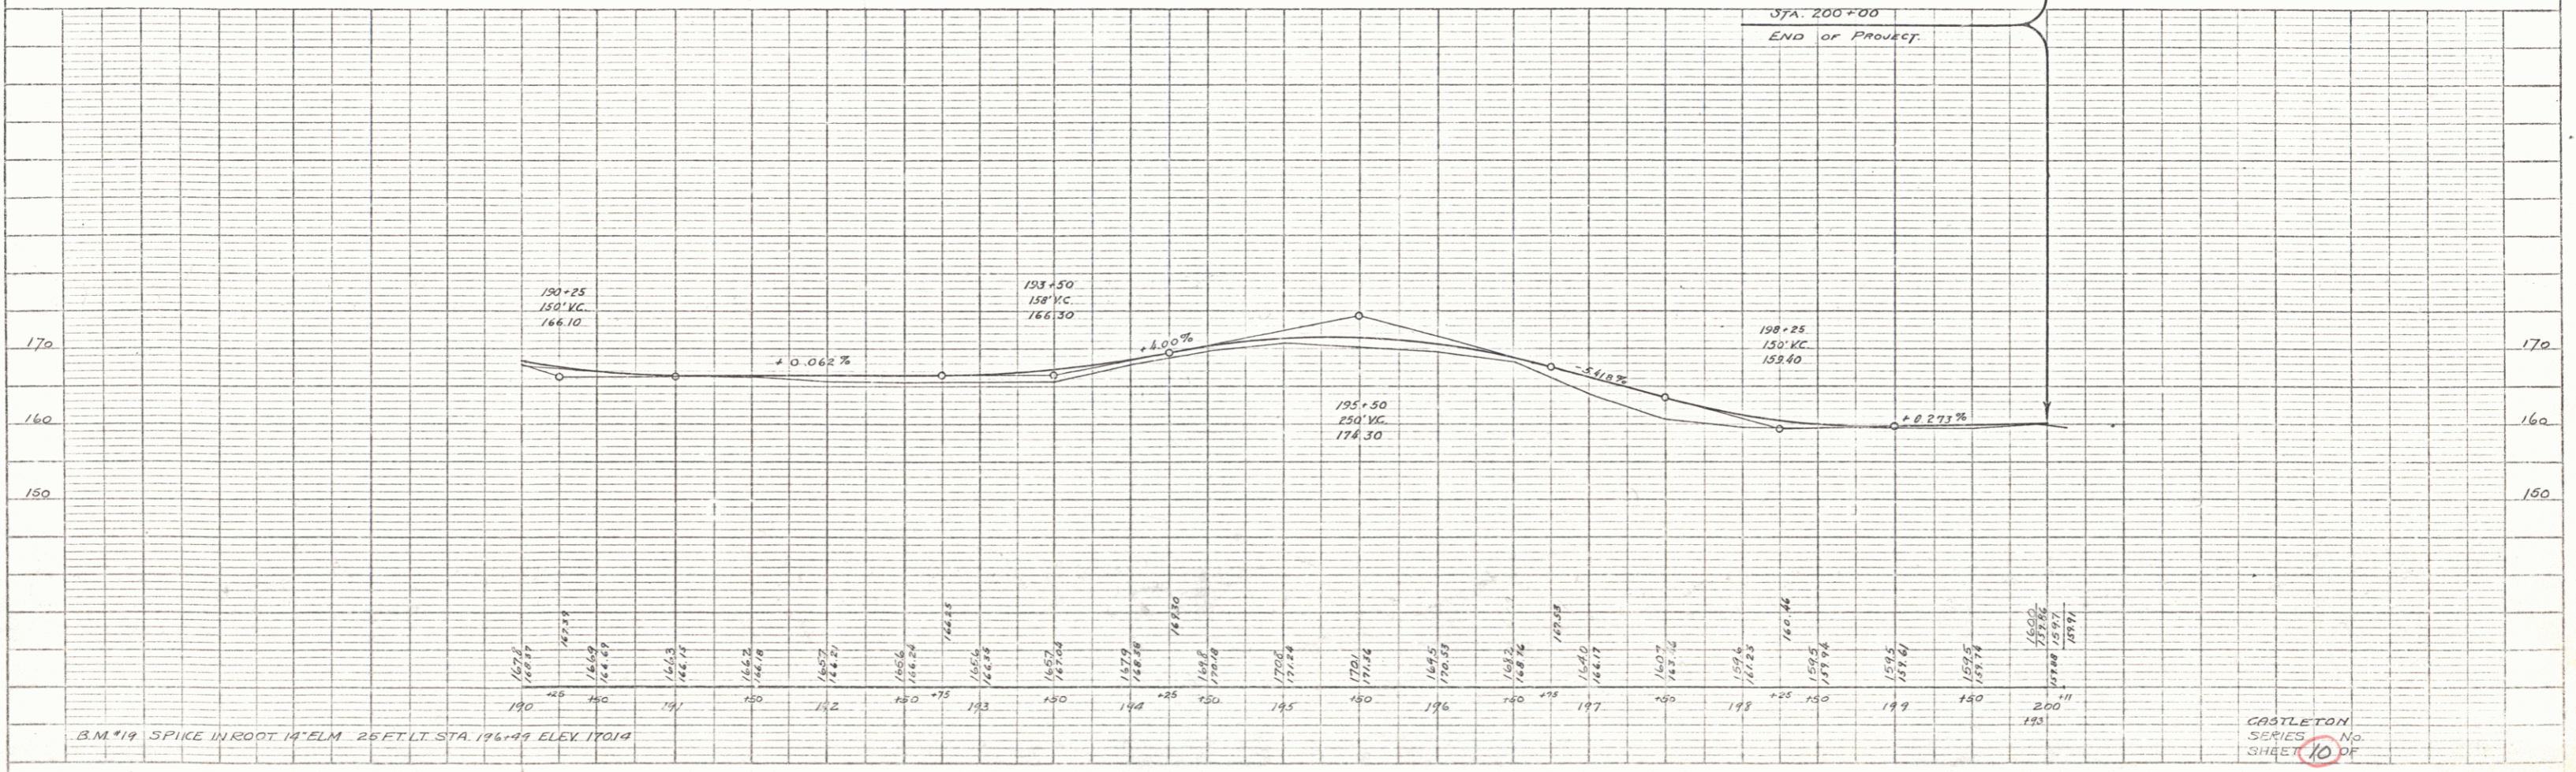


PLAN  
 DRAWN BY: WOOD  
 CHECKED BY: WOOD  
 DATE: 10/1/1919  
 PROJECT: CASTLETON

PROFILE  
 DRAWN BY: WOOD  
 CHECKED BY: WOOD  
 DATE: 10/1/1919  
 PROJECT: CASTLETON

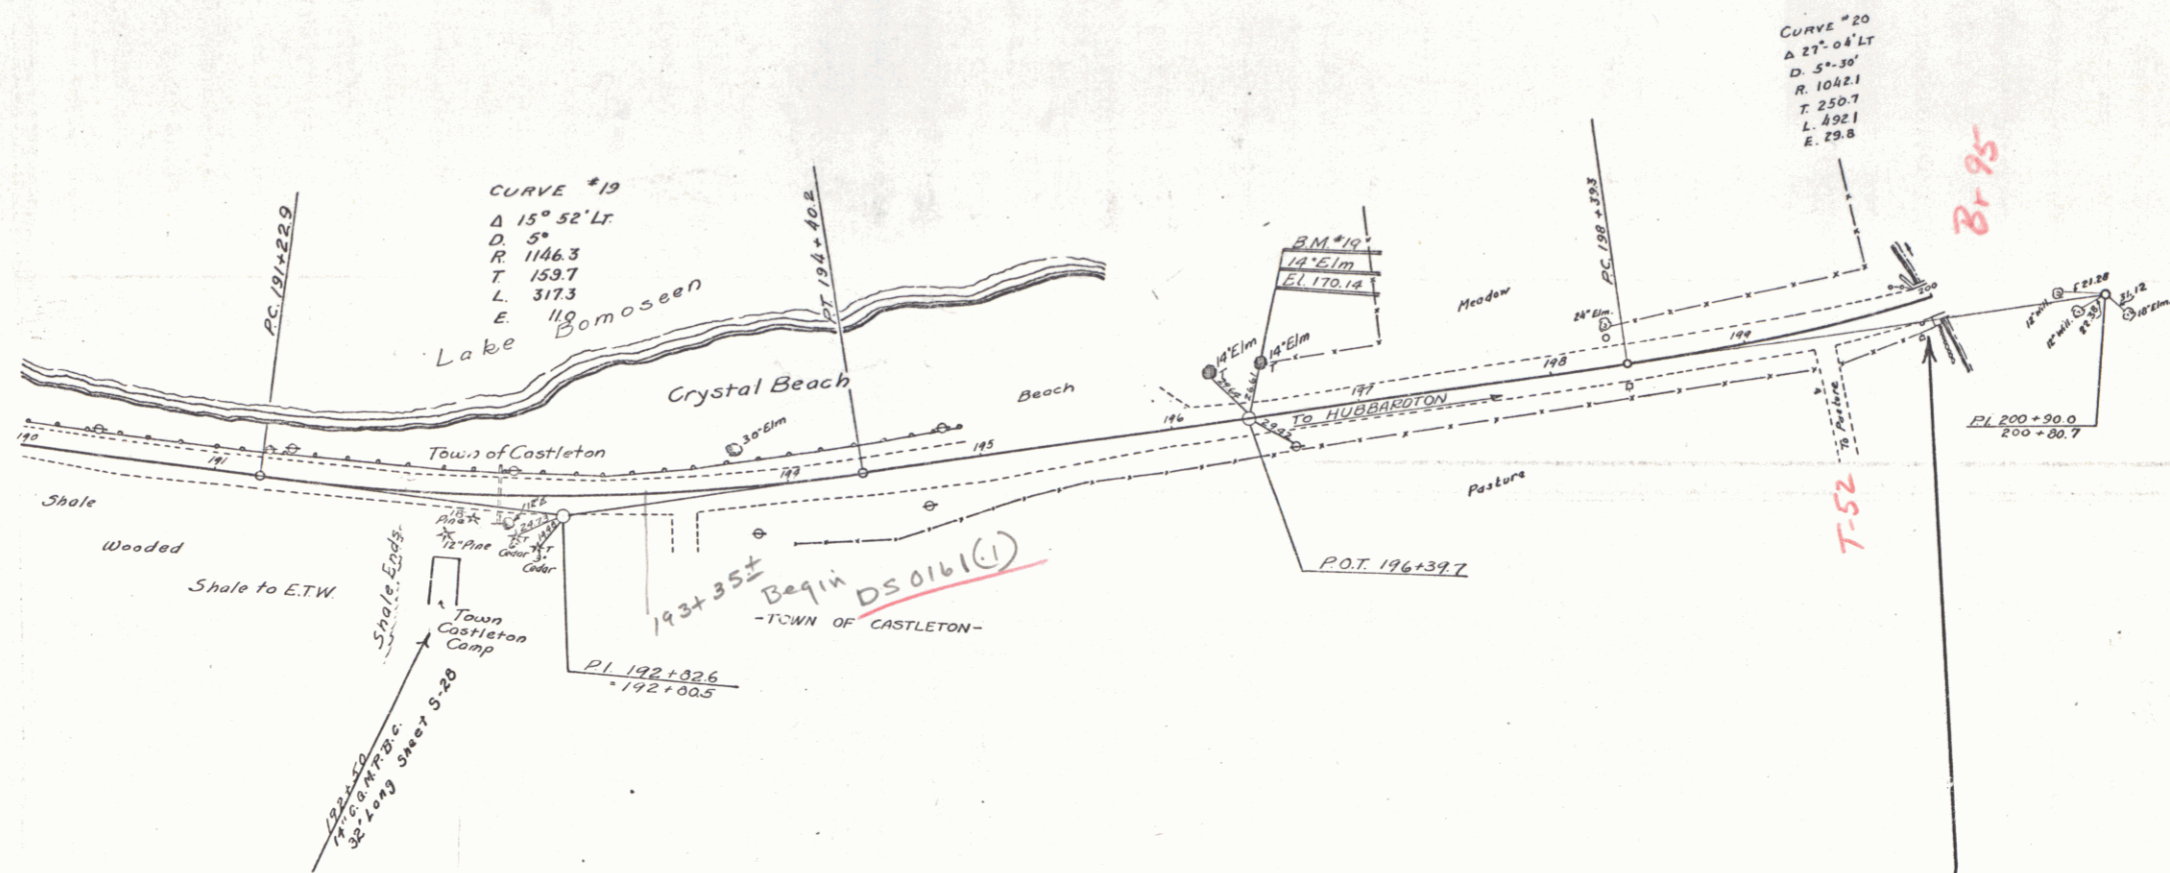

B.M. #19 SPIKE IN ROOT 14' ELM 25 FT. LT. STA. 196+49 ELEV. 170.14

CASTLETON  
 SERIES No. 10  
 SHEET 10 OF 10