

PLAN	DATE
PROJECT	
SCALE	
BY	
CHECKED	
APPROVED	

PROFILE	DATE
PROJECT	
SCALE	
BY	
CHECKED	
APPROVED	

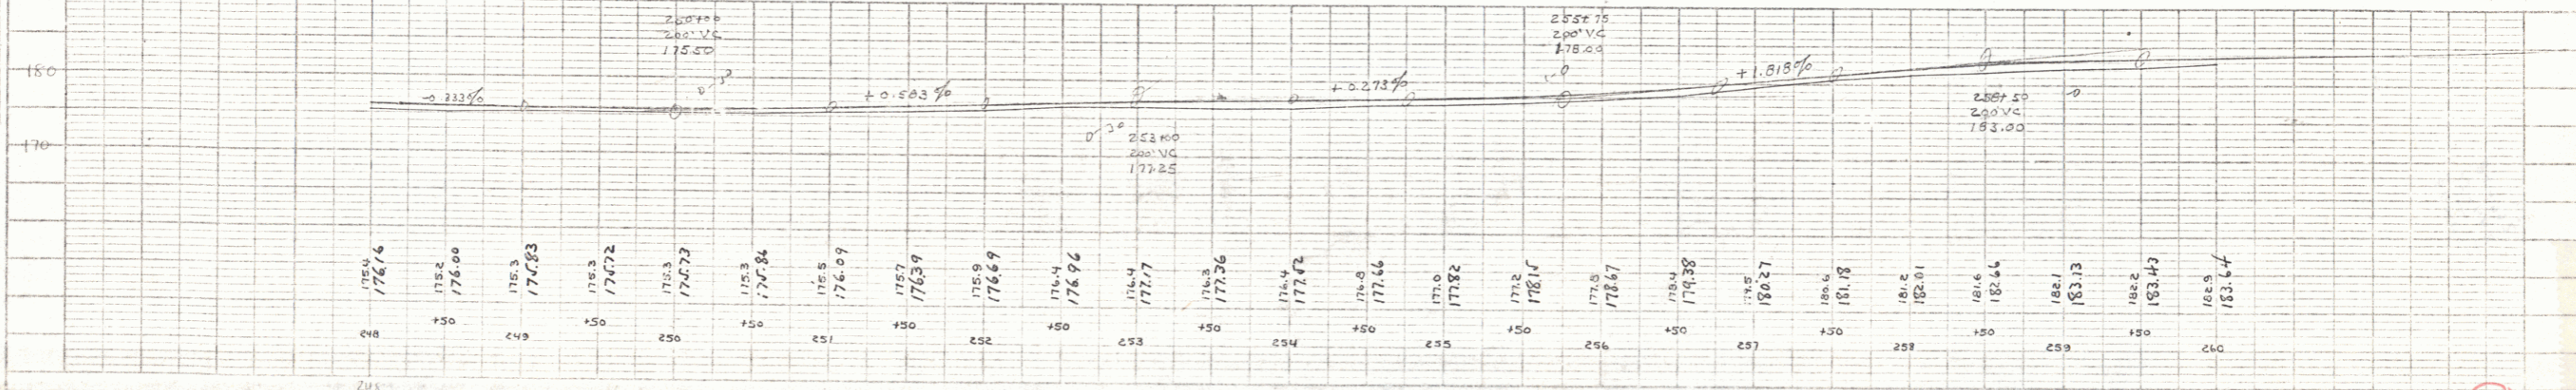
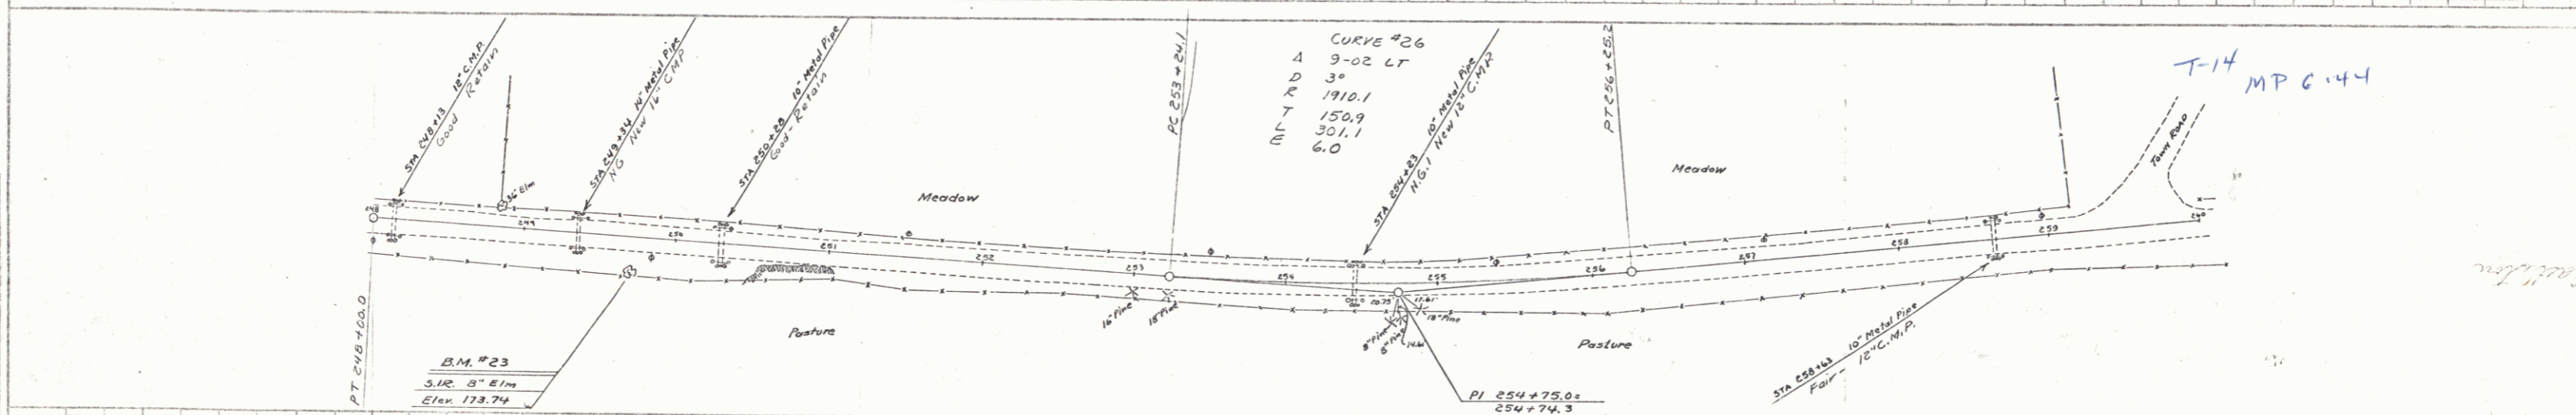
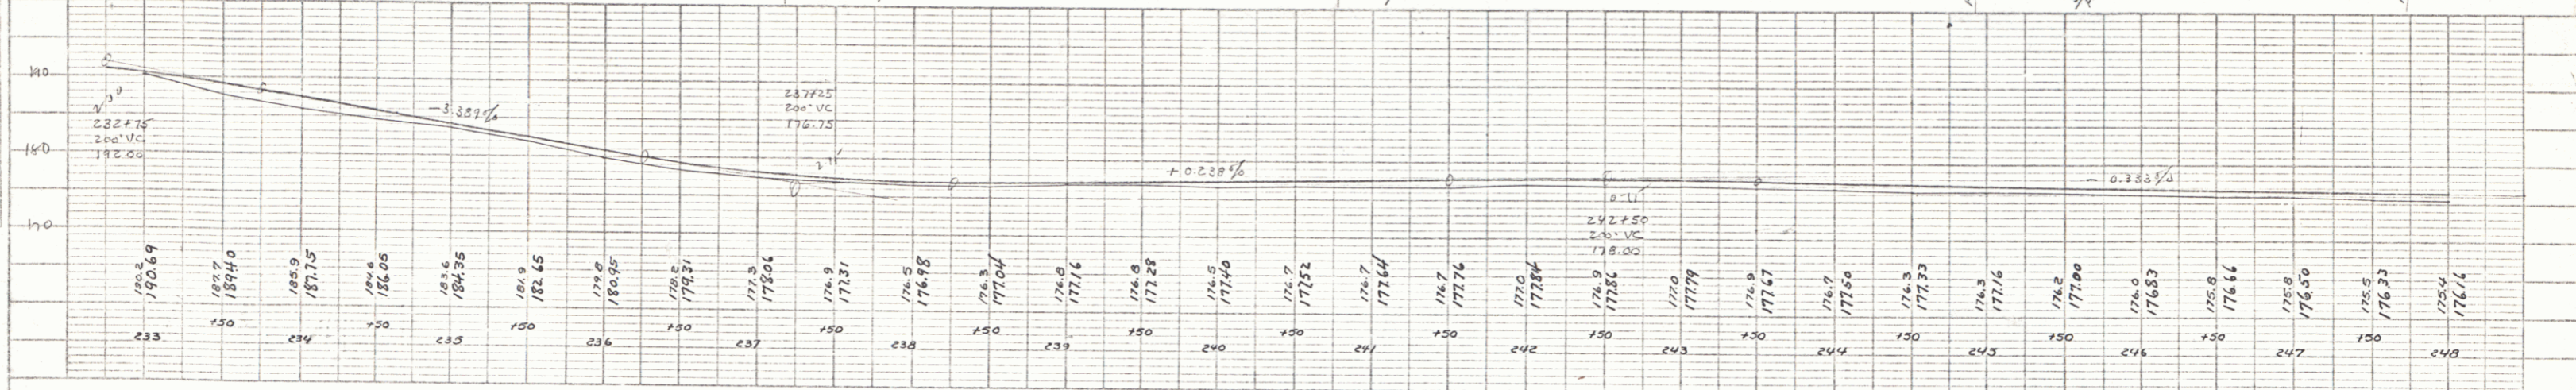
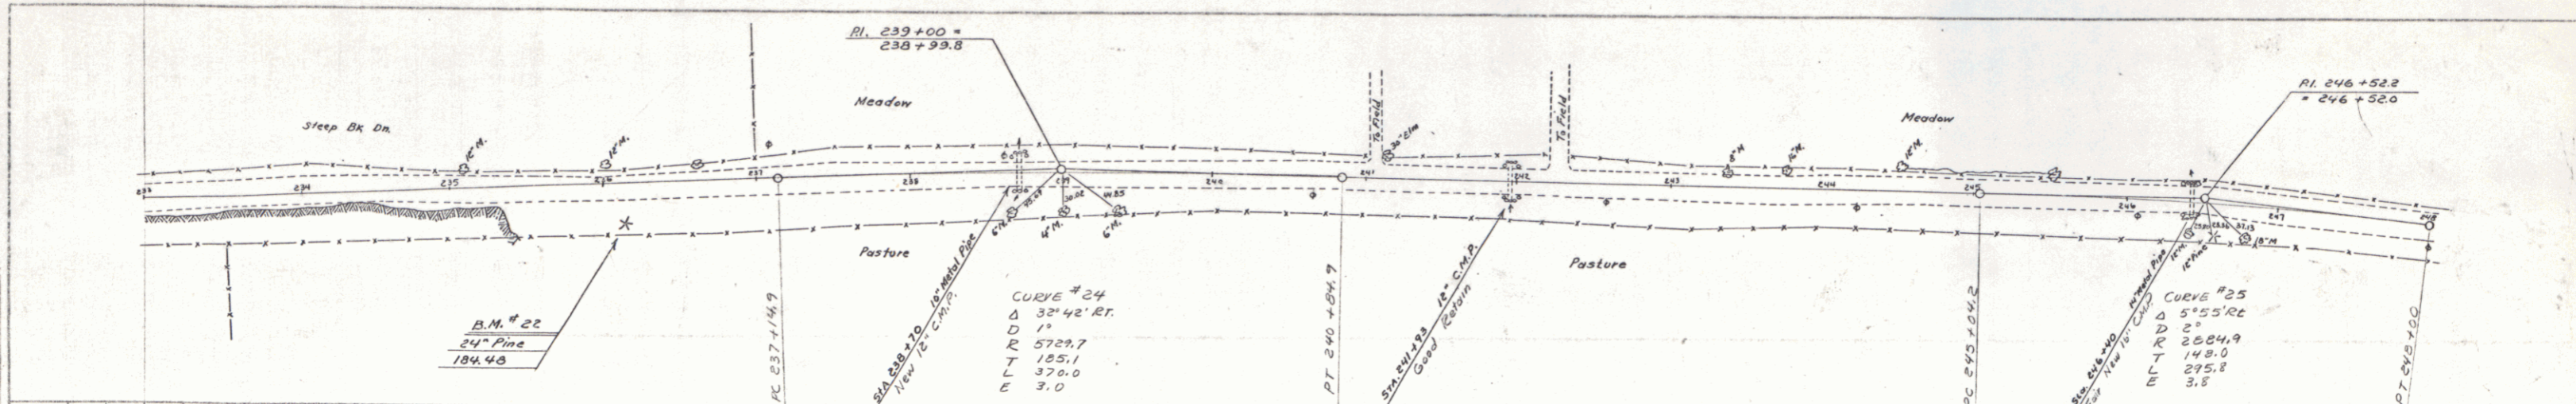


PLATE 2 - PLAN & PROFILE - R.R. & A.L. SHAW  
 NEWTON & BRUCE CO. NEW YORK