


PLAN
 SURVEYED
 ALIGNED
 CHECKED
 BY
 DATE

PROFILE
 PLOTTED
 CHECKED
 BY
 DATE


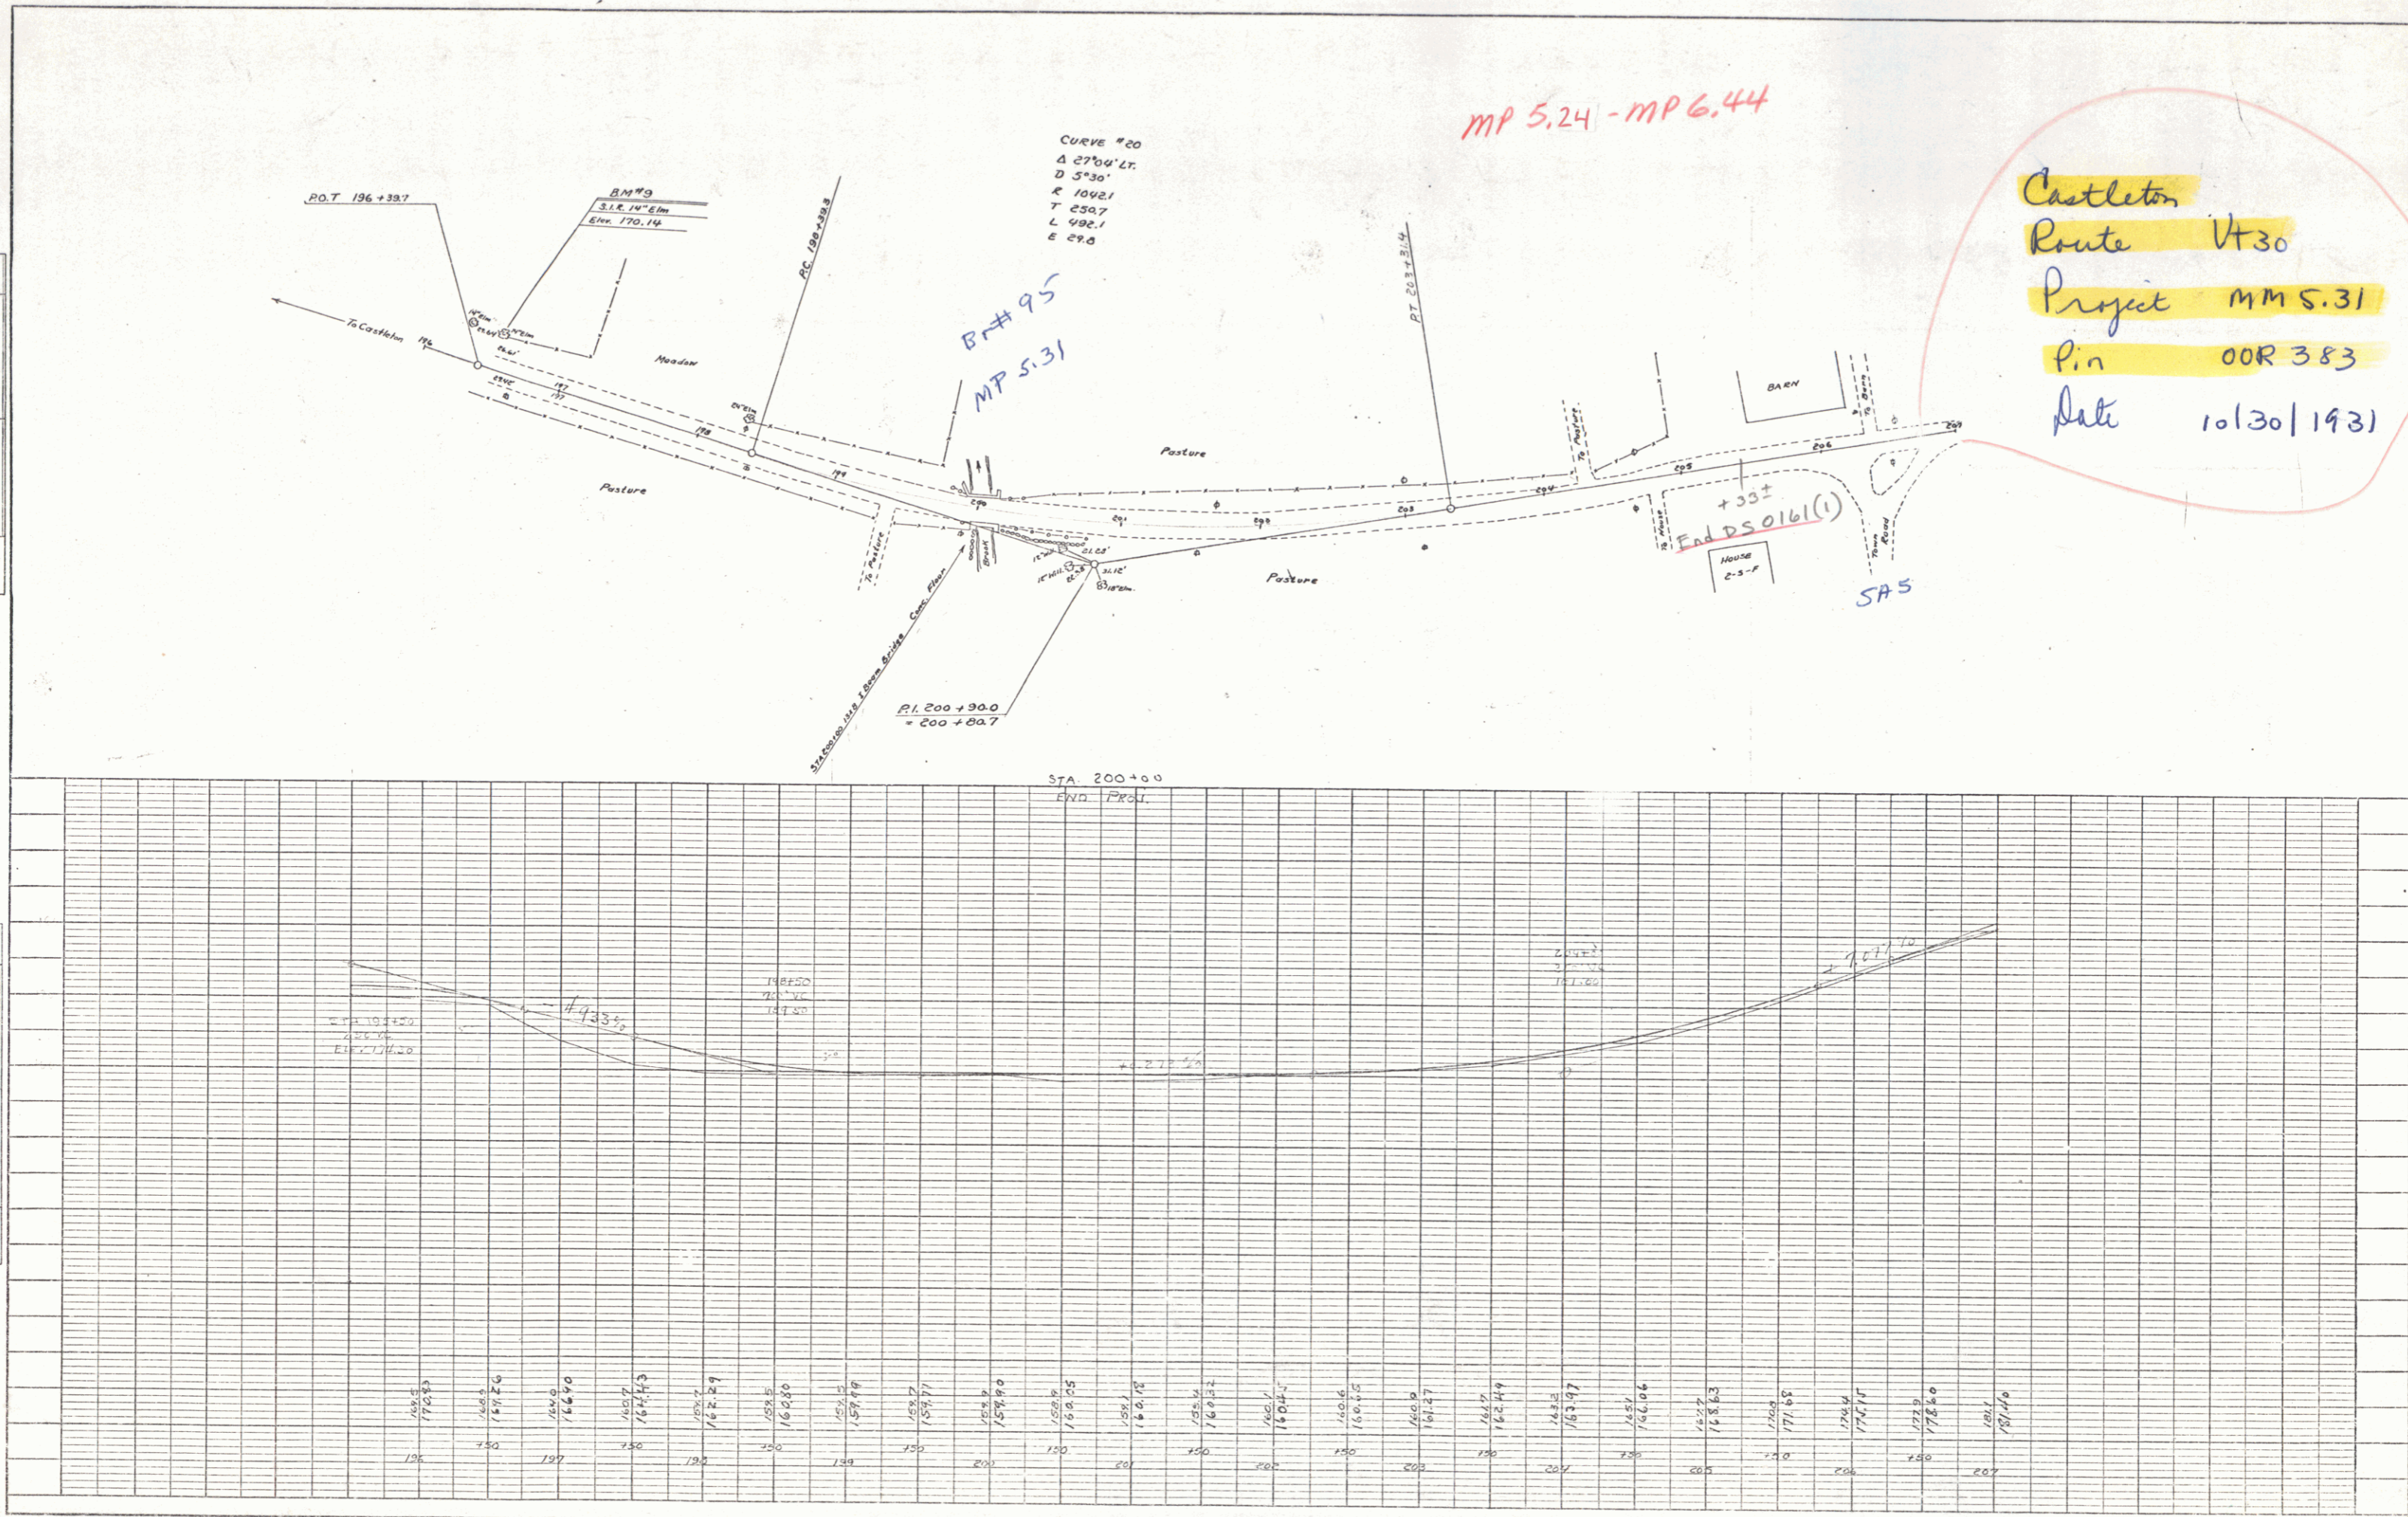


MP 5.24 - MP 6.44

Castleton
 Route Vt 30
 Project MMS.31
 Pin OOR 383
 Date 10/30/1931



PLAN
 DRAWN BY: B. J. BROWN
 CHECKED BY: [blank]
 DATE: 12/1/50
 NO. OF WALS CHECKED: [blank]

PROFILE
 DRAWN BY: B. J. BROWN
 CHECKED BY: [blank]
 DATE: 12/1/50
 NO. OF WALS CHECKED: [blank]

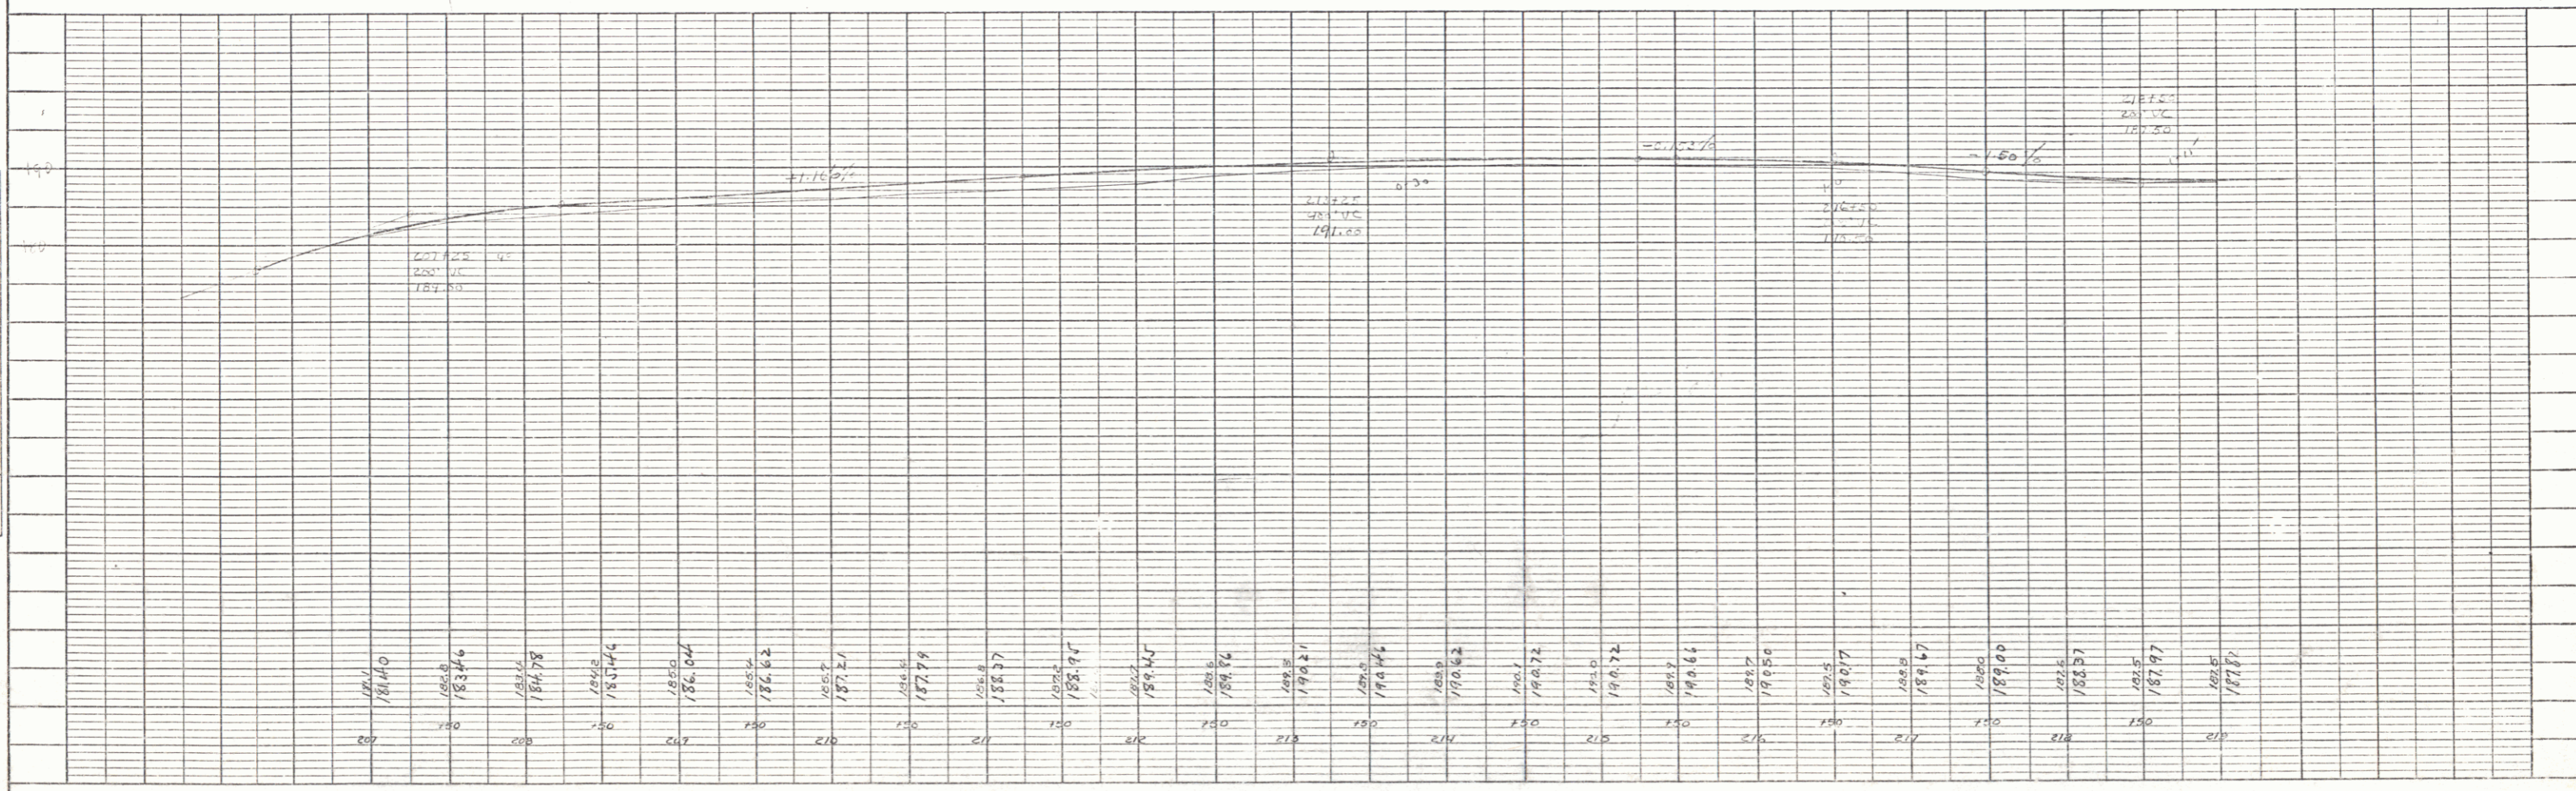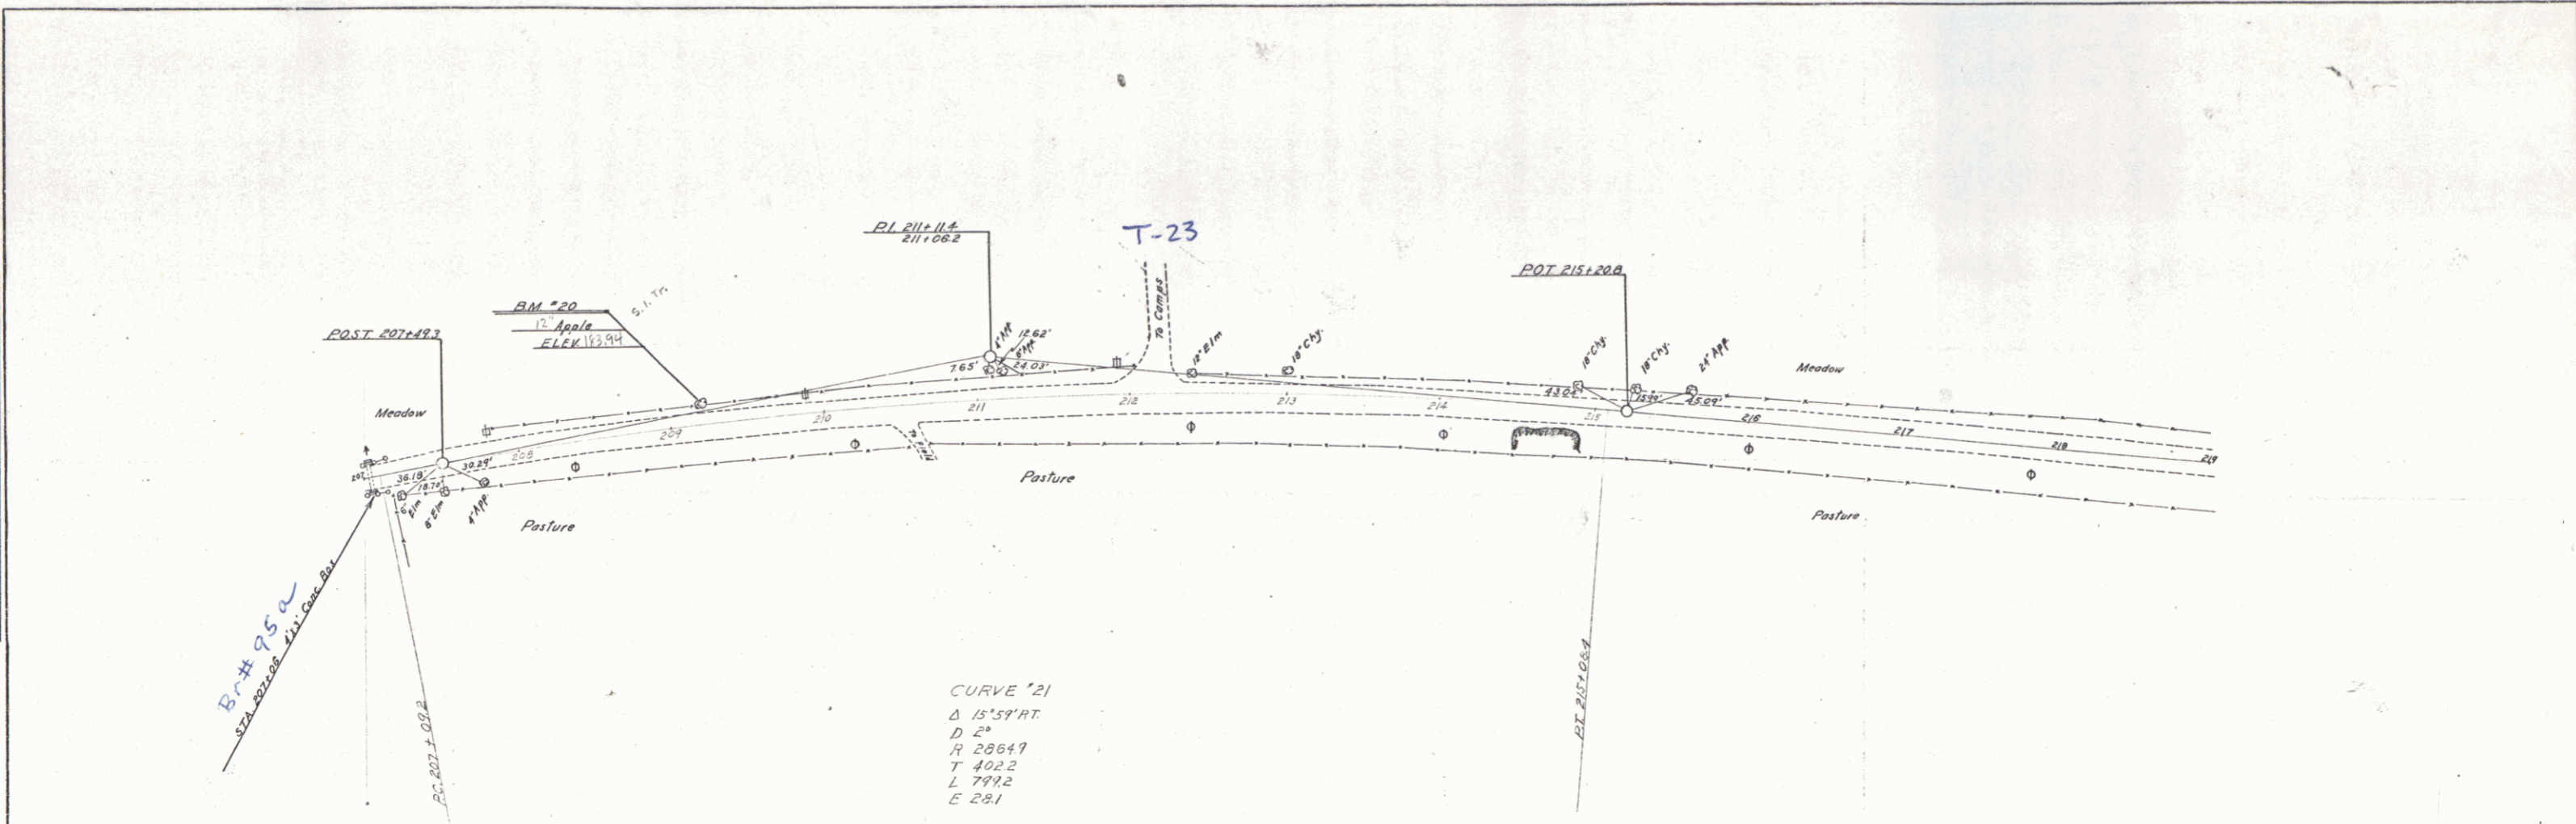

PLAN
 DIRECTOR
 CHECKED
 DATE
 NO.

PROFILE
 DIRECTOR
 CHECKED
 DATE
 NO.

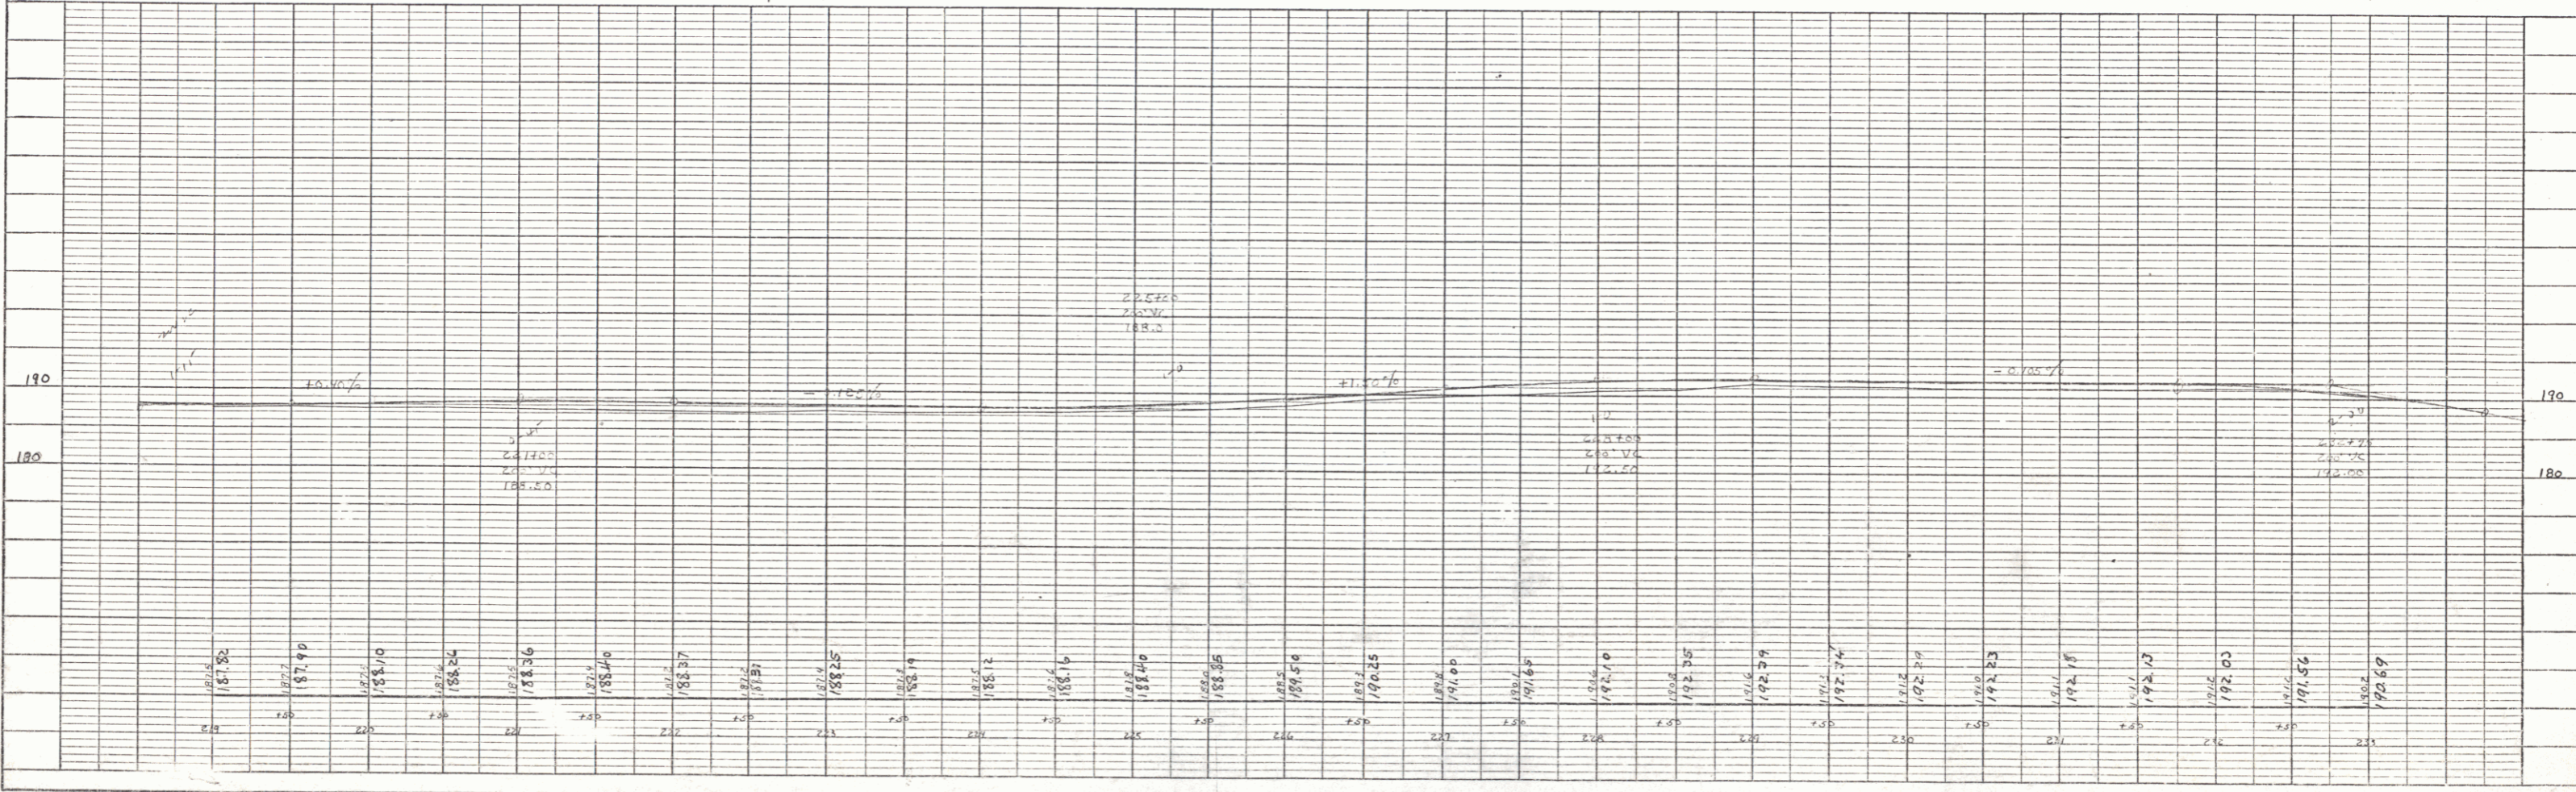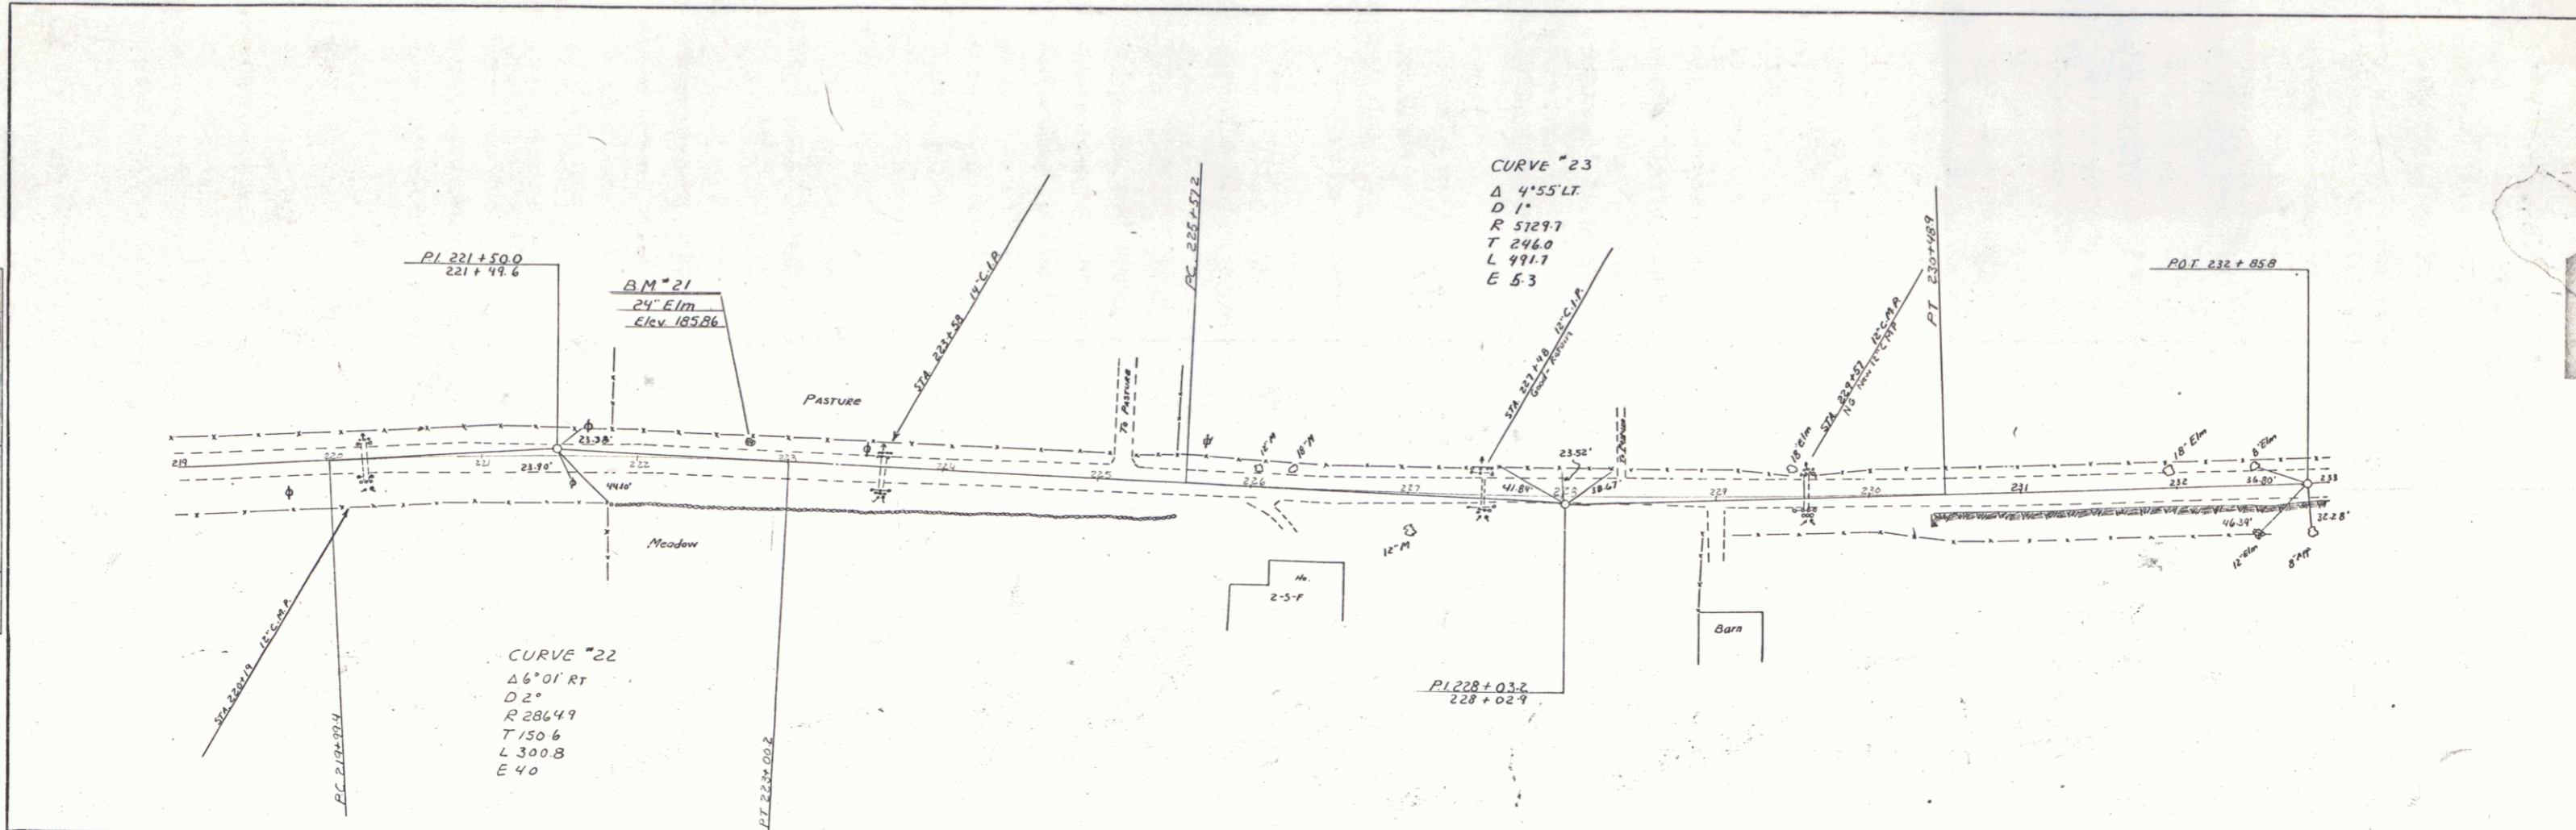

PLAN	DATE
PROJECT	
DATE	
BY	
CHECKED	
APPROVED	

PROFILE	DATE
PROJECT	
DATE	
BY	
CHECKED	
APPROVED	

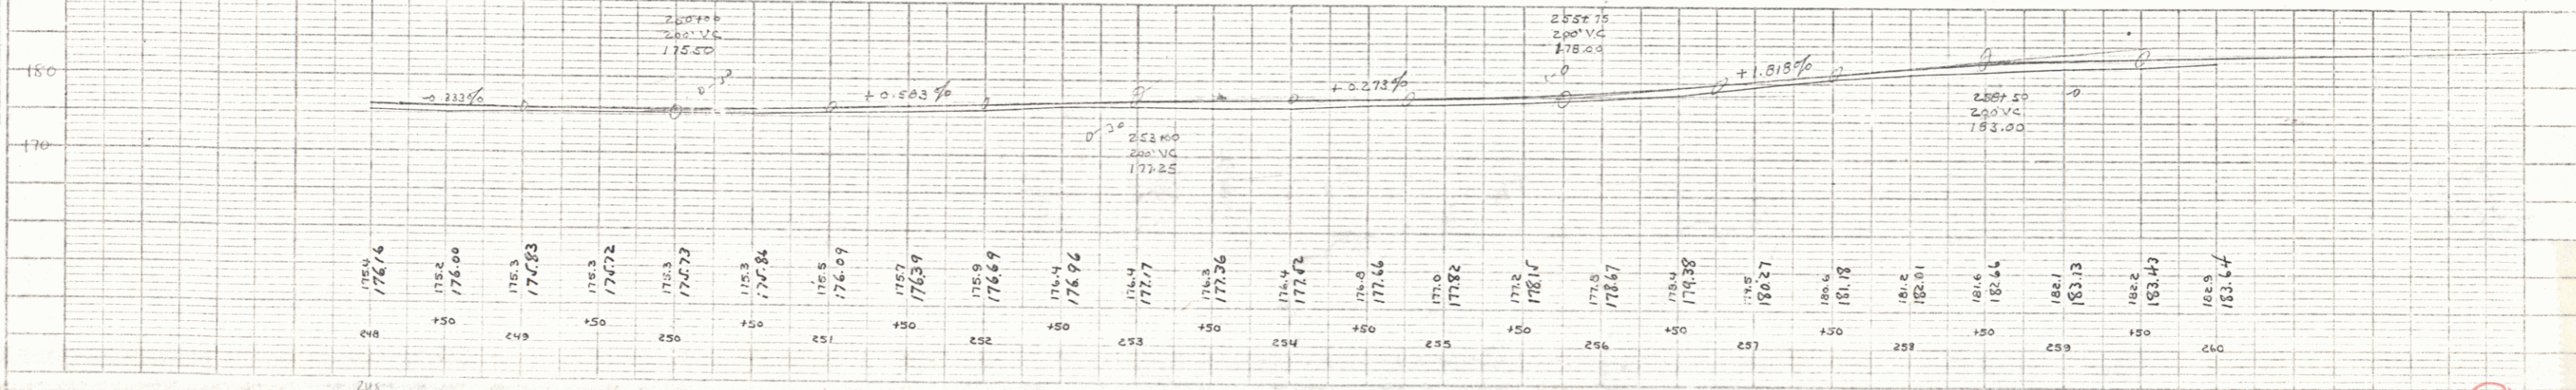
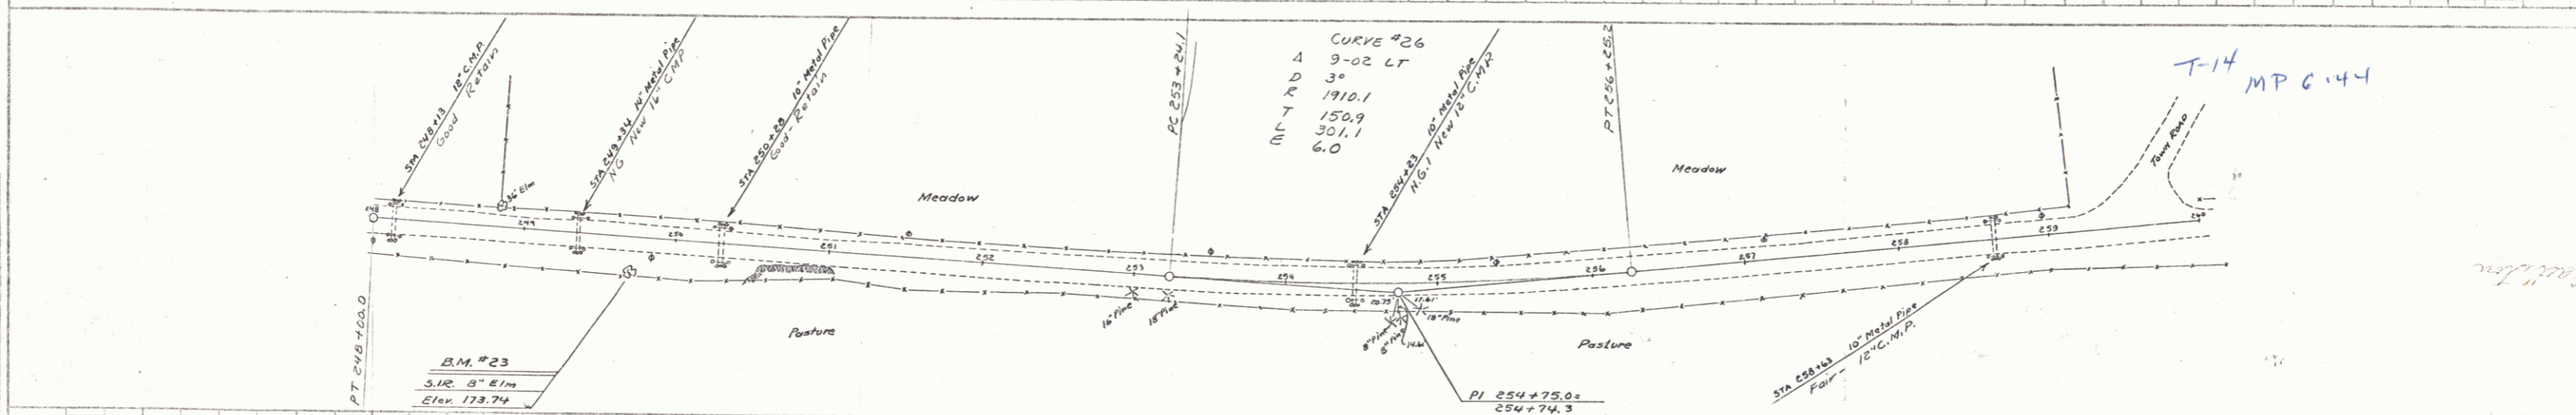
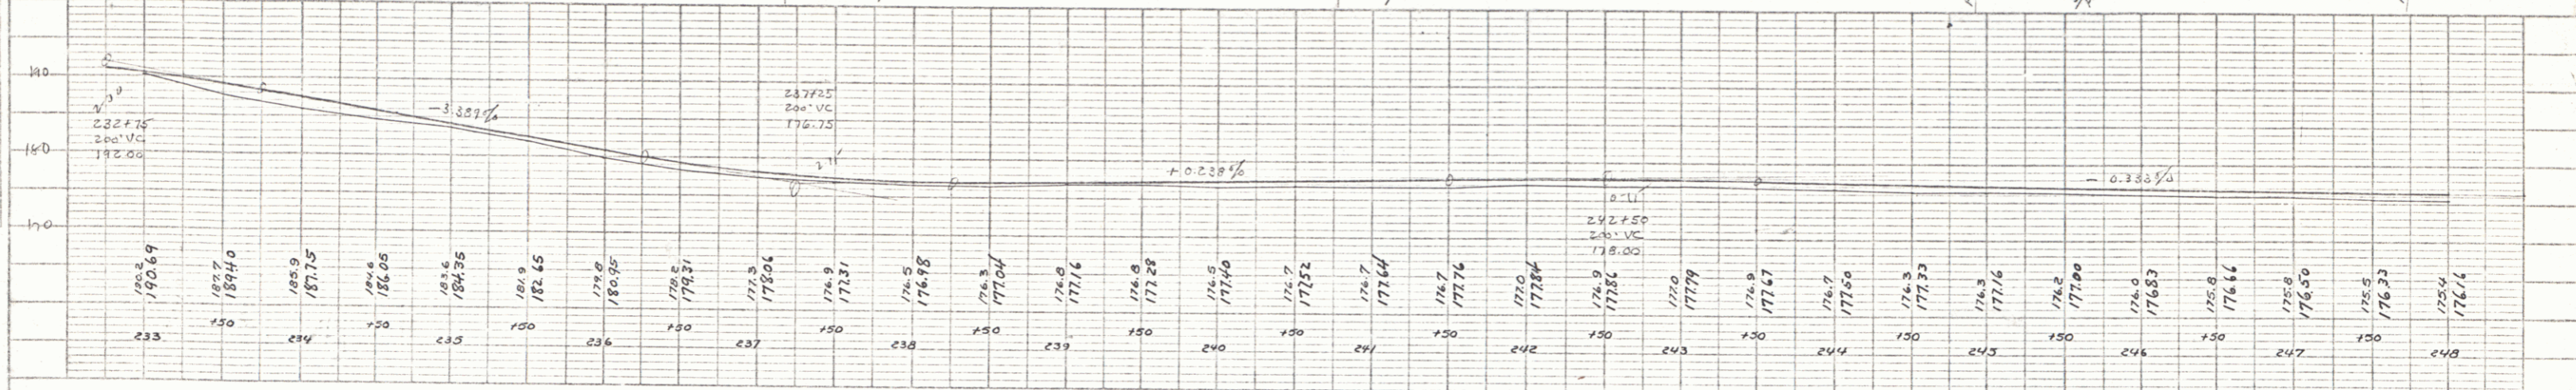
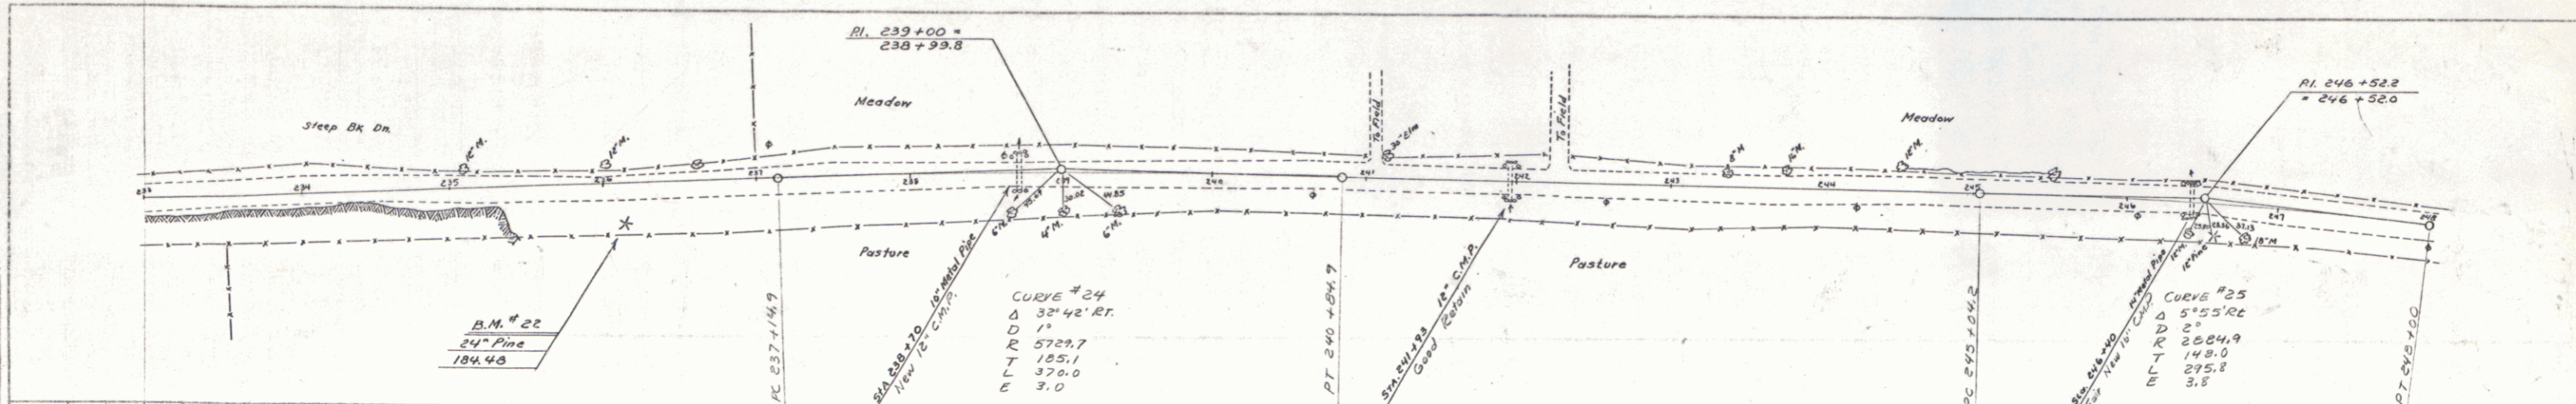


PLATE 2 - PLAN & PROFILE - R.R. & A.L. SHAW
 MECHANICAL ENGINEER
 1000 N. 10th St., St. Paul, Minn.