
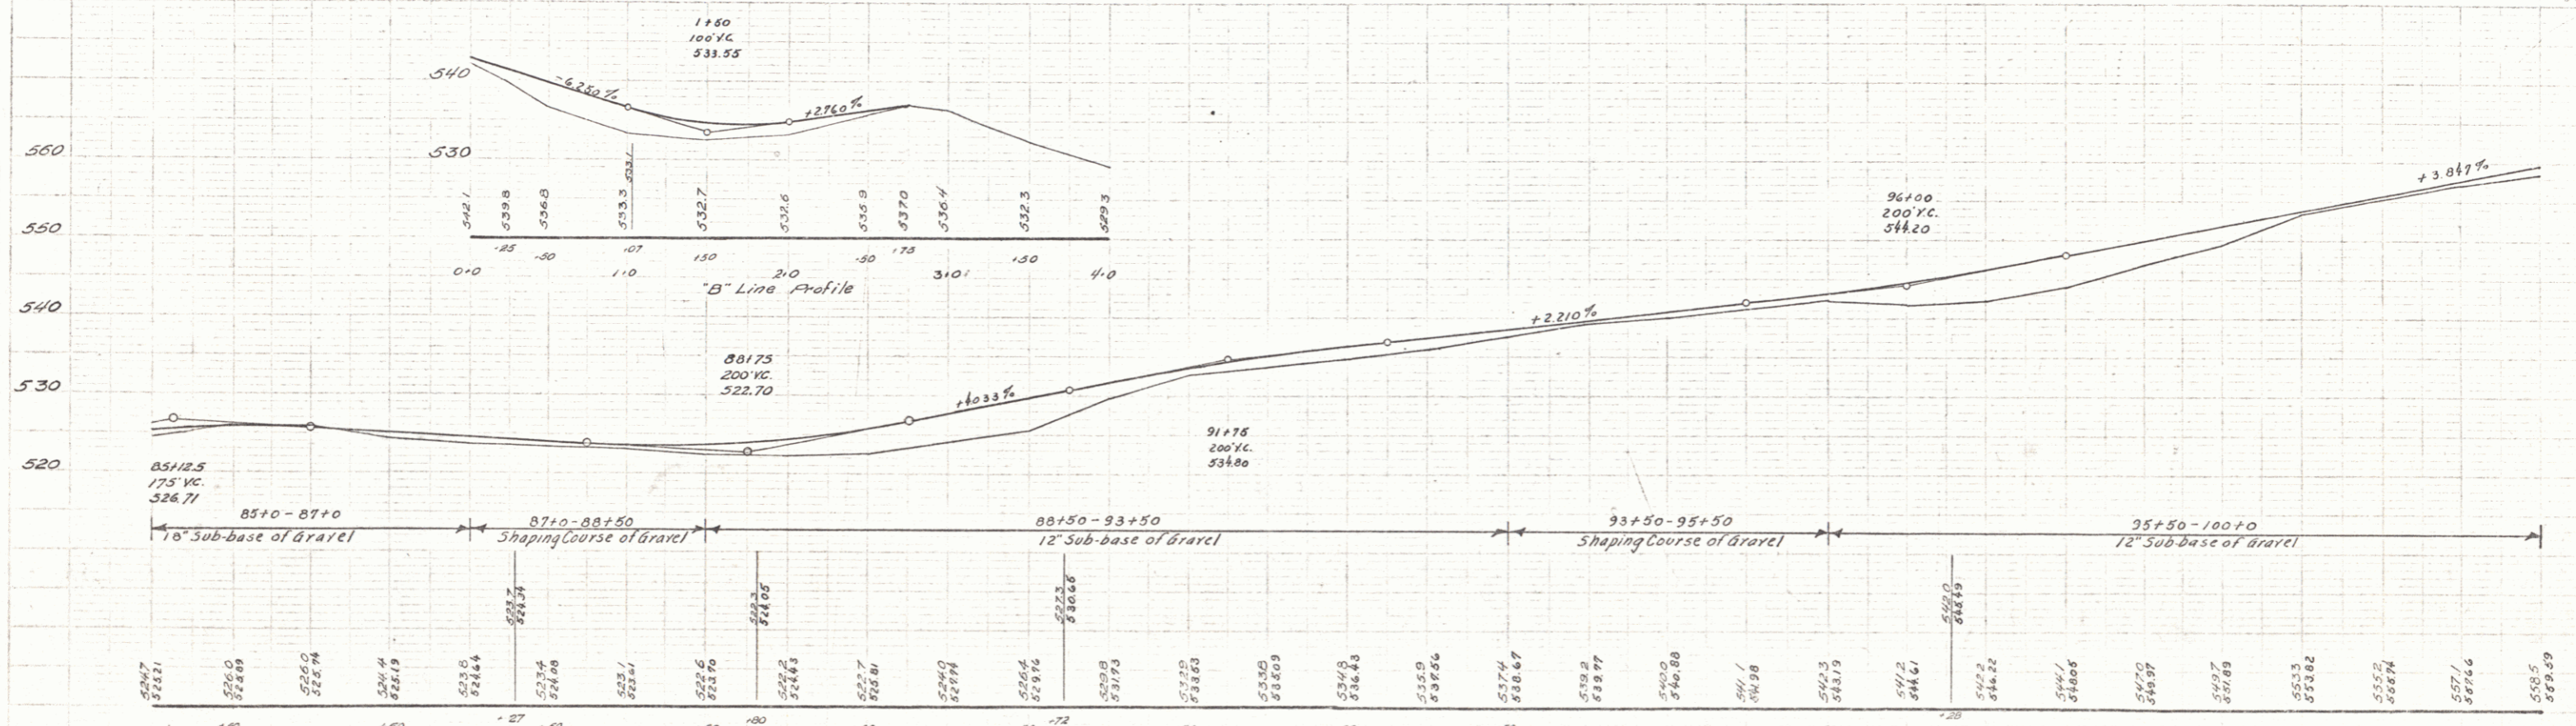


PARCEL	INSTRUMENT	DATE	GRANTOR	GRANTEE	RECORDED	REMARKS
A, B, C	W.D.O.E.	6-19-40	EDGAR HUNT ESTATE	ST. OF VT.	BOOK 13 PAGE 246-250	6-21-40
A'	W.D.O.E.	8-28-40	W.T. COREY	ST. OF VT.	13 280	9-11-40
A'' B'	W.D.O.E.	8-28-40	HANNAH C. ROOT	ST. OF VT.	13 281	9-11-40

FED. ROAD DIST. NO.	STATE	FISCAL YEAR	SHEET NO.	TOTAL SHEETS
9	Vt.	192 L	8	8

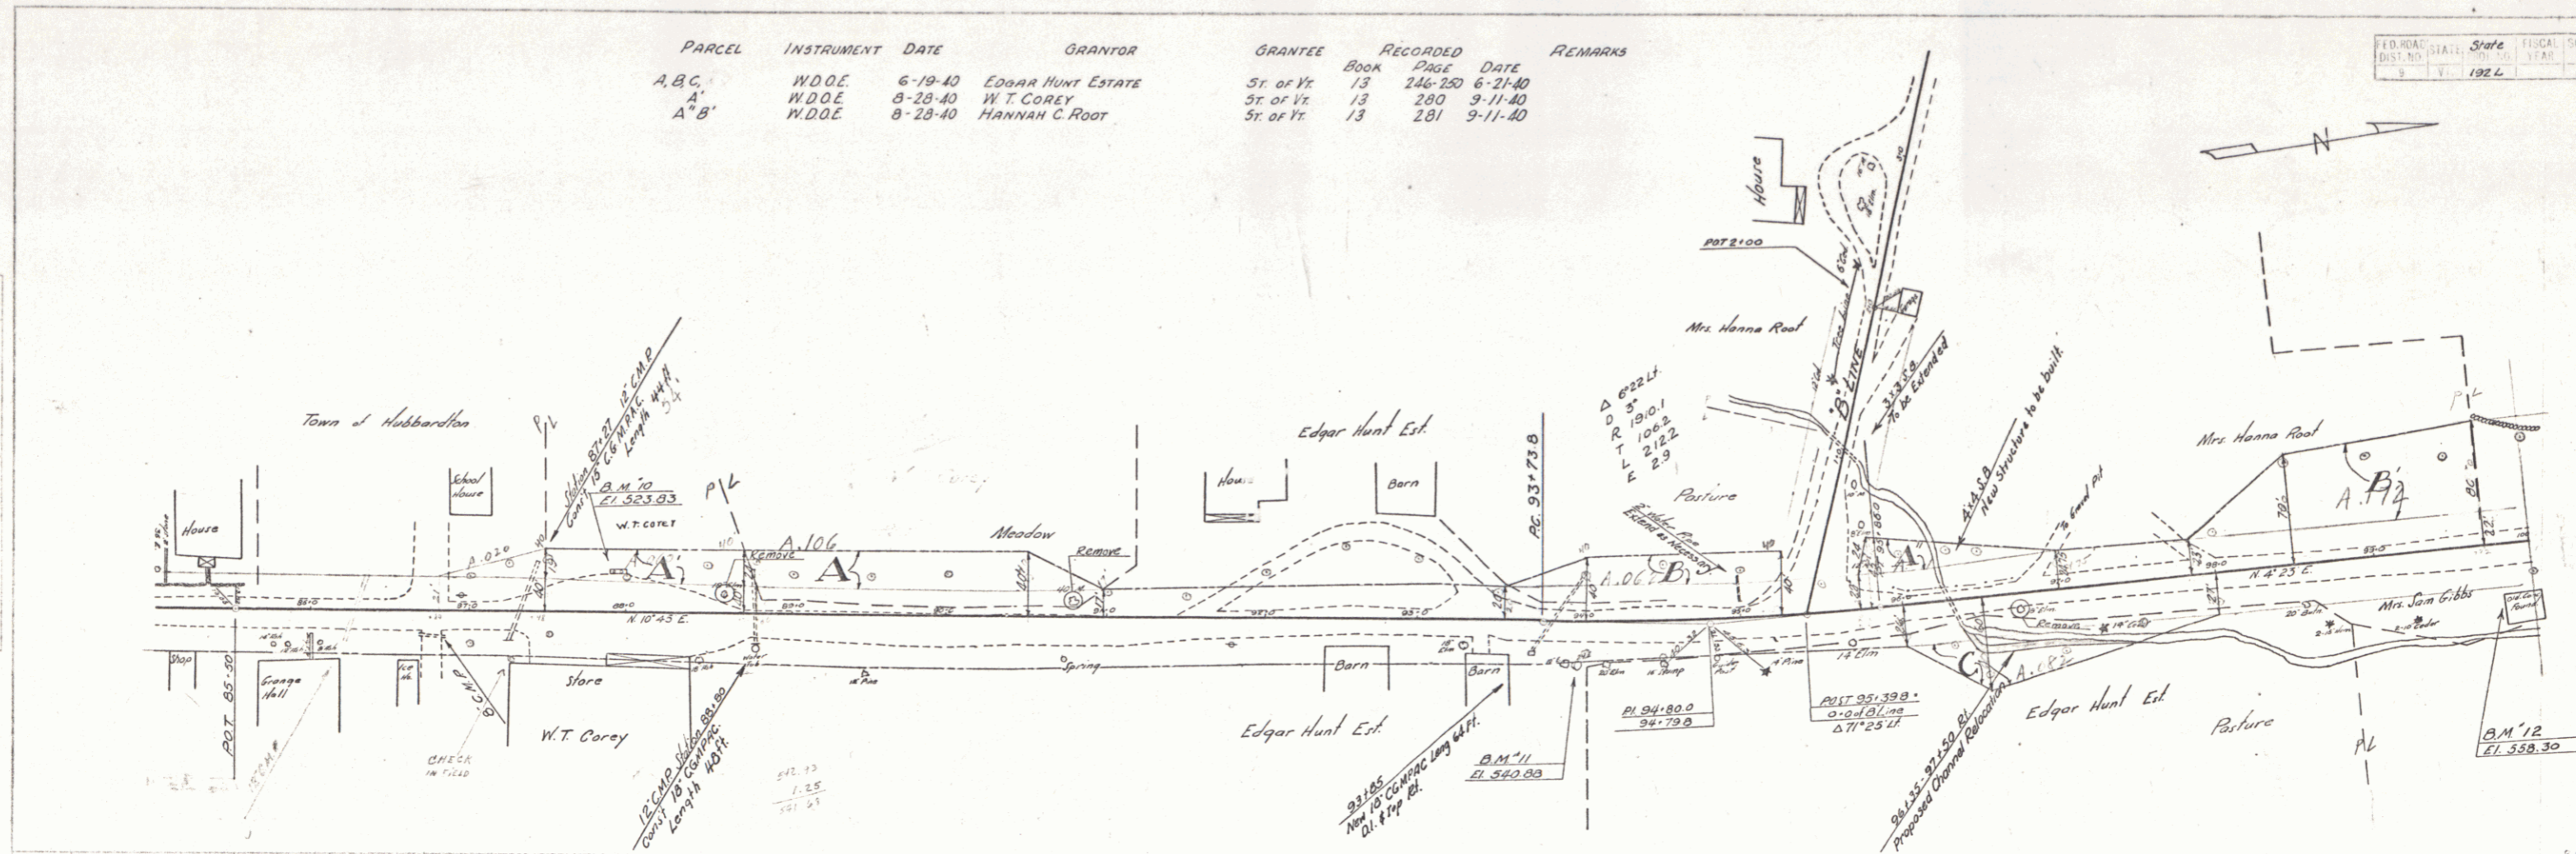

HUBBARDSTON  
SERIES STATE NO 192 L  
SHEET (3) OF