
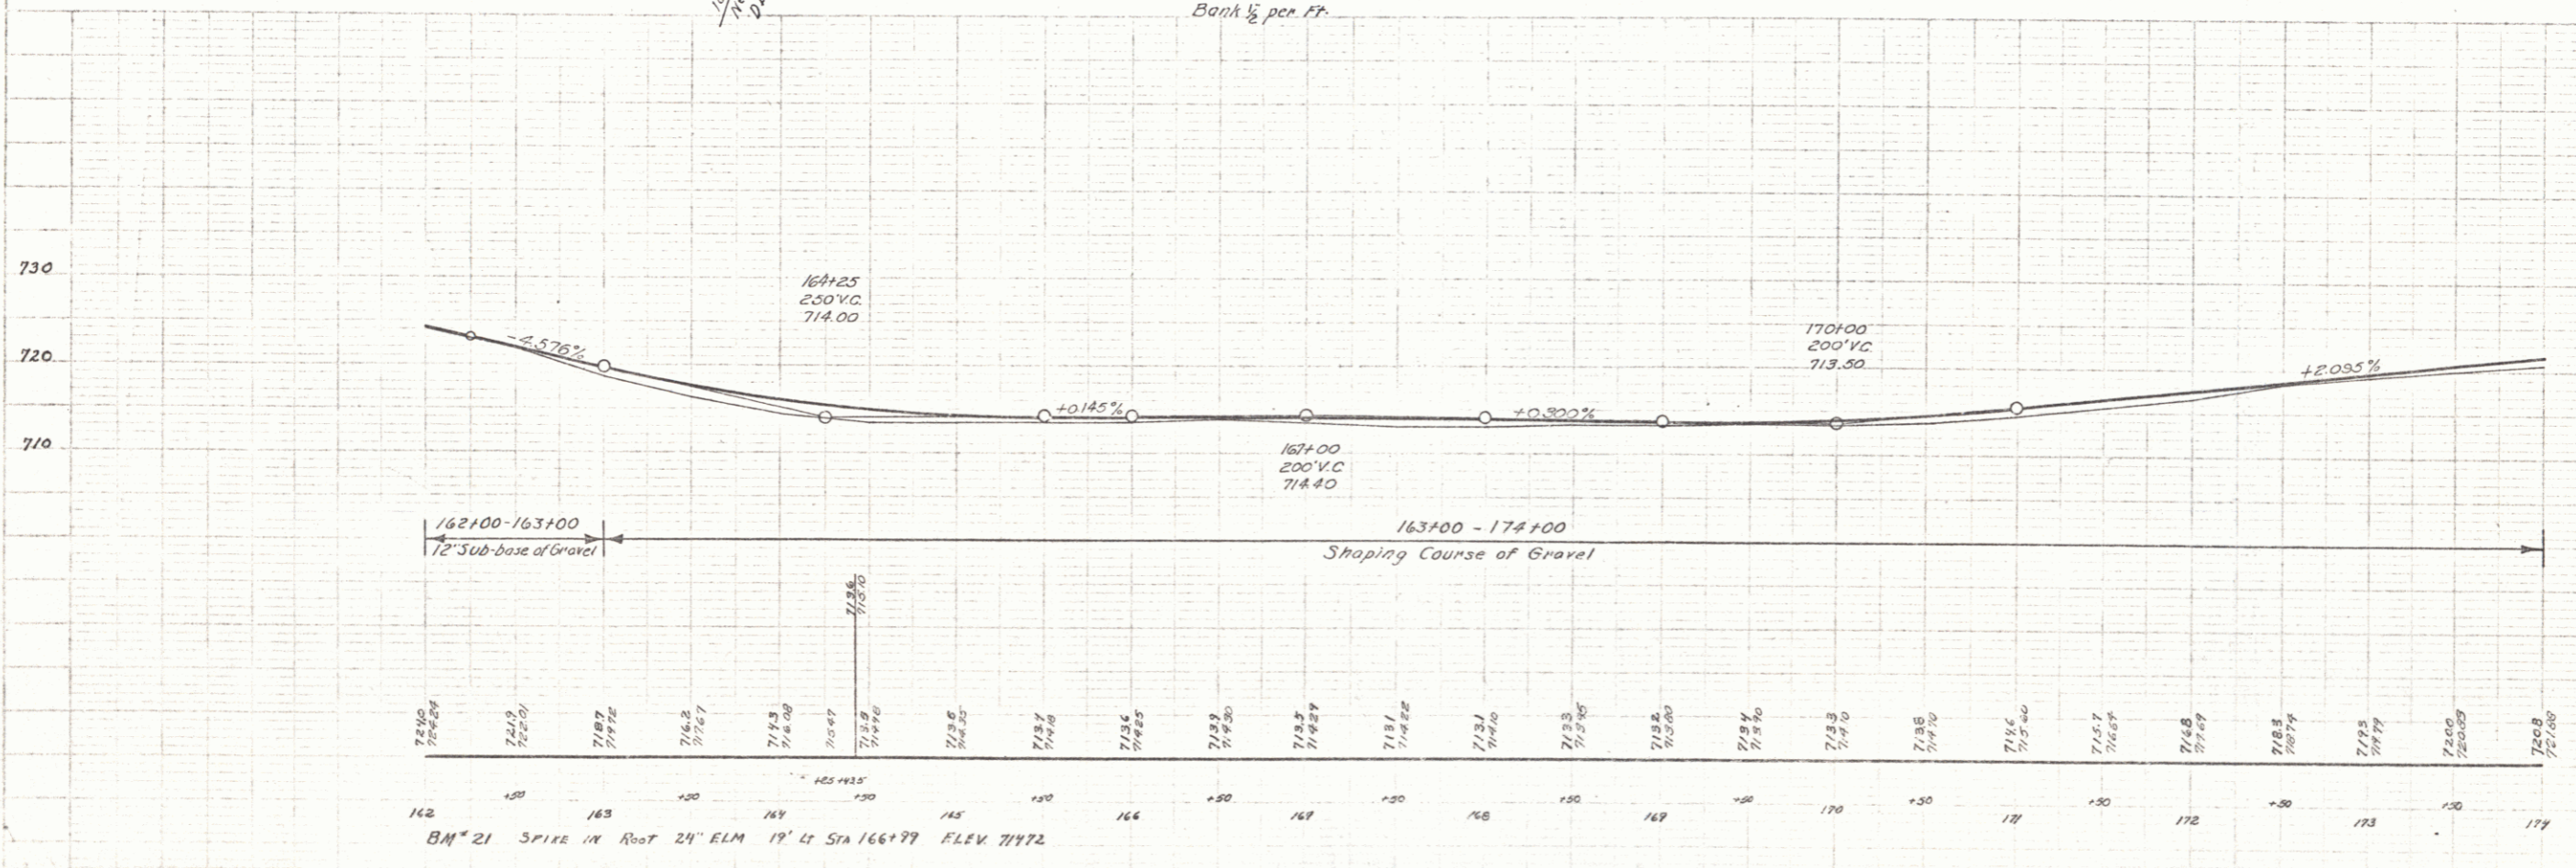


REV. CURVE  
 $\Delta 14^{\circ}45'LT$   
 $D 7^{\circ}$   
 $R 019.0$   
 $T 106.0$   
 $L 510.7$   
 $E 8.0$   
 Bank  $1\frac{1}{2}$  per Ft.

PARCEL INSTRUMENT DATE GRANTOR GRANTEE RECORDED REMARKS  
 B V.A.G.E. 1-25-41 D.B. GIBBS HUBBARDTON  
 57. OF 11 13 288.90 2.7.41

STATE	FISCAL YEAR	SHEET NO.	TOTAL SHEETS
OHIO	1941	13	112

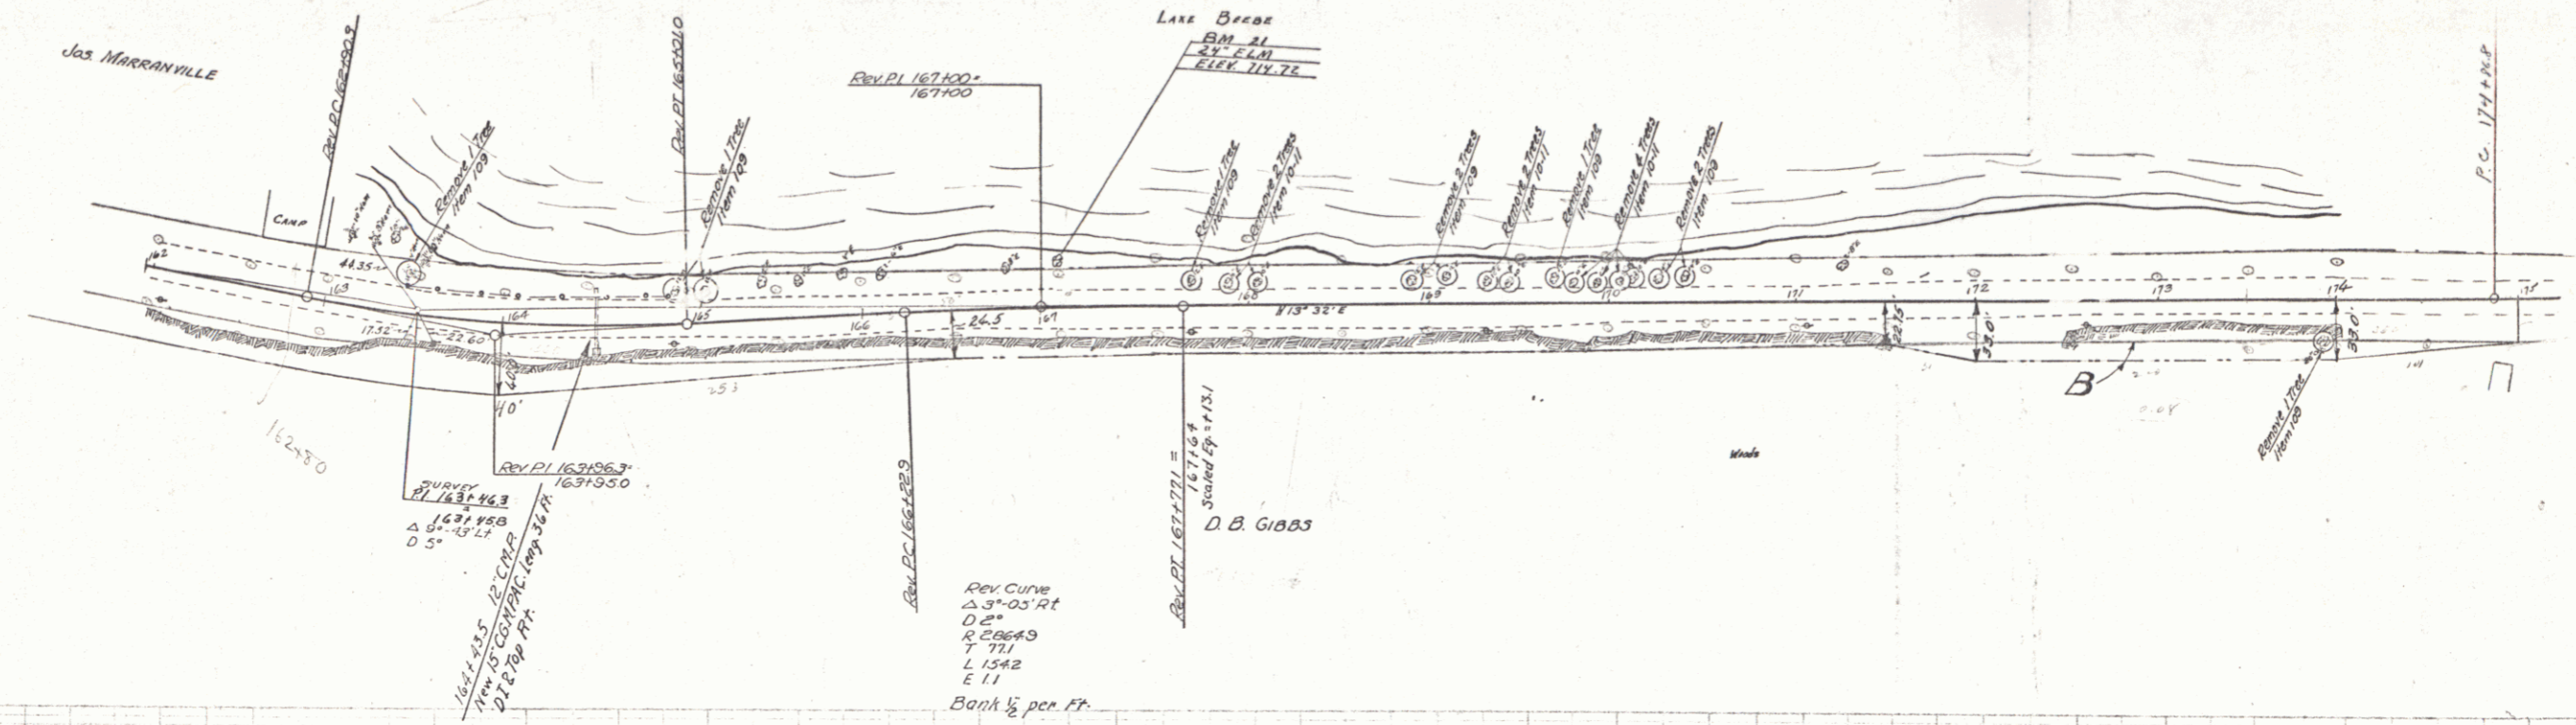

PLAN  
 SCALE 1" = 40'  
 BARRETT  
 D. GIBBS

PROFILE  
 SCALE 1" = 10'  
 BARRETT  
 D. GIBBS

HUBBARDTON  
 SERIES NO. 135  
 SHEET 13 OF 112