



1/10
SARGENT
SULLY
1/14
ALLEY
0/14

3/14
SARGENT
HUBBARD
0/14
HUBBARD
0/14

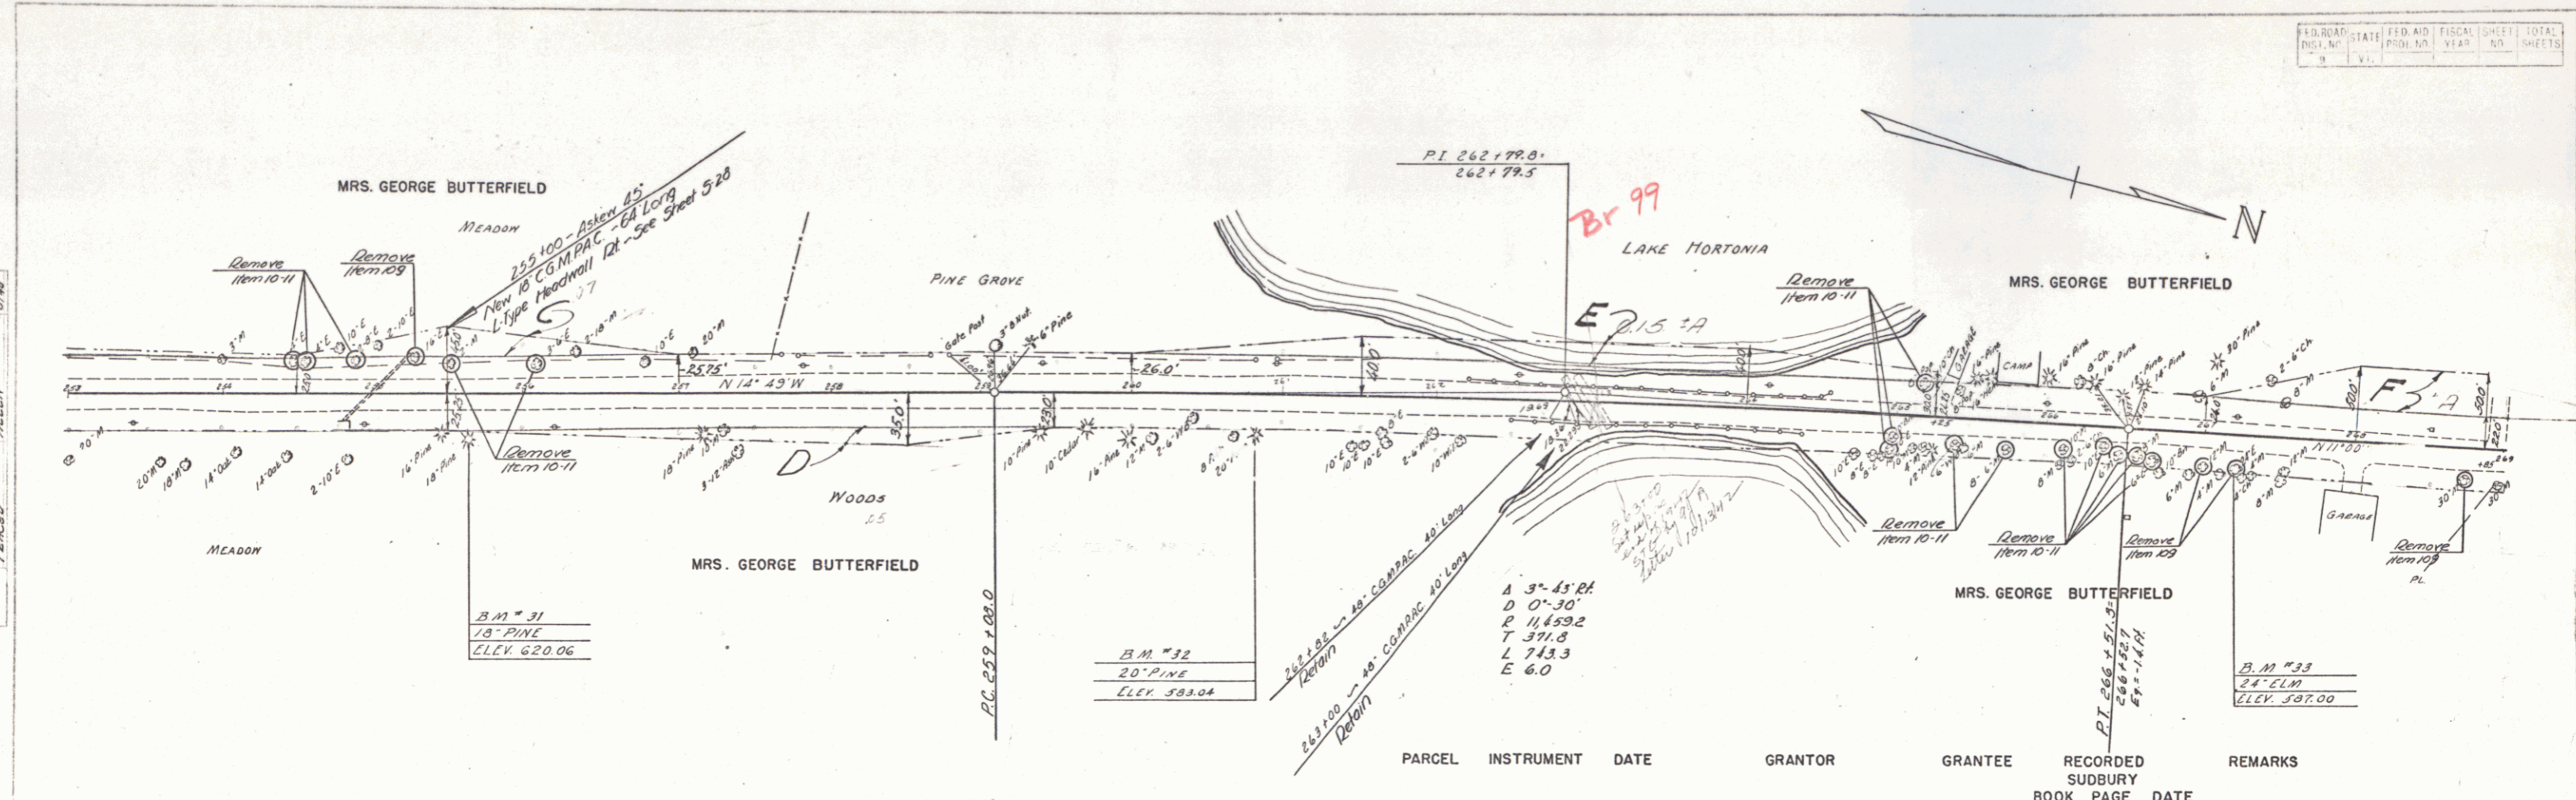

PARCEL	INSTRUMENT	DATE	GRANTOR	GRANTEE	RECORDED SUBBURY BOOK PAGE DATE	REMARKS
C, D, E, F	W.D.O.E.	10-8-41	VELLA HALLARY	BUTTERFIELD ST OF VT	12, 231-23 10-27-41	NEW CURV.

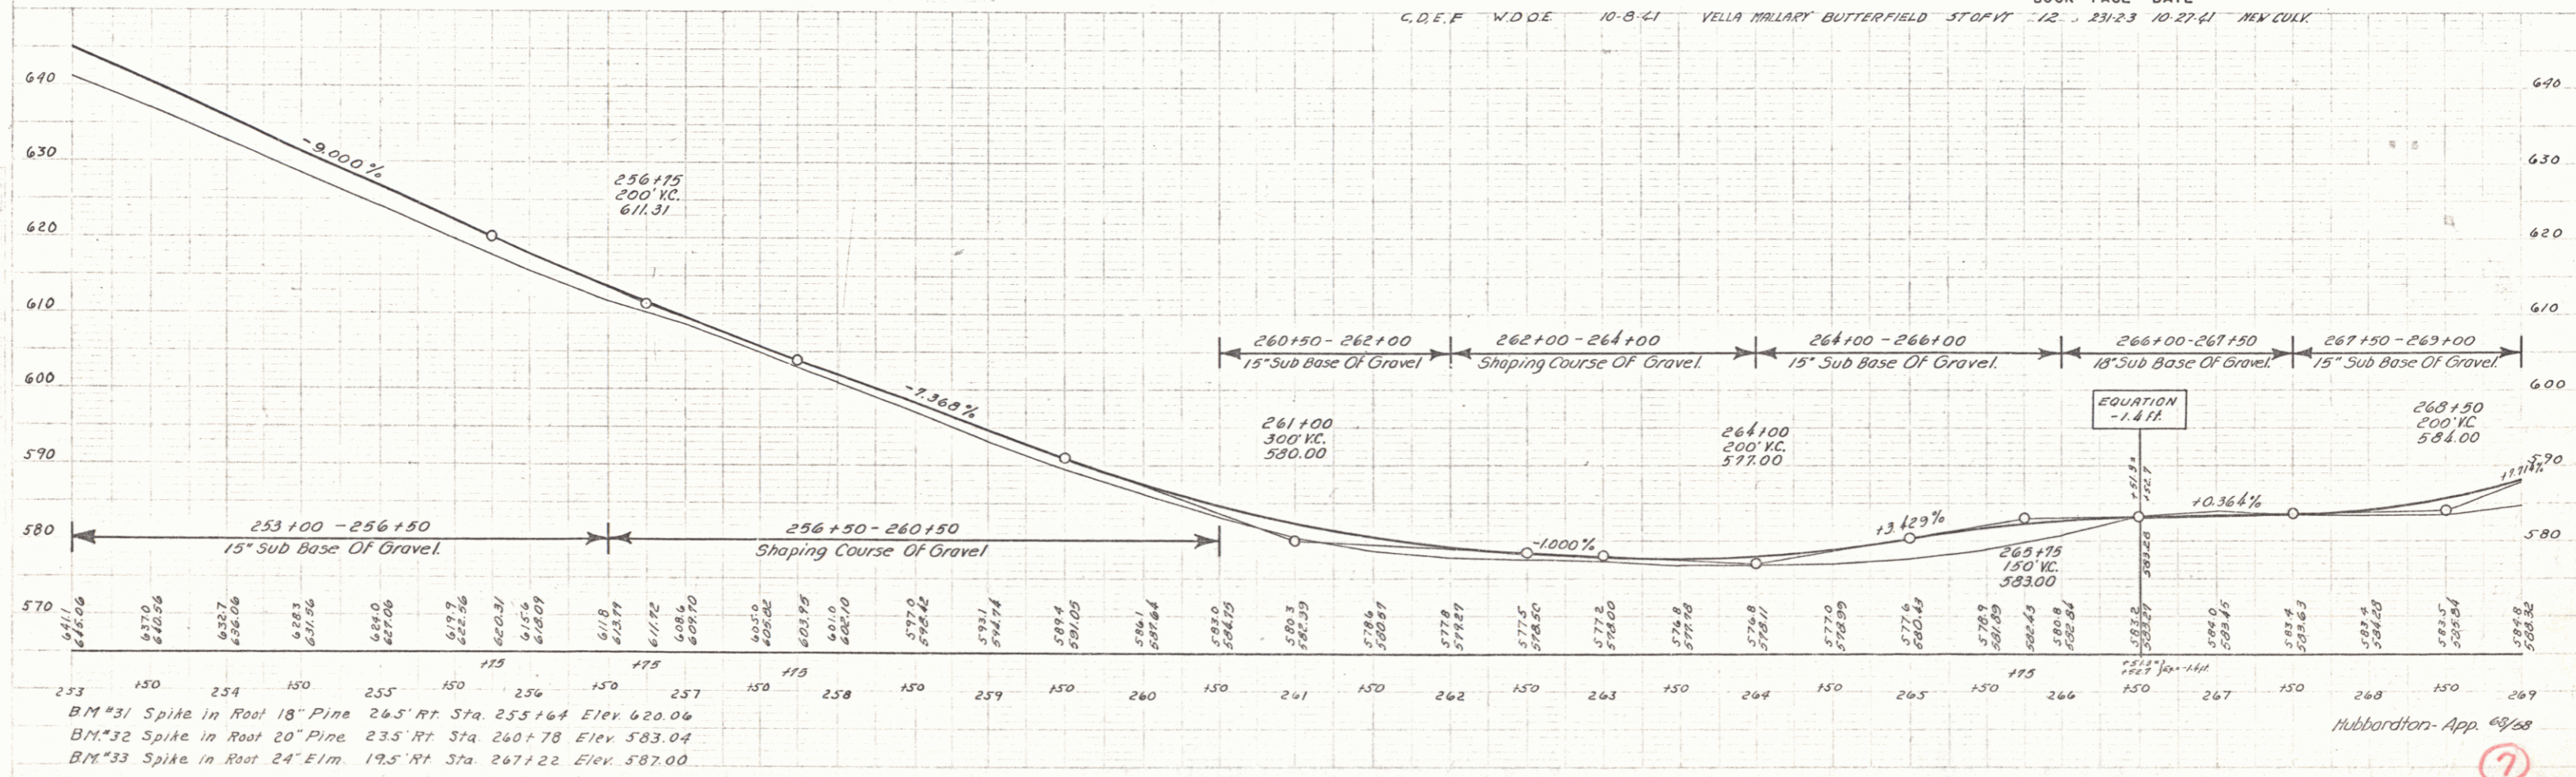

B.M. #31 Spike in Root 18" Pine 265' Rt. Sta. 253+64 Elev. 620.06
 B.M. #32 Spike in Root 20" Pine 235' Rt. Sta. 260+78 Elev. 583.04
 B.M. #33 Spike in Root 24" Elm 195' Rt. Sta. 267+22 Elev. 587.00

Hubbardton-App. 6/68