


PARCEL	INSTRUMENT	DATE	GRANTOR	GRANTEE	RECORDED SUBURBY	REMARKS
B	W.D.O.E.	12-22-41	CHARLES & HELEN ST. JOHN	ST. OF VT.	BOOK 12	
A	W.D.O.E.	2-10-42	ARTHUR C. MALLORY	ST. OF VT.	PAGE 253	1-27-42
C, D	W.D.O.E.	4-13-45	C.E. MALLORY	ST. OF VT.	DATE 13	233-4-5 8-10-45

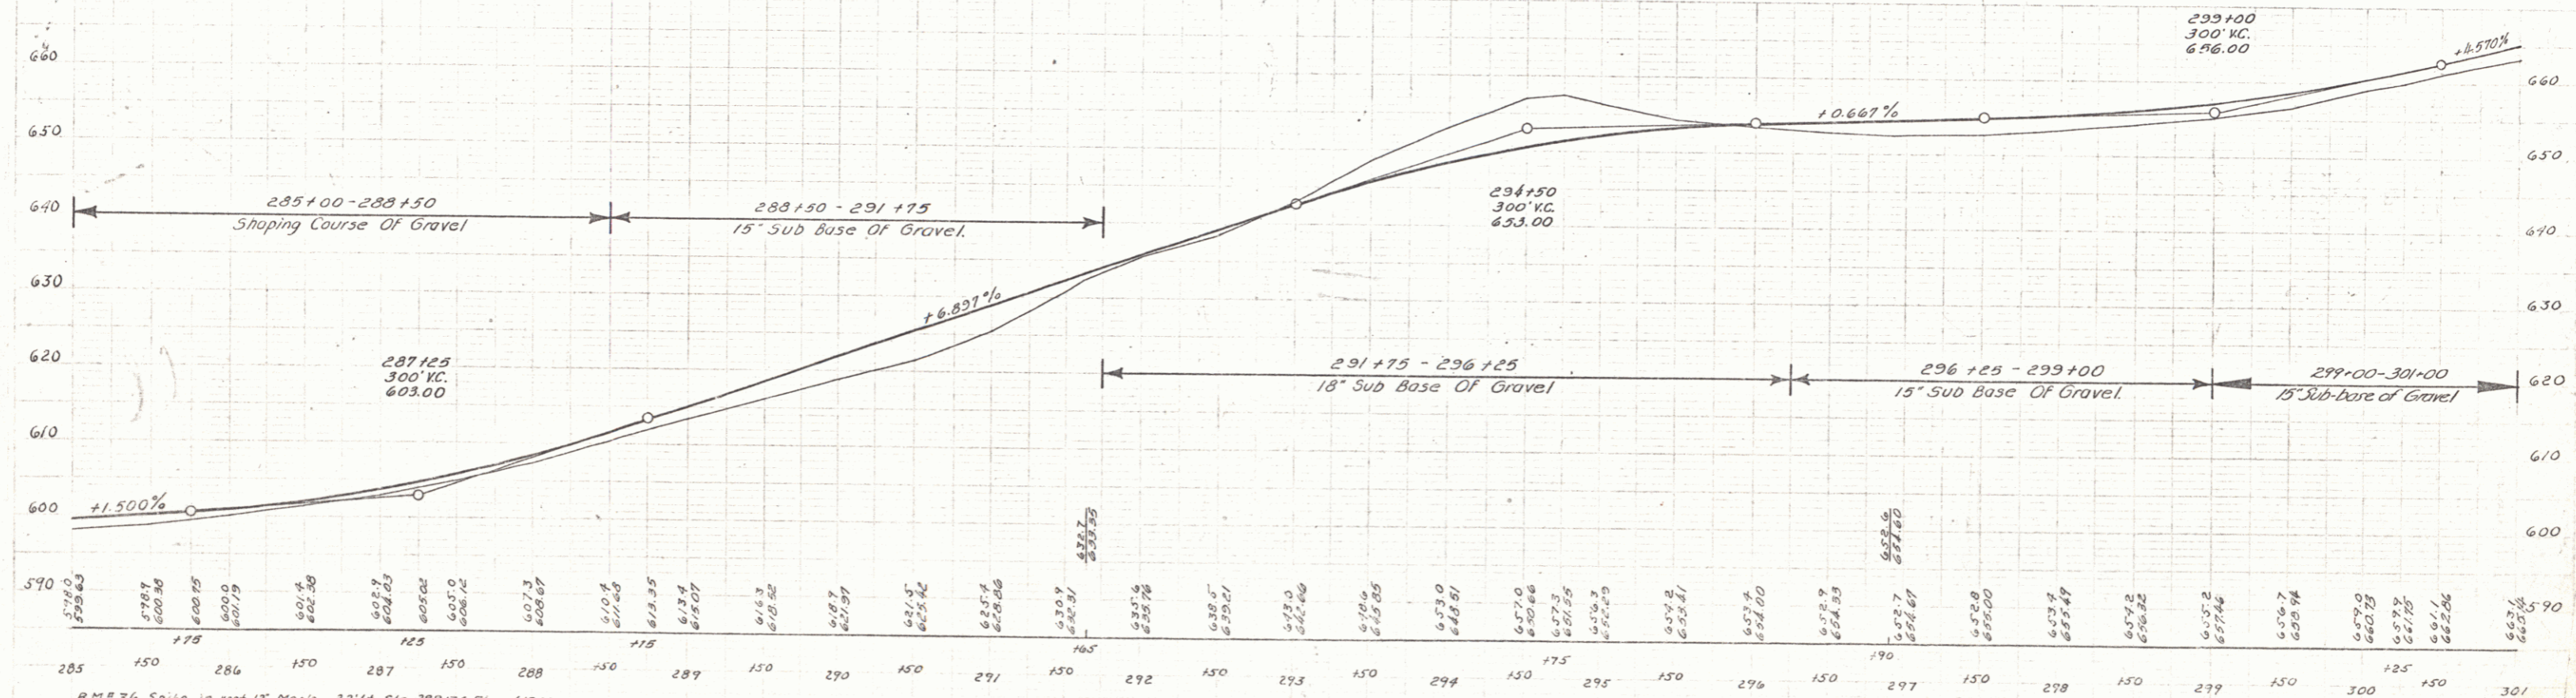

B.M. #36 Spike in root 12' Maple 22' Lt Sta 288+74 Elev 430.3  
 B.M. #37 Spike in root 24' Pine 26' Rt Sta 295+15 Elev 657.30

Hibbard 100-App 69/68  
 Sudbury  
 St. 192-L