

INDEX OF SHEETS

SHEET NO. 1	TITLE PAGE	DOUBLE TACK COAT OF REFINED TAR WITH PEA STONE SEAL, ITEM 29A
2	TYPICAL CROSS-SECTION OF IMPROVEMENT BANKING AND WIDENING TABLES	
4-10	PLAN AND PROFILE	
11	STANDARD STRUCTURE SHEET	S-28 PIPE CULVERTS
12		S-30 WOOD GUARD RAIL
13		S-30A STANDARD UNDERDRAIN
14		S-40 BARRICADES, SIGNS AND LIGHTS
15		S-41 TYPICAL GRADING CROSS-SECTIONS
16-30	CROSS SECTIONS	

STANDARD STRUCTURE SHEETS APPROVED BY THE CHIEF ENGINEER VERMONT STATE DEPARTMENT OF HIGHWAYS

S-28 APRIL 26, 1941  
S-30 MAY 12, 1941  
S-30A APRIL 19, 1941  
S-40 DEC. 18, 1945

STATE OF VERMONT  
STATE HIGHWAY DEPARTMENT

PLAN AND PROFILE OF PROPOSED STATE HIGHWAY

SECONDARY PROJECT

TOWN OF SUDBURY


HUBBARDTON - MIDDLEBURY ROAD

VERMONT ROUTE 30


BEGINNING AT A POINT 2958 FEET NORTHERLY FROM THE HUBBARDTON SUDBURY TOWN LINE AND EXTENDING NORTHERLY 9945.6 FEET.

LENGTH OF PROJECT 9945.6 FEET = 1.884 MILE  
9948.0

FED. ROAD DIST. NO.	STATE	PROJ. NO.	SHEET NO.	TOTAL SHEETS
9	Vt.	S34(1)	1	30

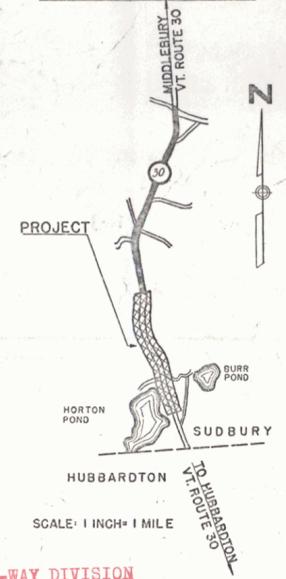

RIGHT-OF-WAY DIVISION  
TOWN FILE  
PERPETUAL  
Town of U30  
(To Be Returned To R.O.W. Division)

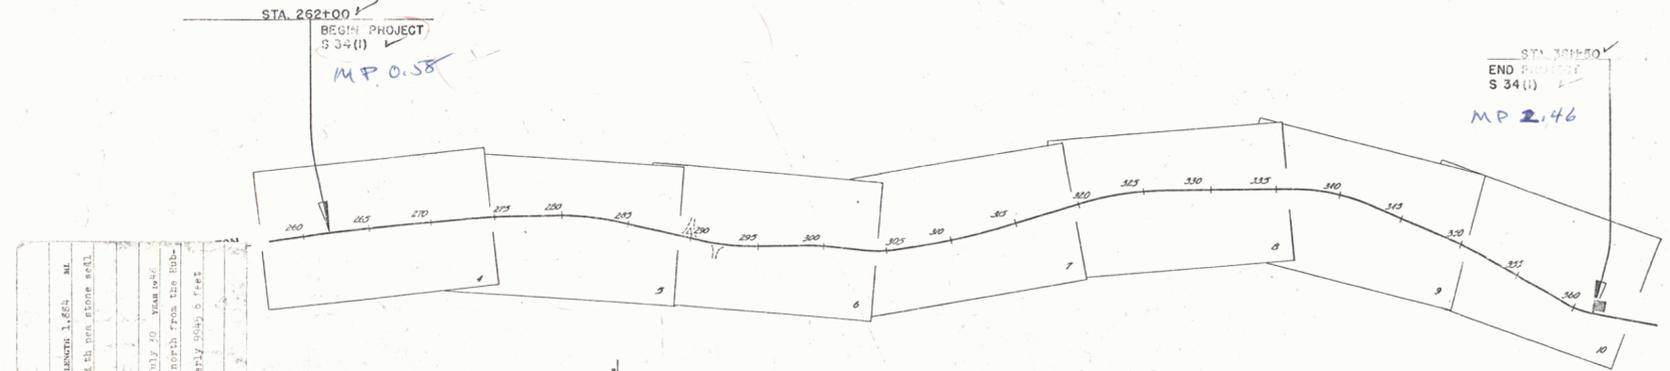

LENGTH 1.884 MI.  
NUMBER S 34(1)  
TYPE DOUBLE TACK COAT OF REFINED TAR WITH PEA STONE SEAL  
CONTRACTOR Frank W. Whitcomb  
DATE July 30 1948  
CHECKED Beginning at a point 2958 feet north from the Hubbardton-Sudbury town line and extending northerly 9945.6 feet

GROUND ELEVATION	DATUM	LINE
GRADE ELEVATION	DATUM	LINE

CURVE DATA

DEFLECTION ANGLE	Δ
DEGREE OF CURVE	D
RADIUS OF CURVE	R
TANGENT DISTANCE	T
LENGTH OF CURVE	L
EXTERNAL DISTANCE	E
POINT OF INTERSECTION	P. I.
POINT OF CURVE	P. C.
POINT OF TANGENT	P. T.
POINT ON TANGENT	P. O. T.

SCALES

TITLE	1" = 500'
TYPICAL	1" = 2'
PLAN	1" = 50'
PROFILE HORIZONTAL	1" = 50'
PROFILE VERTICAL	1" = 10'
CROSS SECTIONS	1" = 5'

PREPARED BY I. A. TRASK  
RESIDENT ENGINEER B. BLANCHARD

RECORD PLANS

THESE PLANS ARE SUBJECT TO SUCH REVISIONS AS MAY BE REQUIRED BY THE PUBLIC ROADS ADMINISTRATION OR THE COMMISSIONER OF HIGHWAYS.  
CONSTRUCTION IS TO BE CARRIED ON IN ACCORDANCE WITH THE PLANS AND THE STANDARD ROAD AND BRIDGE SPECIFICATIONS OF 1936, AS APPROVED DECEMBER 28TH, 1936 BY THE PUBLIC ROADS ADMINISTRATION, INCLUDING ALL SUBSEQUENT APPROVED REVISIONS AND SUCH REVISED SPECIFICATIONS AND SPECIAL PROVISIONS AS ARE SUBMITTED WITH THE PLANS.

APPROVED: 3 Nov 1947  
I. A. Trask  
HIGHWAY ENGINEER

APPROVED: 5 Dec 1947  
Earl A. Tolson  
DISTRICT HIGHWAY COMMISSIONER

SERIES S NO. 34(1) FILED  
SHEET 1 OF 30

APPROVED: 3 Nov 1947  
H. E. Laing  
COMMISSIONER OF HIGHWAYS  
SUBMITTED BY ORDER OF THE STATE HIGHWAY BOARD

Pin # 00R388

RECOMMENDED FOR APPROVAL  
APPROVED