
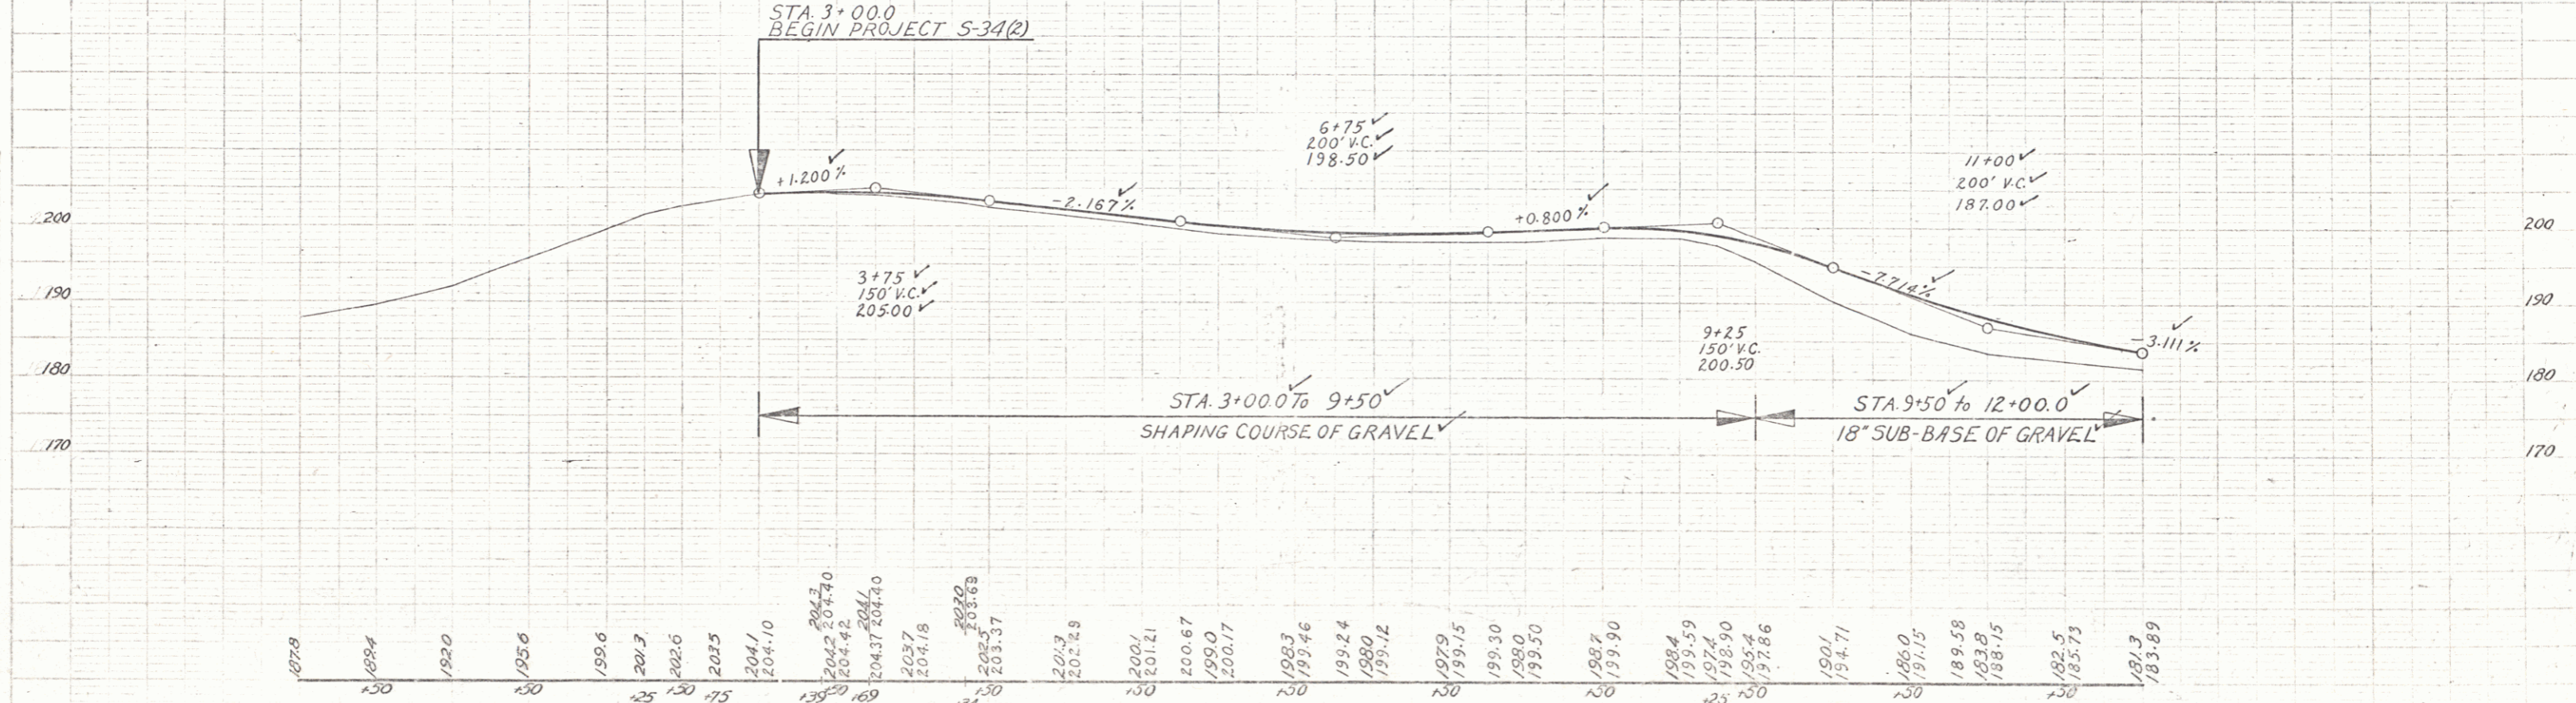


PLAN  
 DATE: 5-27-47  
 DRAWN BY: Spaulding Stevens  
 CHECKED BY: J. M. W. C. C. C.  
 NOTE: BOUNDARY MARKERS SHOWN ARE NOT TO BE DELETED.

PROFILE  
 DATE: 5-27-47  
 DRAWN BY: Spaulding Stevens  
 CHECKED BY: J. M. W. C. C. C.

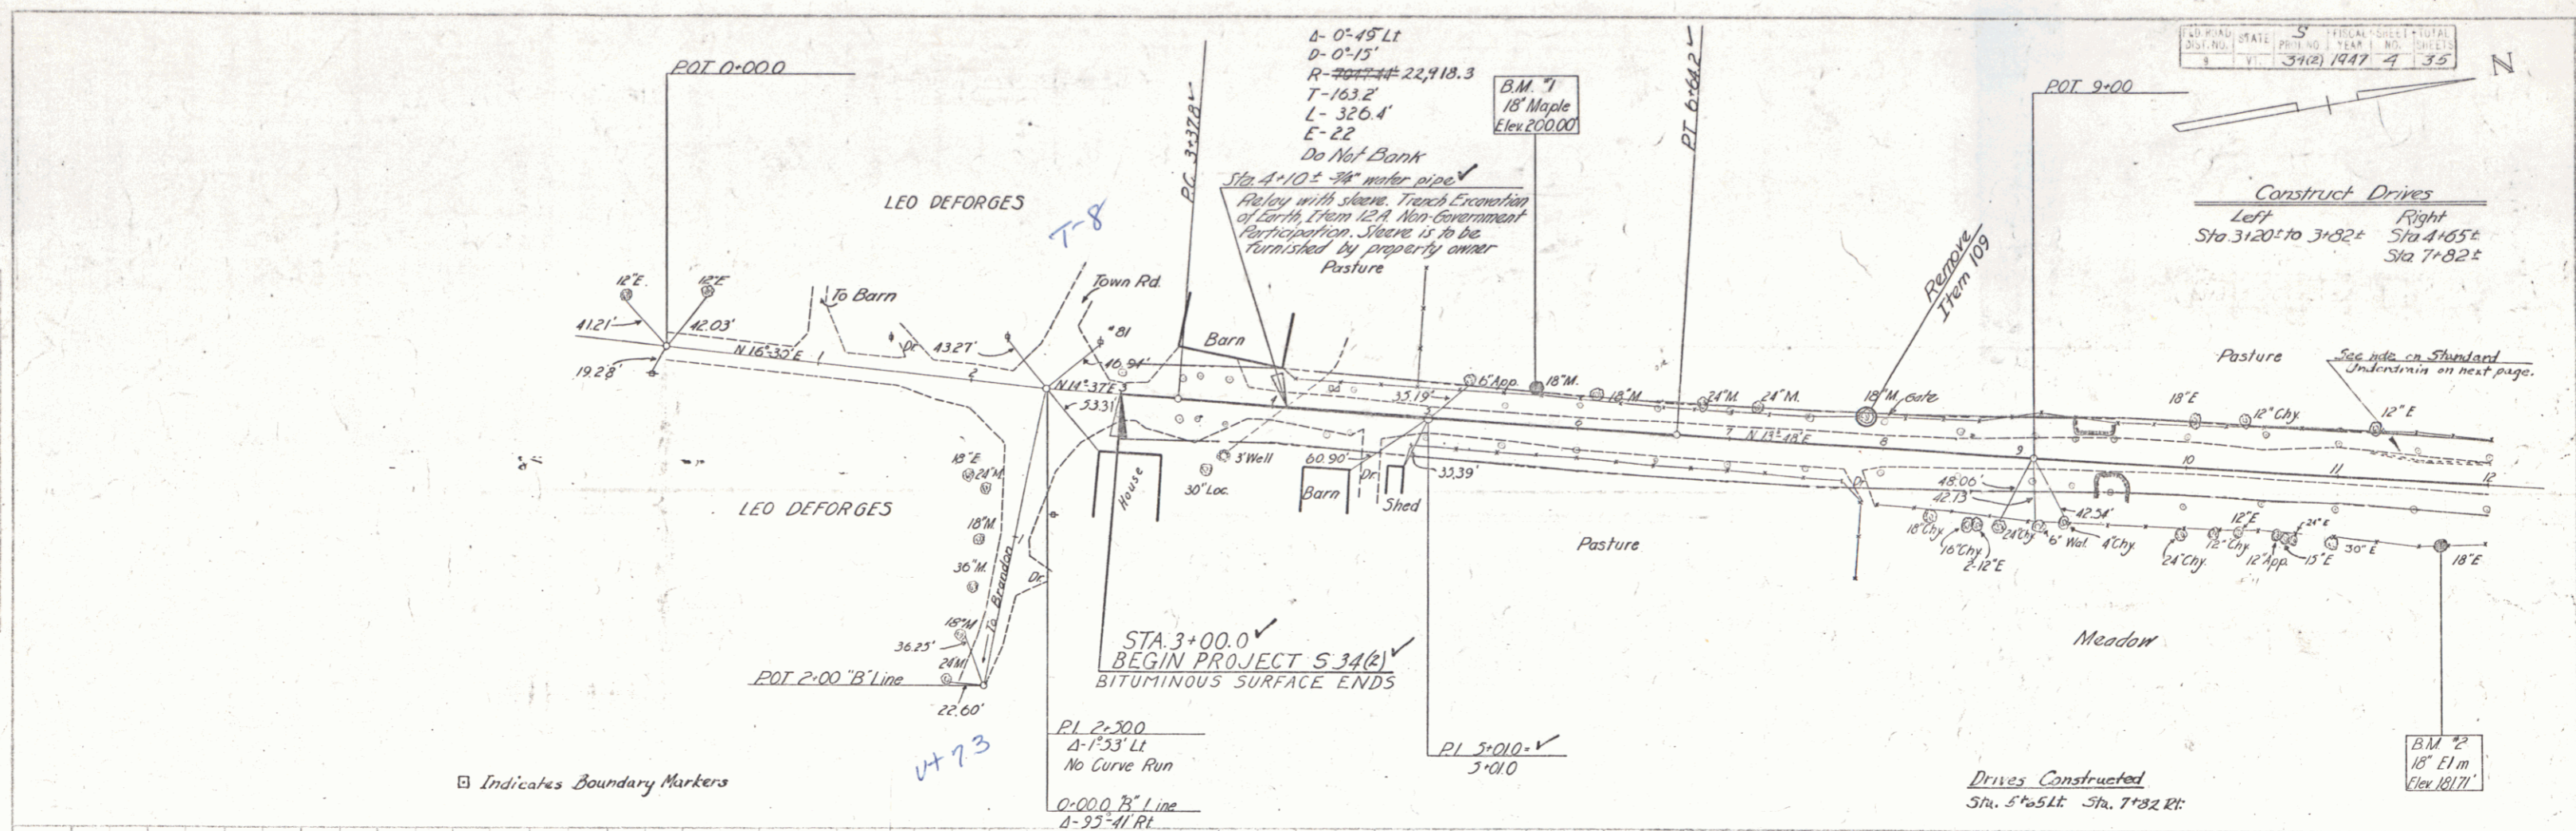

B.M. #1 S.I.R. 18' Maple 20' Lt. Sta. 5+70 Elev. 200.00  
 B.M. #2 S.I.R. 18' Elm. 38' Rt. Sta. 11+69 Elev. 181.71