


PLAN  
 CHECKED BY: [Signature]  
 DATE: [Date]  
 DRAWN BY: [Signature]

GRADE  
 CHECKED BY: [Signature]  
 DATE: [Date]  
 DRAWN BY: [Signature]

PARCEL	INSTRUMENT	DATE	GRANTOR	GRANTEE	RECORDED BOOK	RECORDED PAGE	RECORDED DATE	REMARKS
A	W.D.O.E.	10-14-47	LEO & YVETTE DESFORGES	ST. OF VT.	14	107-108	10-25-47	

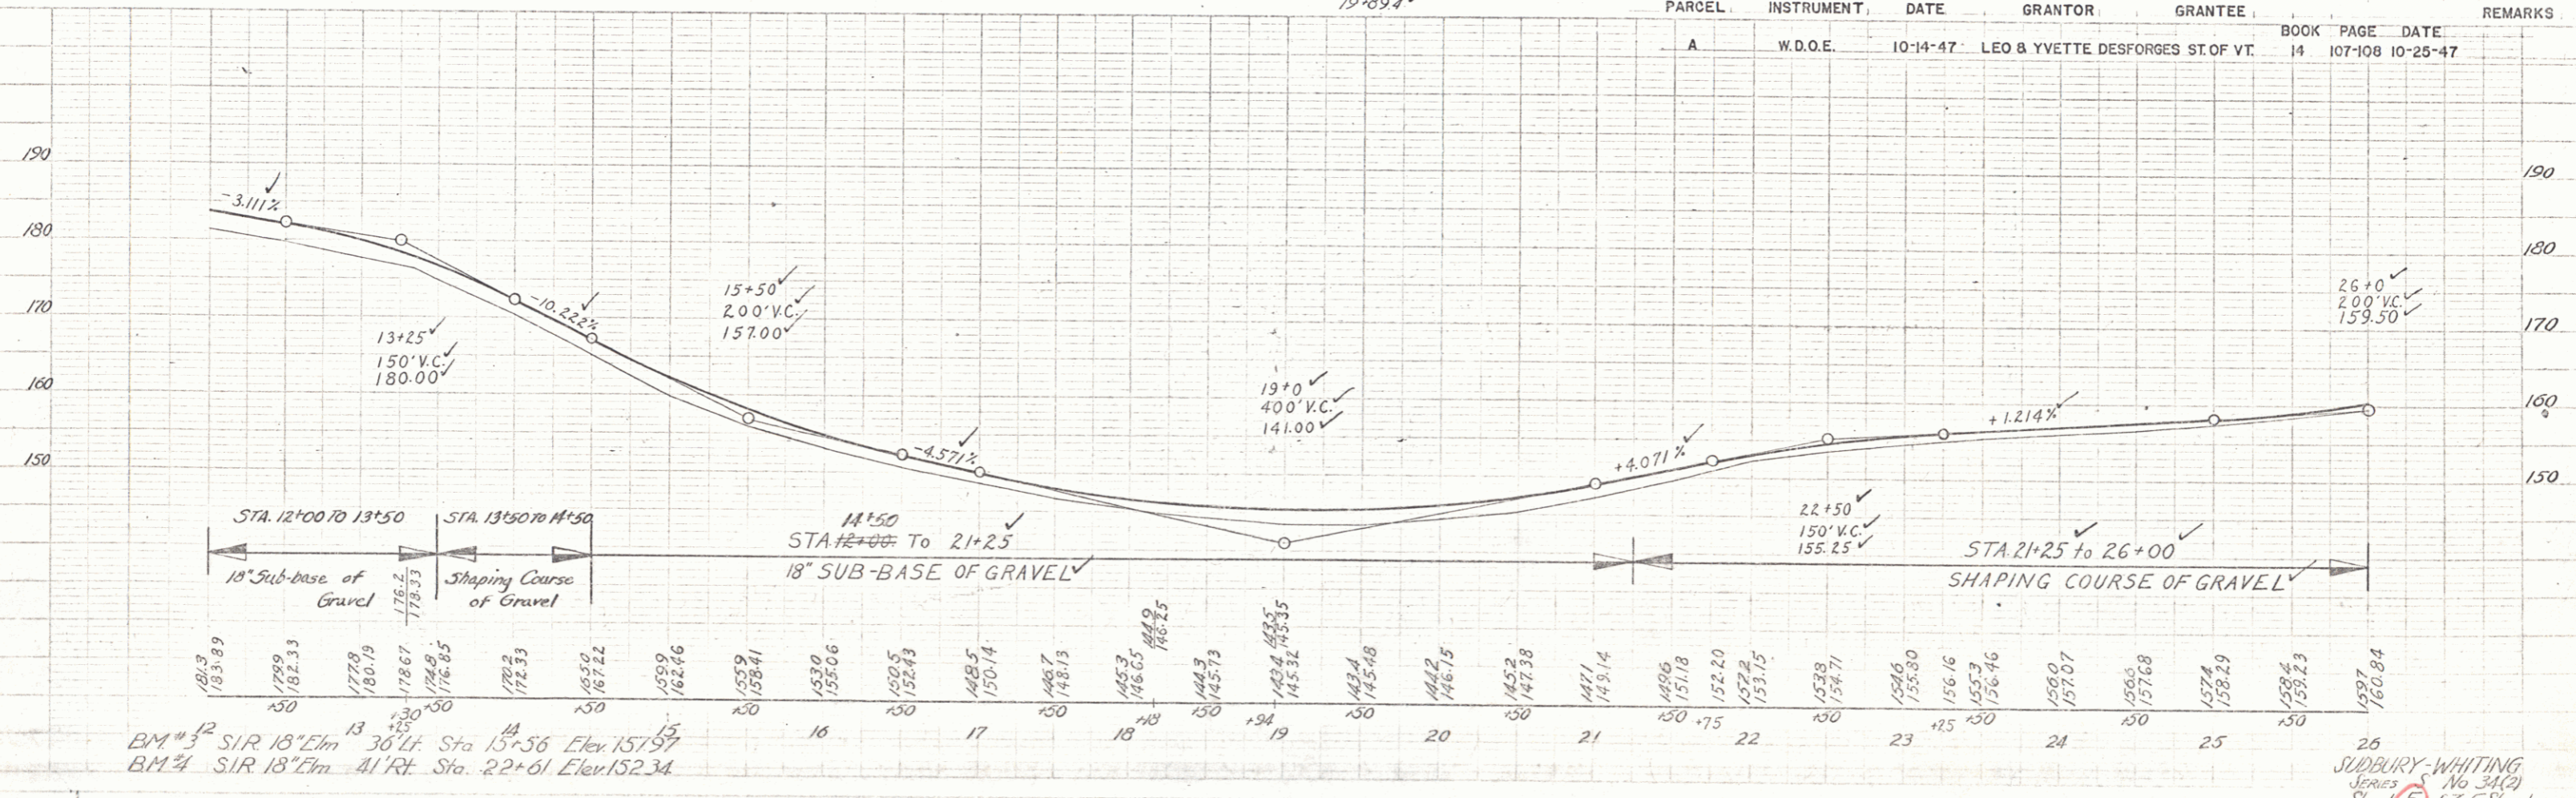

BM #2 SIR 18\"/>

SUBBURY-WHITING  
 Maps No 34(2)  
 Sheet 5 of 35 Sheets