
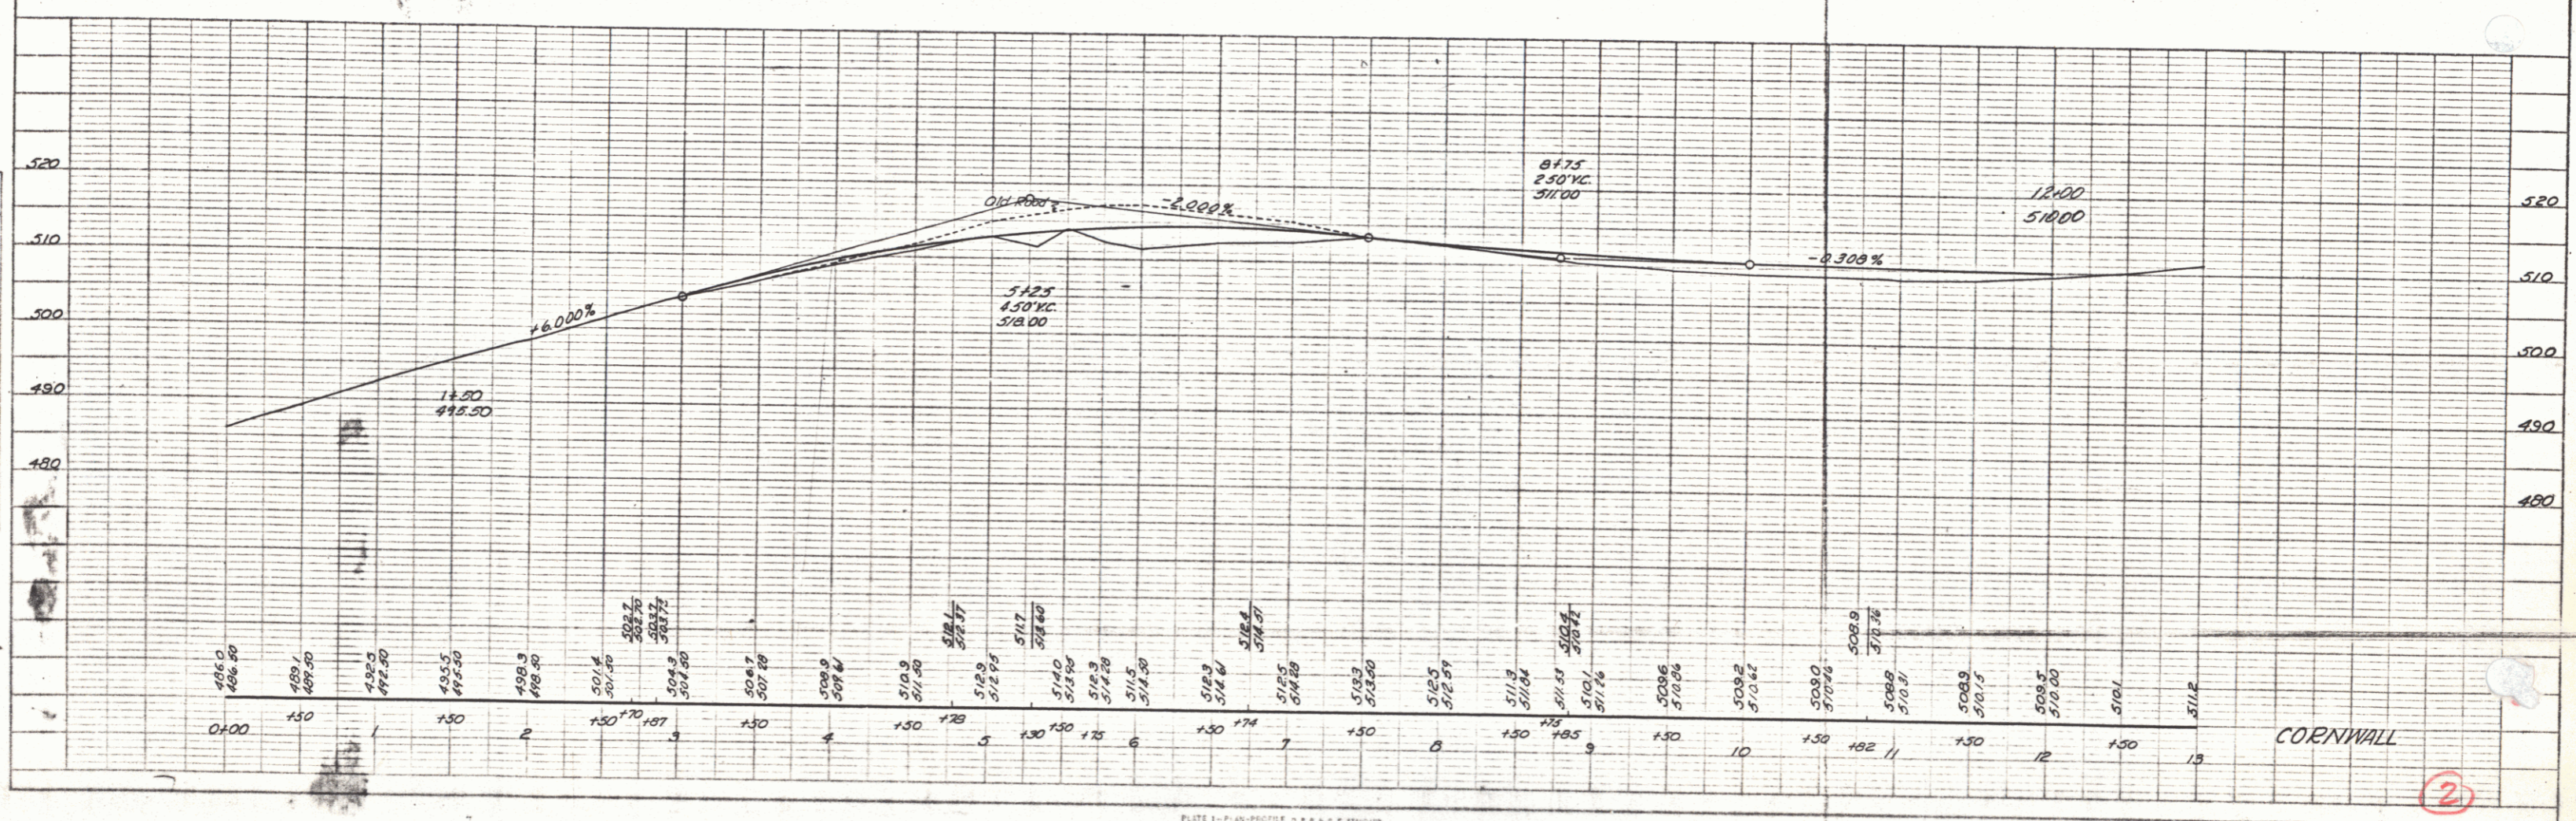


PLAN
 PROJECT: ...
 DRAWN BY: ...
 CHECKED BY: ...
 DATE: ...

PROFILE
 DATE: 12-76
 DRAWN BY: J. J. ...
 CHECKED BY: ...
 DATE: ...

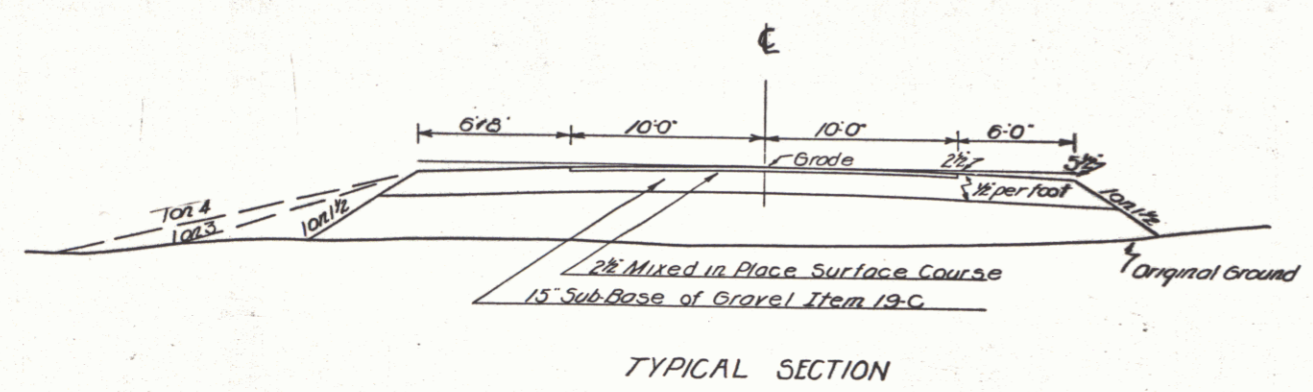

CORNWALL

2