


PLAN  
 DRAWN BY: *Speckling*  
 CHECKED BY: *George*  
 DATE: *7/19/74*

OFFICE  
 CHECKED BY: *George*  
 DATE: *7/19/74*

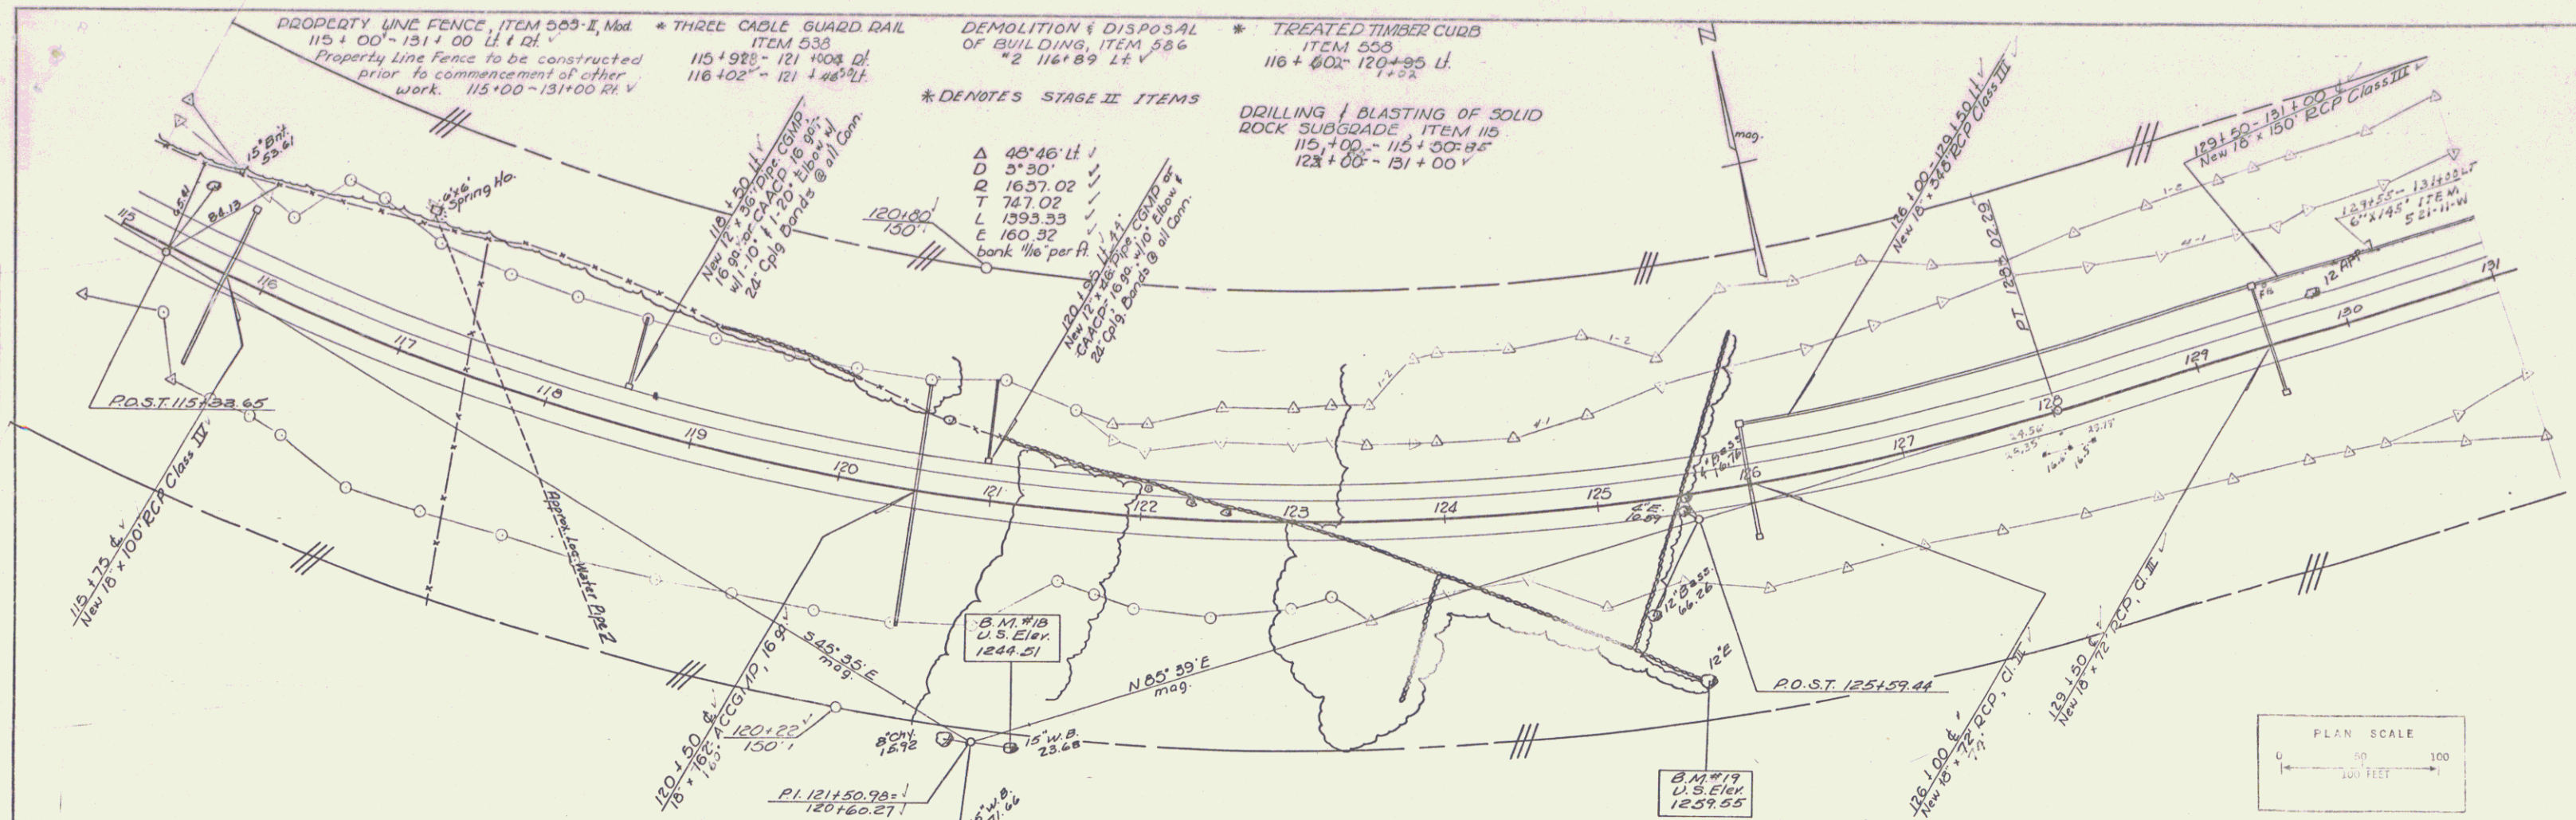

JUL 19 1974  
 STAGE 2 CONSTRUCTION  
 130  
 BERLIN-BARRE  
 F-137-1 (4)  
 Sheet 53 of 105