

DRAWN BY
 S. J. WILSON
 CHECKED BY
 W. W. WILSON
 DATE
 11/15/74

PROFILE
 SUBMITTED BY
 W. W. WILSON
 CHECKED BY
 W. W. WILSON
 DATE
 11/15/74

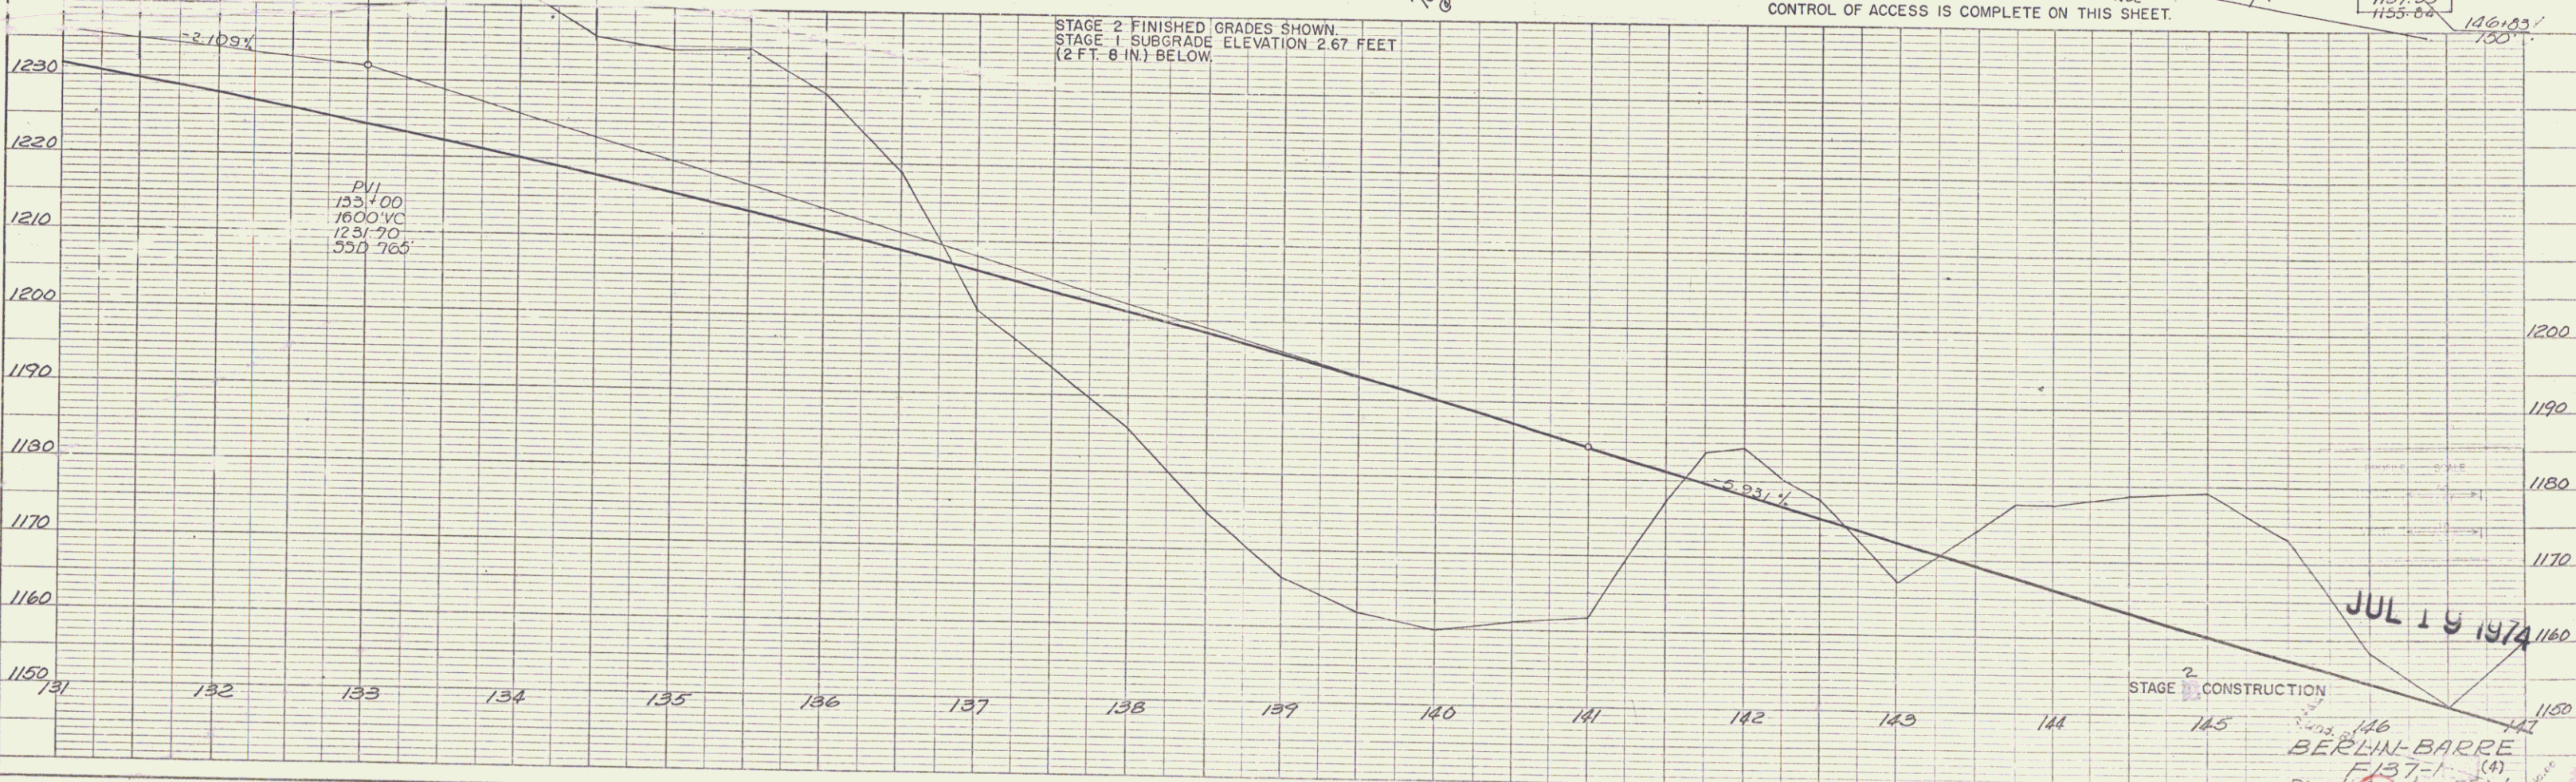
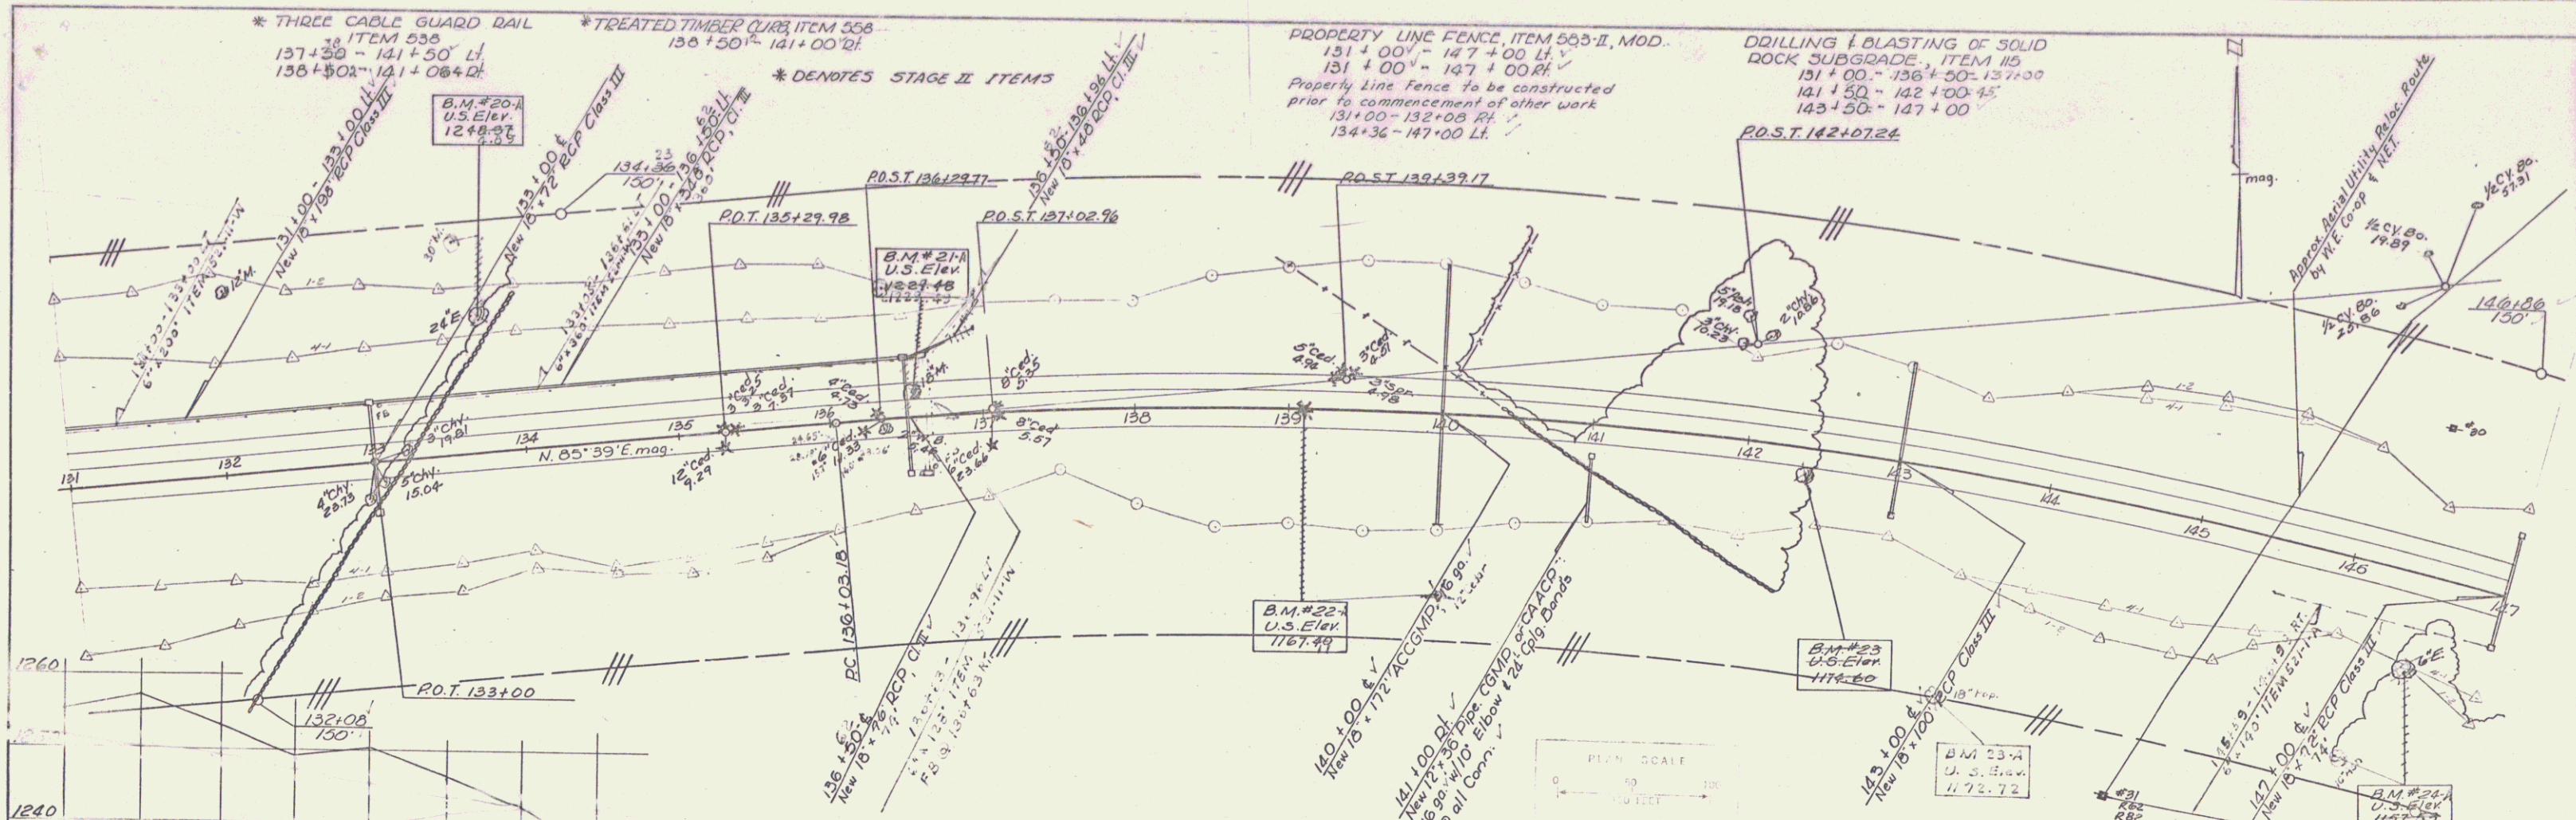


PLATE 1, PLAN-PROFILE
 REUTEL & EISEN CO.
 48 7014 IMPERIAL TRADING CENTER 2700

JUL 19 1974
 STAGE 2 CONSTRUCTION
 BERLIN-BARRE
 F137-1 (4)
 Sheet 21 of 103