

DRILLING & BLASTING of SOLID
ROCK SUBGRADE, ITEM 115
404+00 - 167+50' ✓
176+00 - 171+00 ✓
163+50 - 168+75

* THREE CABLE GUARD RAIL
ITEM 553
167+50 - 171+98 Lt ✓
170+80 - 172+60 Rt ✓


PROPERTY LINE FENCE, ITEM 563-II, Mod.
163+00 - 171+53 Lt ✓
165+00 - 179+00 Rt ✓
171+65 - 179+00 Lt ✓

* TREATED TIMBER CURB
ITEM 558
169+50 - 171+95 Lt ✓


CONSTRUCT DRIVE
172+50 Lt ✓

* DENOTES STAGE II ITEMS
TWO CABLE GUARD RAIL
ITEM 541
167+50 - 171+98

DRIVE GATE FOR PROPERTY
LINE FENCE Item 563-II, Mod.
171+53 - 171+65 Lt ✓

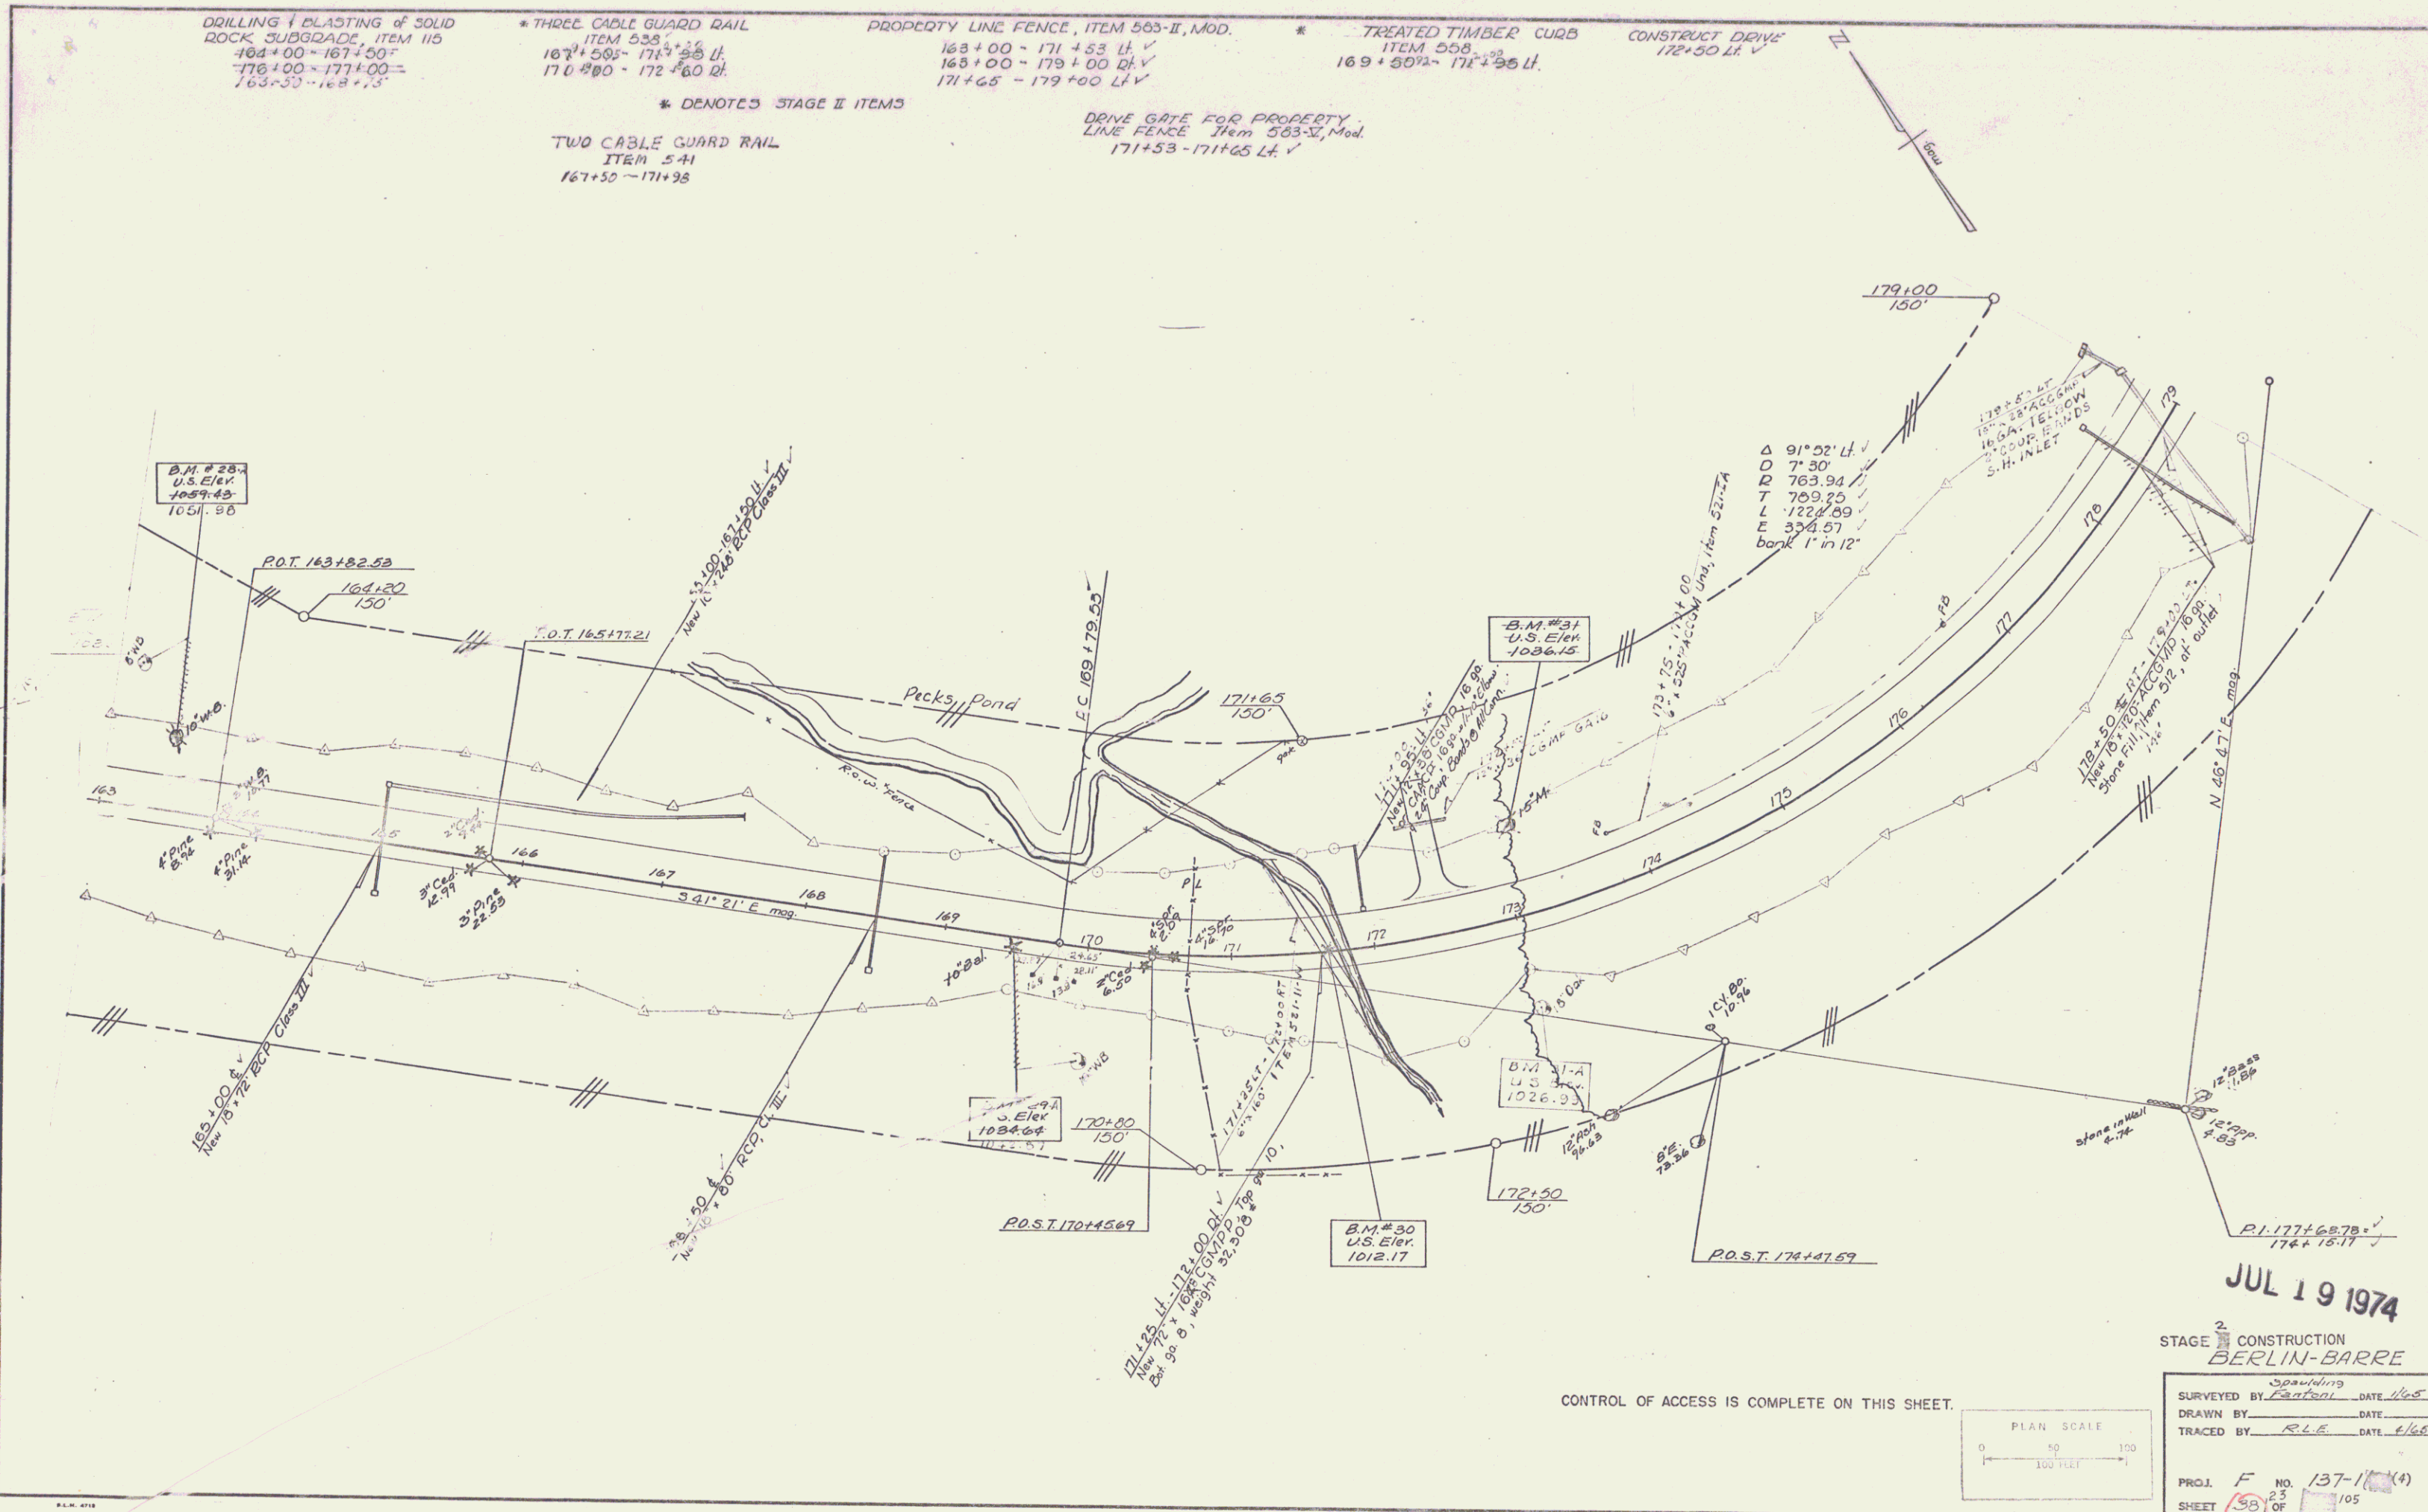

CONTROL OF ACCESS IS COMPLETE ON THIS SHEET.

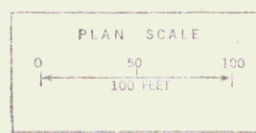

JUL 19 1974
STAGE 2 CONSTRUCTION
BERLIN-BARRE
SURVEYED BY Spaulding DATE 1/65
DRAWN BY FANTONI DATE 1/65
TRACED BY R.L.E. DATE 1/65
PROJ. F NO. 137-1(4)
SHEET 25 OF 105