

PLAN
 DATE: 7/19/74
 DRAWN BY: S. W. ROSE
 CHECKED BY: S. W. ROSE
 NO. 105

PROFILE
 DATE: 7/19/74
 DRAWN BY: S. W. ROSE
 CHECKED BY: S. W. ROSE
 NO. 105

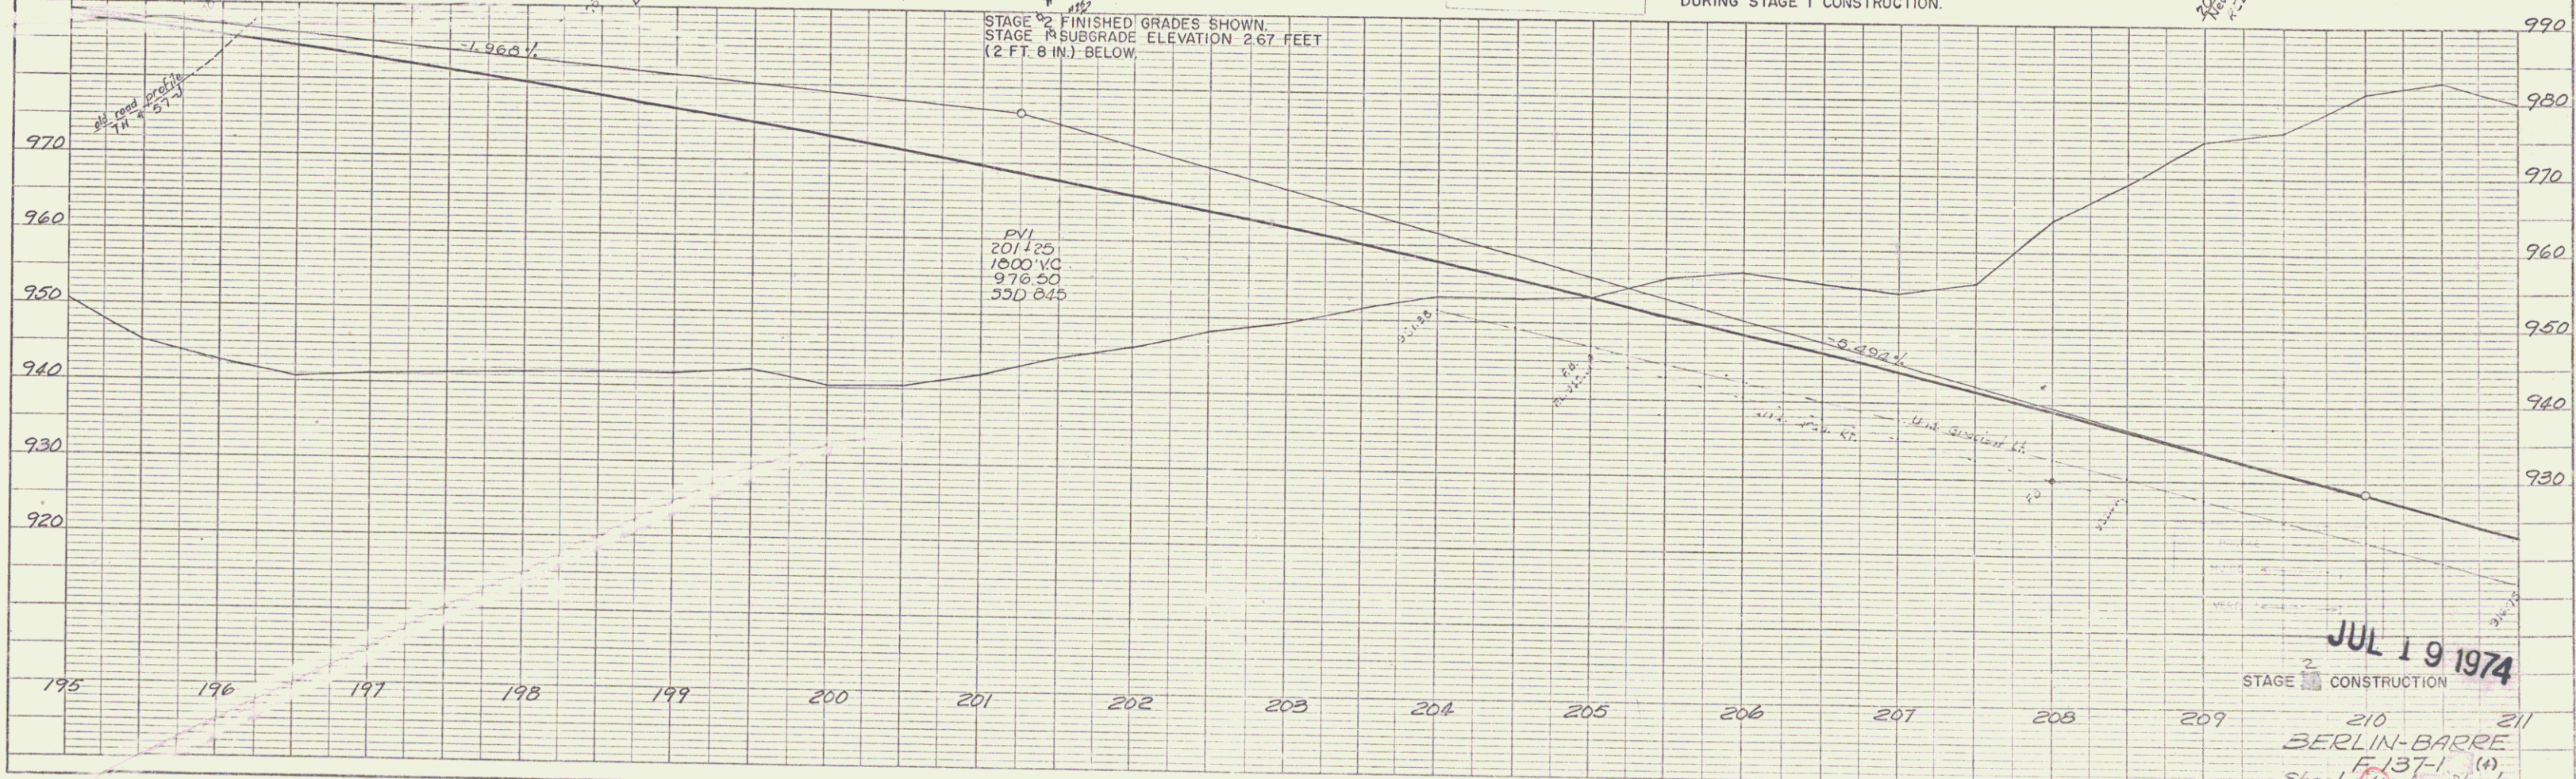
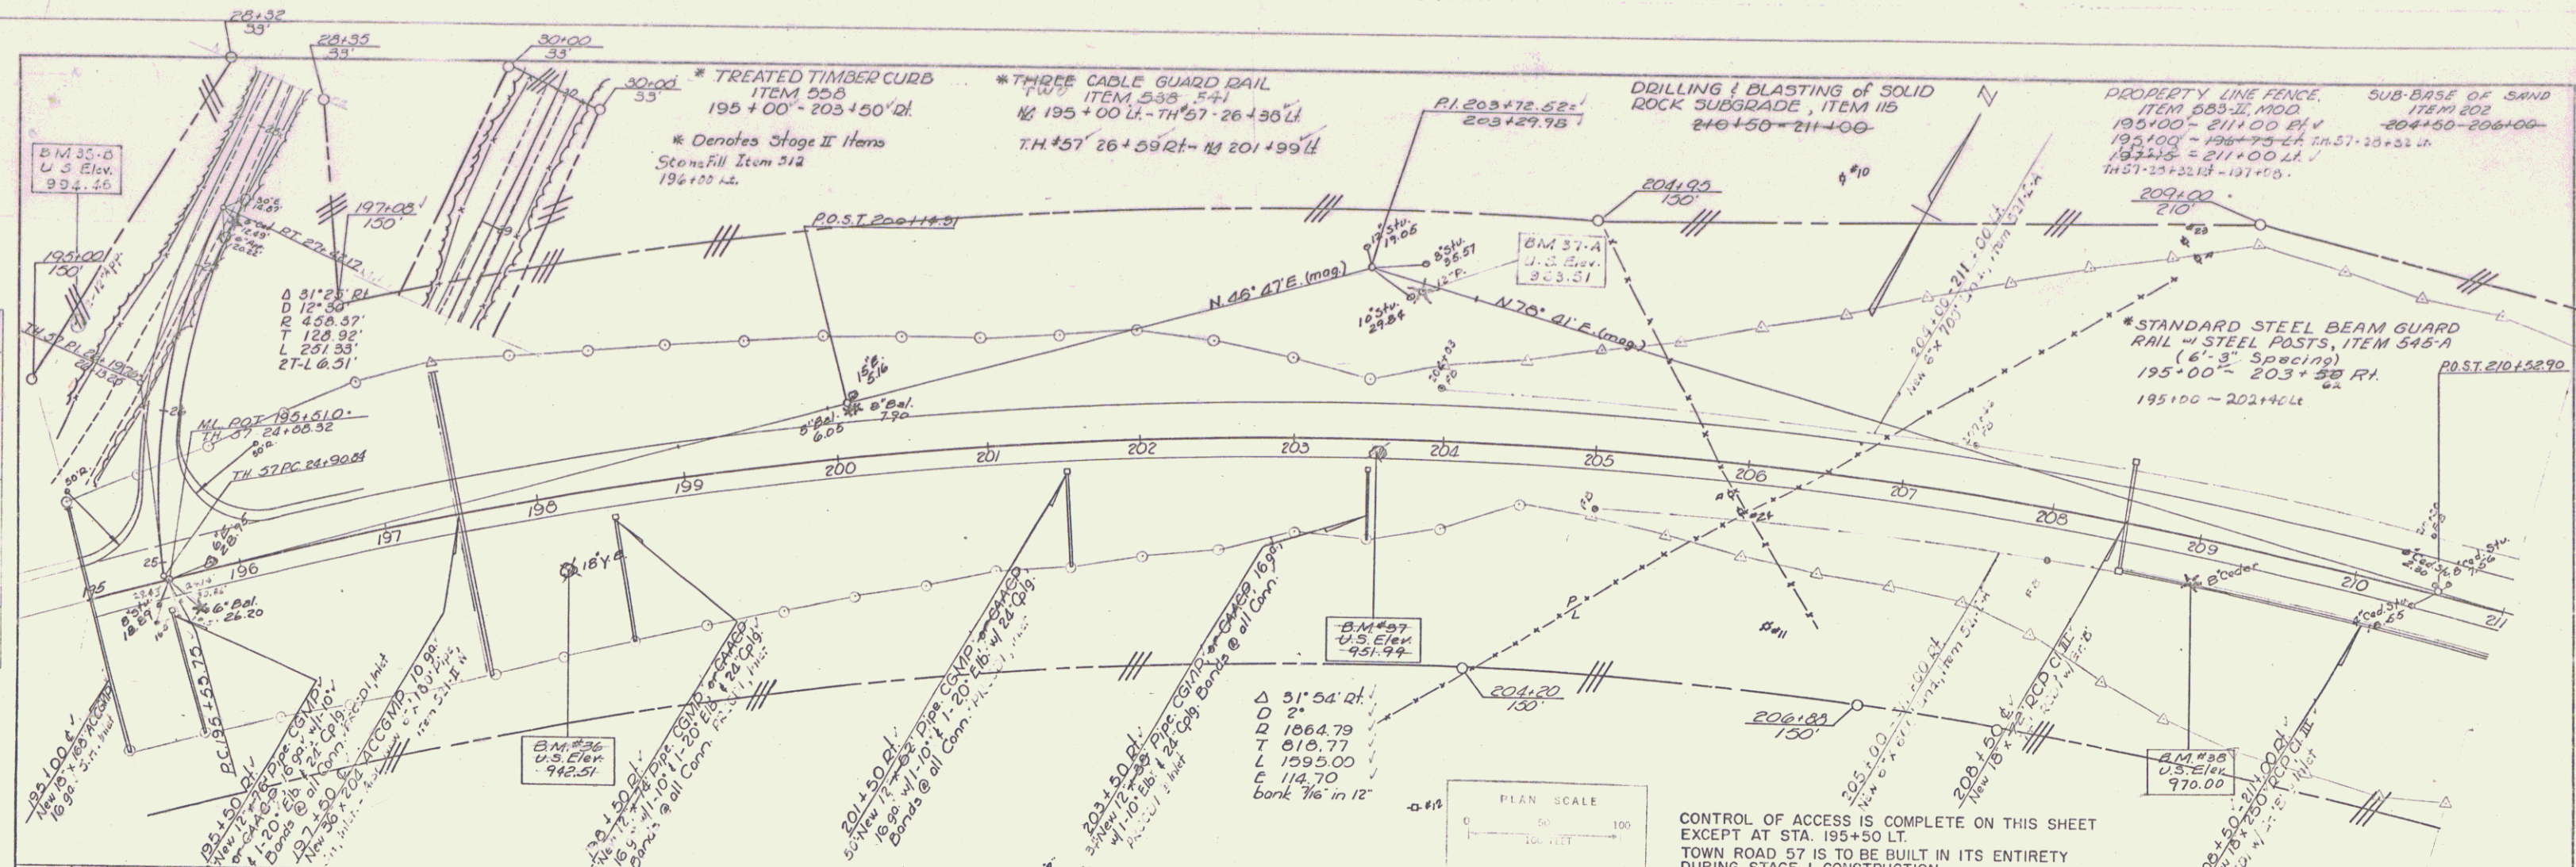


PLATE 1, PLAN PROFILE
 STUFFLE & SHAW CO.
 48 7012 IMPERIAL TRADING ALPHIN 2708

JUL 19 1974
 STAGE 2 CONSTRUCTION
 210 BERLIN-BARRE 211
 F-137-1 (A)
 Sheet 26 of 105