


PLAN  
NOTE BOOK NO. 100-1000  
NO. 100-1000

PROFILE  
NOTE BOOK NO. 100-1000  
NO. 100-1000

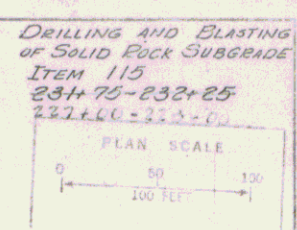

STAGE 2 FINISHED GRADES SHOWN.  
STAGE 1 SUBGRADE ELEVATION 2.67 FEET  
(2 FT. 8 IN.) BELOW.

CONTROL OF ACCESS IS COMPLETE ON THIS SHEET.  
TOWN ROAD 59 IS TO BE BUILT IN ITS ENTIRETY  
DURING STAGE 1 CONSTRUCTION.

JUL 19 1974  
STAGE 2 CONSTRUCTION  
242  
BERLIN-BARRE  
Sheet 137-1-1  
28 Sheets 105