

CONSTRUCT DRIVE
19+70 EA

DEMOLITION AND DISPOSAL
OF BUILDING ITEM 586
#3 19+05 LK V
*3A 19+65 RI V


PLAN

DATE: _____ BY: _____


NO. _____

SCALE CHECKED: _____

DATE: _____

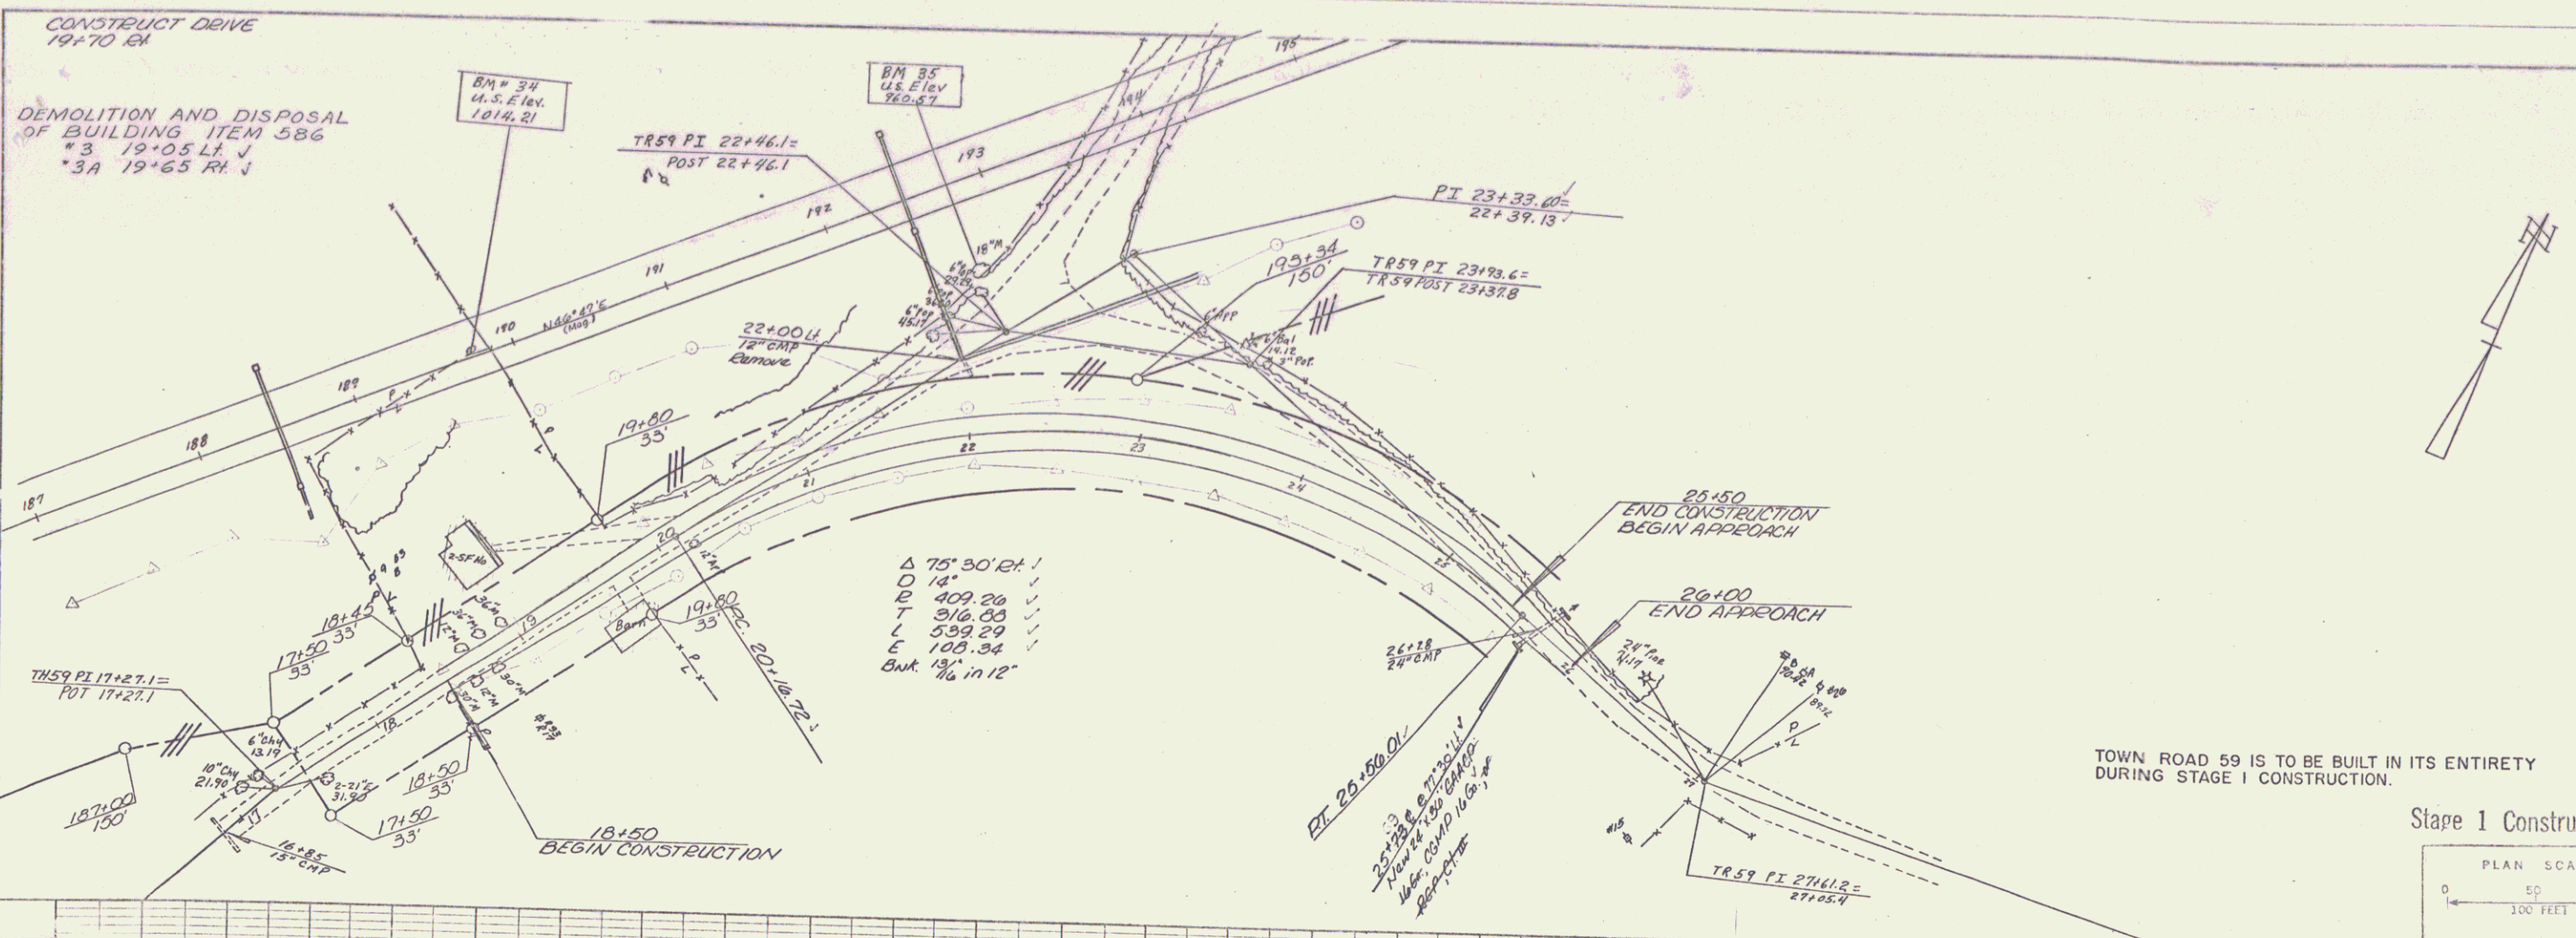

TOWN ROAD 59 IS TO BE BUILT IN ITS ENTIRETY
DURING STAGE I CONSTRUCTION.

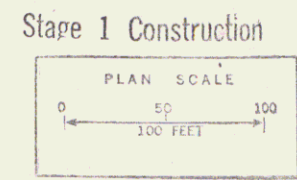


PROFILE

DATE: _____ BY: _____

NO. _____

SCALE CHECKED: _____

DATE: _____

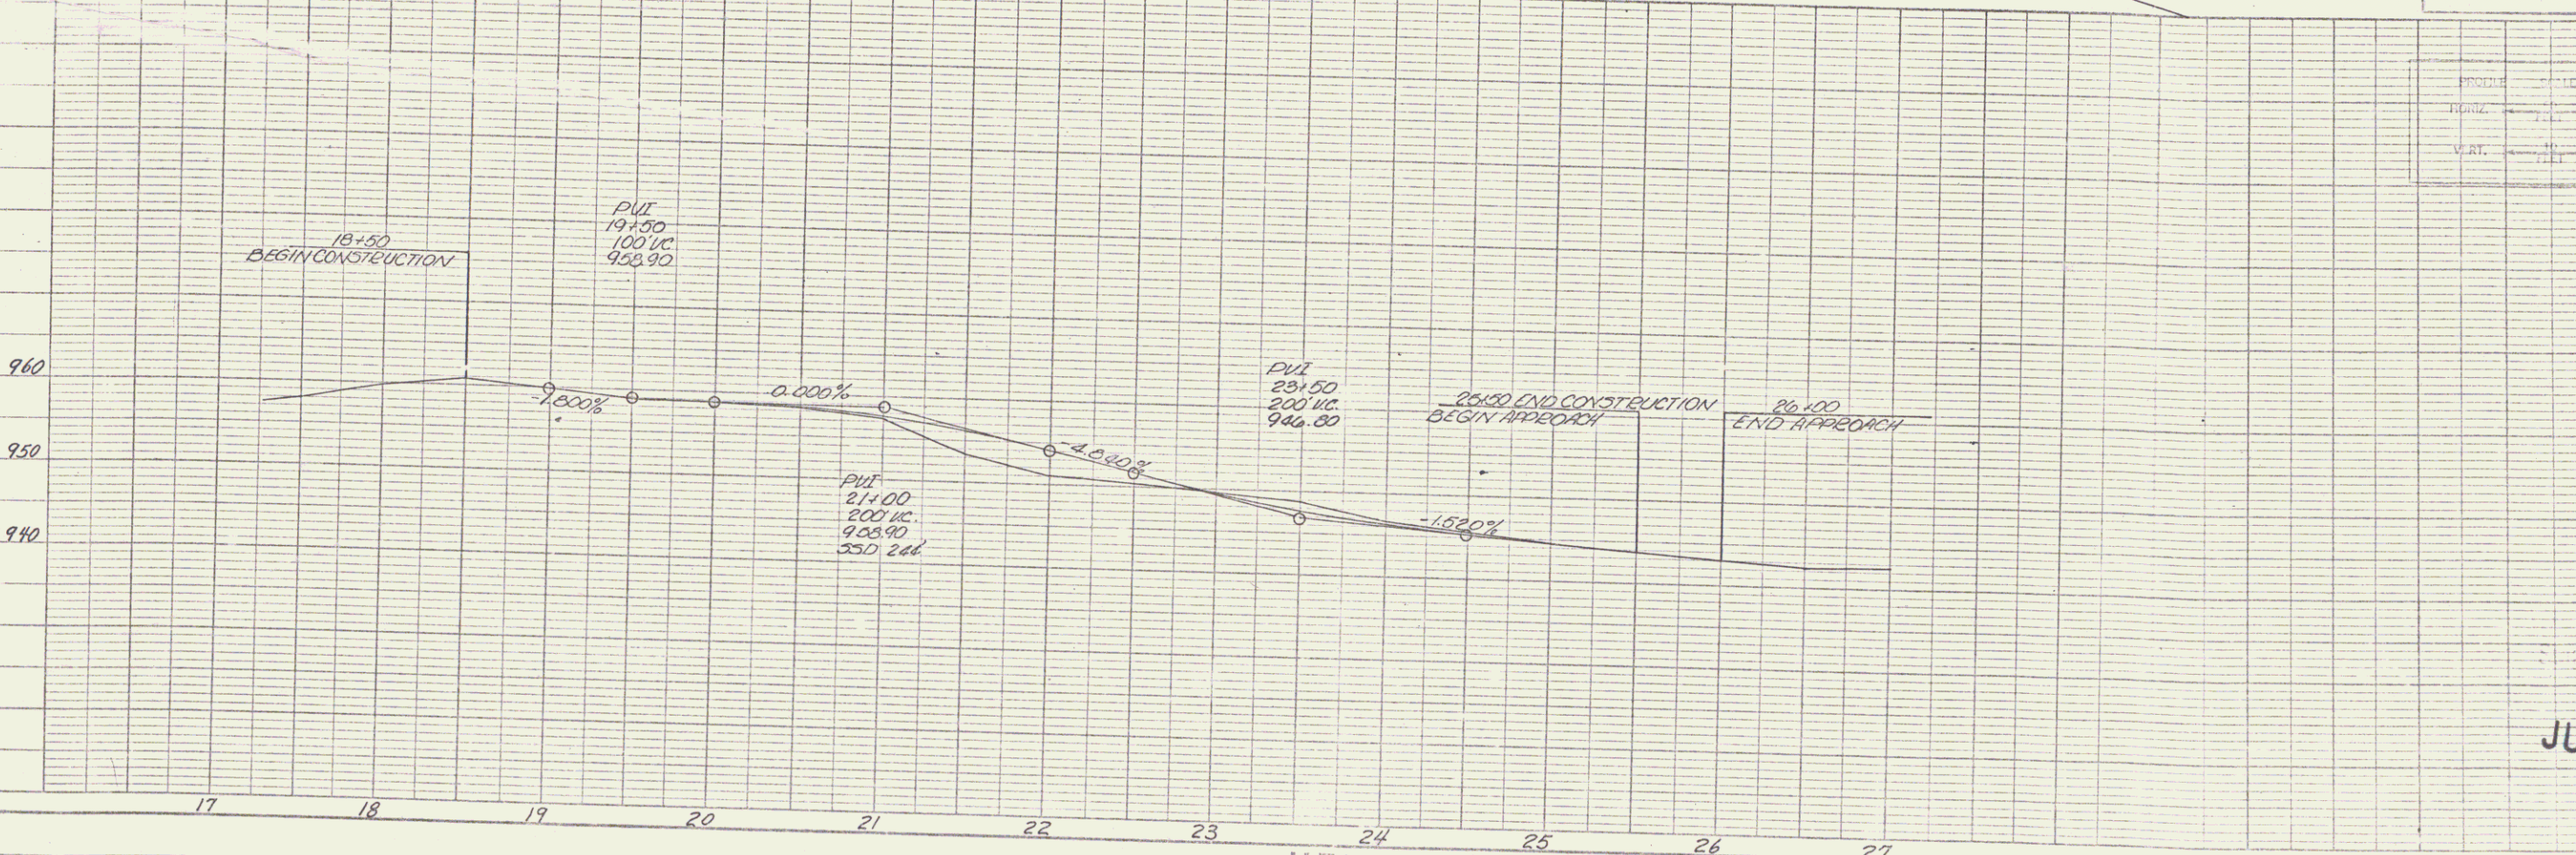

JUL 19 1974

K&E PLATE 1, PLAN-PROFILE
KUMPT & EISEN CO.

TH 59 @ 195 BERLIN-BARRE
FL 37-1 (4)
Sheet 17 of 34