
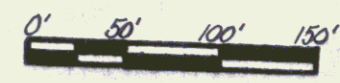


* THREE CABLE GUANO DAIL
ITEM 532
35+48 - 35+50 DI
35+90 - 36+14 LI

MUCK EXCAVATION
ITEM 117
44+00 - 45+50

PROPERTY LINE FENCE
ITEM 503 II
35+00 - 36+00 LI (P)

* DENOTES STAGE 2 ITEMS

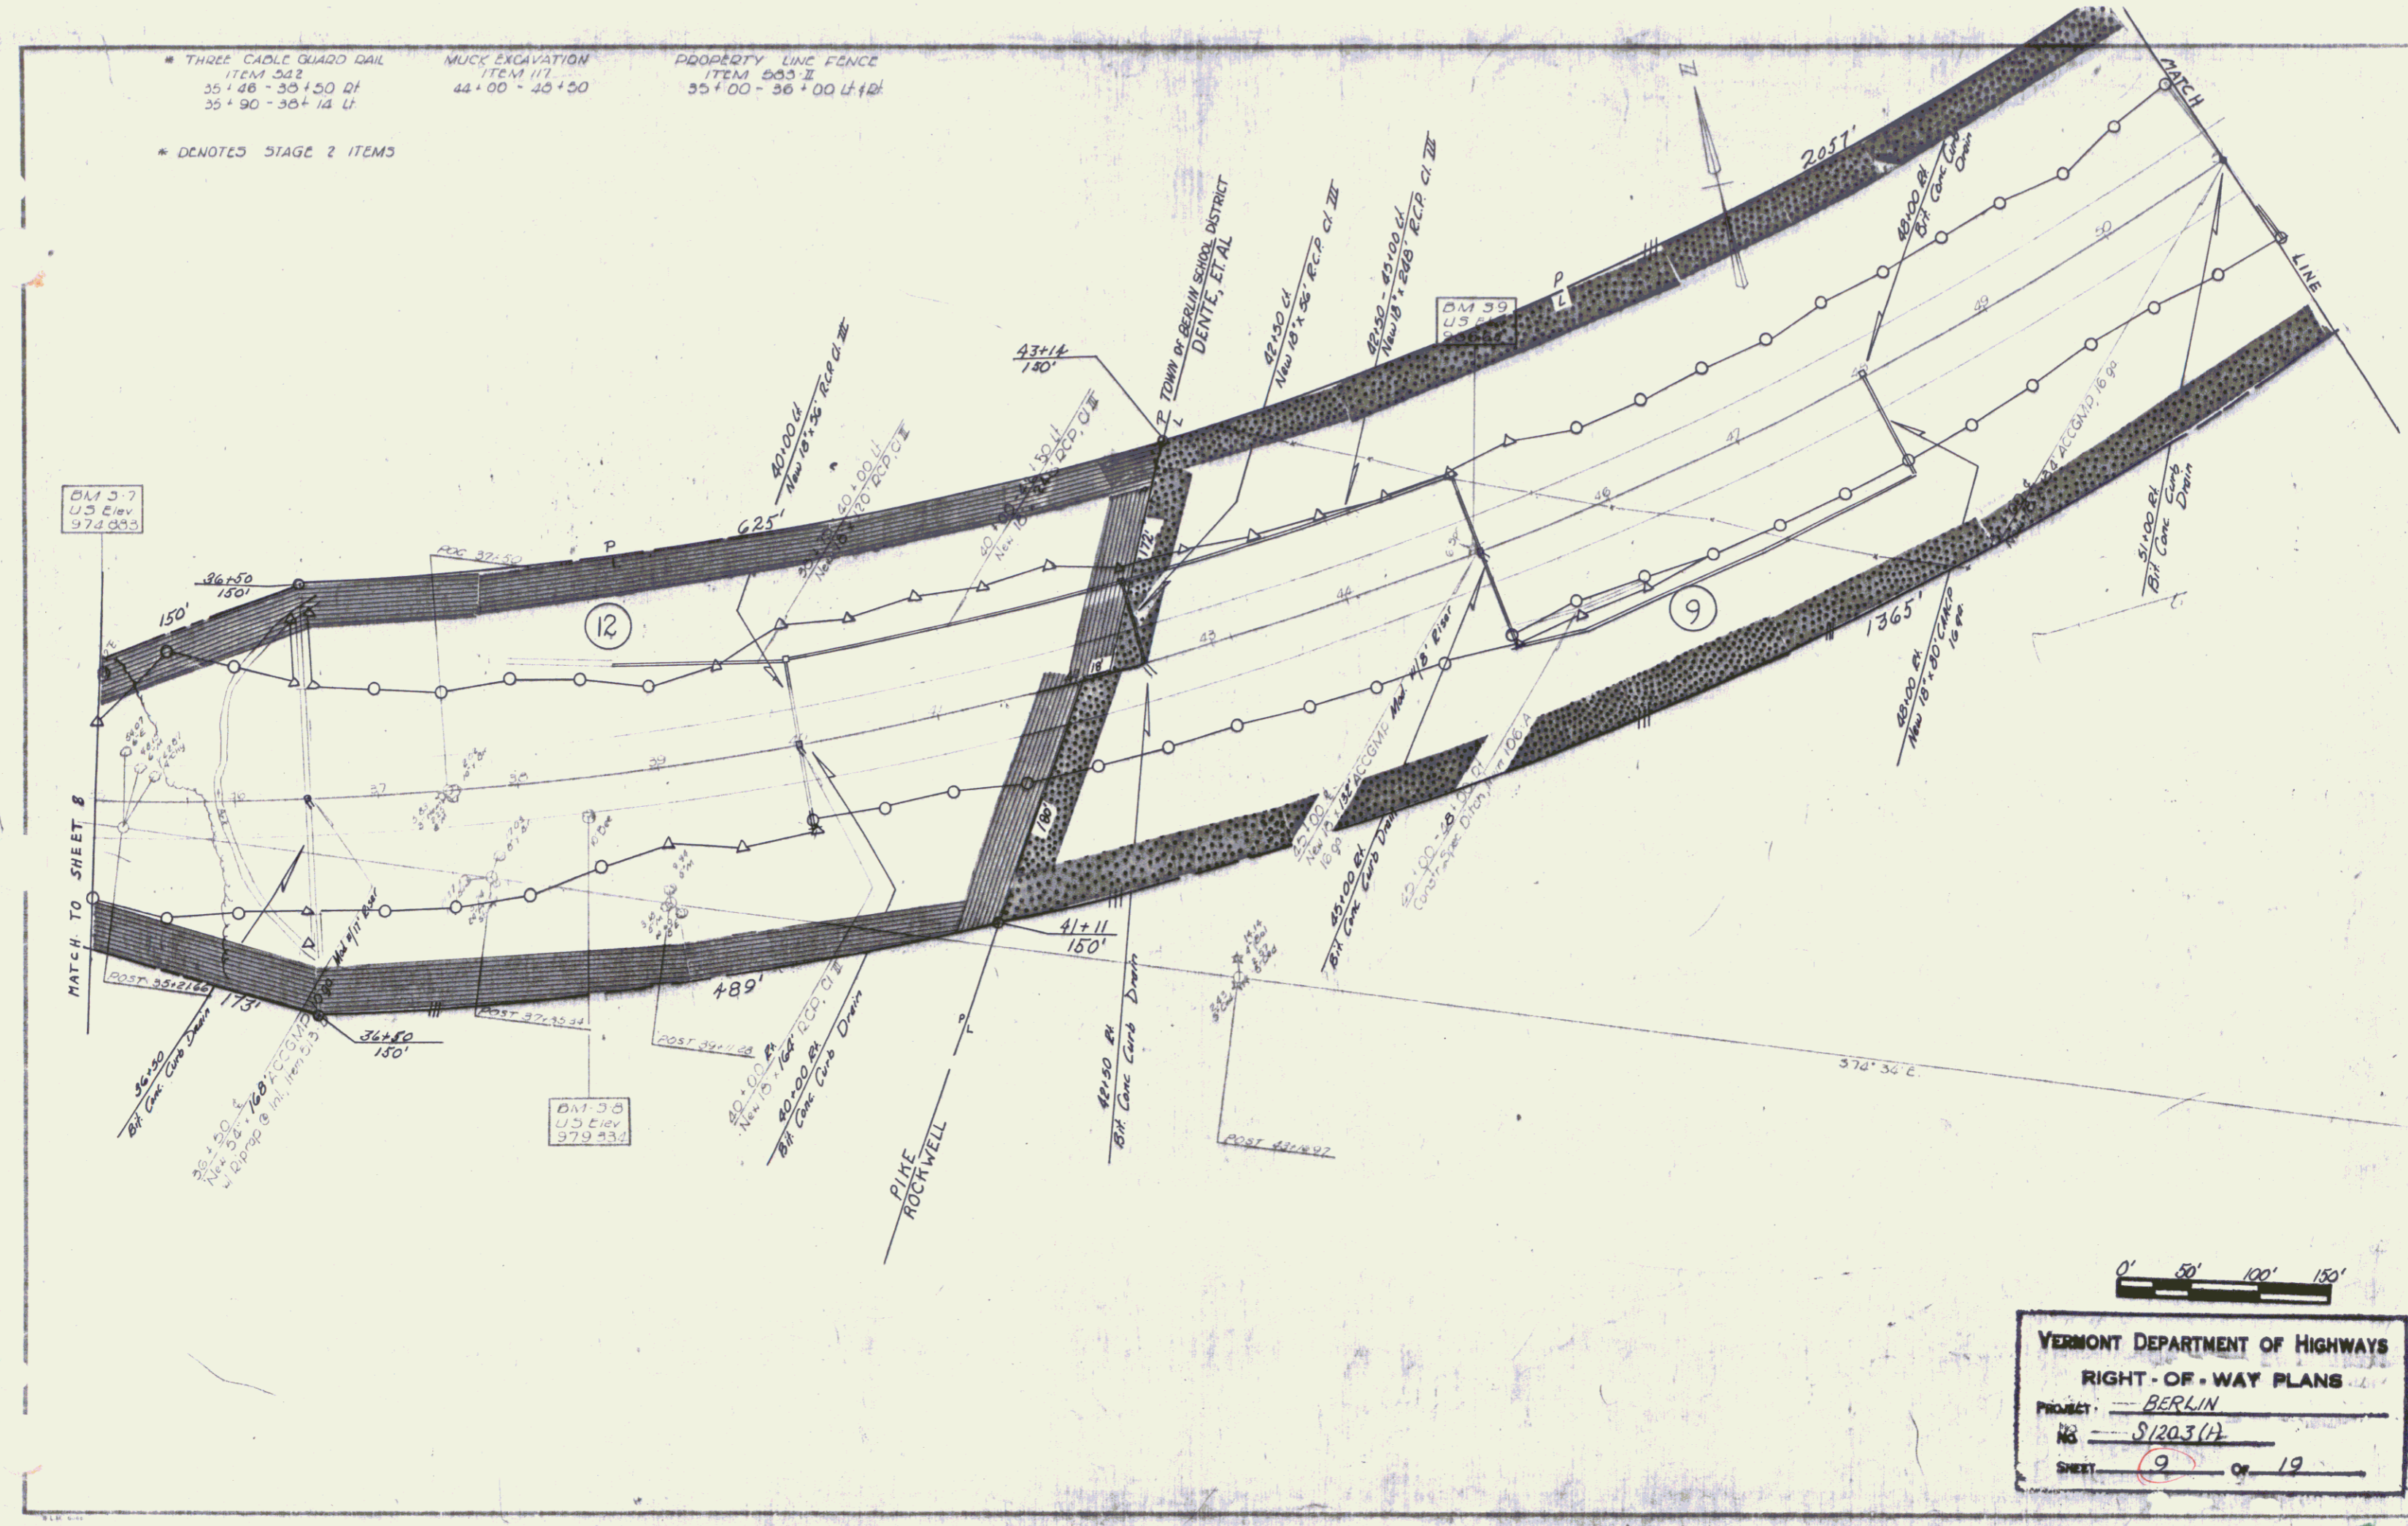

VERMONT DEPARTMENT OF HIGHWAYS
RIGHT-OF-WAY PLANS

PROJECT: BERLIN

NO: S/203 (P)

SHEET: 9 OF 19

8