



STATE OF VERMONT
DEPARTMENT OF HIGHWAYS
PROPOSED IMPROVEMENT

FEDERAL PROJECT
F 126-1(8)
TOWN OF BERLIN
COUNTY OF WASHINGTON
INTERSTATE 89 - BARRE-MONTPELIER-EXPRESSWAY ROAD
BEGINNING AT A POINT ON THE BERLIN STATE HIGHWAY 0.229 MILE NORTHERLY
OF THE JUNCTION OF S.A. HIGHWAY #5 AND EXTENDING SOUTHEASTERLY

LENGTH OF R.O.W. 10,451 FEET 1.999 MILES
LENGTH OF PROJECT 6744.43 FEET 1.277 MILES
ADT 1972 - 4125
ADT 1992 - 8250
DMV 1972 - 550
DMV 1992 - 795
D - 5%
T - 8%
V - 50

Route: VT 62
Project: F 126-1(8)
Pin: 00R399
Date: 02/10/1971

R.O.W. PLANS

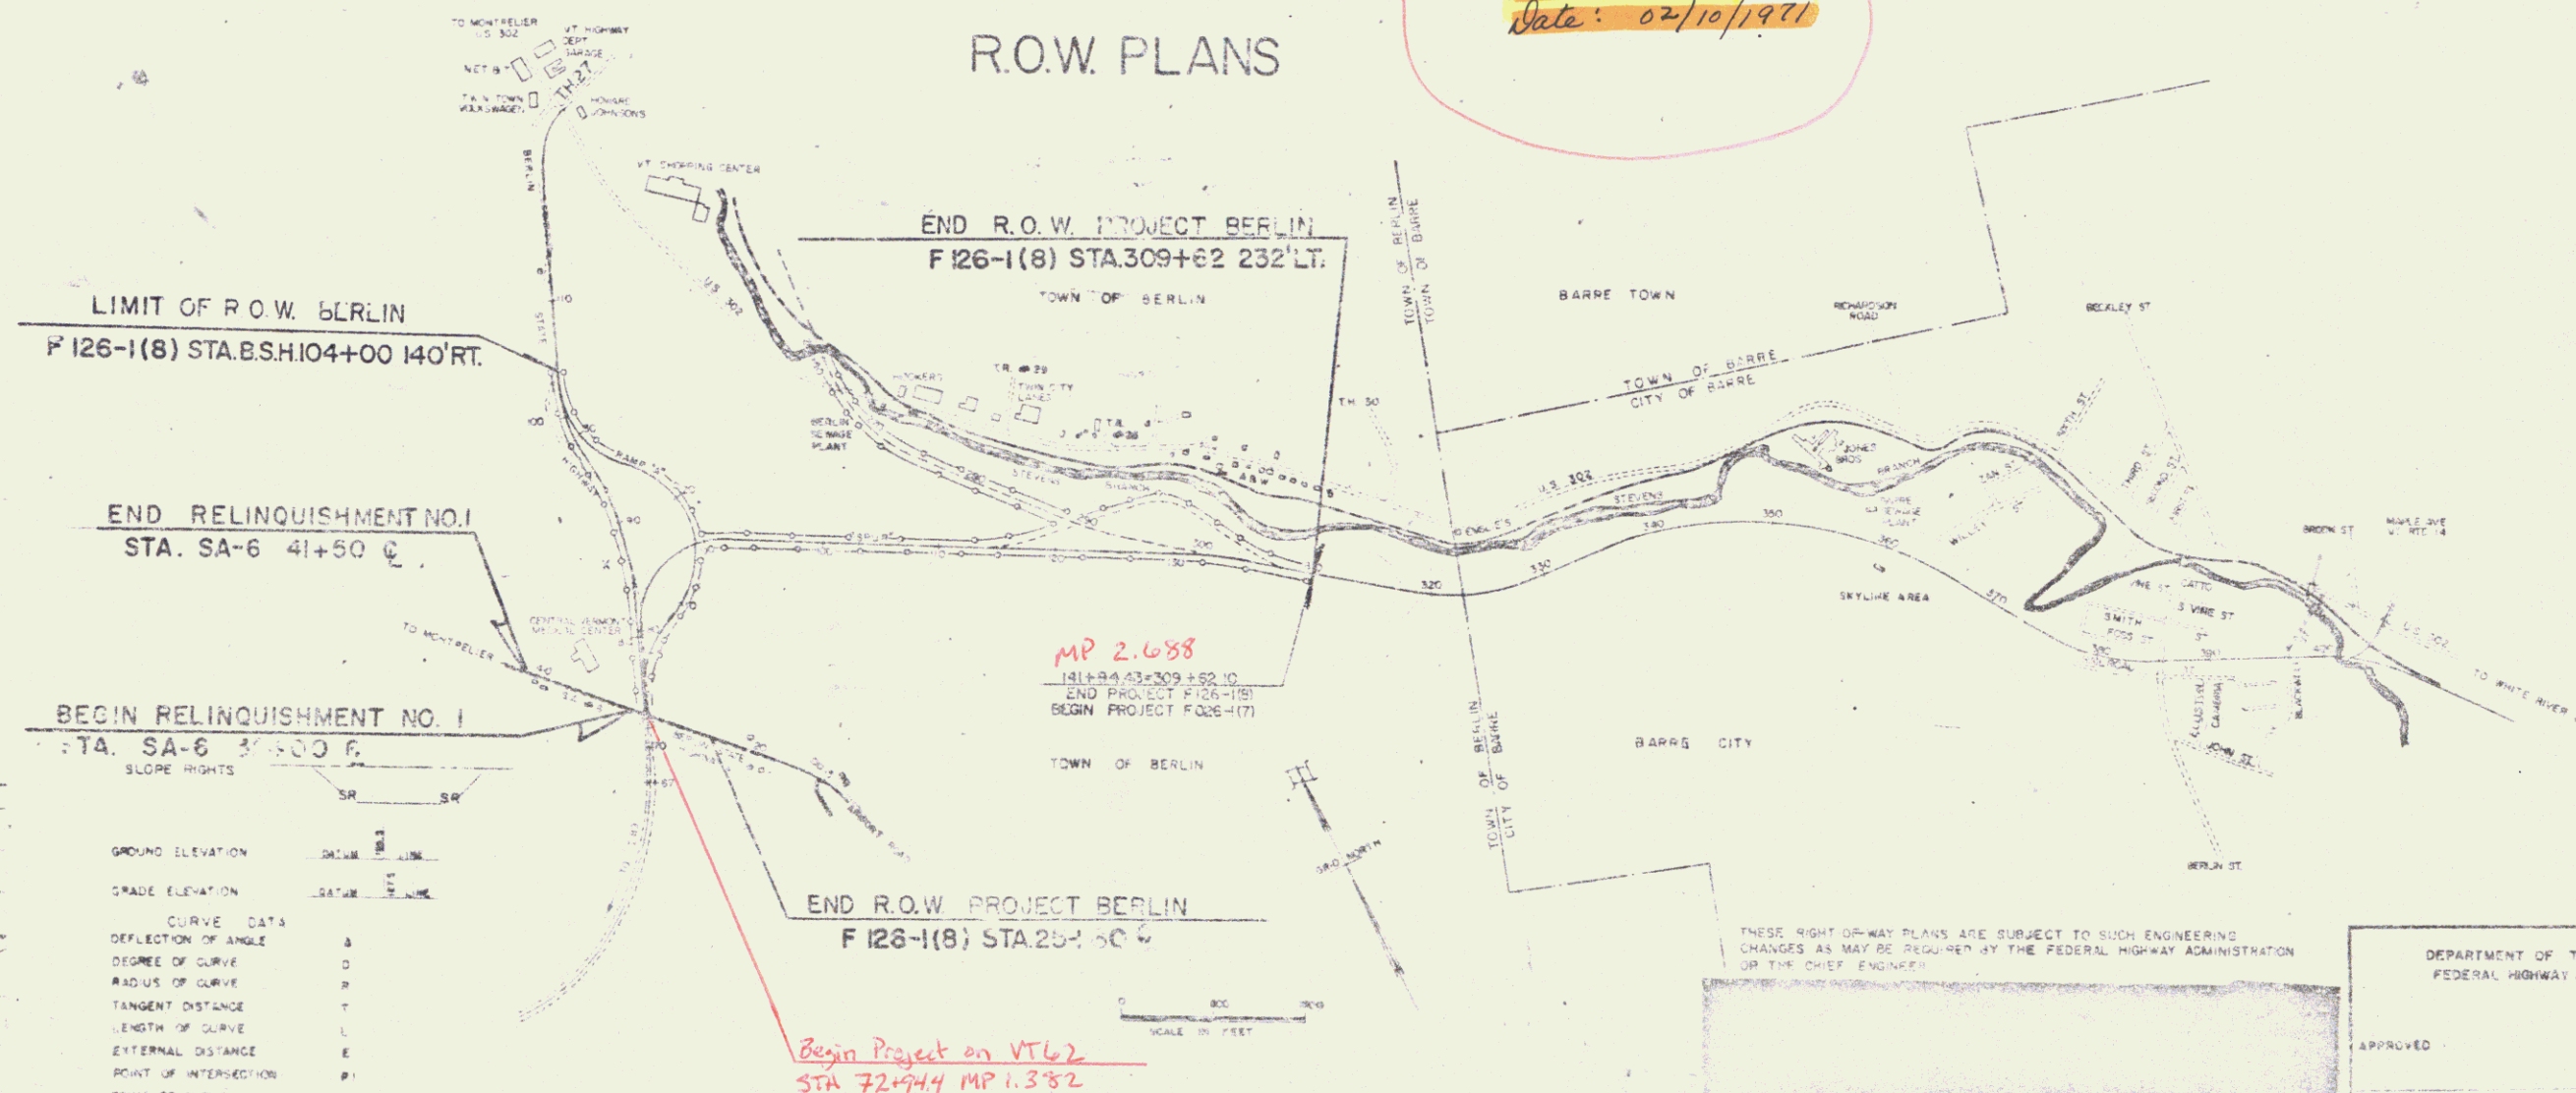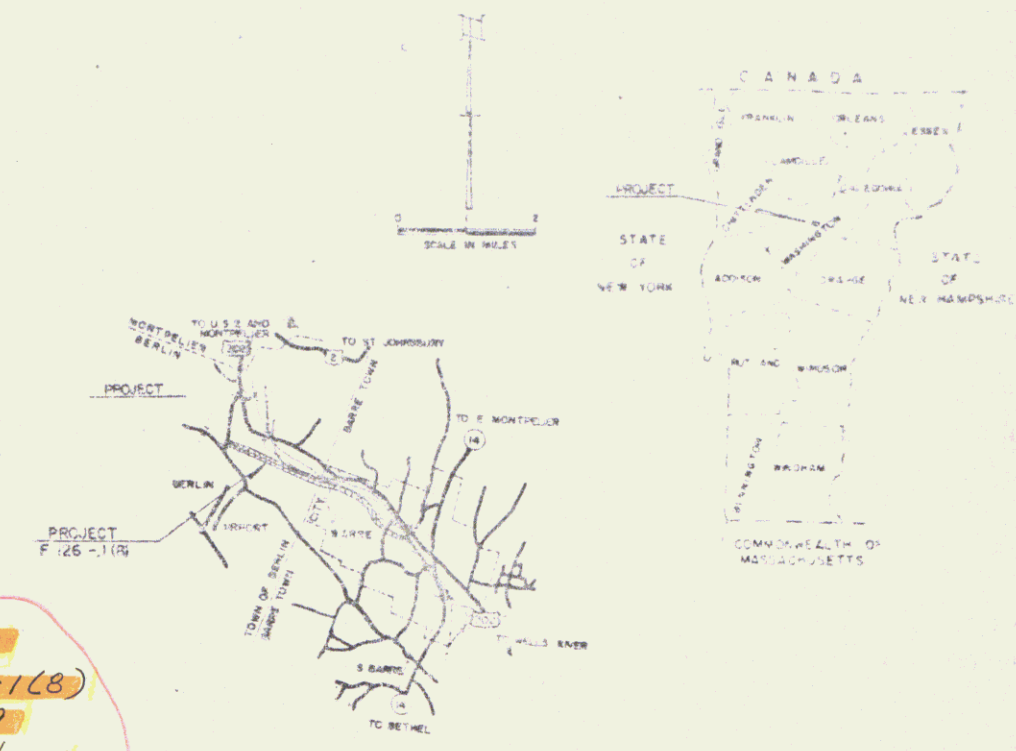

CONVENTIONAL SIGNS

POINT OF ACCESS	---
LIMITS OF ACCESS	---
COUNTY LINE	---
TOWN LINE	---
FENCE LINE	---
STONE WALL	---
UNFENCED PROPERTY	---
GUARD RAIL	---
TRAVELLED WAY	---
RAILROAD	---
RETAINING WALL	---
CENTER LINE	---
SURVEY LINE	---
CULVERT	---
DROP INLET	---
TROLLEY HOLE	---
POWER POLE	---
TELEPHONE POLE	---
TREE	---
MEDE	---

POINT OF ACCESS	X
LIMITS OF ACCESS	---
COUNTY LINE	---
TOWN LINE	---
FENCE LINE	---
STONE WALL	---
UNFENCED PROPERTY	---
GUARD RAIL	---
TRAVELLED WAY	---
RAILROAD	---
RETAINING WALL	---
CENTER LINE	---
SURVEY LINE	---
CULVERT	---
DROP INLET	---
TROLLEY HOLE	---
POWER POLE	---
TELEPHONE POLE	---
TREE	---
MEDE	---

APPROVED	DATE
APPROVED	DATE
APPROVED	DATE

DEPARTMENT OF TRANSPORTATION
FEDERAL HIGHWAY ADMINISTRATION

APPROVED _____ DATE _____

PROJECT F 126-1(8)

SHEET 1 OF 37

*Begin Project on VT 62
STA 72+74.4 MP 1.382*