


GRANULAR BORROW, ITEM 105
 BERLIN ST HWY
 89+00 - 104+00
 RAMP A
 27+50 - 36+00
 SUB-BASE OF SAND, ITEM 202
 RAMP A
 23+75 - 27+50
 RIP-RAD LIGHT TYPE, ITEM 513-9
 BERLIN ST HWY
 93+70 - 93+80 RT
 100+72 - 100+82 LT
 THREE CABLE GUARD RAIL
 LIGHT STEEL POSTS, ITEM 533
 BERLIN STATE HWY
 89+00 - 95+34 RT
 95+00 - 96+75 LT
 100+00 - 101+50 LT
 TREATED TIMBER CURB, ITEM 559
 RAMP A
 33+30 - 36+00 RT
 SODDING, ITEM 616
 BERLIN ST HWY
 93+85 - 94+50 RT

STONE FILL FOR SLOPE PROTECTION
 LIGHT TYPE, ITEM 512
 BERLIN ST HWY
 93+00 - 93+70 RT
 93+00 - 93+90 RT
 100+62 - 100+72 LT
 100+82 - 100+92 LT
 RAMP A
 23+50 - 26+00 LT
 GRANITE SLOPE EDGING, ITEM 556-A
 BERLIN ST HWY
 101+30 - 102+20 RT

BERLIN STATE HIGHWAY
 $\Delta 15^{\circ}03'30''$ LT
 $D 2^{\circ}15'$
 $R 2546.46$
 $T 336.57$
 $L 669.26$
 $E 22.15$
 Bank $\frac{3}{8}$ per ft

Contract Drive
 93+78 Rt (Ramp A)

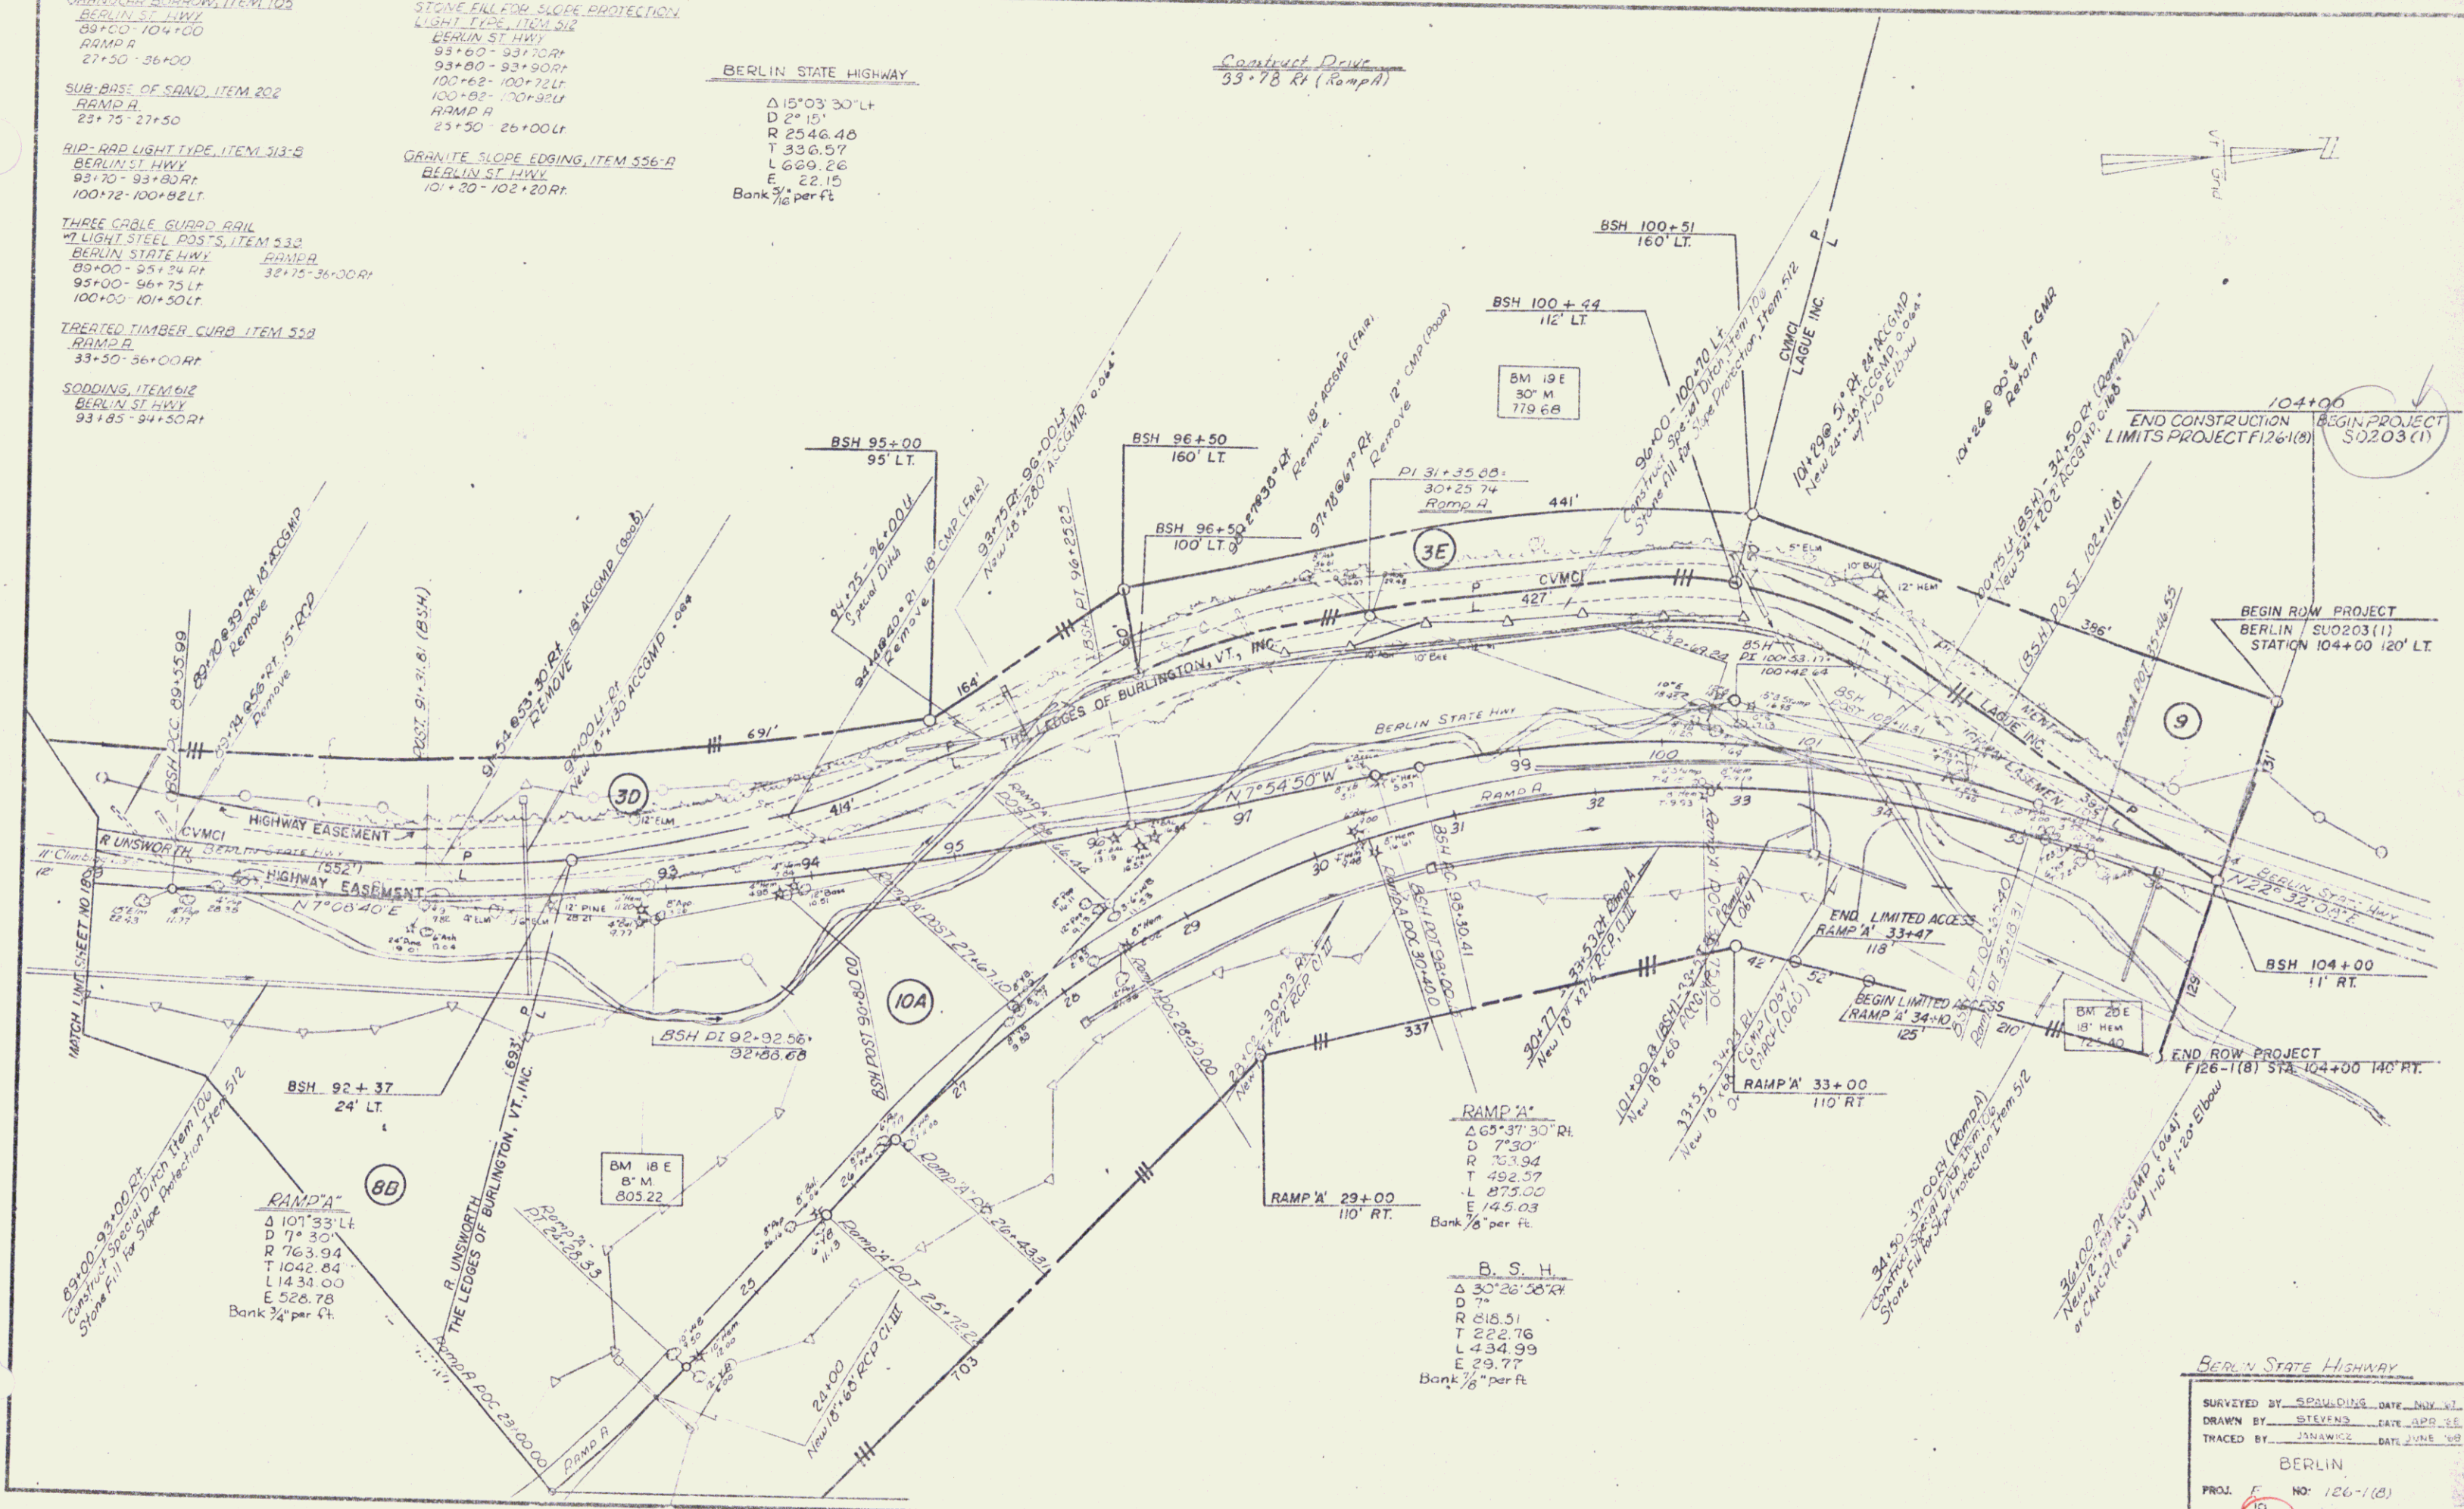

END CONSTRUCTION LIMITS PROJECT F126(1)
 BEGIN PROJECT S0203(1)

BEGIN ROW PROJECT
 BERLIN S0203(1)
 STATION 104+00 120' LT

END ROW PROJECT
 F126-1(8) STA 104+00 140' RT

RAMP A'
 $\Delta 69^{\circ}37'30''$ RT
 $D 7^{\circ}30'$
 $R 763.94$
 $T 492.37$
 $L 875.00$
 $E 145.03$
 Bank $\frac{3}{8}$ per ft

B. S. H.
 $\Delta 30^{\circ}26'50''$ RT
 $D 7^{\circ}$
 $R 816.51$
 $T 222.76$
 $L 434.99$
 $E 29.77$
 Bank $\frac{3}{8}$ per ft

BERLIN STATE HIGHWAY
 SURVEYED BY SPENDING DATE NOV 81
 DRAWN BY STEVENS DATE APR 82
 TRACED BY JONAWICK DATE JUNE 82
 BERLIN
 PROJ. NO. 126-1(B)
 SHEET 19 OF 27