

SAND BORROW
105+00 - 118+00


STONE FILL, TYPE II
106+10 - 106+40 Rt.
107+65 - 107+85 Rt.
112+35 - 112+65 Rt.

GUARD RAIL, THREE CABLE
W/ LIGHT STEEL POSTS
105+00 - 118+00 Lt.


TREATED TIMBER CURB
105+00 - 118+00 Lt.

STONE FILL, TYPE I
105+00 - 106+20 Rt. (Int. Ditch)
106+25 - 107+25 Rt. (Int. Ditch)
107+75 - 109+50 Rt. (Int. Ditch)
109+75 - 112+50 Rt. (Int. Ditch)
112+50 - 115+00 Rt. (Int. Ditch)
113+00 - 118+00 Rt. (Int. Ditch)
108+00 - 111+00 Rt. (Slopes)
113+00 - 118+00 Rt. (Slopes) Refer to Sheet 40 of 341

WOVEN WIRE FENCE W/ STEEL POSTS
105+00 - 118+00 Lt.

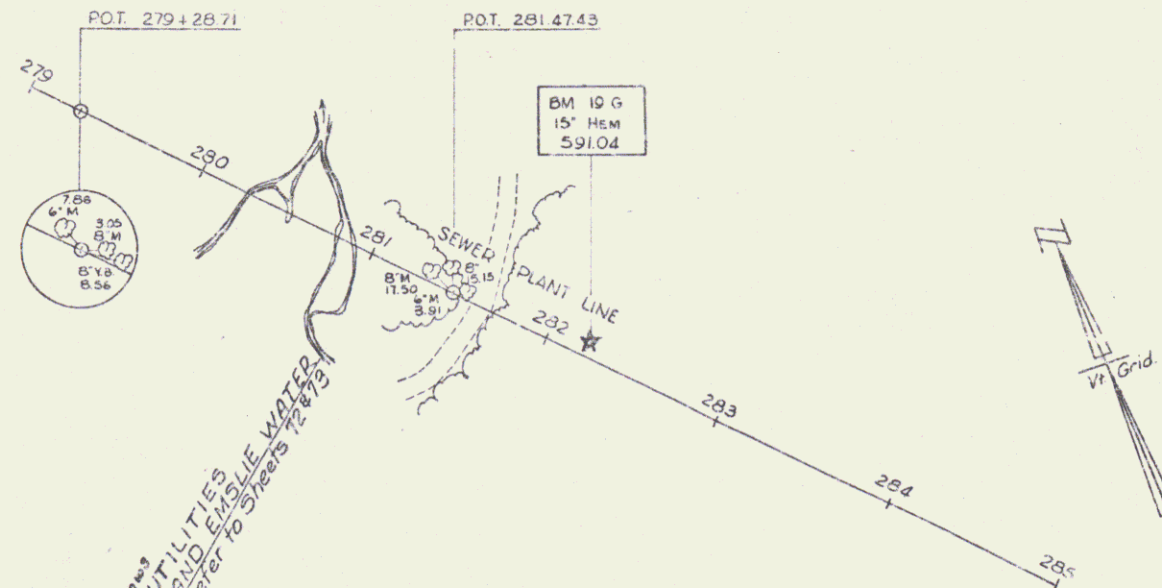

POOR ORIGINAL COPY

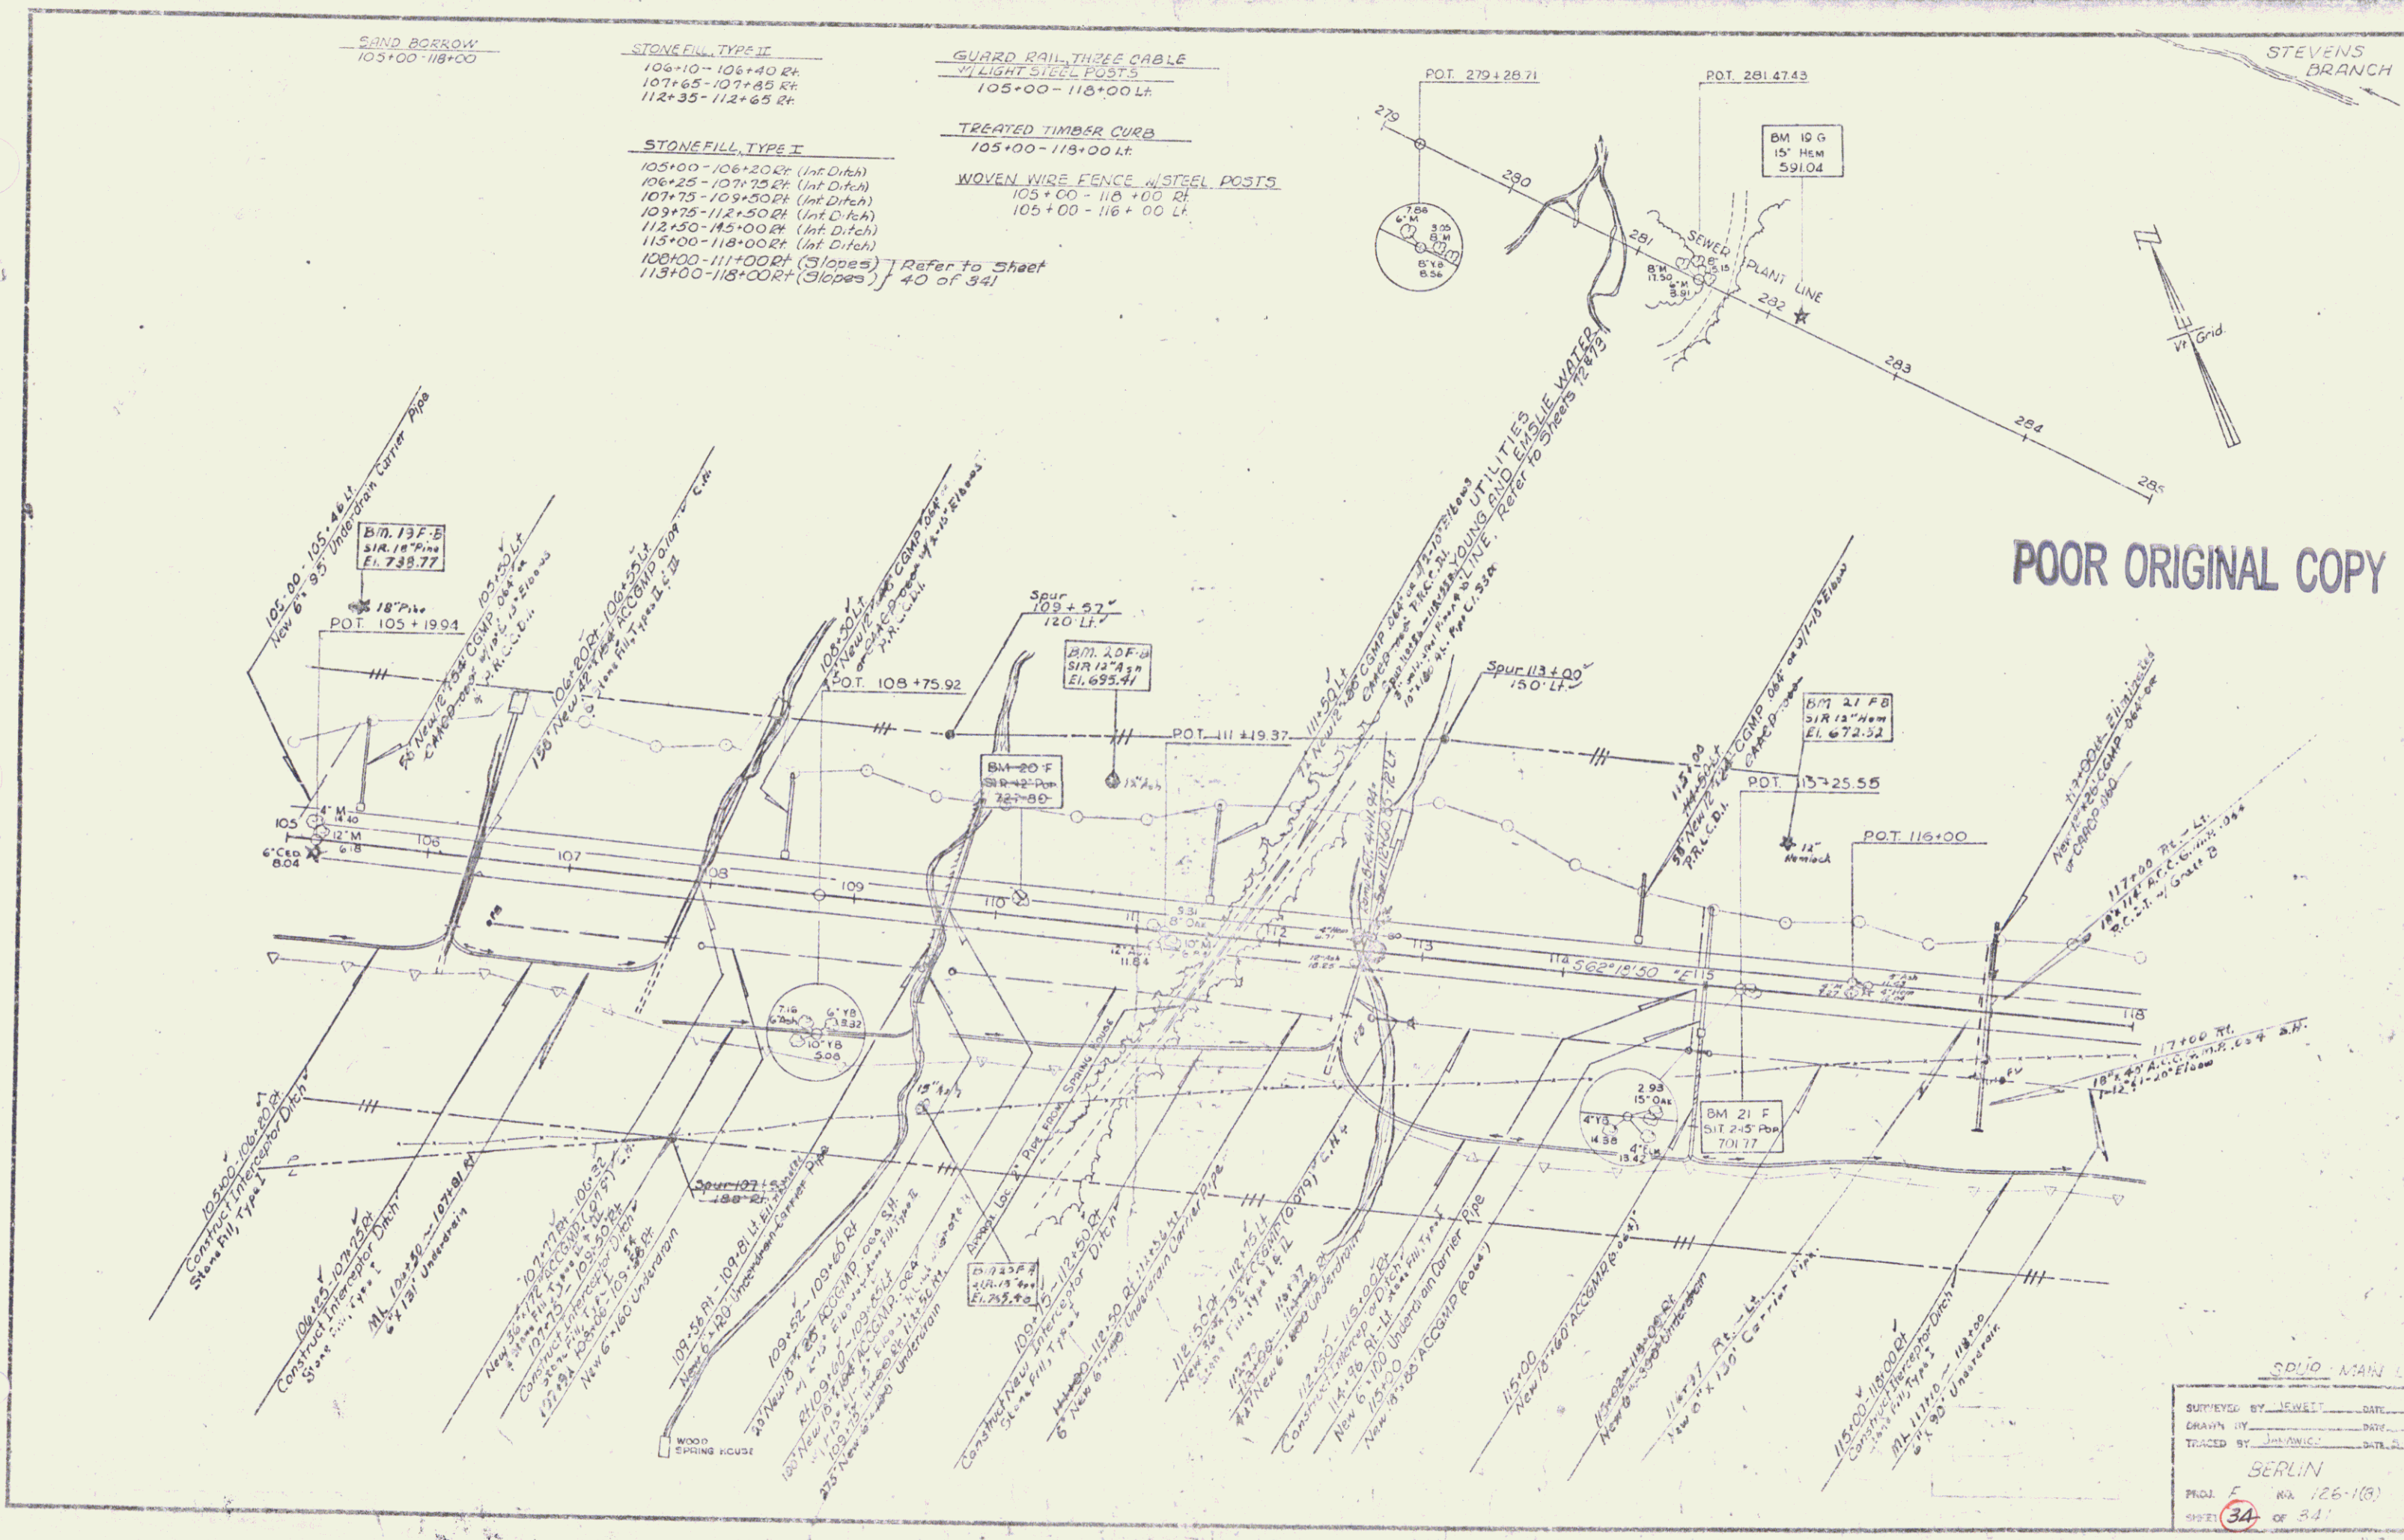

SD10 - MAIN LINE
SUPPLIED BY: SEWET DATE: _____
DRAWN BY: J. W. B. DATE: _____
TRACED BY: J. W. B. DATE: _____
BERLIN
PROJ. NO. 126-1(B)
SHEET 34 OF 34