

PLAN
 SURVEYED BY
 PLOTTED BY
 CHECKED BY
 DATE
 NO. OF WAY CHECKED

P-FILE
 SURVEYED BY
 PLOTTED BY
 CHECKED BY
 DATE
 NO. OF WAY CHECKED

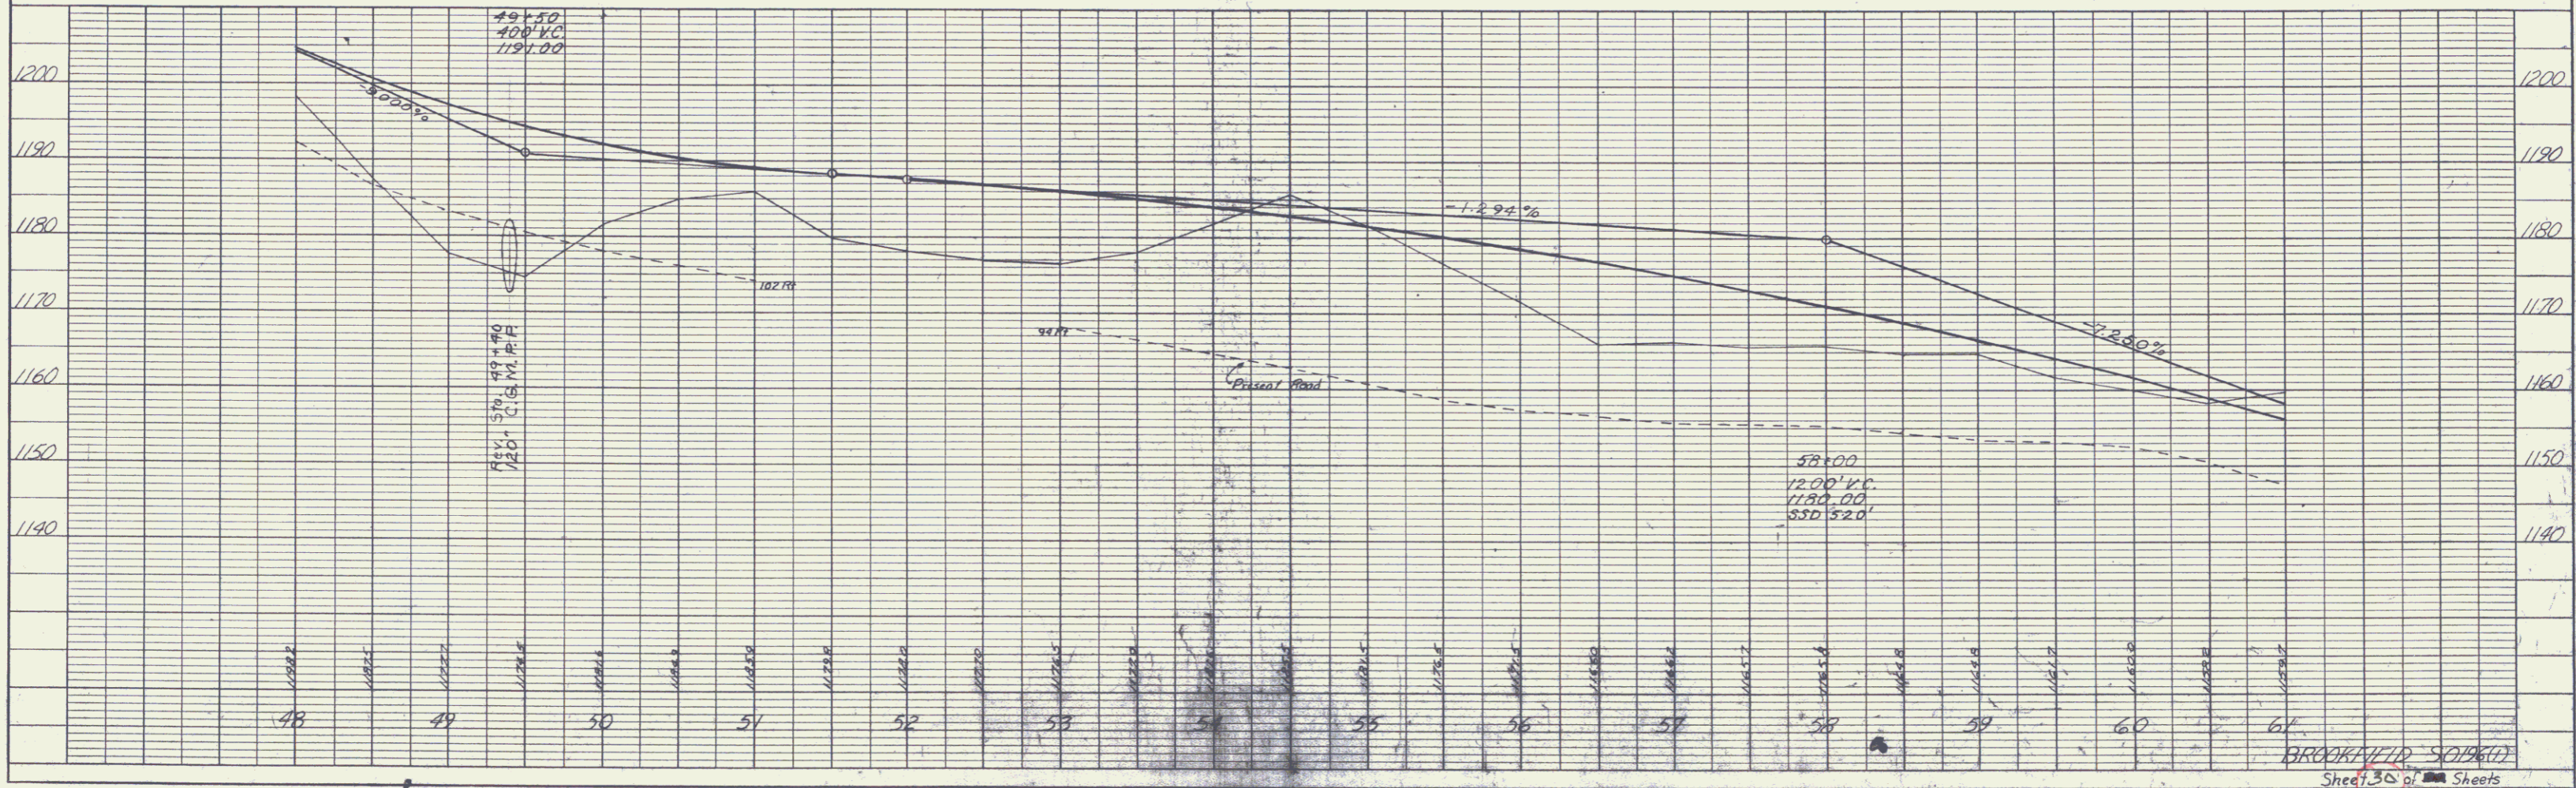


PLATE 1: PLAN-PROFILE
 KUPPEL & EBER CO.

BROOKFIELD 50196(2)
 Sheet 30 of 30 Sheets