

INDEX OF SHEETS

- TITLE
- TYPICAL (2 1/2" Bituminous Concrete Pavement, Item 361-B, Mod.)
- SUMMARY OF QUANTITIES
- ITEM DETAIL & DRAINAGE SHEET
- EARTHWORK SHEETS
- SUMMARY (In-Class, Channel Exc. & Stone Fill)
- PLAN & PROFILE SHEETS
- DETAILS OF ROUND PLATE PIPE (Rev. Sta. 35+35.0)
- CHANNEL SECTIONS FOR PLATE PIPE (Rev. Sta. 35+35.0)
- DETAILS OF ROUND PLATE PIPE (Rev. Sta. 63+35.0)
- CHANNEL SECTIONS FOR PLATE PIPE (Rev. Sta. 83+35.0)
- DETAILS OF PLATE PIPE ARCH (Rev. Sta. 91+79.45 Rt.)
- STANDARD SHEETS
- A-61 (Drilling & Blasting of Solid Rock Sub-grade)
- B-1 (Banking Tables)
- B-5 (Typical Slope Grading)
- B-6 (Tuck Excavation)
- B-11 (Slope Stabilization)
- B-12 (Approach Intersection - Depressed Ramp)
- B-13 (Drive Intersection - Depressed & Crest Ramps)
- C-1 (Timber Cuts)
- D-2 (C.R.M. Headwalls - C.R.M. Retaining Wall - Standard Underdrain)
- D-2 (Bituminous Concrete Outter)
- D-3 (Spec. ACCOMP Pipe Elbows)
- D-8 (Reinf. Conc. D.I. w/Grate (Bottom Section))
- D-10 (Top for Reinf. Conc. D.I. w/Grate)
- D-18 (Prec. Reinf. Conc. Curb D.I. w/ Cast Iron Grate & Frame)
- E-1 (Barricades, Signs & Lights)
- E-8 (Federal-Aid Construction Identification Signs)
- G-2A (Two Cable Guard Rail w/Wood Posts)
- G-4 (Wood Marker Posts - Wood Guide Posts - Plank Guard Rail)
- J-1 (Project Markers - Boundary Markers)
- CROSS SECTIONS
- APPROACH SECTIONS (Town Road #68 - Rev. Sta. 30+43.5 Rt.)
- APPROACH SECTIONS (Town Road #57 - Rev. Sta. 82+45.0 Lt.)
- APPROACH SECTIONS (Town Road #83 - Rev. Sta. 85+53.5 Lt.)
- APPROACH SECTIONS (Town Road #59 - Rev. Sta. 91+79.45 Rt.)
- APPROACH SECTIONS (Town Road #26 - Rev. Sta. 91+79.45 Lt.)
- BANKING TRANSITION DIAGRAMS

PROJECT NAME & NUMBER TYPE PAVEMENT AREA
 RANDOLPH S 0190(1) SA BIT. CONC. PAV. T. 10,363 SY

RECORD PLANS

MATERIALS

SUBBASE OF GRAVEL & GRAVEL SHOULDERS - VESPER'S GRAVEL BAR - STOCKBRIDGE, VT. & SHARON SAND & GRAVEL INC. - SHARON, VT.

GRANULAR BORROW & SOIL FOR SOIL CEMENT - WALLACE PIT - RANDOLPH, VT.

PORTLAND CEMENT FOR SOIL CEMENT - UNIVERSAL ATLAS CEMENT CO. - HUDSON, N.Y.

ASPHALT - MOBIL OIL CO. - E. PROVIDENCE, R.I.

REFINED TAR - WITCO CHEMICAL CO. - WORCESTER, MASS.

PEASTONE - WELLS - AMSON QUARRY CO. INC. - BARRE, VT.

BITUMINOUS CONCRETE - L.M. FIFE & SON INC. (PLANT) - W. LEBANON, N.H.

CONCRETE CLASS "B" - D & D CONCRETE CO. - RANDOLPH, VT.

REINFORCING STEEL - VERMONT STRUCTURAL STEEL CORP. - BURLINGTON, VT.

REINFORCING PIPE & PREC. R.C.P.D.I. - MARTIN MARIETTA CO. - WINDSOR, VT.

ASPH. CTD. CORR. GALV. METAL PIPE - NEW ENGLAND METAL PIPE CO. - WHITE RIVER JUNCTION, VT.

C.I. GRATES - E.L. LABARRON FOUNDRY - BROCKTON, MASS.

GUARD RAIL, WOOD GUIDE & MARKER POSTS & TREATED TIMBER CURB - S.T. GRISWOLD & CO. INC. - WILTON, VT.

CONTRACTOR - ROGERS BROTHERS
 RANDOLPH, VT.
 RESIDENT ENGINEER - G.J. ABAIR.
 INSPECTOR - D. MAHONEY.
 RECORD PLANS - G.J. ABAIR.

CONTRACT:
 DATED - APRIL 23, 1963.
 STARTED - MAY 2, 1963.
 COMPLETED - JANUARY 28, 1964.
 ACCEPTED - JANUARY 28, 1964.

STATE OF VERMONT
DEPARTMENT OF HIGHWAYS
PROPOSED IMPROVEMENT



TOWN OF RANDOLPH
COUNTY OF ORANGE
STATE AID ROUTE #1
RANDOLPH VILLAGE - RANDOLPH CENTER ROAD

FEDERAL AID SECONDARY PROJECT

BEGINNING AT A POINT ON THE RANDOLPH VILLAGE - RANDOLPH CENTER ROAD APPROXIMATELY 0.45 OF A MILE FROM ITS INTERSECTION WITH VERMONT ROUTE 12 AND EXTENDING NORTHEASTERLY 1.472 MILE.

LENGTH OF PROJECT: 7,772.3 FEET = 1.472 MILE

Route: VT 66
 Project: S0190(1) SA
 Plan: 00R401
 Date: 08/28/1962

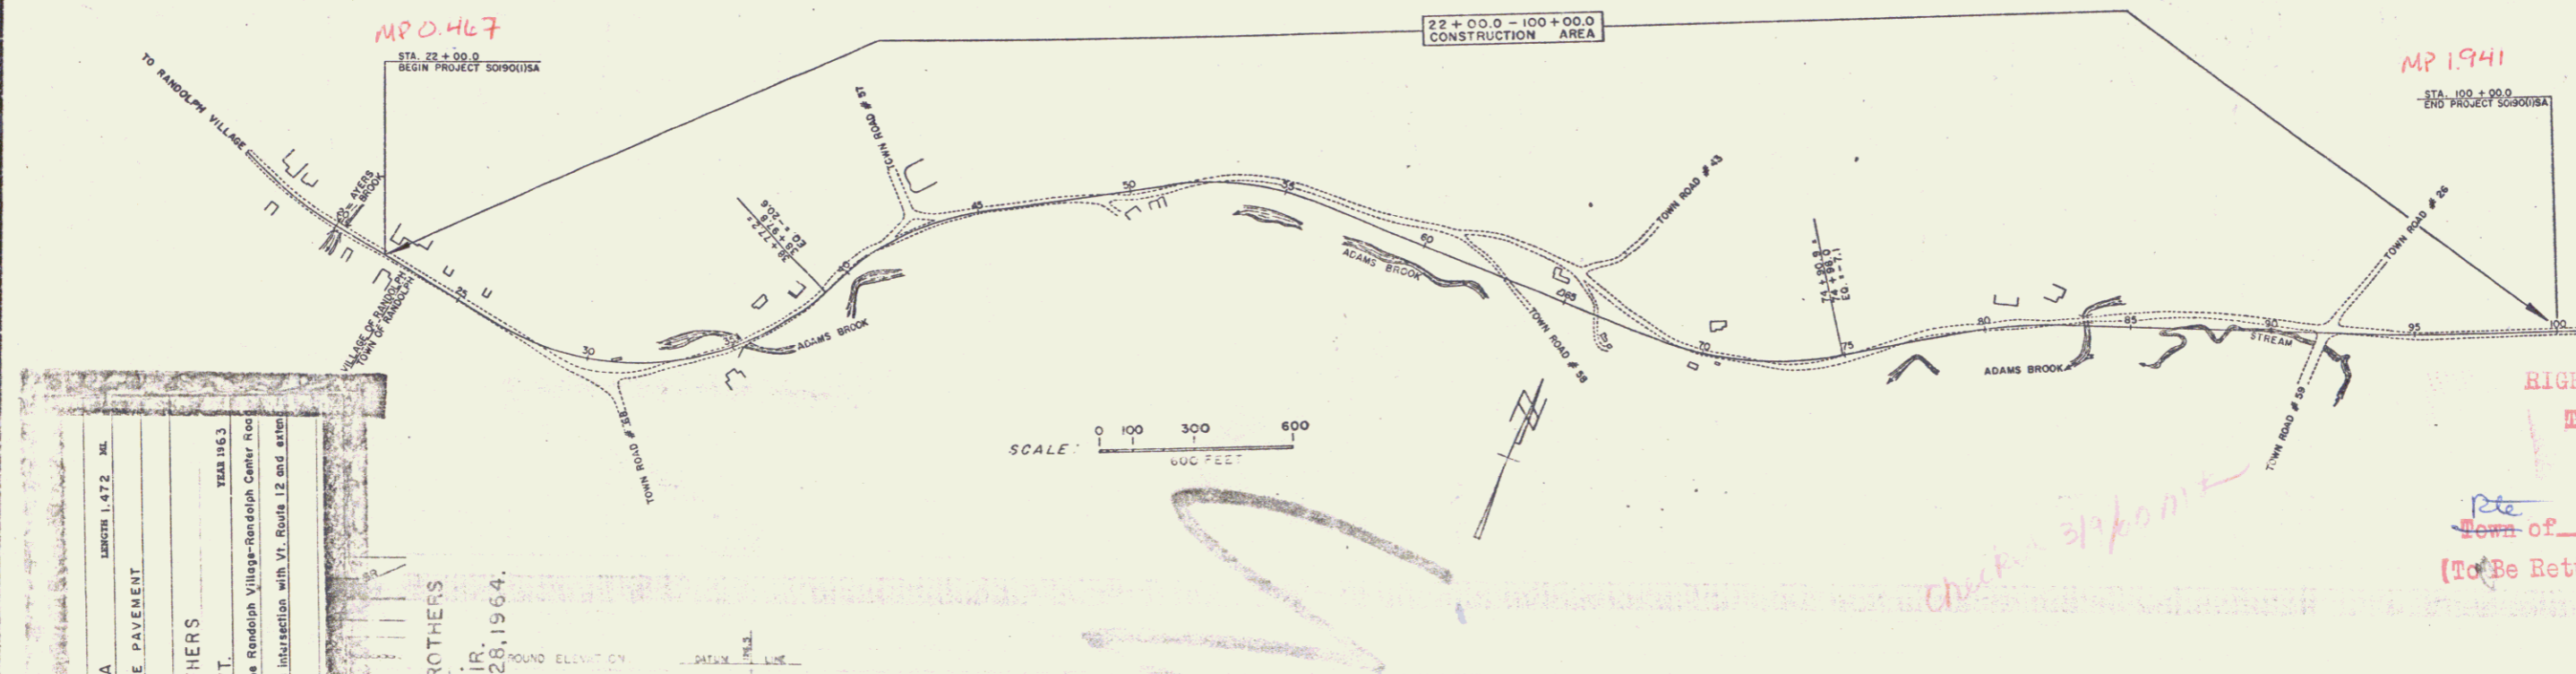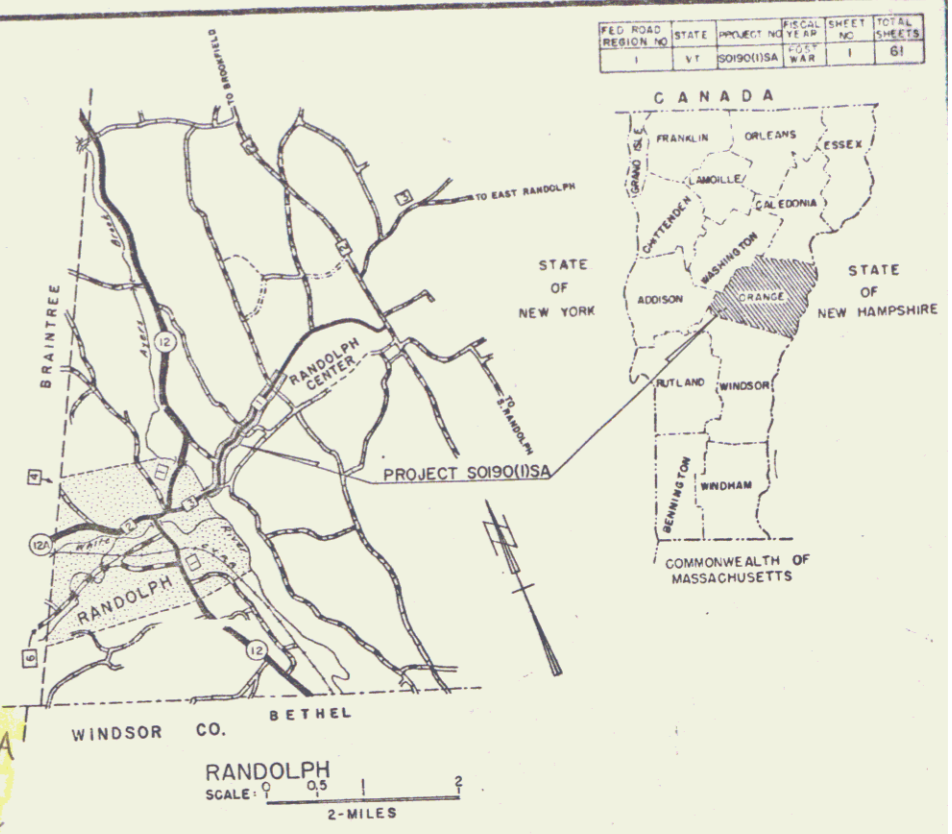

RANDOLPH
 PROJECT S 0190(1) SA
 LENGTH 1.472 MI.
 YEAR 1963
 CONTRACTOR - ROGERS BROTHERS
 RANDOLPH, VT.
 RECORD PLANS - G.J. ABAIR.
 COMPLETED JANUARY 28, 1964.

CURVE DATA

DEFINITION OF ANGLE	A
DEGREE OF CURVE	D
RADIUS OF CURVE	R
TANGENT DISTANCE	T
LENGTH OF CURVE	L
EXTERNAL DISTANCE	E
POINT OF INTERSECTION	PI
POINT OF CURVE	PC
POINT OF TANGENT	PT
POINT ON TANGENT	POT
POINT ON SUB-TANGENT	POST

SCALES

TITLE	1" = 300'
TYPICAL	1" = 48'
PLAN	1" = 50'
PROFILE HORIZONTAL	1" = 10'
PROFILE VERTICAL	1" = 10'
CROSS-SECTIONS	1" = 10'

THESE PLANS ARE SUBJECT TO SUCH REVISIONS AS MAY BE REQUIRED BY THE BUREAU OF PUBLIC ROADS OR THE COMMISSIONER OF HIGHWAYS.

CONSTRUCTION IS TO BE CARRIED ON IN ACCORDANCE WITH THE PLANS AND THE STANDARD SPECIFICATIONS FOR HIGHWAY AND BRIDGE CONSTRUCTION OF JANUARY 1956 SUBMITTED TO THE BUREAU OF PUBLIC ROADS AS APPROVED JULY 3, 1956, INCLUDING ALL SUBSEQUENT APPROVED REVISIONS AND SUCH REVISED SPECIFICATIONS AND SPECIAL PROVISIONS AS ARE SUBMITTED WITH THE PLANS.

APPROVED [Signature] DISTRICT ENGINEER DATE: 8/23/62	APPROVED [Signature] HIGHWAY ENGINEER DATE: 8/26/62	APPROVED [Signature] DATE: 8/26/62	APPROVED [Signature] DATE: 8/26/62
---	--	--	--

RIGHT-OF-WAY DIVISION
 TOWN FILE
 PERPETUAL
 Town of VT 66
 (To Be Returned To H.O.W. Division)

DEPARTMENT OF COMMERCE
 BUREAU OF PUBLIC ROADS

PROJECT NO. 0190(1) SA
 SHEET 1 OF 61 SHEETS