


PLAN	DATE	BY
REVISED		
NO. 1	DATE	BY
NO. 2	DATE	BY
NO. 3	DATE	BY

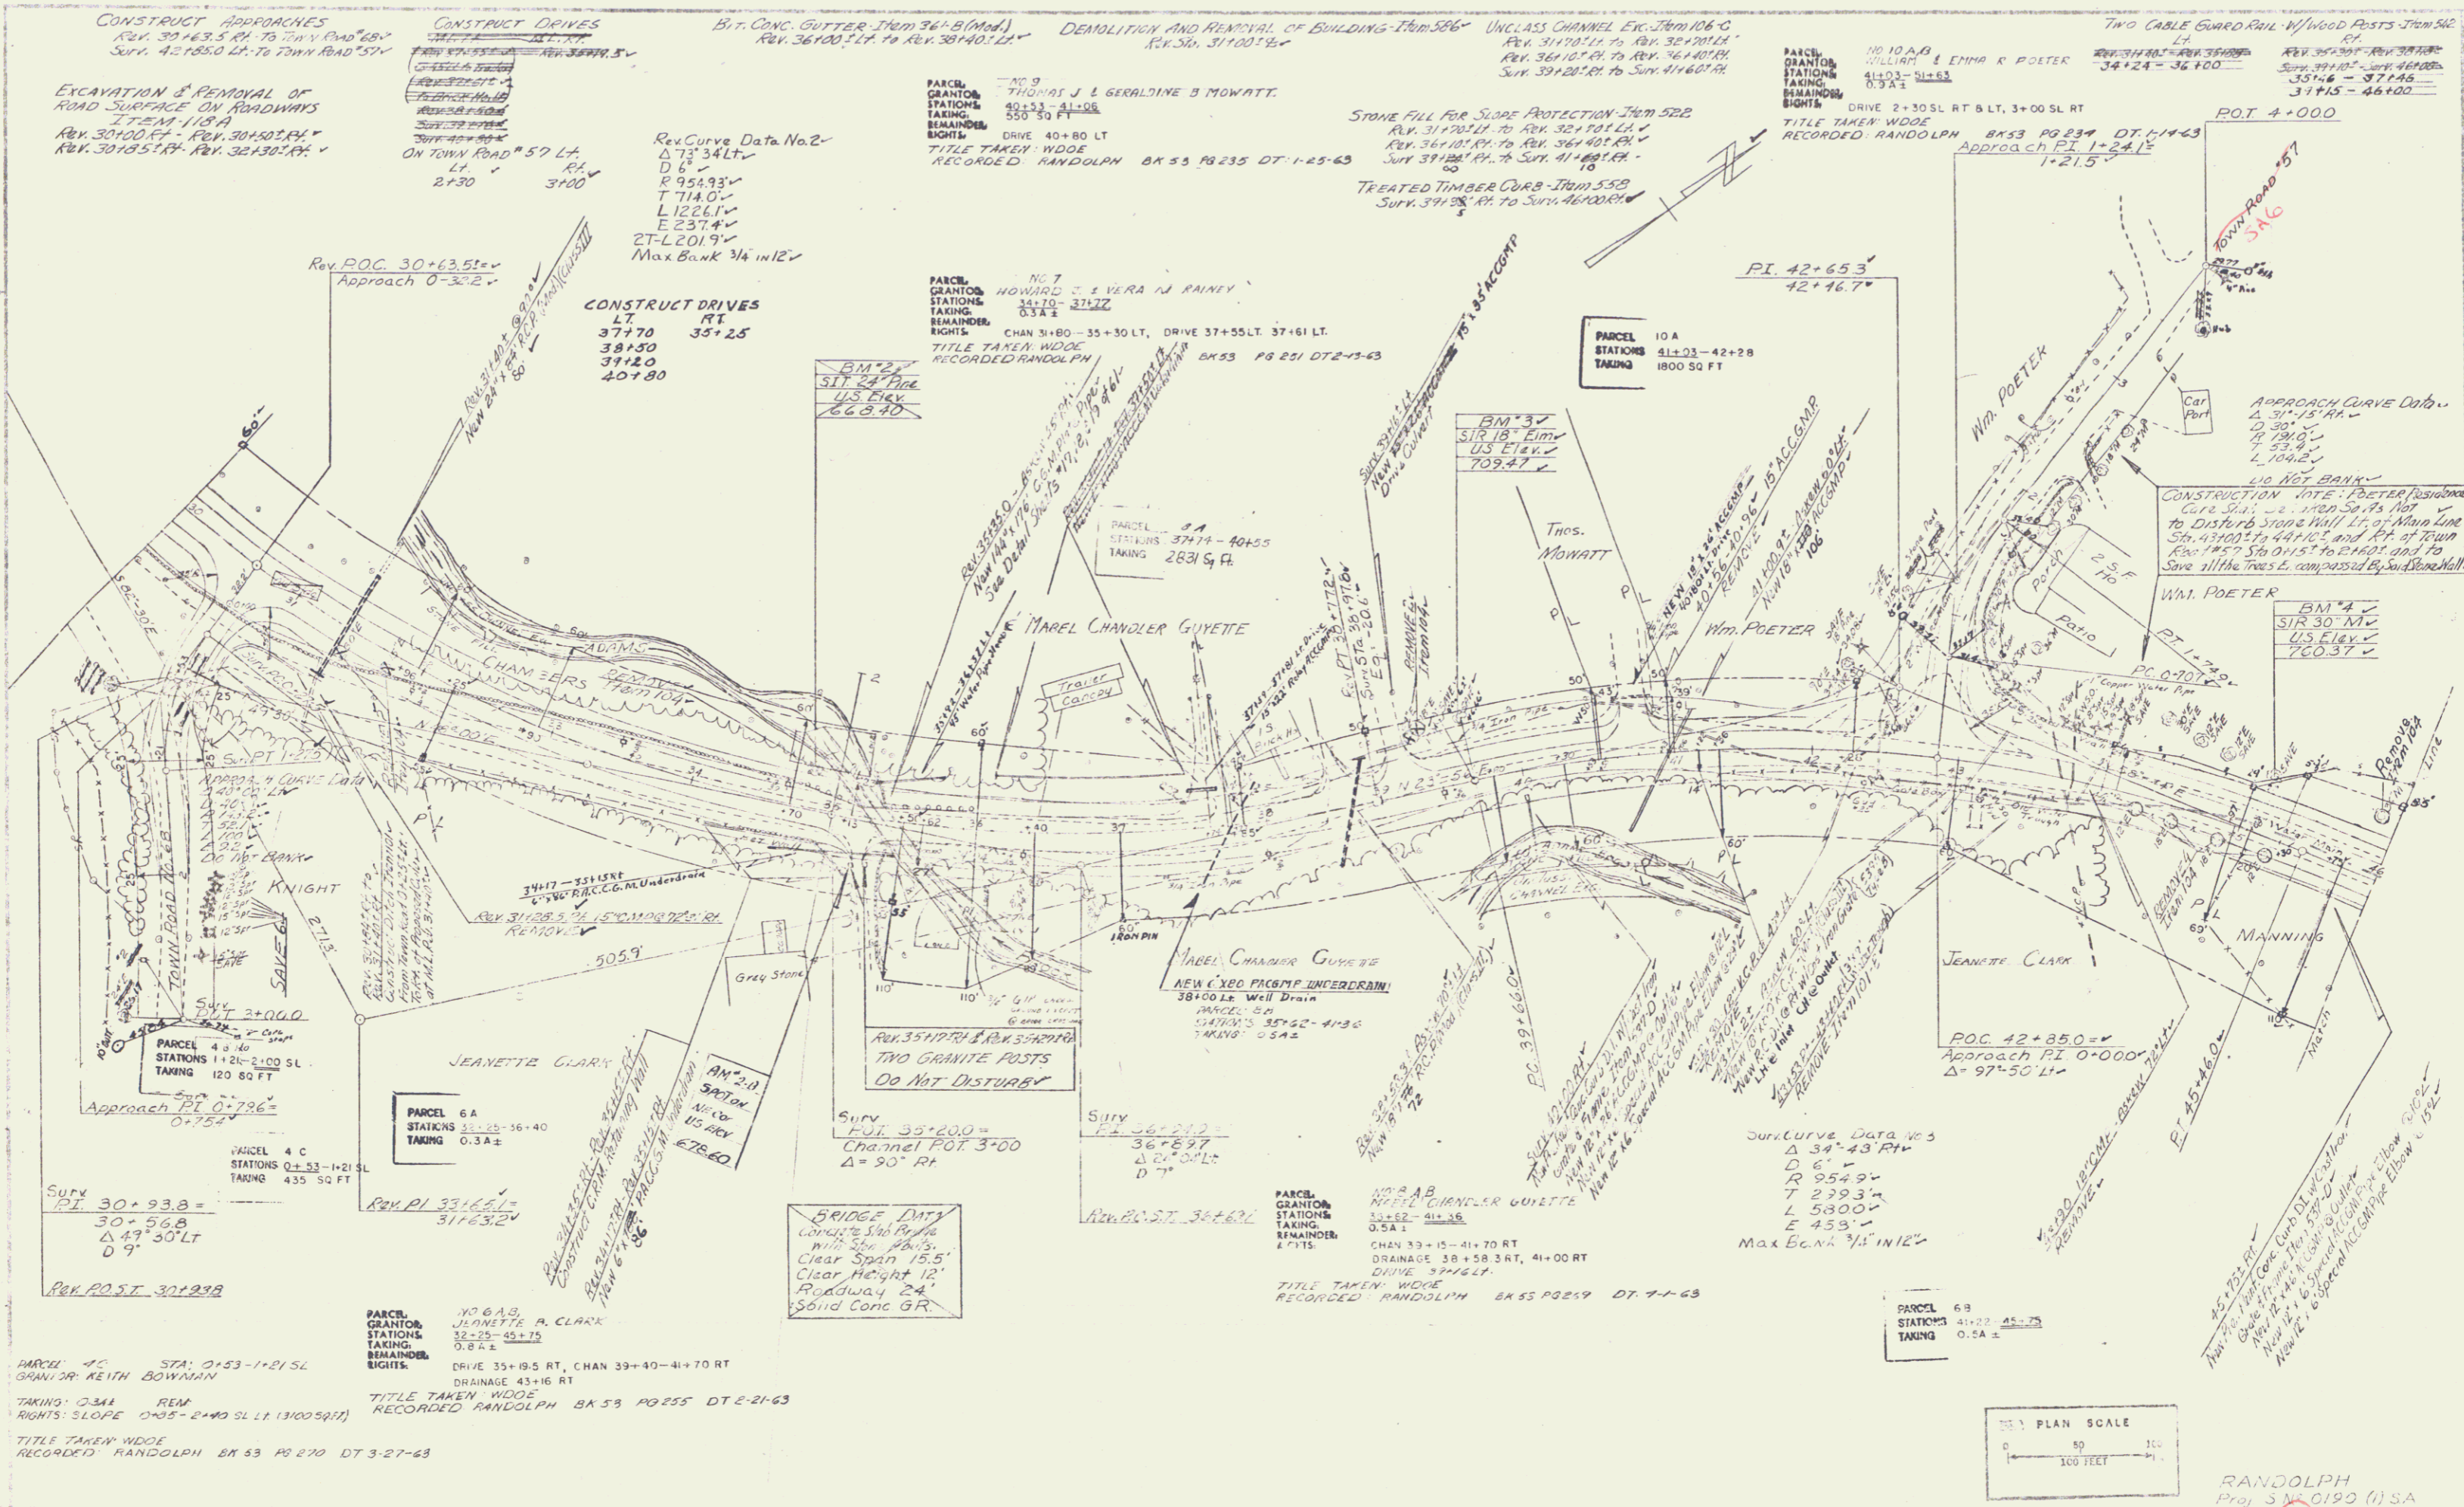

CONSTRUCT APPROACHES
 Rev. 30+43.5 PI to Town Road 57N
 Surv. 42+185.0 LA to Town Road 57N

EXCAVATION & REMOVAL OF ROAD SURFACE ON ROADWAYS
 ITEM 118A
 Rev. 30+100 PI to Rev. 30+130 PI
 Rev. 30+135 PI to Rev. 30+130 PI

CONSTRUCT DRIVES
 ON TOWN ROAD 57N LA
 2+30 3+00

Rev. Curve Data No. 2
 Δ 73° 34' LT
 D 6'
 R 954.93'
 T 714.0'
 L 1226.1'
 E 237.4'
 27+L 201.9'
 Max Bank 3/4 IN 12"

CONSTRUCT DRIVES
 LT RT
 37+70 35+25
 38+50 37+120
 40+80

PARCEL NO. 7
 GRANTEE HOWARD J. & GERALDINE B. MOWATT
 STATIONS 34+10 - 37+27
 TAKING 0.3A ±
 REMAINDER CHAN 31+80 - 35+30 LT, DRIVE 37+55 LT 37+61 LT.
 TITLE TAKEN WDOE
 RECORDED RANDOLPH BK 53 PG 231 DT 2-12-63

STONE FILL FOR SLOPE PROTECTION Item 522
 Rev. 31+100 PI to Rev. 32+100 PI
 Rev. 36+100 PI to Rev. 36+100 PI
 Surv. 39+100 PI to Surv. 41+00 PI
 Surv. 39+100 PI to Surv. 41+00 PI

PARCEL NO. 10A
 GRANTEE WILLIAM & EMMA R. POETER
 STATIONS 41+22 - 42+28
 TAKING 0.5A ±
 REMAINDER DRIVE 2+30 SL RT & LT, 3+00 SL RT
 TITLE TAKEN WDOE
 RECORDED RANDOLPH BK 53 PG 234 DT 1-14-63

TWO CABLE GUARD RAIL W/ WOOD POSTS FROM 542
 LA
 Rev. 35+30 PI to Rev. 37+15
 Surv. 39+100 PI to Surv. 41+00 PI
 34+24 - 36+00
 35+16 - 37+15
 37+15 - 46+00

PARCEL 4C
 GRANTEE KENTH BOWMAN
 STA. 0+53 - 1+21 SL
 TAKING 0.3A REM
 RIGHTS: SLOPE 0+35 - 2+40 SL LT (31005971)
 TITLE TAKEN WDOE
 RECORDED RANDOLPH BK 53 PG 210 DT 3-27-63


PARCEL 6A
 GRANTEE JEANETTE A. CLARK
 STATIONS 32+25 - 45+75
 TAKING 0.3A ±
 REMAINDER DRIVE 35+19.5 RT, CHAN 39+40 - 41+70 RT
 DRAINAGE 43+16 RT
 TITLE TAKEN WDOE
 RECORDED RANDOLPH BK 53 PG 255 DT 2-21-63

BRIDGE DATA
 CONCRETE SUB PILE
 WITH 50# BARS
 CLEAR SPAN 15.5'
 CLEAR HEIGHT 12'
 ROADWAY 24'
 SOLID CONC. GR.

PARCEL NO. 8A
 GRANTEE MAREL CHANDLER GUYETTE
 STATIONS 35+52 - 41+36
 TAKING 0.5A ±
 REMAINDER CHAN 33+15 - 41+70 RT
 DRAINAGE 38+58.3 RT, 41+00 RT
 DRIVE 37+61
 TITLE TAKEN WDOE
 RECORDED RANDOLPH BK 53 PG 259 DT 4-4-63

Surf. Curve Data No. 3
 Δ 34° 43' RT
 D 6'
 R 254.9'
 T 239.3'
 L 580.0'
 E 453'
 Max Bank 3/4 IN 12"

PARCEL 6B
 GRANTEE JEANETTE A. CLARK
 STATIONS 41+22 - 42+28
 TAKING 0.5A ±

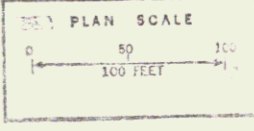

RANDOLPH
 Proj. 5 N 0190 (1) SA
 Sheet 10 of 11