
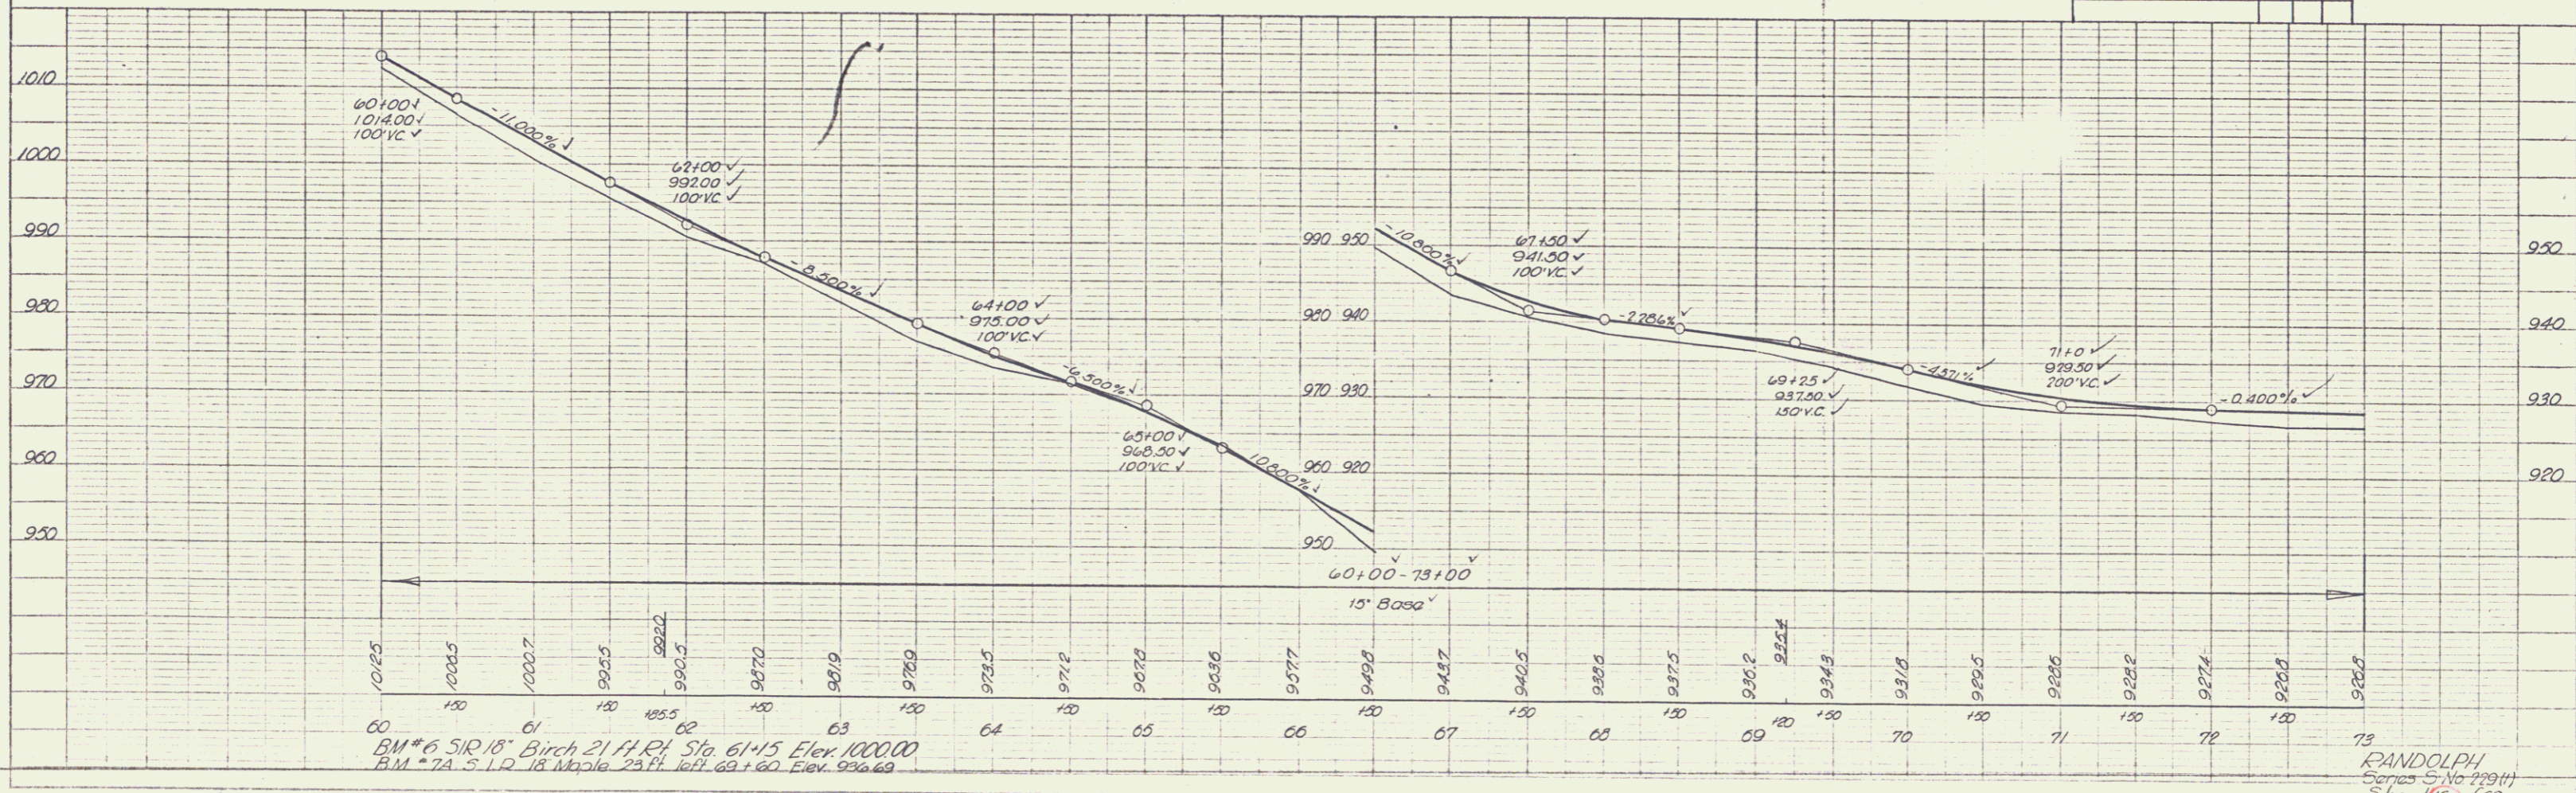


PLAN  
 DATE: R. Abrer 1/50  
 DRAWN BY: J. J. [unclear]  
 CHECKED BY: J. J. [unclear]

FILE NO. 100  
 SHEET NO. 100  
 PROJECT NO. 100

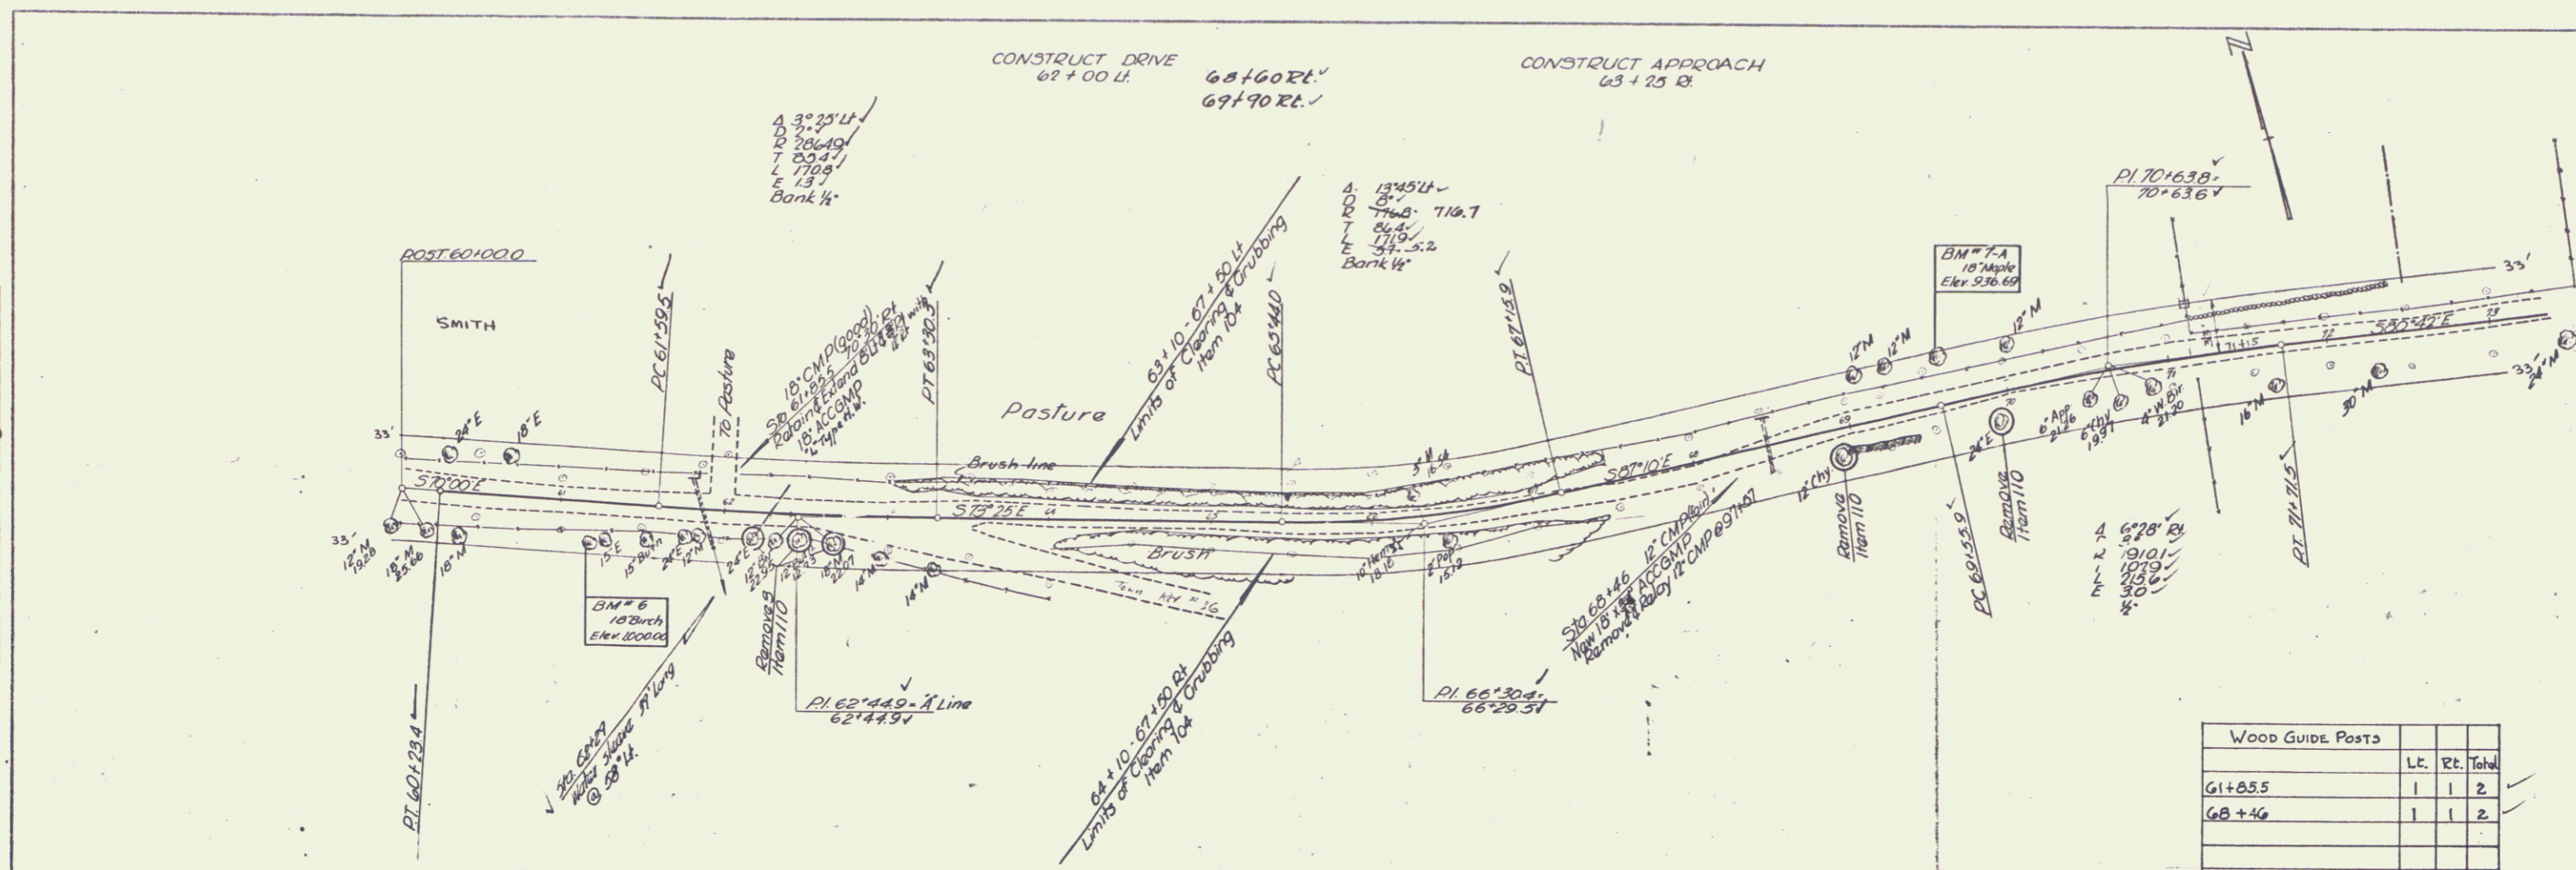

BM # 6 SIR 18 Birch 21 ft Ht Sta. 61+15 Elev. 1000.00  
 BM # 7A 5 1/2" 18 Maple 25 ft Ht Sta. 69+60 Elev. 936.69

RANDOLPH  
 Series S-1 (No. 22911)  
 Sheet 10 of 69

PLATE 1 - PLAN-PROFILES, D. A. & C. STANDARD  
 MECHANICAL & ELECTRICAL ENGINEERS  
 100 N. 10th St. S. Minneapolis, Minn. 55403