



PLAN
 SHEET NO. 10
 DATE: 10/1/09
 PROJECT: [illegible]
 DRAWN BY: [illegible]
 CHECKED BY: [illegible]

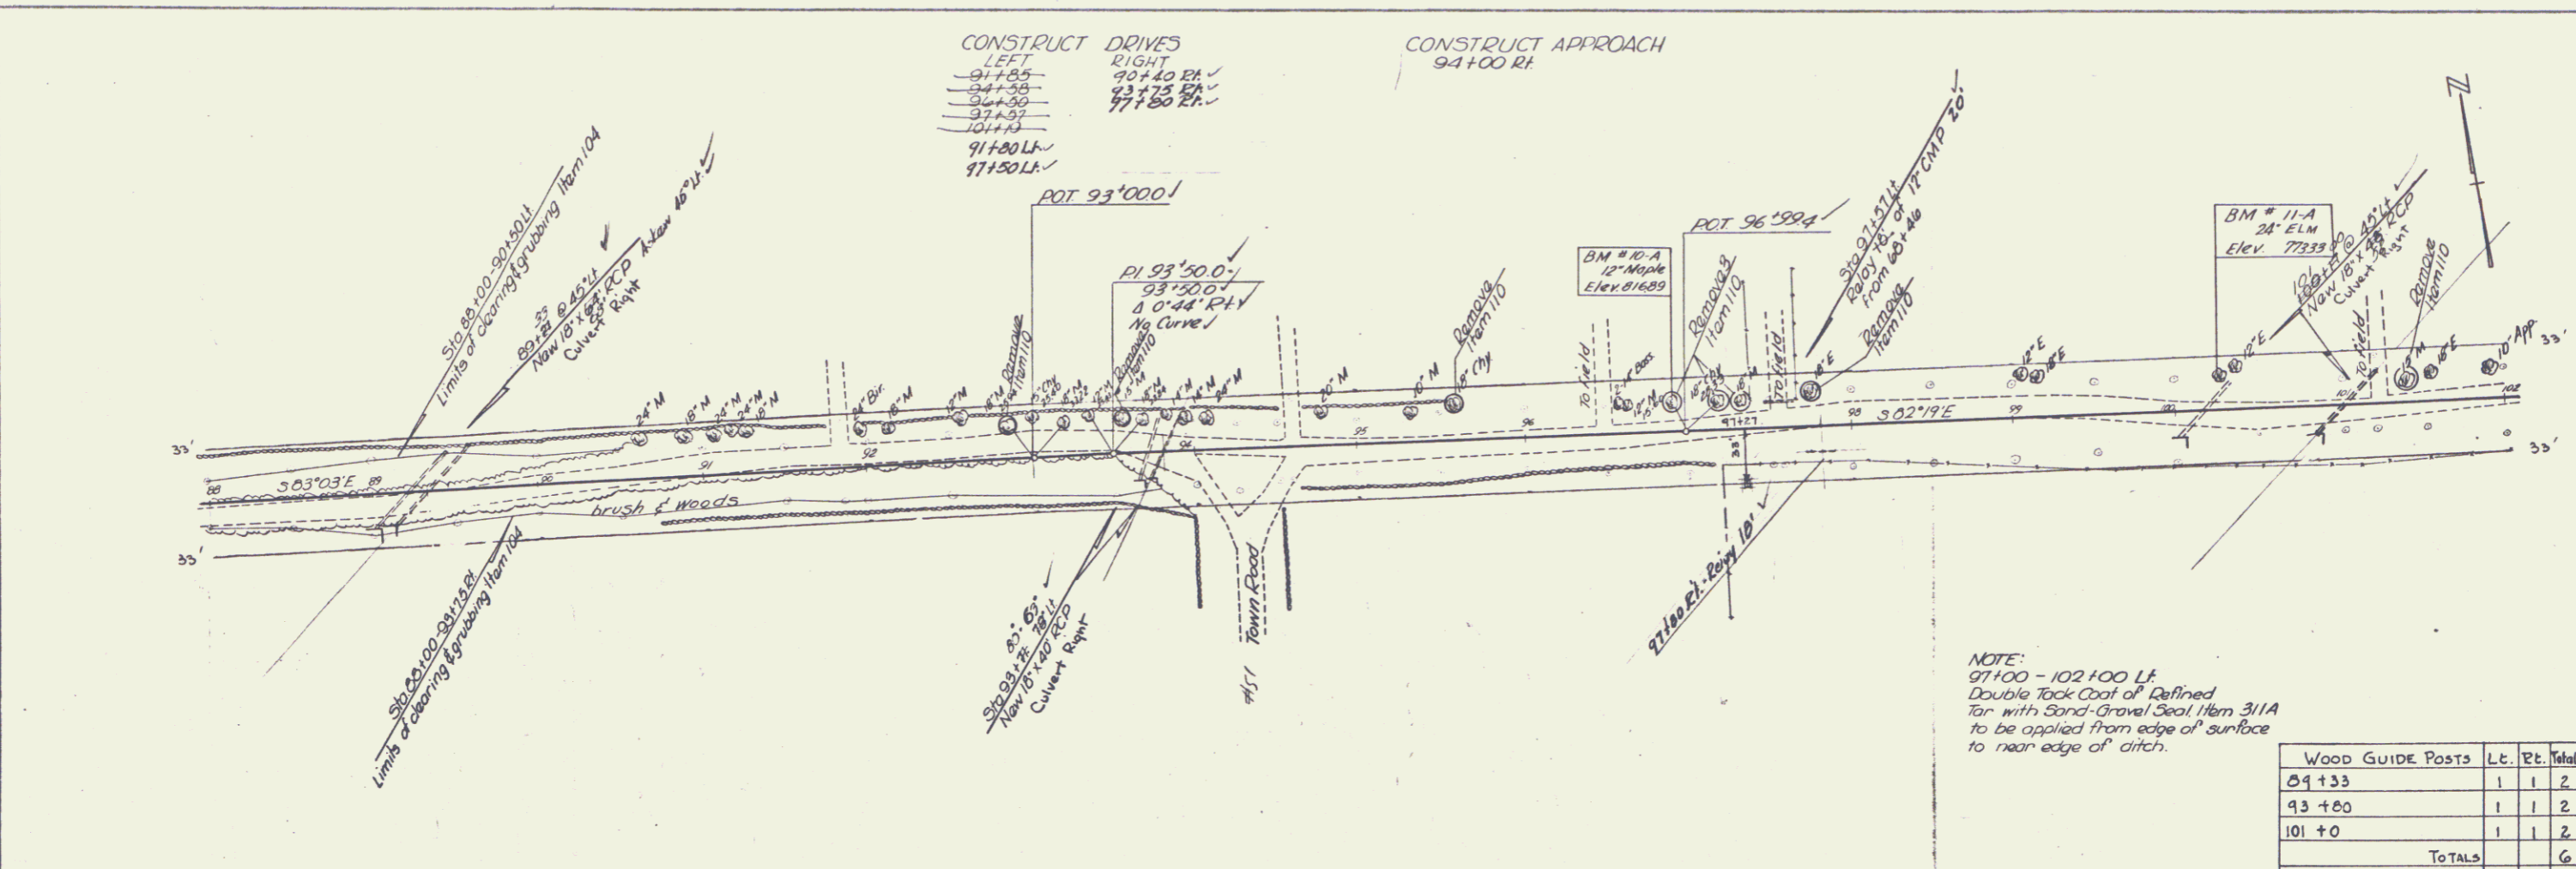

NOTE:
 97+00 - 102+00 LF
 Double Tick Coat of Defined
 Top with Sand-Gravel Seal Mem 311A
 to be applied from edge of surface
 to near edge of ditch.

WOOD GUIDE POSTS	Lt.	Rt.	Total
89+35	1	1	2
93+80	1	1	2
101+0	1	1	2
TOTALS			6

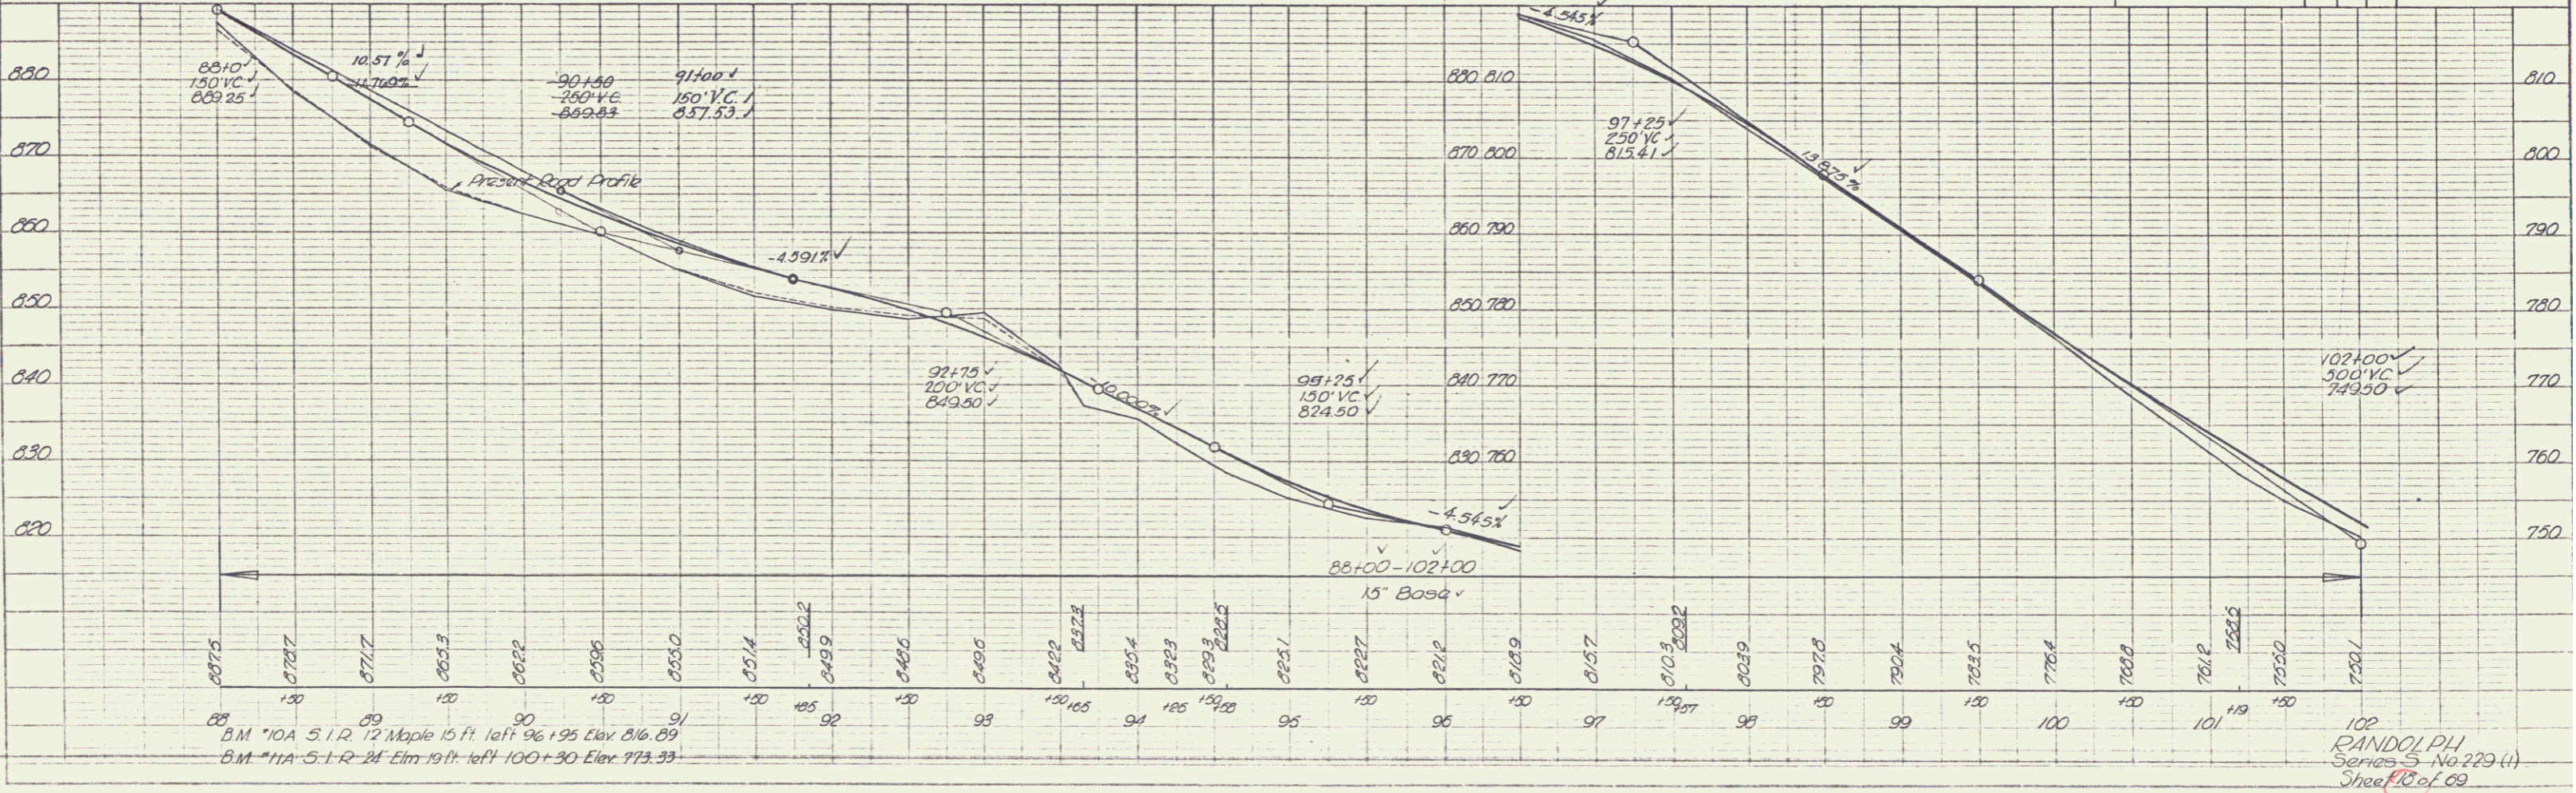

100
 RANDOLPH
 Series 5 No. 229 (1)
 Sheet 10 of 09