


PLAN
 SHEETED BY P. Kerr
 DATE BOOKED 8/18/69


PROFILE
 SHEETED BY P. Kerr
 DATE BOOKED 8/18/69

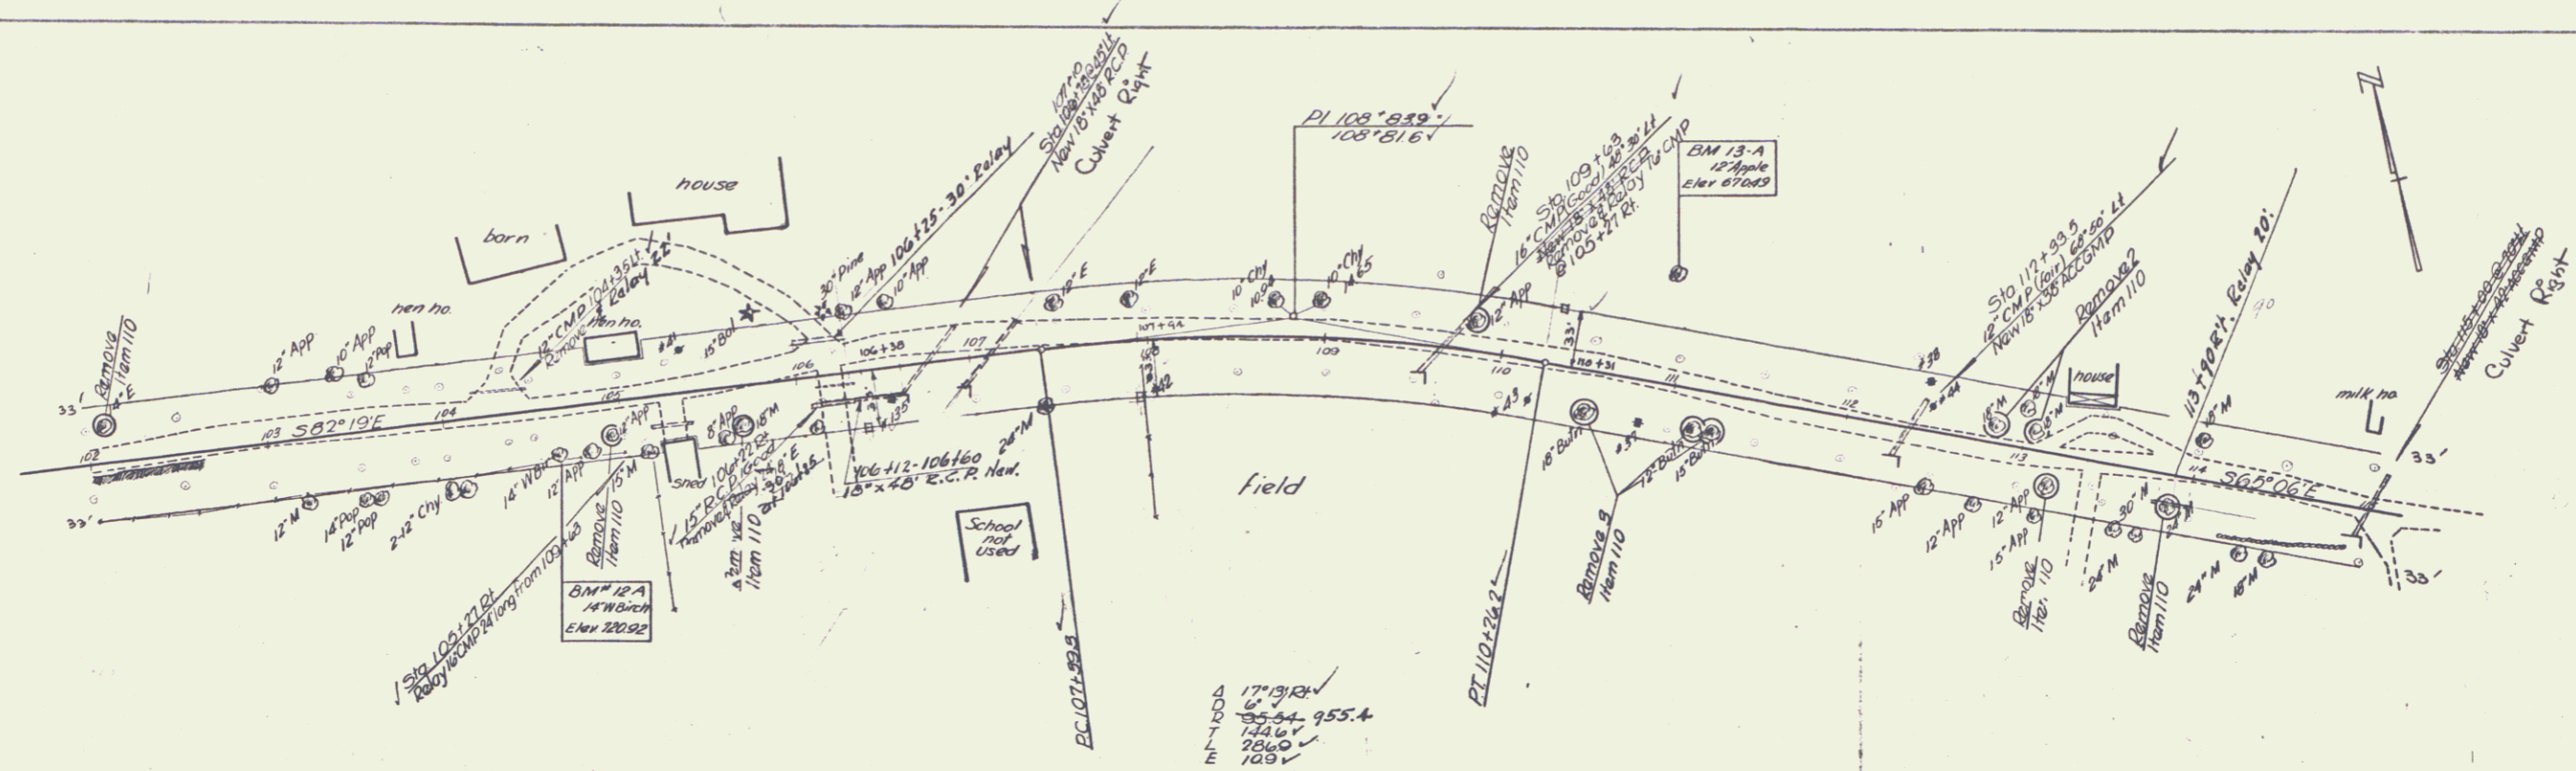

CONSTRUCT DRIVES

LEFT	RIGHT
104+25	104+25
106+22	106+22
113+15	113+23
114+50	115+13
104+30	105+10
108+40	108+30
113+60	113+90

WOOD GUIDE POSTS	Lt.	Rt.	Total
107+10	1	1	2
110+00	1	1	2
112+33.5	1	1	2
TOTALS			6

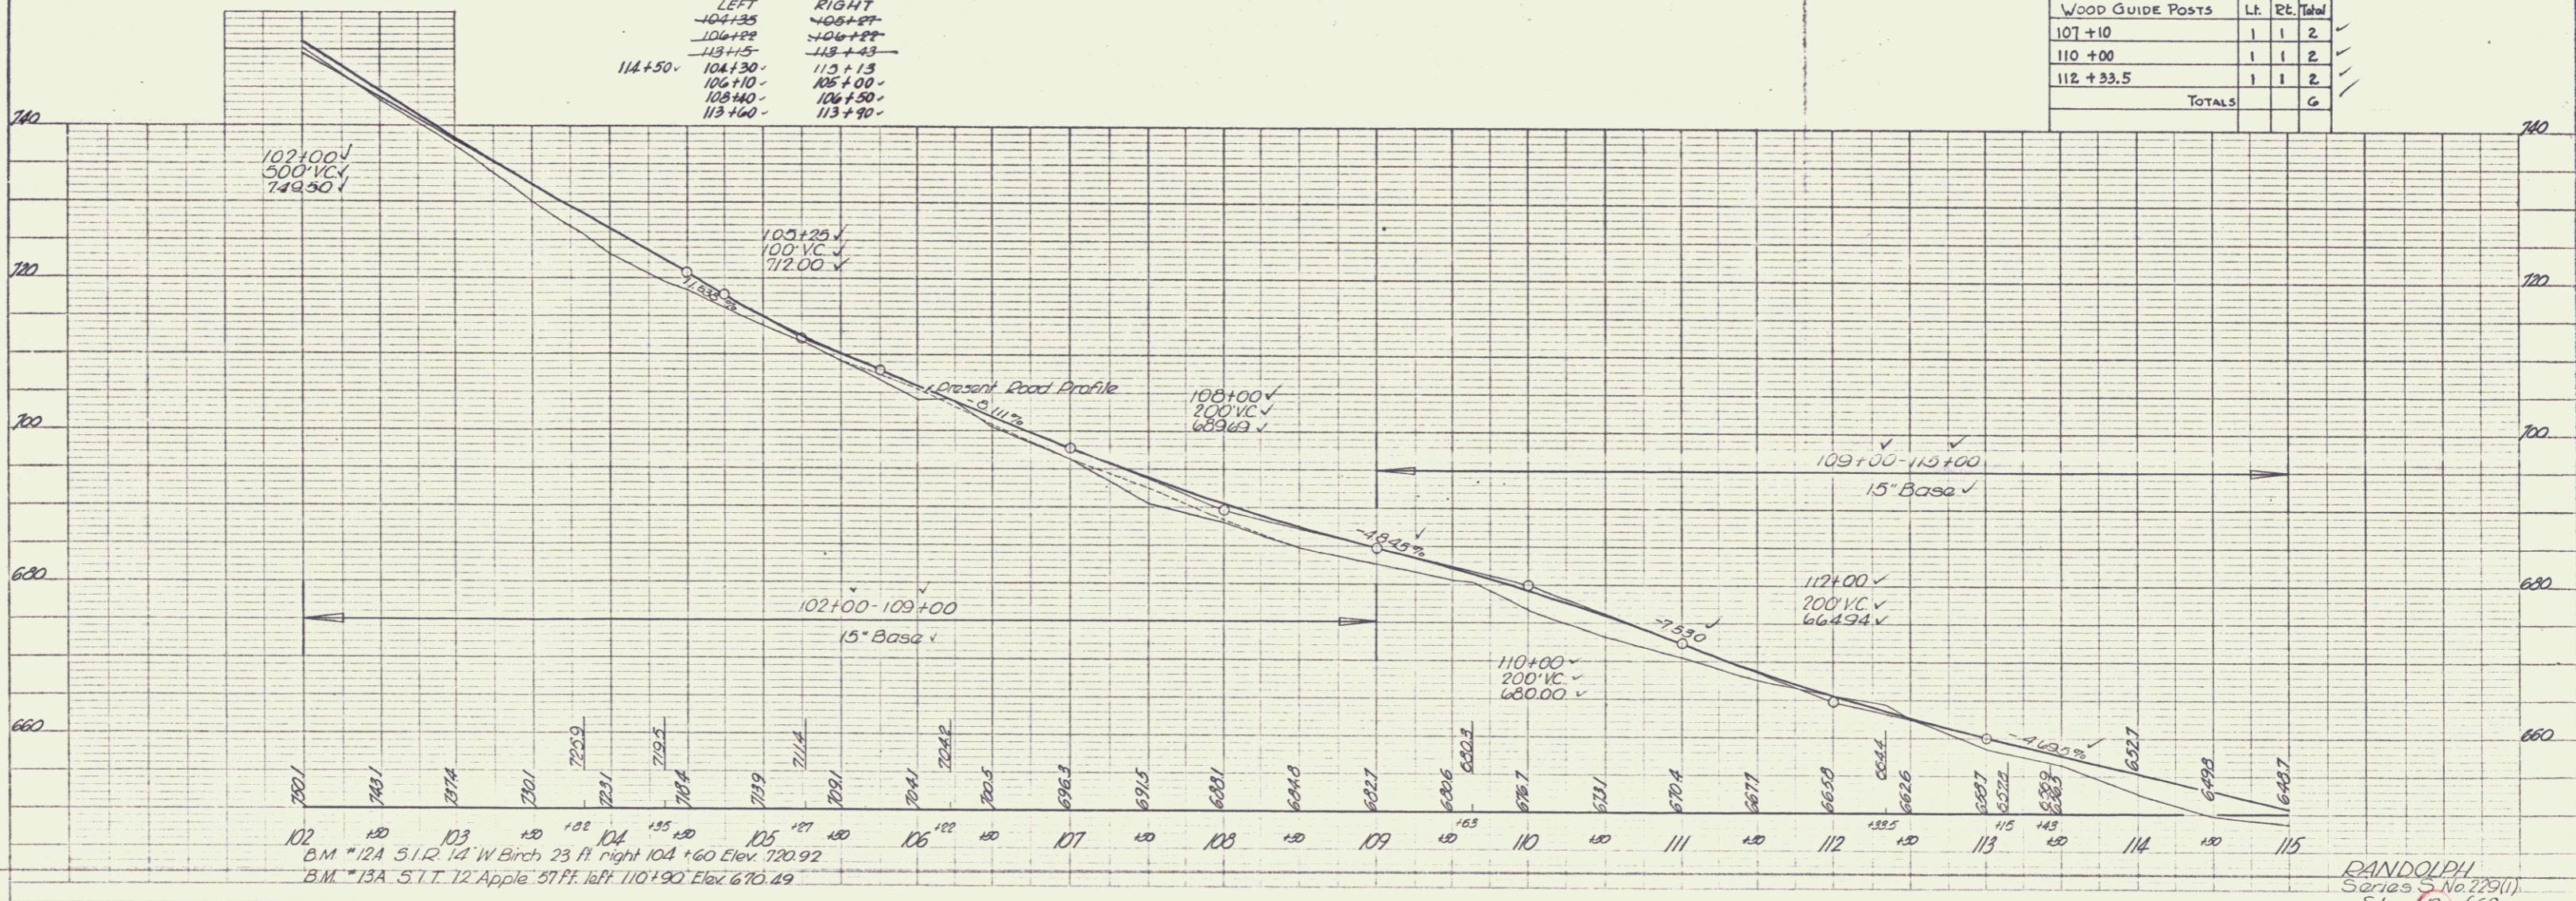

B.M. #12A 5.1 R. 14" W Birch 23 ft right 104+60 Elev. 720.92
 B.M. #13A 5.1 T. 12" Apple 37 ft left 110+90 Elev. 670.49

RANDOLPH
 Series S No. 779(1)
 Sheet 19 of 69

PLATE 19-1 (1969) 24 X 36 IN. (610 X 914 MM)
 REVISED EDITION
 1969