


PLAN
 DATE: 1/20/69
 DRAWN BY: R. Morr
 CHECKED BY: J. G. ...
 PROJECT: ...

PROFILE
 DATE: 1/20/69
 DRAWN BY: R. Morr
 CHECKED BY: J. G. ...
 PROJECT: ...

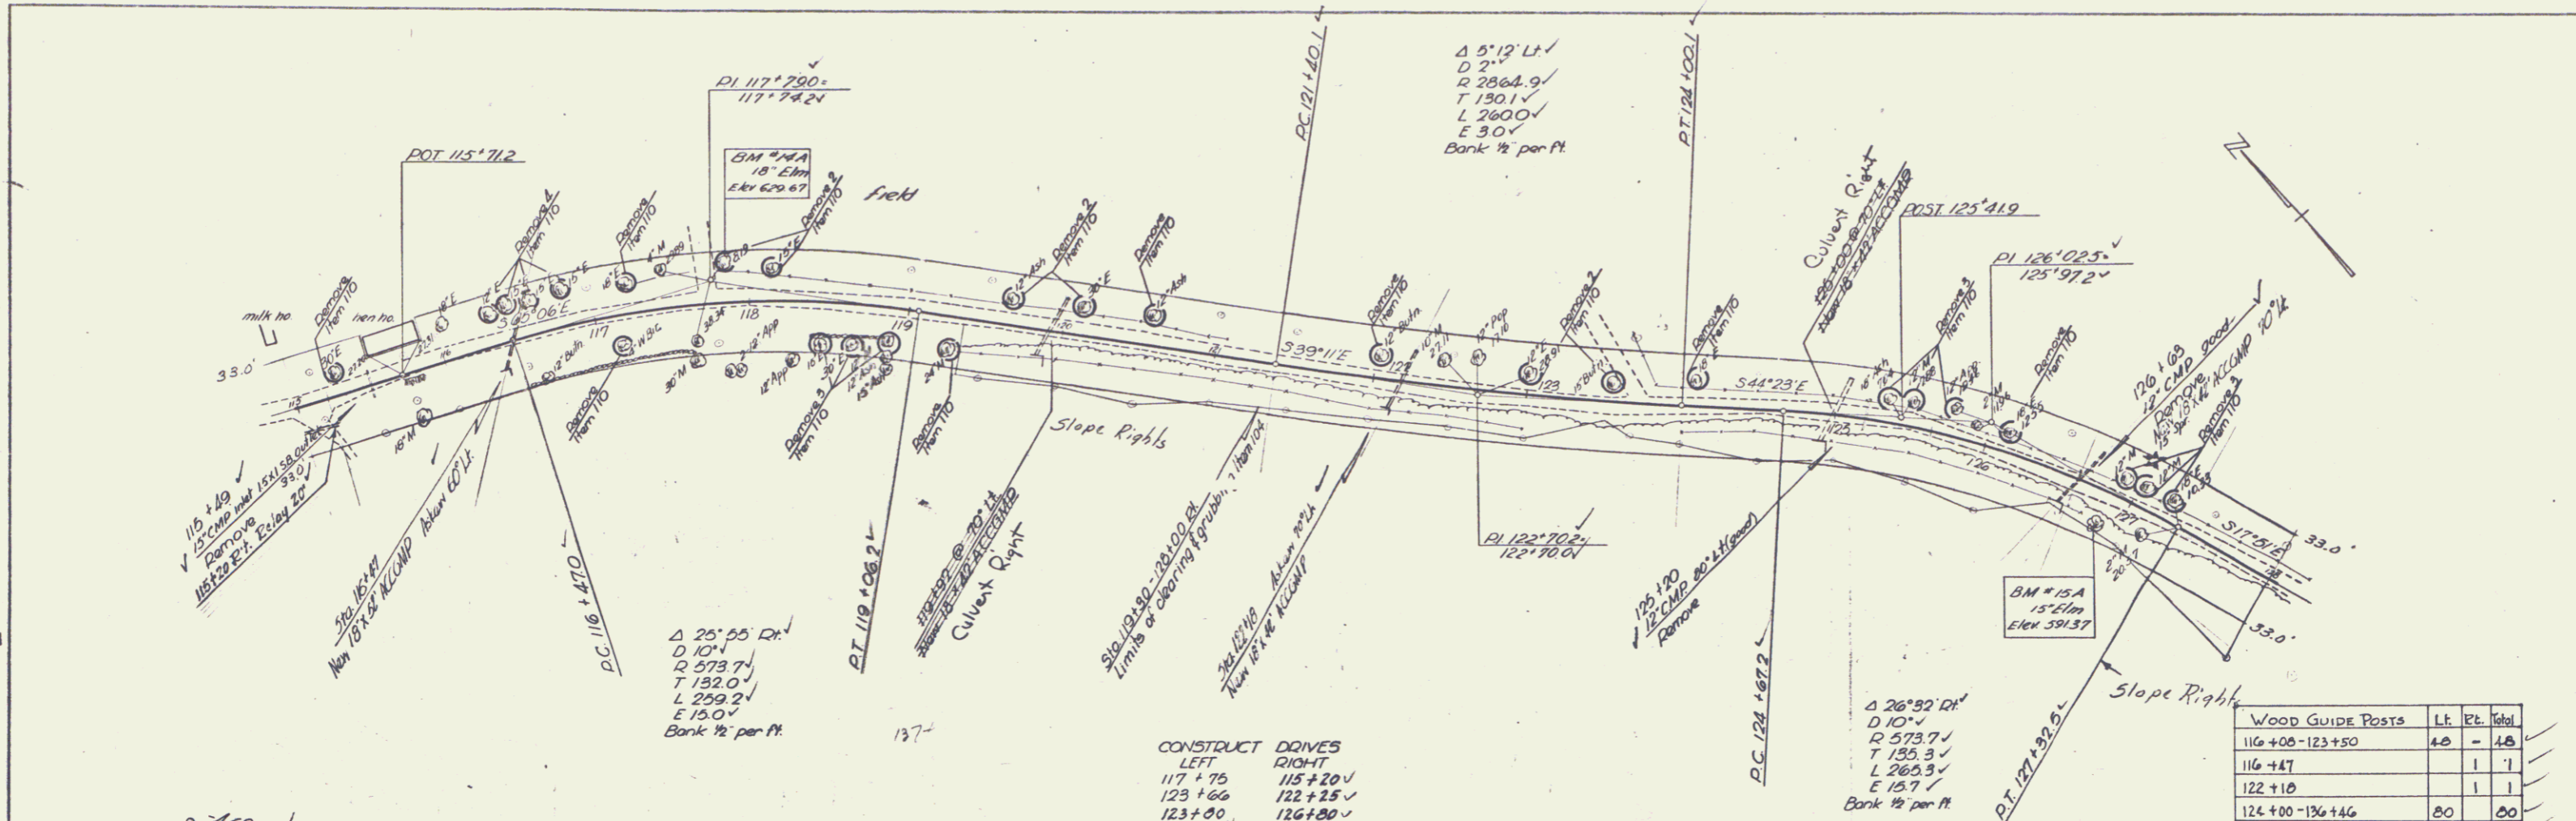


CONSTRUCT DROVES

LEFT	RIGHT
117+75	115+20
123+66	122+25
123+80	126+80
123+90	

WOOD GUIDE POSTS

Station	Lt.	Rt.	Total
116+00-123+50	40	40	80
116+47	1	1	2
122+10	1	1	2
124+00-126+46	80	80	160
126+63	1	1	2

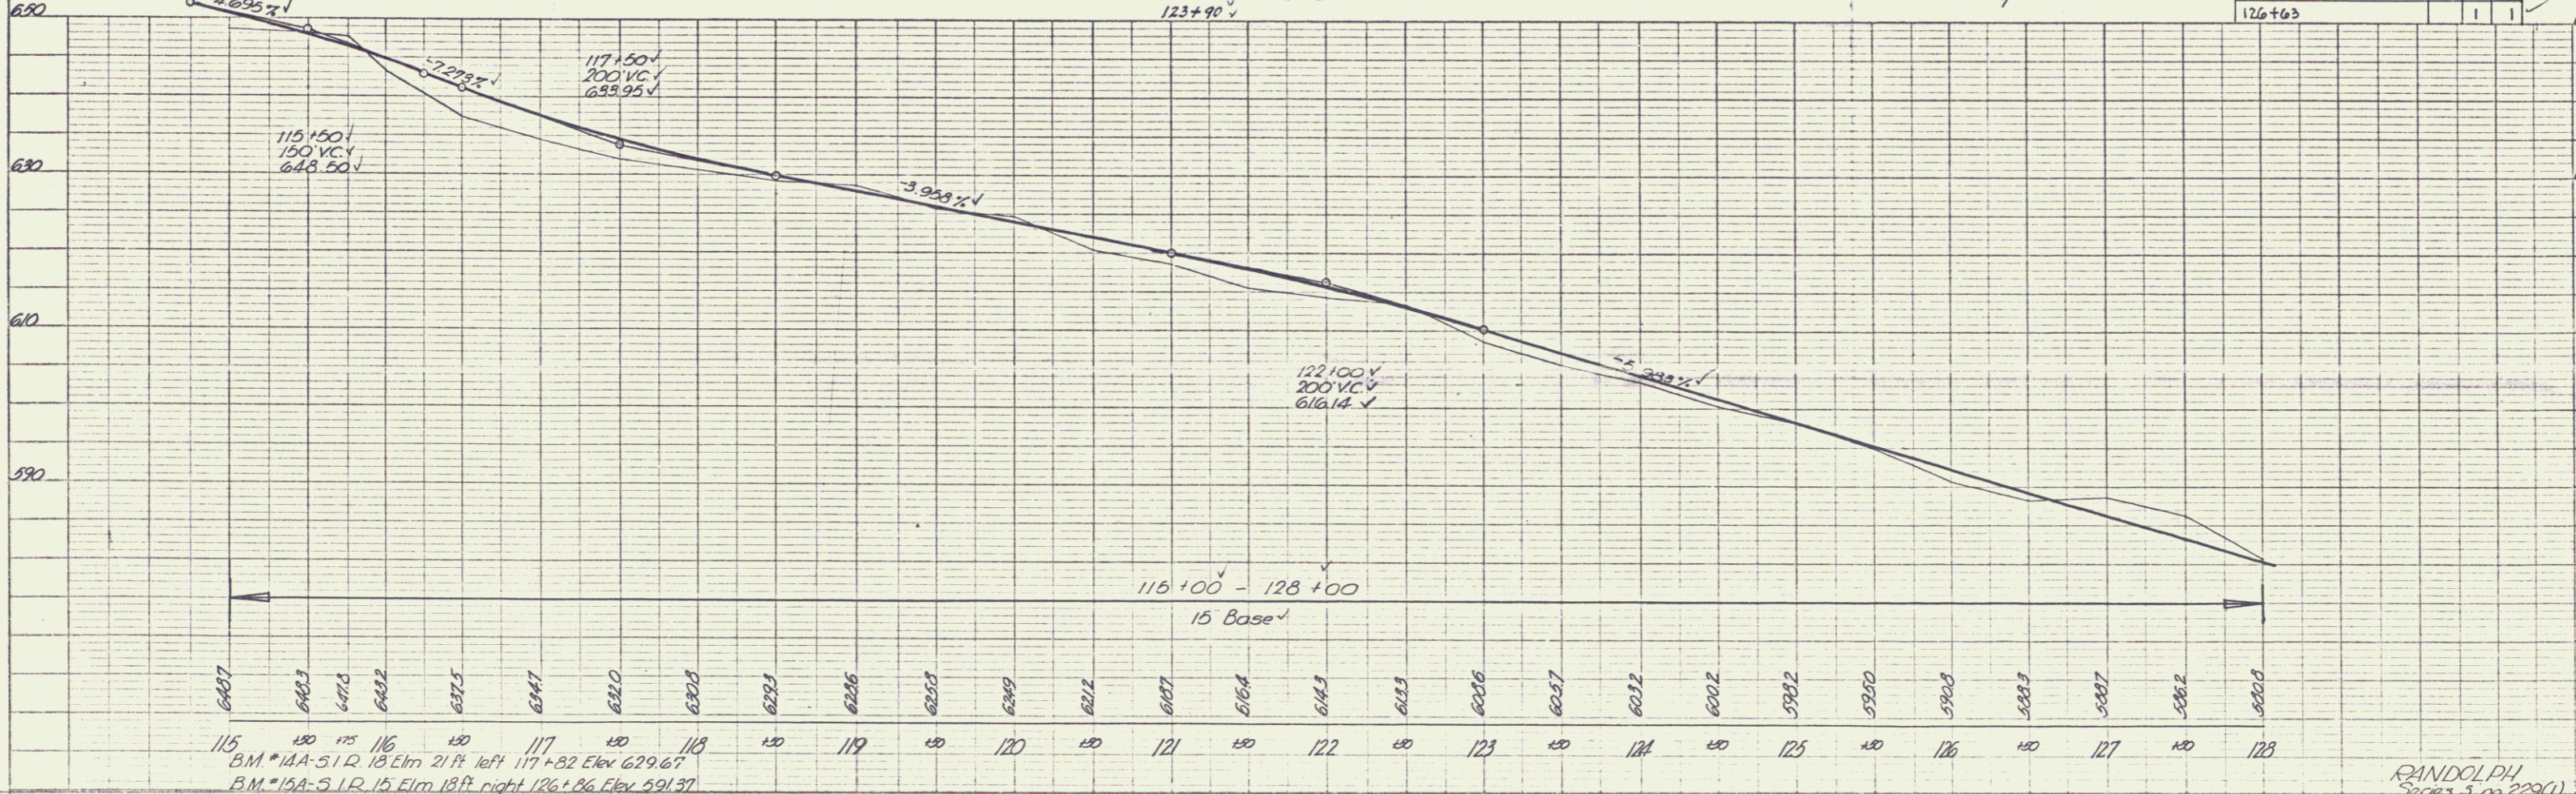

115 120 125 1000

RANDOLPH
 Series 3 no 229(1)
 Sheet 20 of 69