
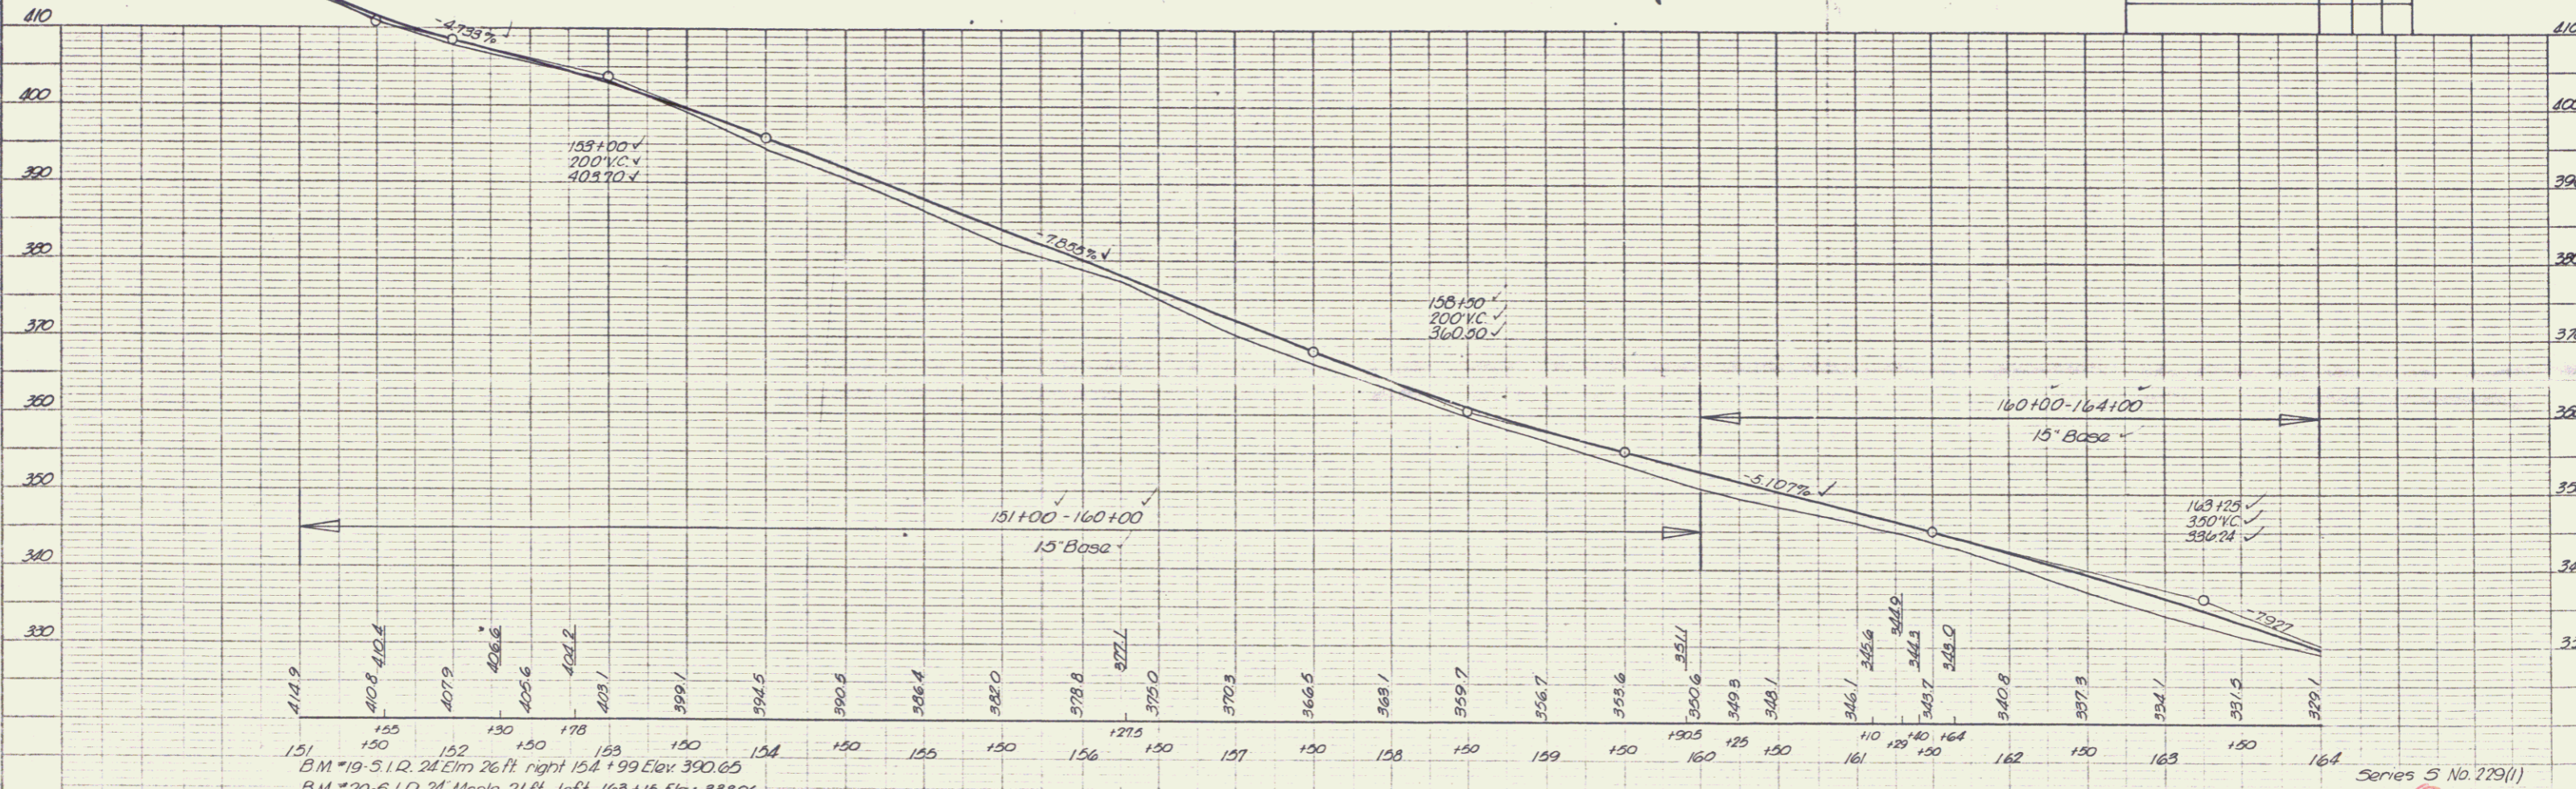


PLAN  
 DATE: 10/15/11  
 PROJECT: 10469  
 NOTE BOOK ALIGNMENT CHECKED: [ ]  
 NO. OF WPT CHECKED: [ ]

PROFILE  
 DATE: 10/15/11  
 PROJECT: 10469  
 NOTE BOOK IN WPT CHECKED: [ ]  
 NO. OF STRUCTURE WPT CHECKED: [ ]

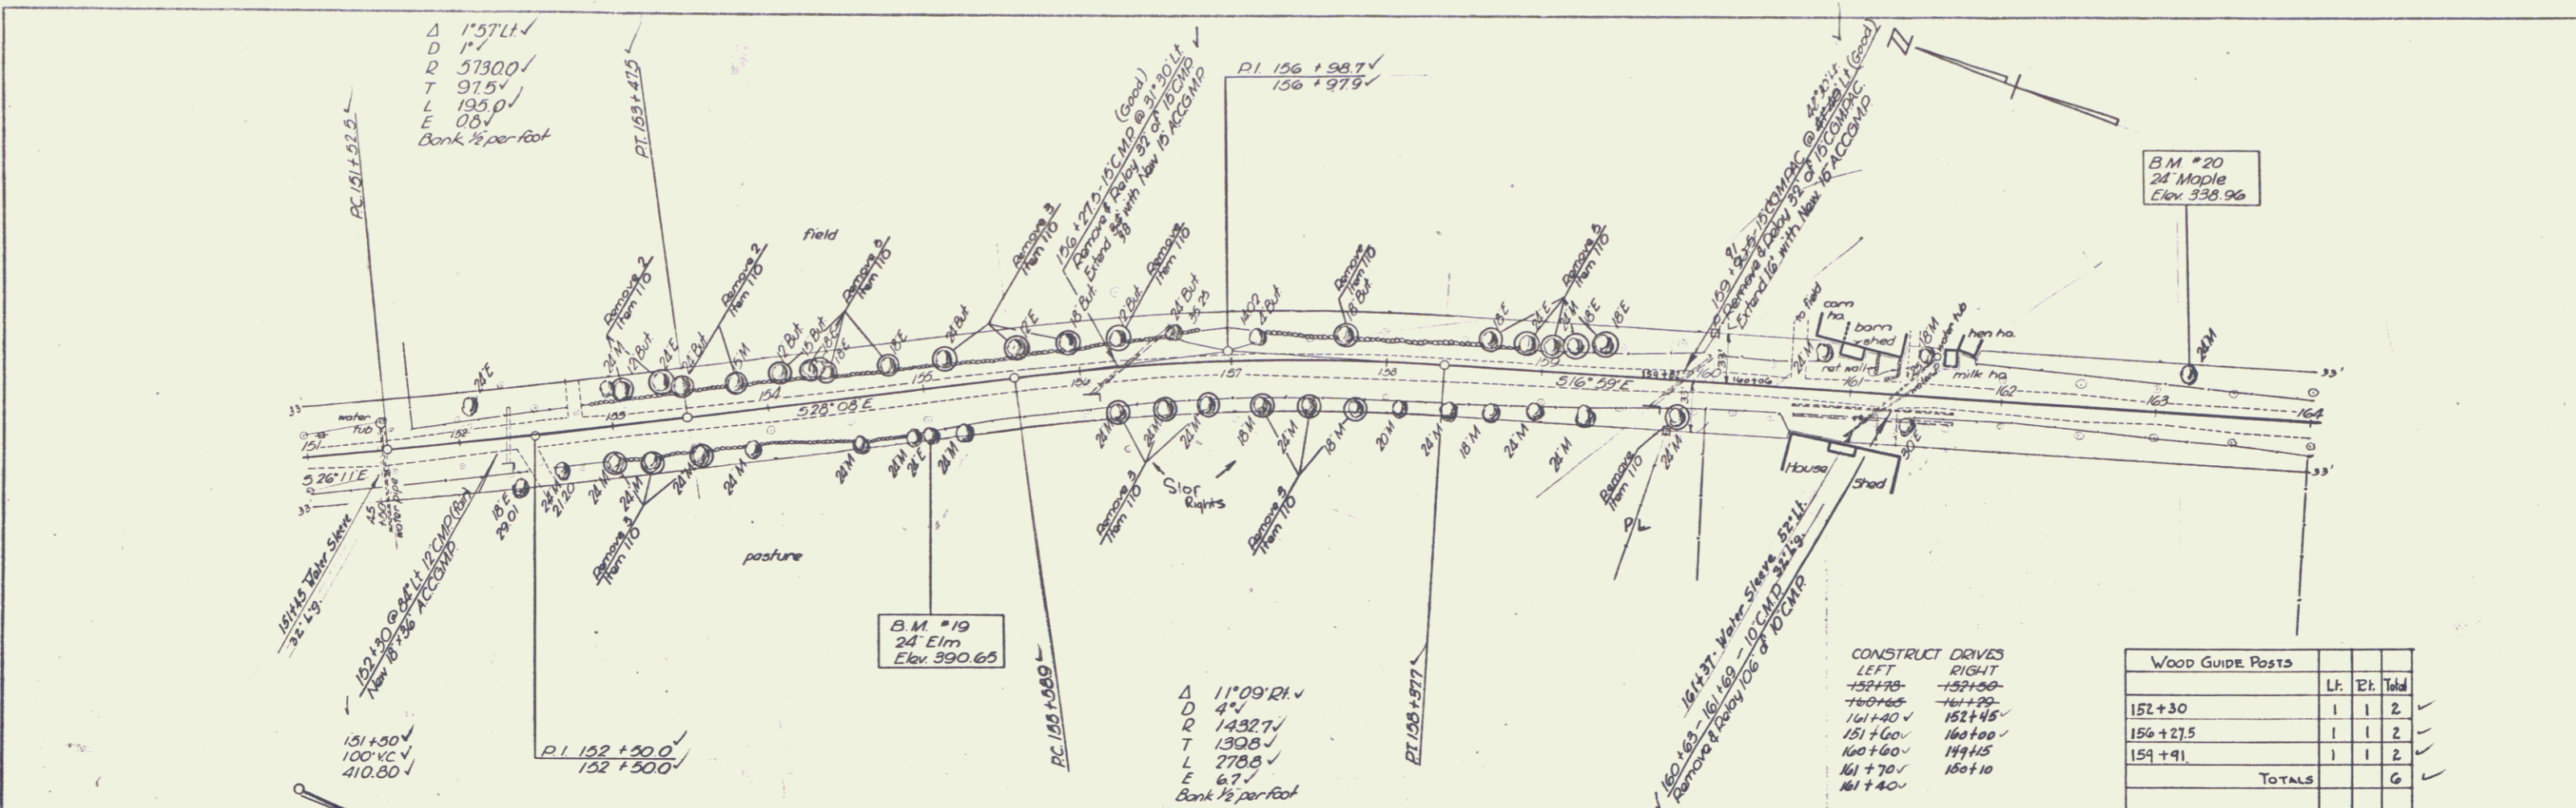

B.M. #19 - S.I.R. 24 Elm 26 ft. right 154+99 Elev. 390.65  
 B.M. #20 - S.I.R. 24 Maple 21 ft. left 163+15 Elev. 338.96

Series S No. 229(1)  
 sheet 23 of 69  
 RANDOLPH