
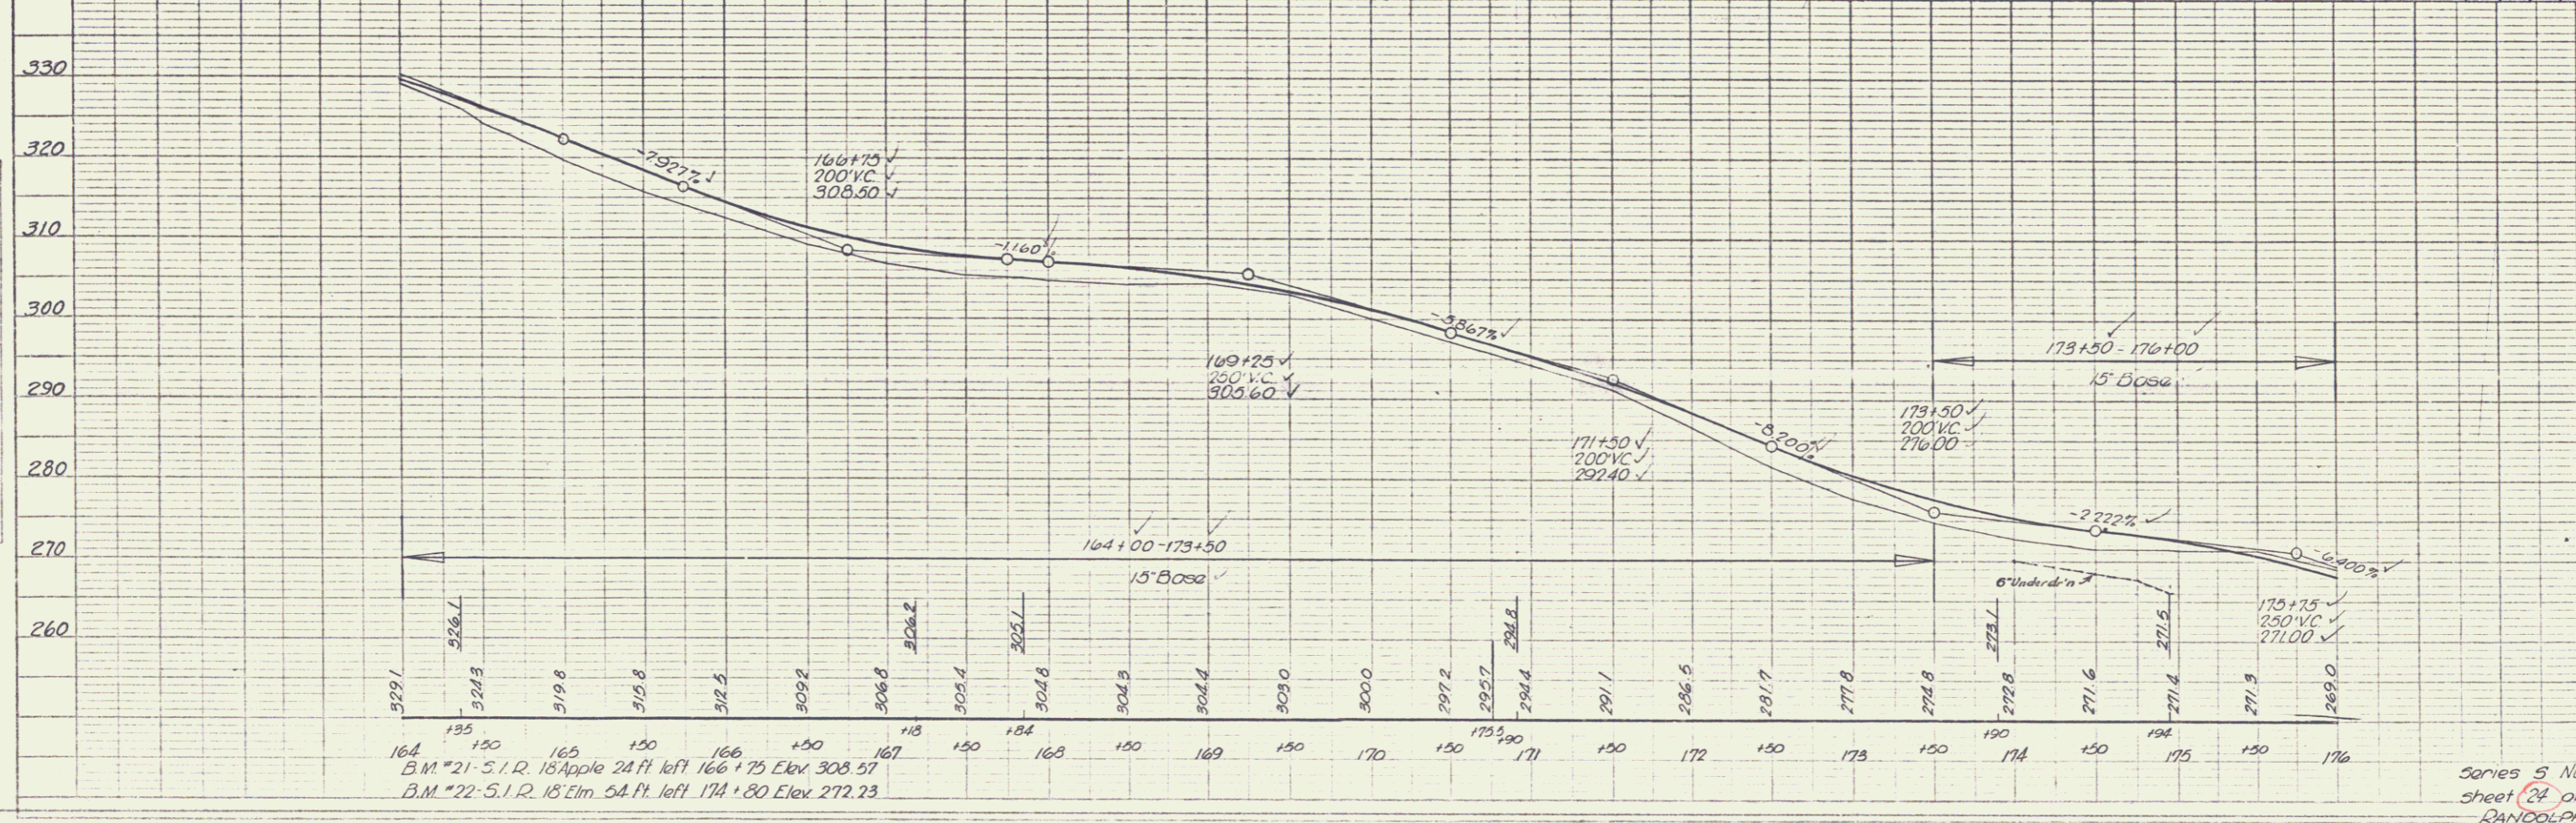


PLAN
 DRAWING NO. 100
 DATE 10/15/50
 PROJECT
 SHEET NO. 24 OF 69

PLAN
 DRAWING NO. 100
 DATE 10/15/50
 PROJECT
 SHEET NO. 24 OF 69

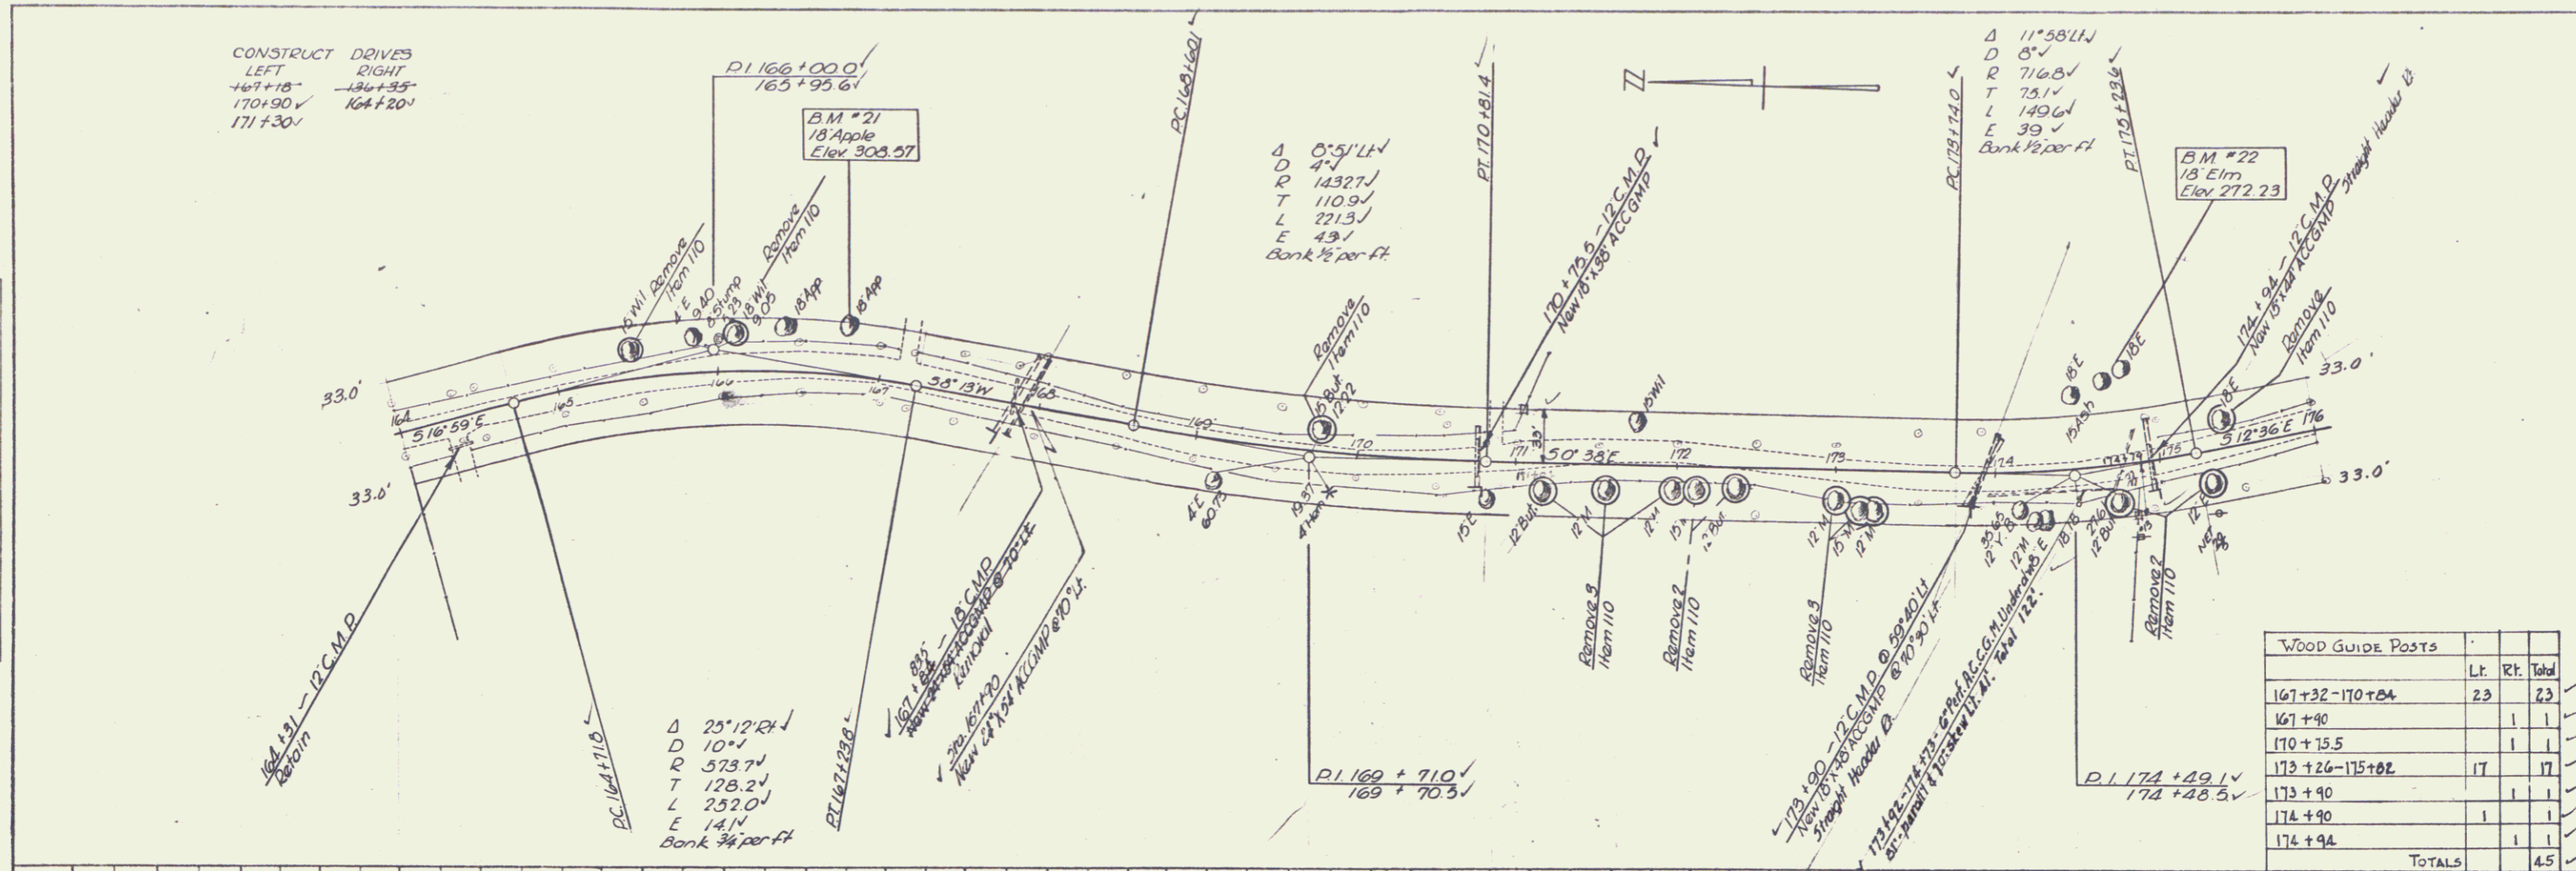

B.M. #21 - S.I.R. 18 Apple 24 ft left 166+75 Elev. 308.57
 B.M. #22 - S.I.R. 18 Elm 54 ft left 174+80 Elev. 272.23

Series 5 No. 229(1)
 sheet 24 of 69
 RANDOLPH