



PLAN
 PORTED
 ALIGNMENT CHECKED
 NOTE BOOK
 BY: [Signature]

DATE
 BY
 CHECKED
 DATE

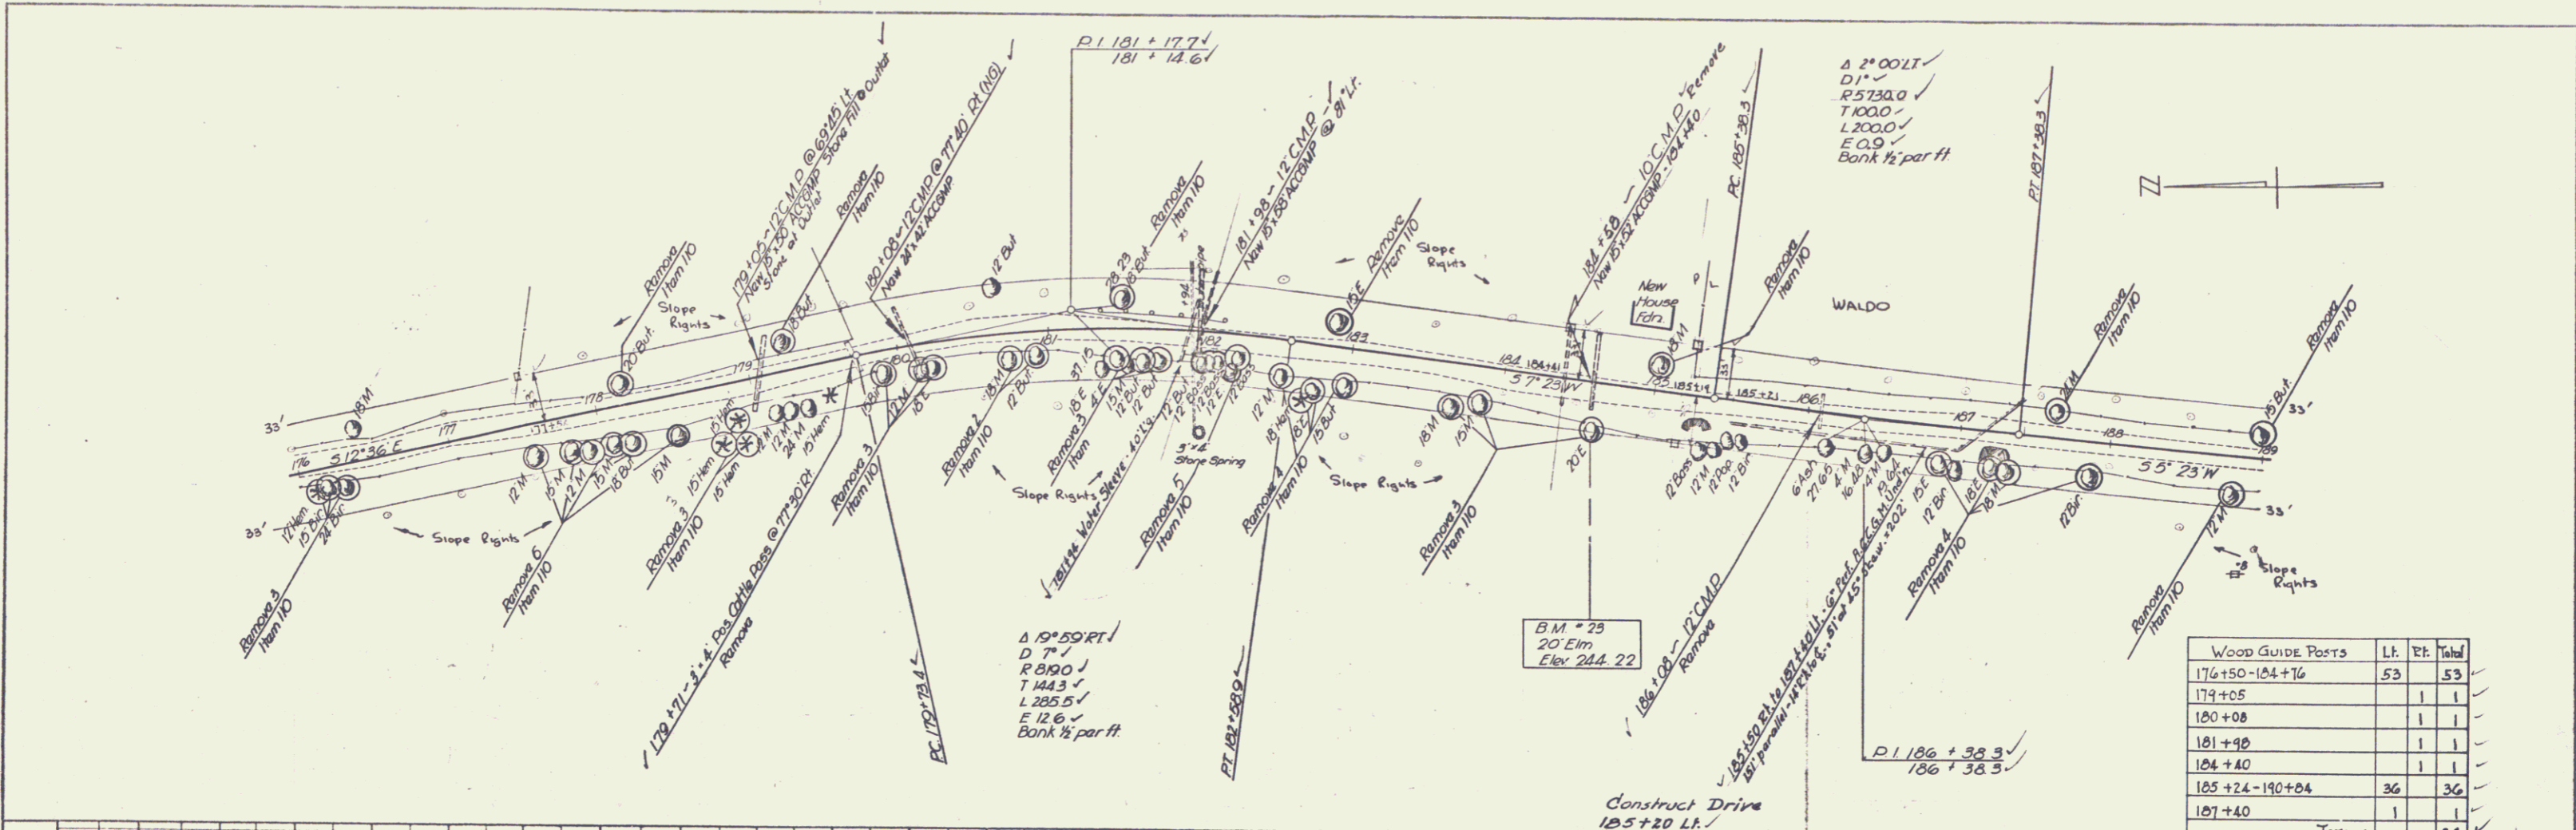

Wood Guide Posts	Lt.	Rt.	Total
176+50-184+16	53		53
179+05		1	1
180+08		1	1
181+98		1	1
184+40		1	1
185+24-190+04	36		36
187+40		1	1
TOTALS			94

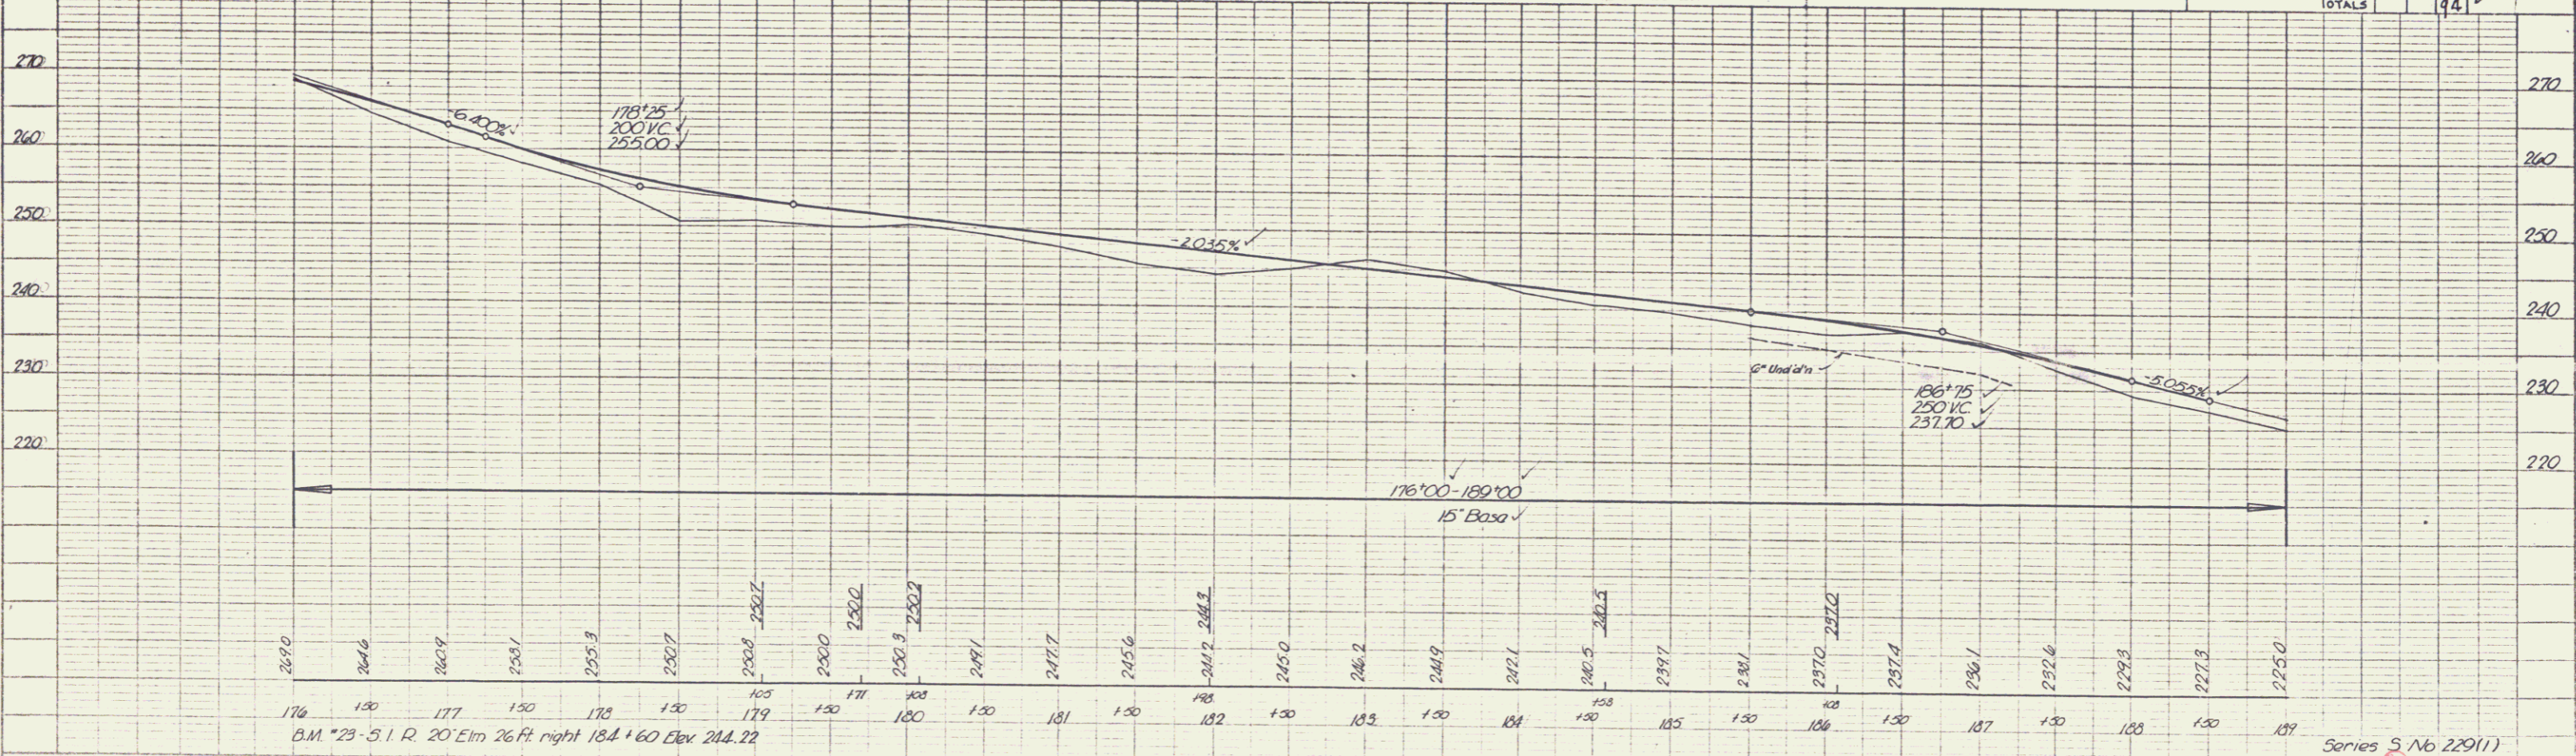

Series S No 229(1)
 sheet 25 of 69
 RANDOLPH