



PLAN
 DATE: 10/21/19
 DRAWN BY: [Signature]
 CHECKED BY: [Signature]

DATE: 10/21/19
 PROJECT: [Signature]
 SCALE: AS SHOWN
 REVISIONS: [Signature]

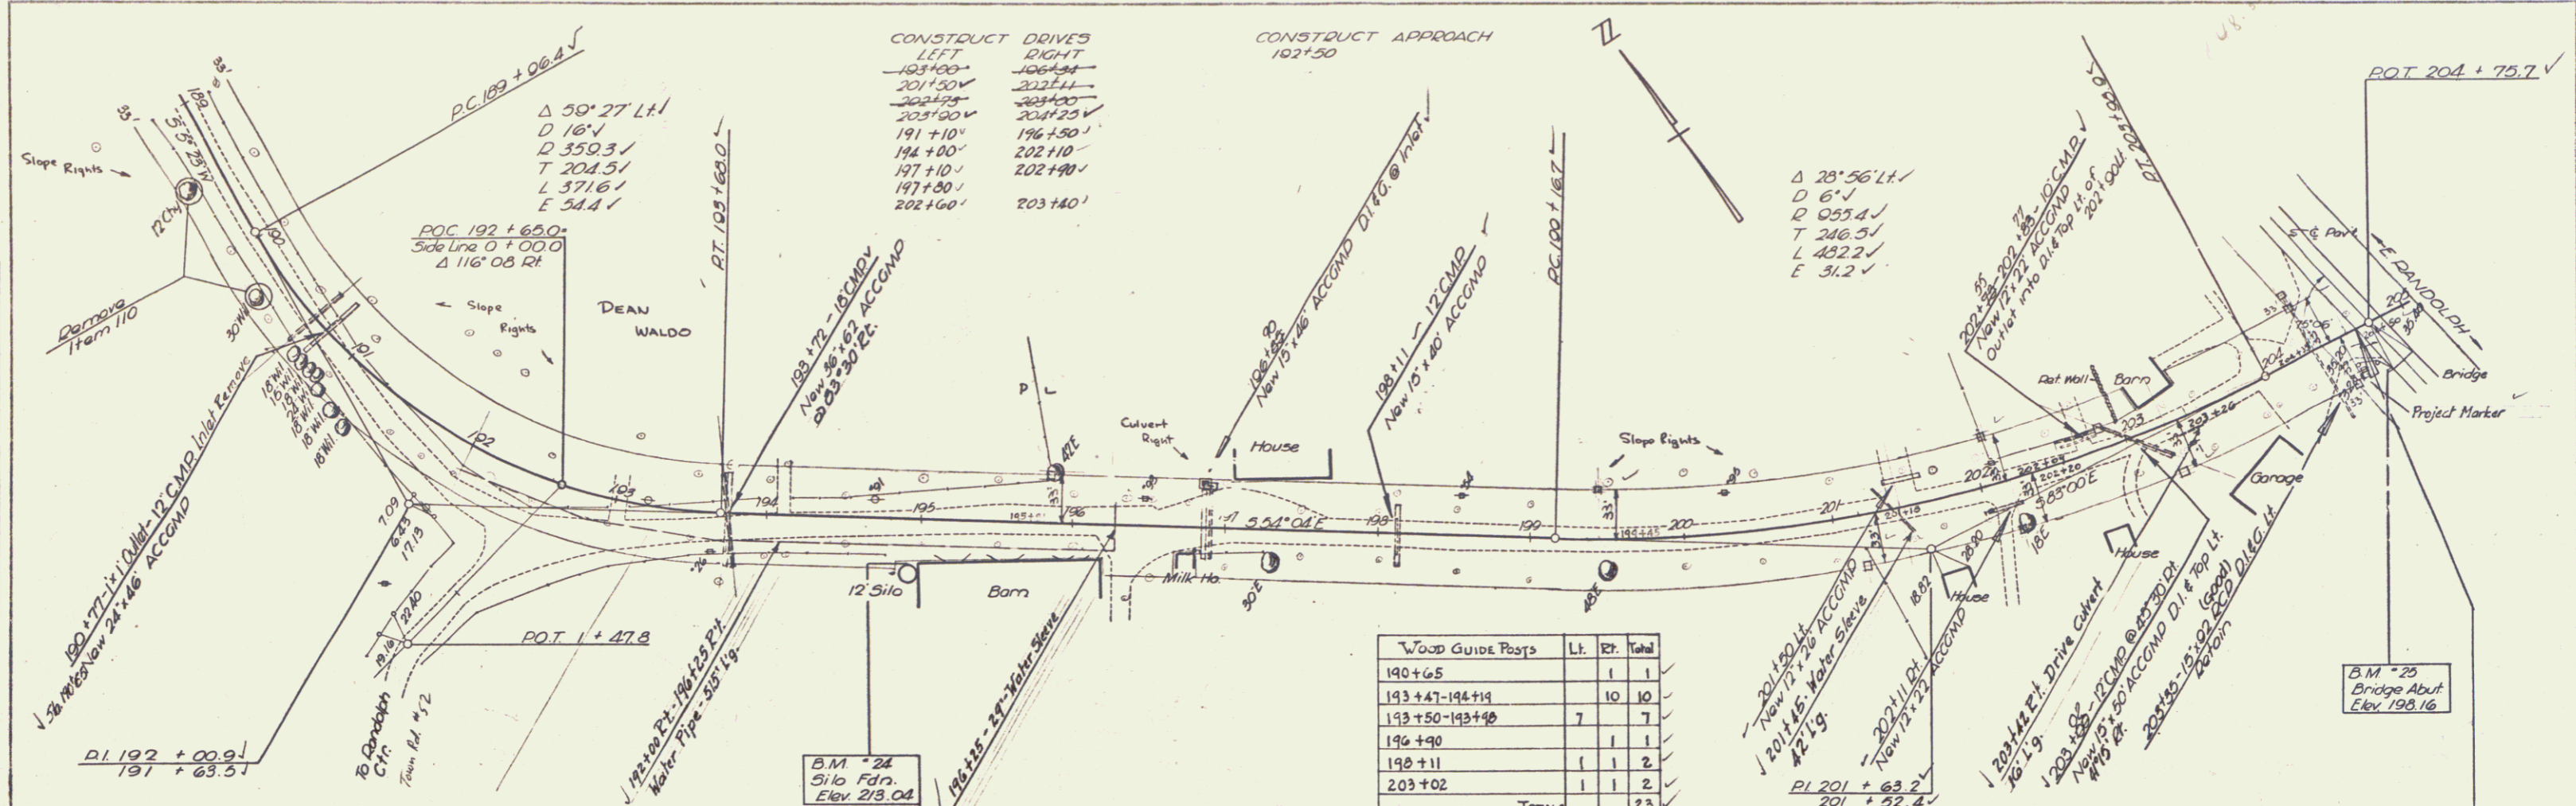

WOOD GUIDE POSTS	LT.	RT.	TOTAL
190+65	1	1	
193+41-194+11	10	10	
193+50-193+98	7	7	
196+90	1	1	
198+11	1	2	
203+02	1	2	
TOTALS	23	23	

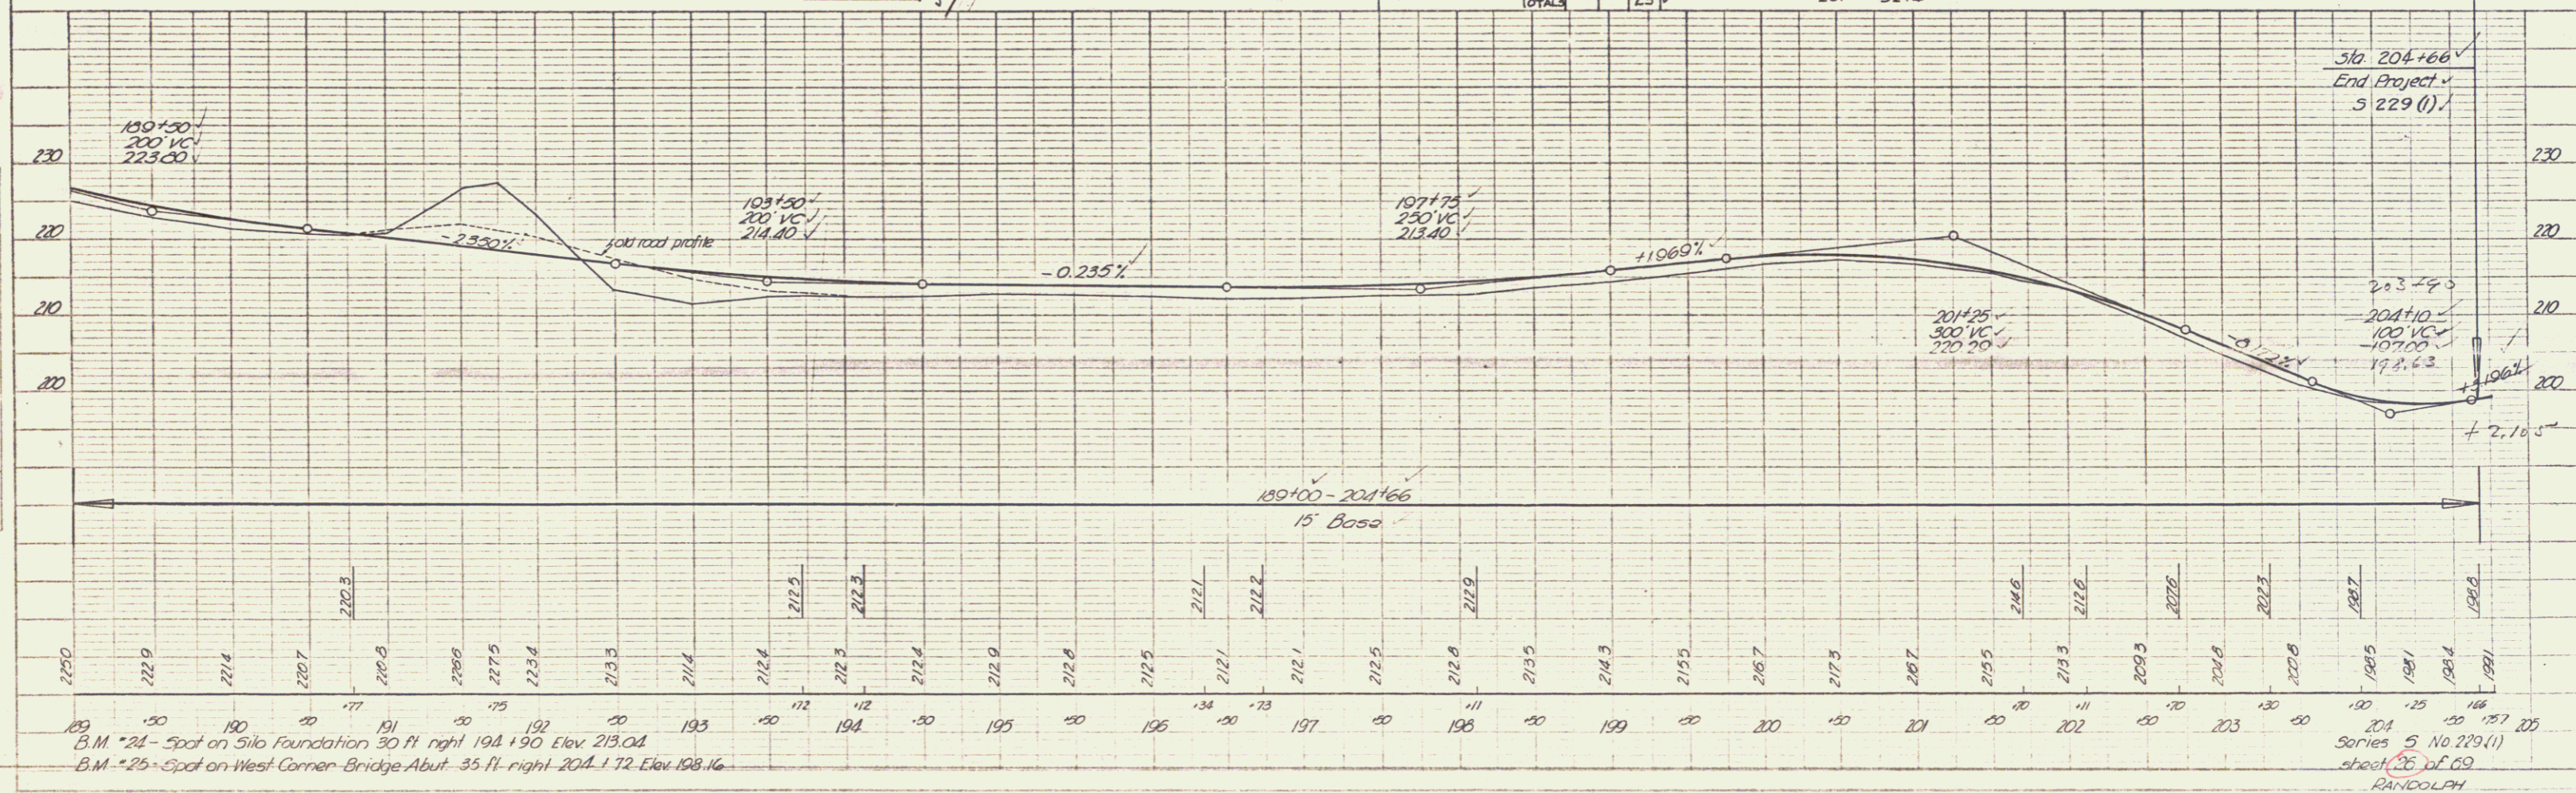

B.M. #24 - Spot on Silo Foundation 30 ft right 194.190 Elev. 213.04
 B.M. #25 - Spot on West Corner Bridge Abut. 35 ft right 204.172 Elev. 198.16

Series 5 No. 229(1)
 sheet 26 of 69
 RANDOLPH