

Parcel Instrument Date Grantor Grantee Recorded Remarks
 A Q.C.D. 1-20-39 Smith & Exelia Harris Shop Mt. Shaftsbury
 Book PAGE DATE
 33 238 1-24-39 col. 1182

BRIDGE DATA

	PRESENT	PROPOSED
TYPE	I-BM-Wood Floor	T-BEAM
SPANS	1 @ 17' CLEAR	1 @ 43' O.O.
CLEAR HEIGHT	4'-0"	5'-3"
WATER WAY	68'	104'
LENGTH OVERALL	21'	43'
ROADWAY WIDTH	16.5'	24' 4" S.W.

LIST OF SHEETS

SHEET No.	Description
1	PLAN & PROFILE
2	ABUTMENT DETAILS
3	SUPERSTRUCTURE DETAILS
4	S.B. 7A STANDARD BALUSTRADE RAIL
5	S.B. No 11 BARRICADES & LIGHTS
6	S.B. No 20 USE DETAILS B, J, L, & GEN. NOTES
7	S 30 - CABLE GUARD RAIL
8-10	CROSS SECTIONS


ITEM NO. QUANTITIES

10 ^e 11	COMMON EXCAV. INCL. BORROW	680
15	CHANNEL EXCAV.	1100
16	STRUCTURE EXCAV.	175
18	MAINTENANCE OF TRAFFIC	1
19C	SUB-BASE OF GRAVEL	460
22	GRAVEL SURFACE COURSE	200
41A	CONCRETE CLASS 'A'	11.9
42	REINFORCING STEEL	27125
56	TEMPORARY BRIDGES	1
57	REMOVAL OF PRESENT SUPERSTRUC.	1
93	BALUSTRADE RAIL	88
69A	HEAVY STONE FILL	440
80A	CABLE GUARD RAIL	392
80B	ANCHORS FOR CABLE GUARD RAIL	2

210

ROADWAY DATA

YEAR	CONTRACTOR	LOCATION	FOR	BY
1939				

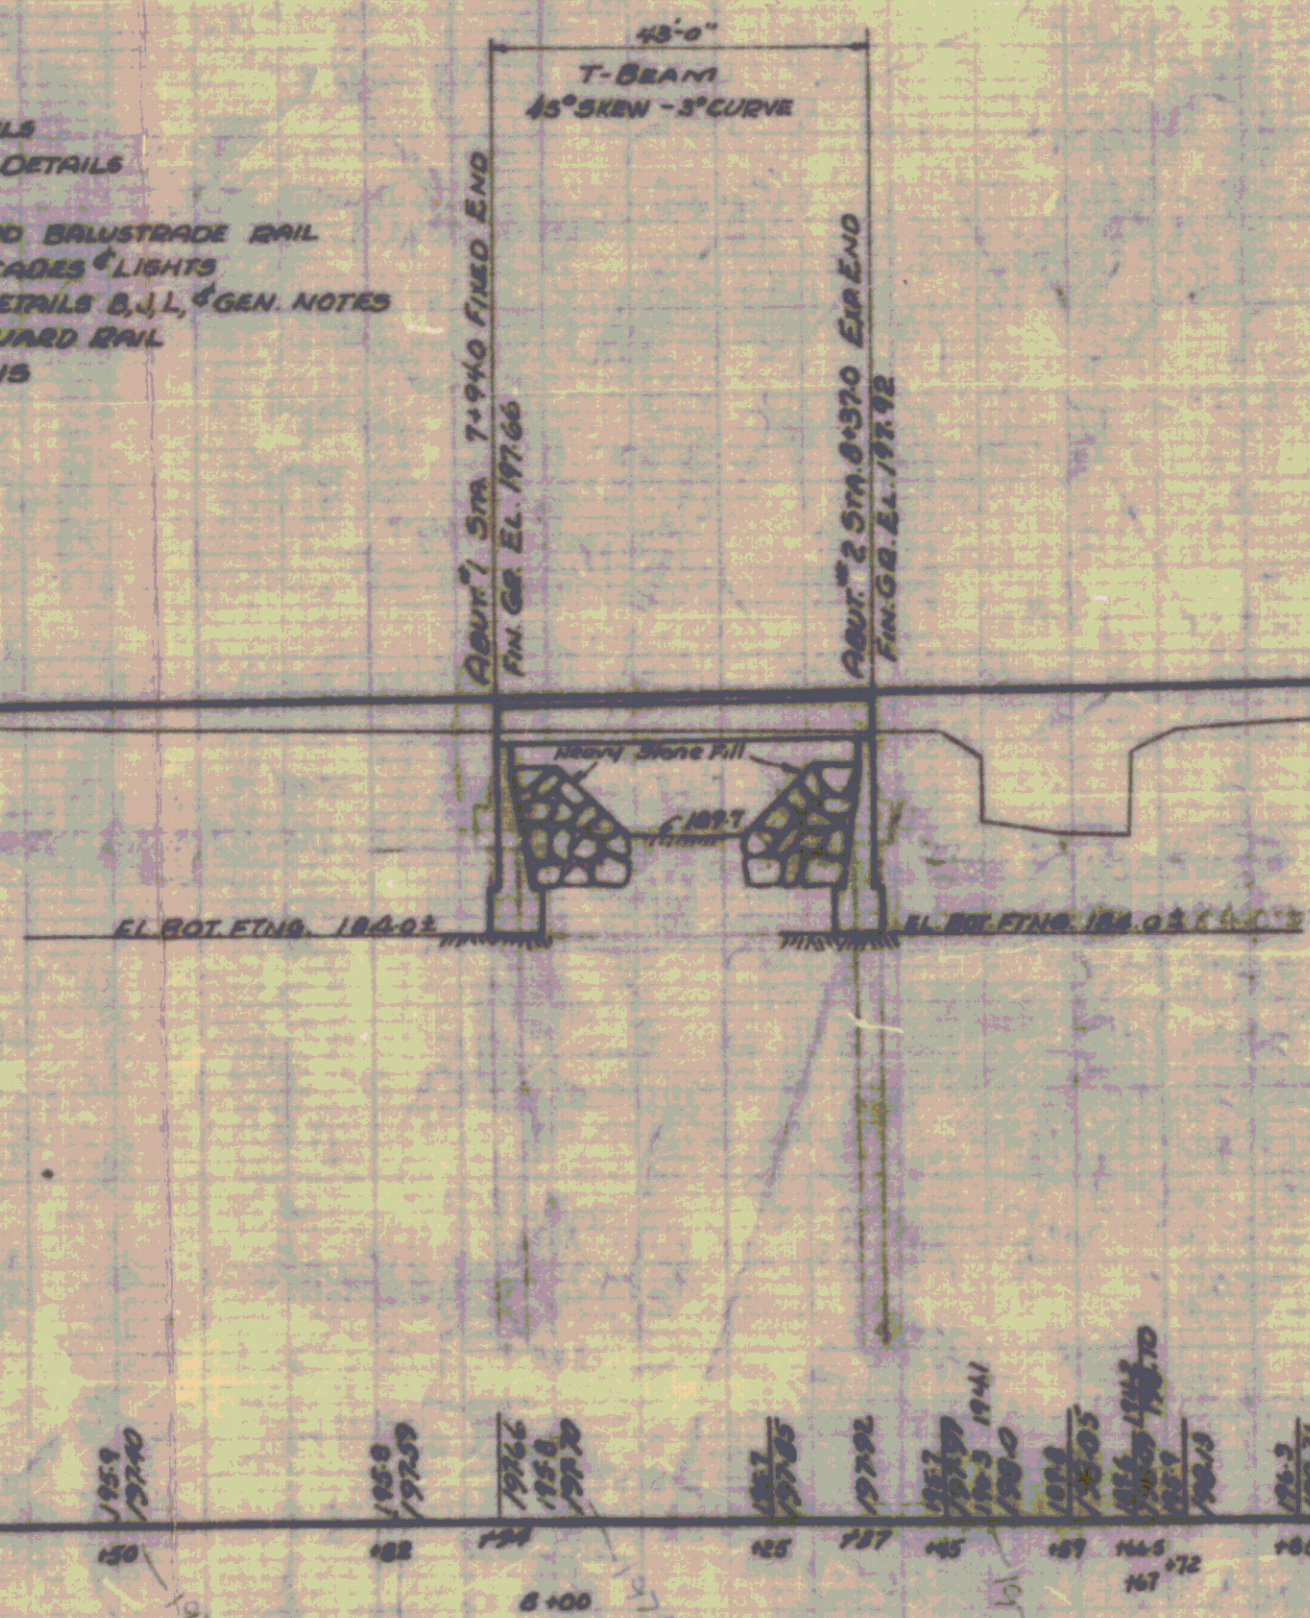

RECOMMENDED
 DISTRICT ENGR.
 RECOMMENDED FOR APPROVAL
 CHIEF ENGR.
 APPROVED
 DIRECTOR

STATION	DATE	REVISIONS
7+00	1963	
7+00	1964	
7+00	1965	
7+00	1966	
7+00	1967	
7+00	1968	
7+00	1969	
7+00	1970	
7+00	1971	
7+00	1972	
7+00	1973	
7+00	1974	
7+00	1975	
7+00	1976	
7+00	1977	
7+00	1978	
7+00	1979	
7+00	1980	
7+00	1981	
7+00	1982	
7+00	1983	
7+00	1984	
7+00	1985	
7+00	1986	
7+00	1987	
7+00	1988	
7+00	1989	
7+00	1990	