

CONSTRUCT APPROACHES
 11+55 L⁺ 12+30 R⁺
 CONSTRUCT DRIVES
 12+50 L⁺
 CHANGING ELEVATIONS OF
 CATCH BASINS OR MANHOLES
 12+50 L⁺


PARCEL 2 STA 1187-12400
 GRANTOR LEONARD W. & LILA D. MORIN
 TAKING 312 SQ. FT.
 SLOPE-11783-11+89 695 sq ft
 TITLE TAKEN
 RECORDED BK. 0-166 Pg. 142 DATE 10/22/63

PARCEL 3 STA 1198-12140
 GRANTOR REBECCA S. GRIFPIN
 TAKING 655 SQ. FT.
 TITLE TAKEN
 RECORDED BK. 0-166 Pg. 10 DATE 9/3/63

PARCEL 1 STA 1182-12125
 GRANTOR HAYNES REALTY CORPORATION
 TAKING 990 SQ. FT.
 RIGHTS
 TITLE TAKEN 0-165
 RECORDED BK. Pg. 9 DATE 9/13/63

PLAN
 DESIGNED BY WATSON TRAPP
 CHECKED BY
 DATE 4/62

PROFILE
 DESIGNED BY WATSON TRAPP
 CHECKED BY
 DATE 4/62

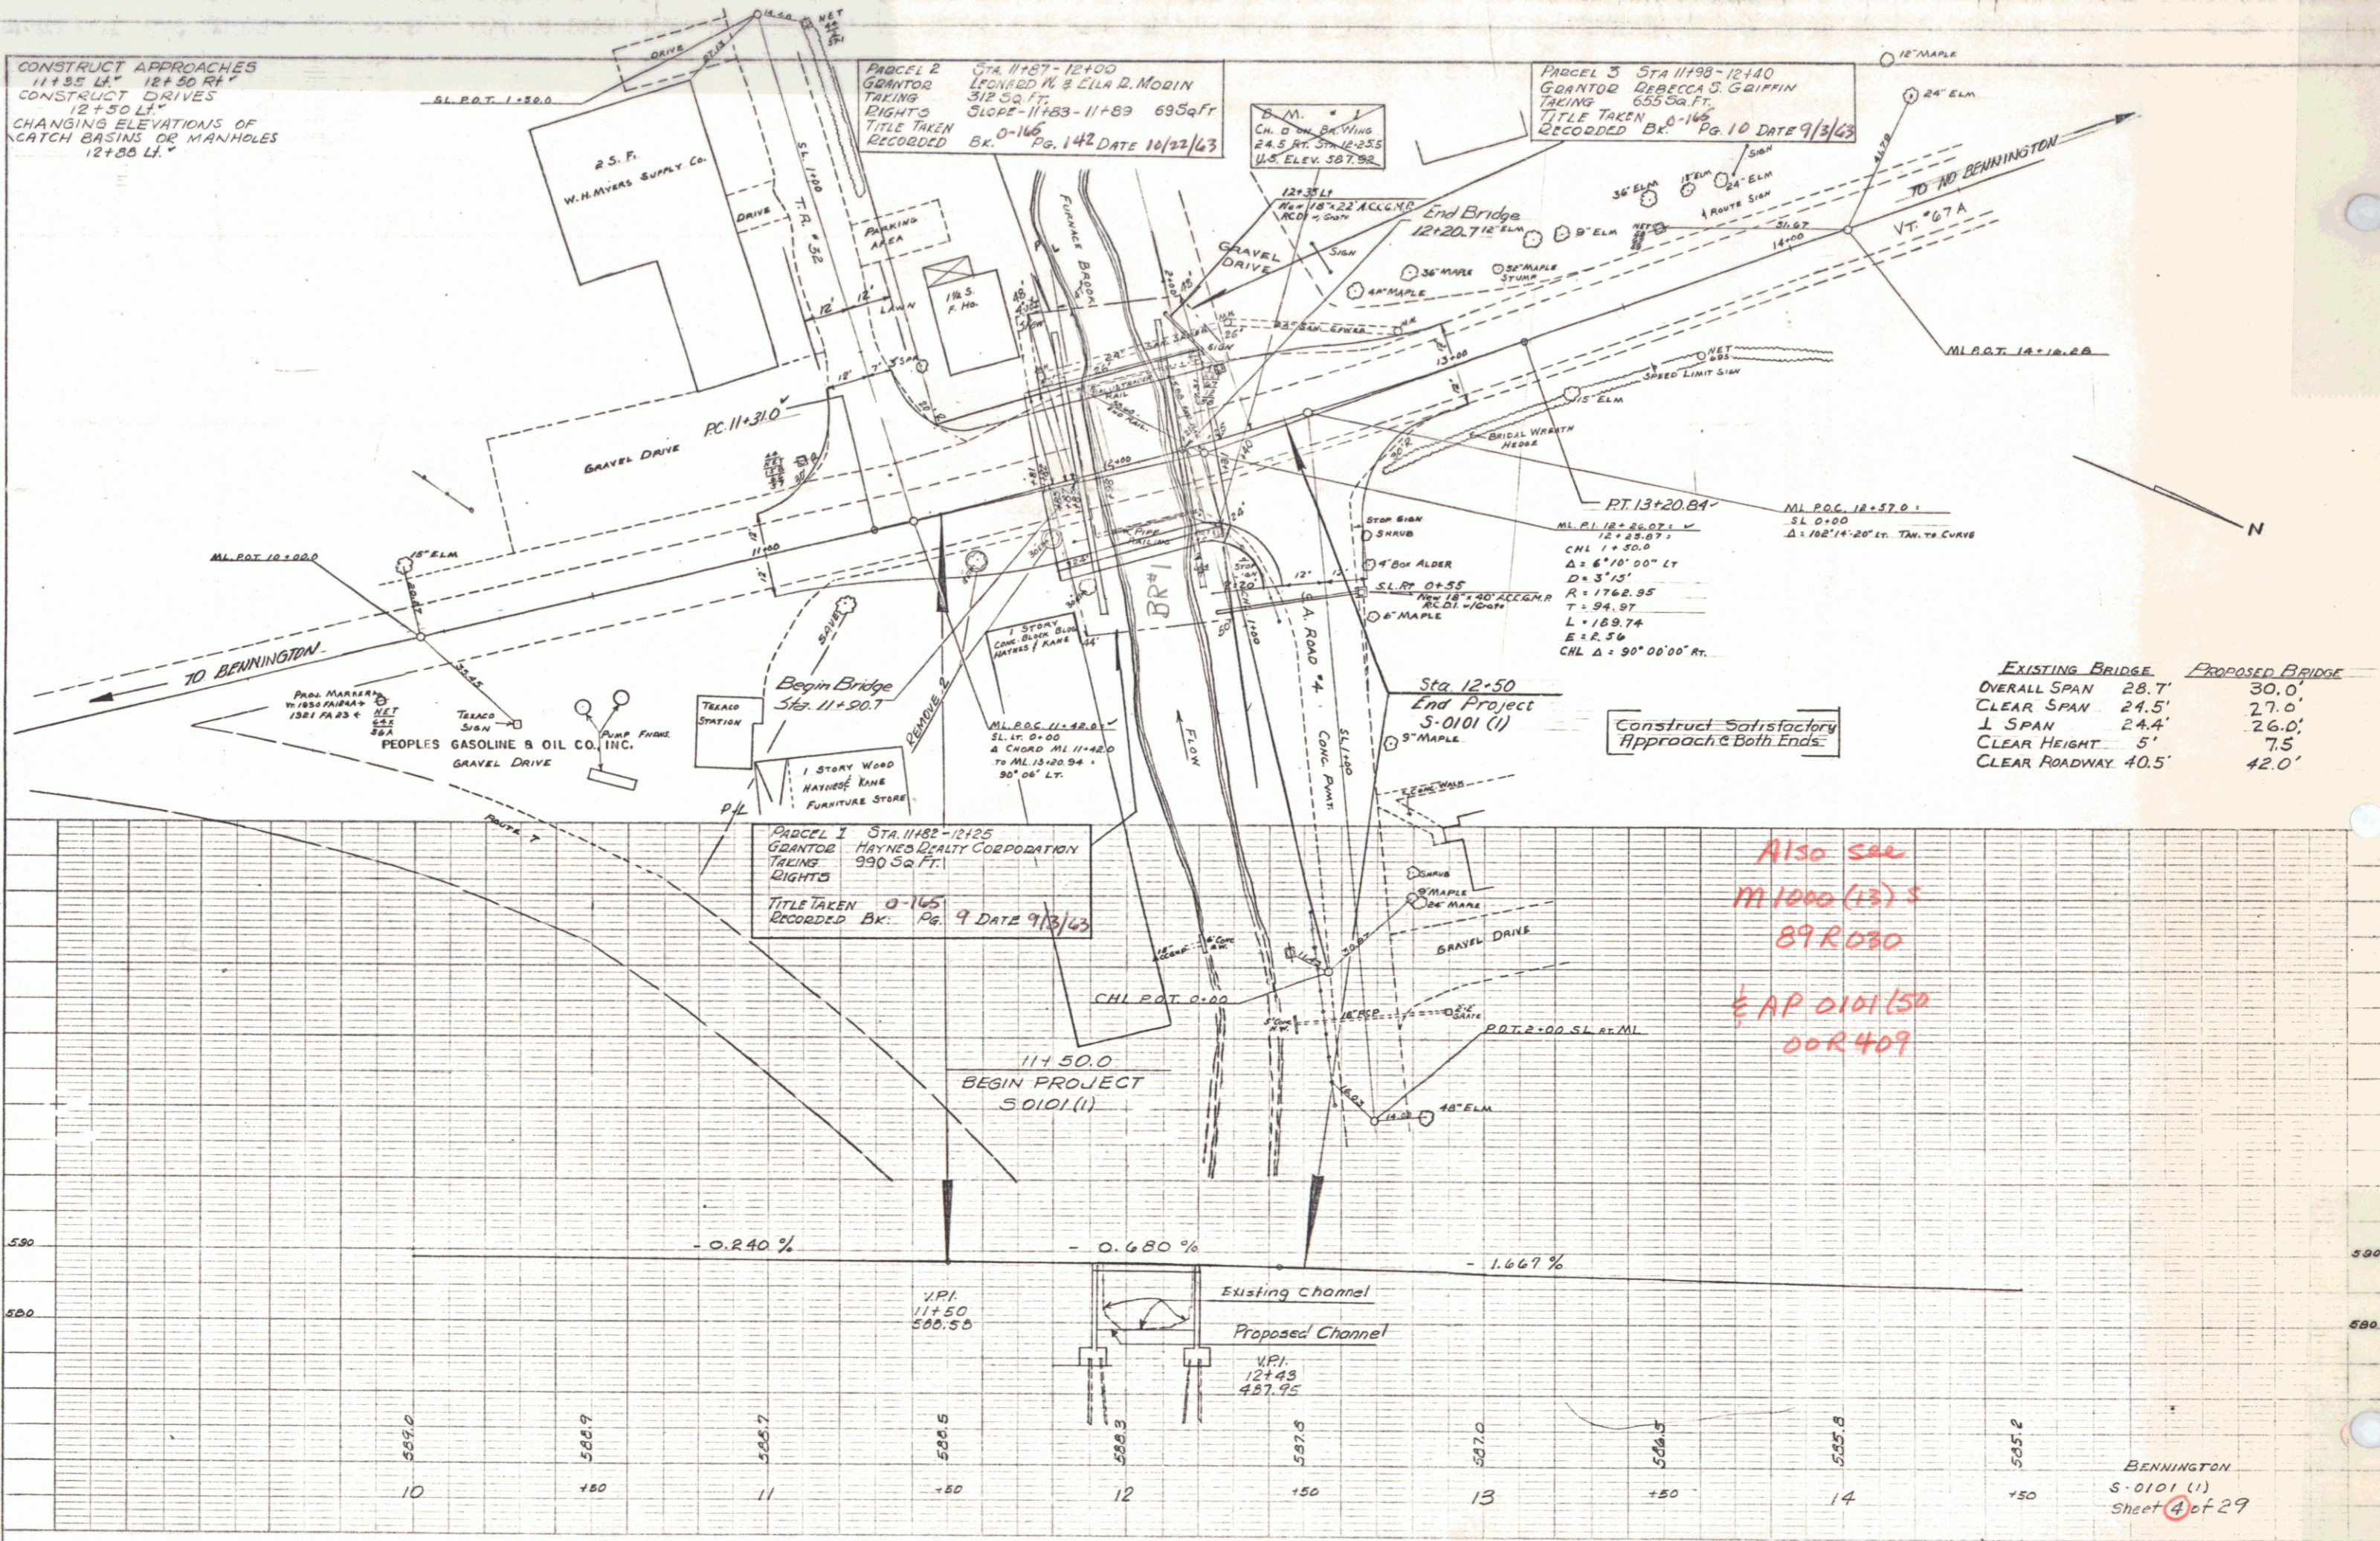

BENNINGTON
 S-0101 (1)
 Sheet 4 of 29