
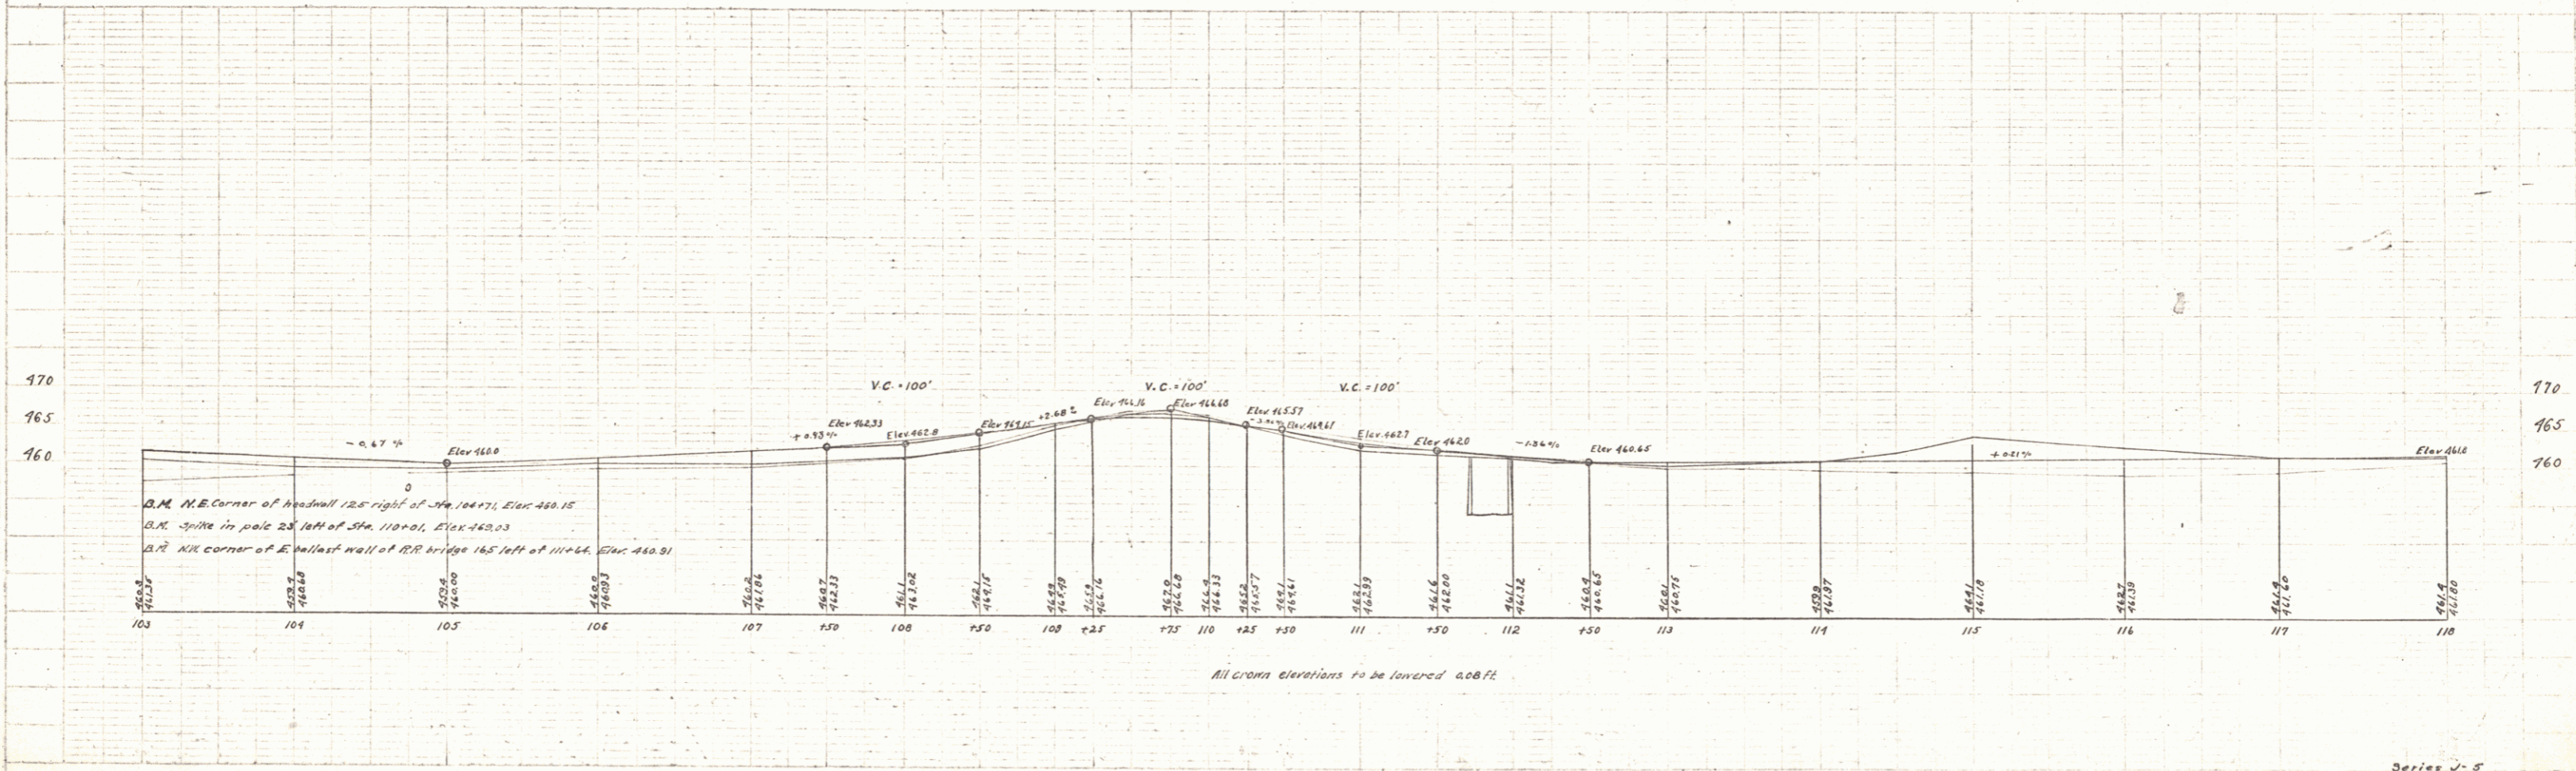


J.L. Davis
 C.E. Day and J.L.Z.
 J.L.Z.

C.W. Barger
 R.W. White
 J.L. Davis

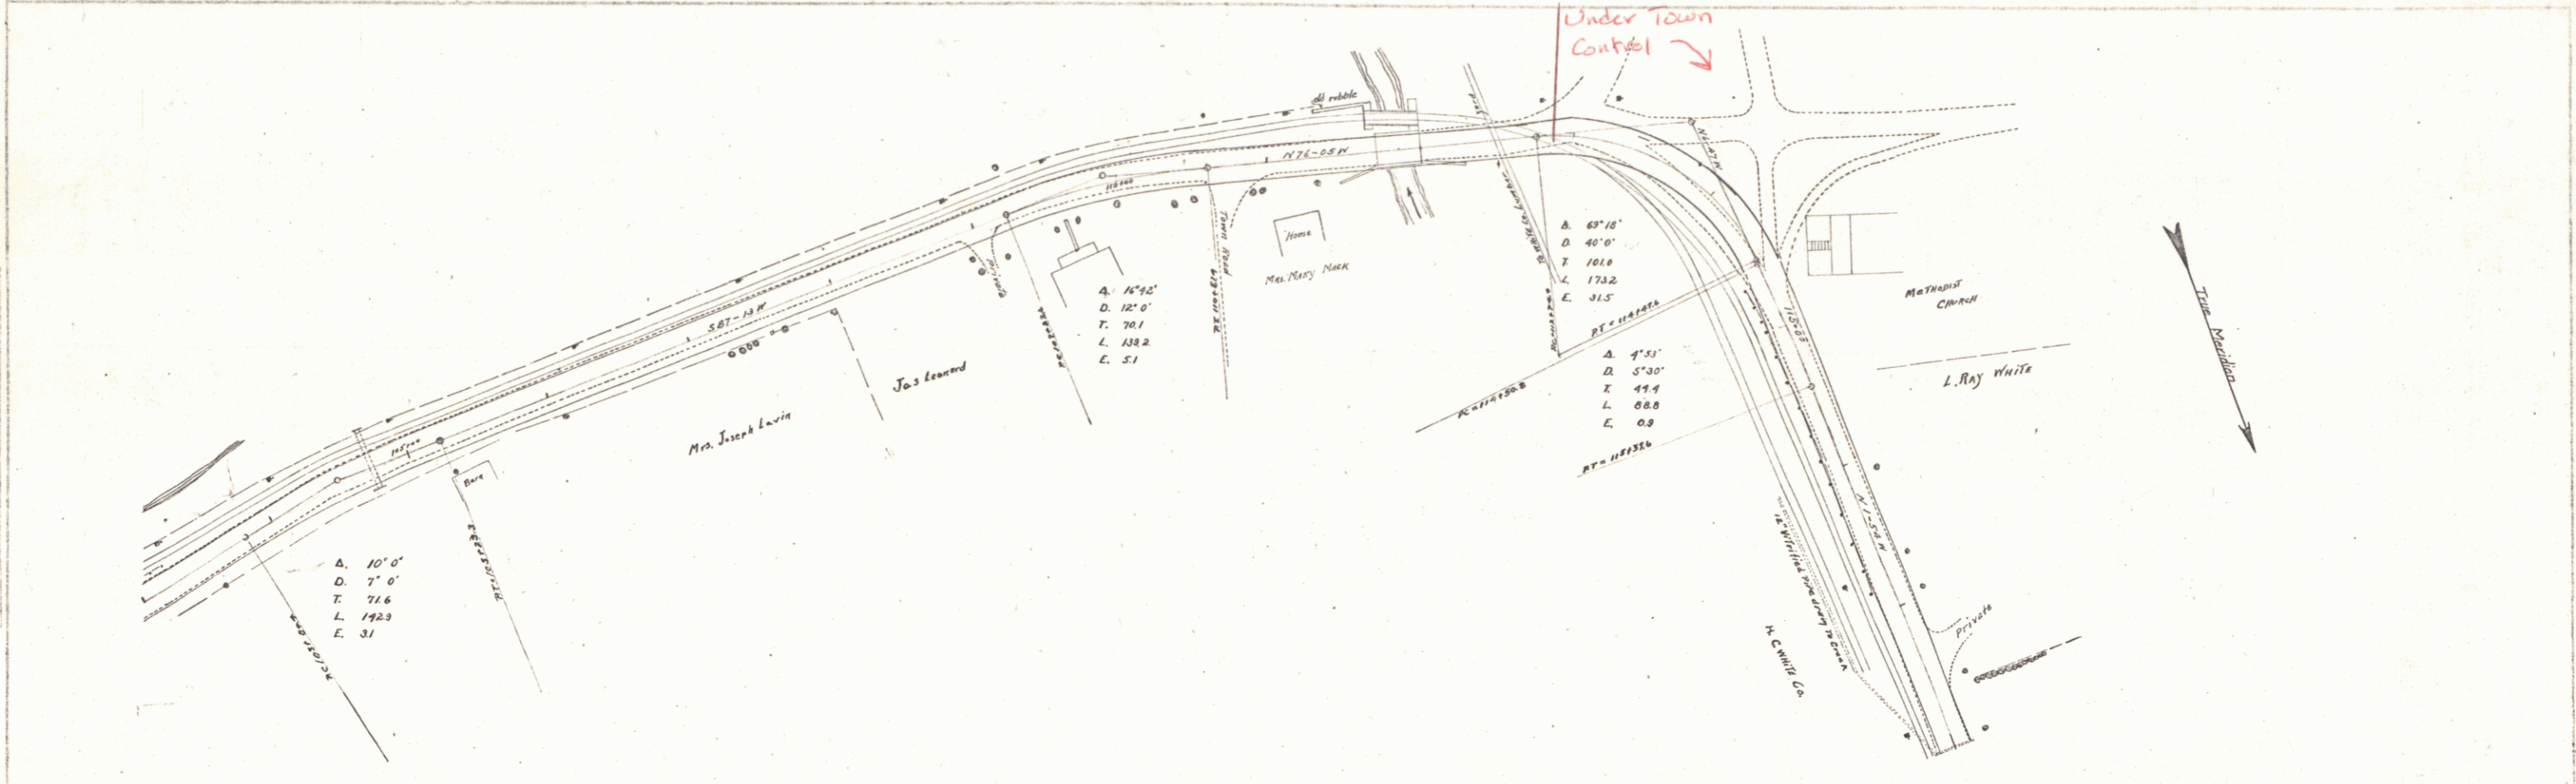

Series U-5
 Sheet 9 of 20 MSB