

**INDEX TO SHEETS**


SHEET NO.	TITLE PAGE AND TYPICAL SECTIONS
2	PLAN AND PROFILE STA. 0+00 TO STA. 16+00
3	16+00 - 31+00
4	31+00 - 45+00
5	45+00 - 60+00
6	60+00 - 74+00
7	74+00 - 89+00
8	89+00 - 103+00
9	103+00 - 118+00
10	118+00 - 132+00
11-24	CROSS SECTIONS
25	BRIDGE
26	111+02.5

**TOWN OF BENNINGTON**

**PLAN AND PROFILE OF PROPOSED IMPROVEMENT  
STATE HIGHWAY NO. 2  
FROM PERCEY'S CORNER TO NORTH BENNINGTON VILLAGE**

Route: **VT 67A**  
Project: **MsB15**  
Plan: **002408**  
Date: **02/08/1921**

Scales: Plan - 1" = 500'  
Profile - Hor. 1" = 500', Vert. 1" = 10'  
Cross Sections 10" = 50'

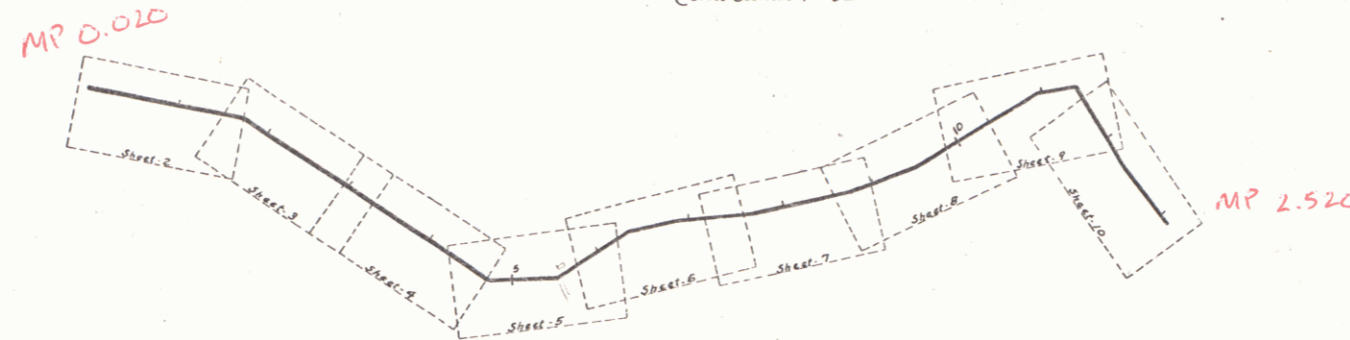

**SUMMARY OF QUANTITIES**



EARTH EXCAVATION	4077	CU YDS.
BORROW	735	"
CEMENT CONCRETE PAVEMENT REINFORCED	4565	"
1-2-4 CONCRETE (CLASS A)	30	"
1-3-6 CONCRETE (CLASS C)	37	"
X WOODEN GUARD RAIL	1132	LIN. FT.
VERIFIED LEACHING BASINS		
X CRUSHED STONE OR GRAVEL FOR SHOULDERS	2130	CU YDS.
ROCK EXCAVATION	20	"
CONCRETE AT R.R. CROSSINGS	67	"
REINFORCING STEEL	450	LBS.
X BROKEN STONE OR GRAVEL FOR DRAINS	175	CU YDS.
STANDARD UNDERDRAIN	1010	LIN. FT.
SUB BASE	2346	CU YDS.
RECONSTRUCTED SUB BASE	268	"
SAND OR GRAVEL CUSHION	1800	"
X 1-2-4 CONCRETE (CLASS A) FOR STRUCTURES OVER 4 FT SPAN EXCL. YDS.	146	"
X 1-3-6 CONCRETE (CLASS C)		
X REINFORCING STEEL		9011 LBS.

X = OPTIONAL ITEMS

**LAYOUT**

Scale - 1" = 1000'

**TYPICAL SECTIONS**

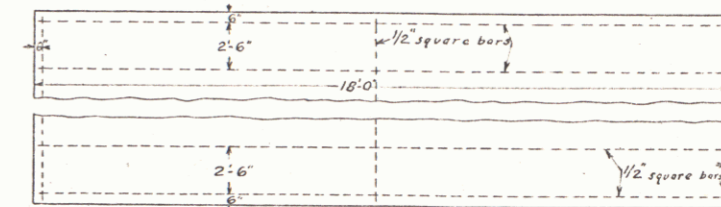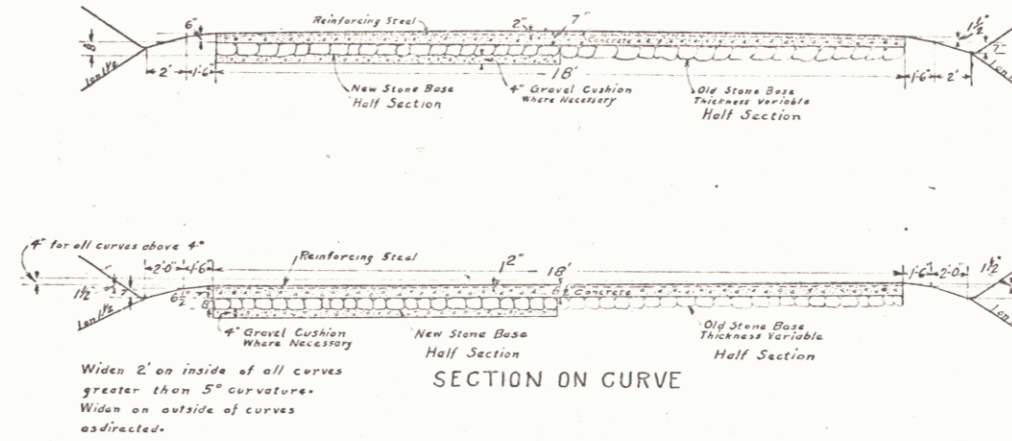

PLAN  
SHOWING BAR REINFORCING  
Scale: Hor. 1" = 25' ft.  
Vert. 1" = 5' ft.

PROJECT: Bennington

NUMBER: Concrete

TYPE: Concrete

CONTRACTOR: \_\_\_\_\_

LOCATION: 0.25 mile south from Percy's corner near road to Bennington Village

YEAR IN USE: \_\_\_\_\_

**SIGNS**

GROUND ELEVATION	Station	Grade
GRADE ELEVATION	Station	Grade
BASE OF RAIL (on profile)		
CURVE DATA		
DEFLECTION ANGLE	Δ	
DEGREE OF CURVE	D	
RADIUS OF CURVE	R	
TANGENT DISTANCE	T	
LENGTH OF CURVE	L	
EXTERNAL DISTANCE	E	
POINT OF INTERSECTION	P.I.	
POINT OF CURVE	P.C.	
POINT OF TANGENT	P.T.	

*H. M. McIntosh*  
STATE ENGINEER

2/8/21



RIGHT-OF-WAY DIVISION  
TOWN FILE  
PERPETUAL

ptc  
Town of VT 67A  
(To Be Returned To R.O.W. Division)

Series 15  
Sheet 1 of 26 MsB-15

PLAN  
 J. L. Pears  
 G. A. Peck  
 J. L. Peck


PROFILE  
 J. L. Pears  
 G. A. Peck  
 J. L. Peck

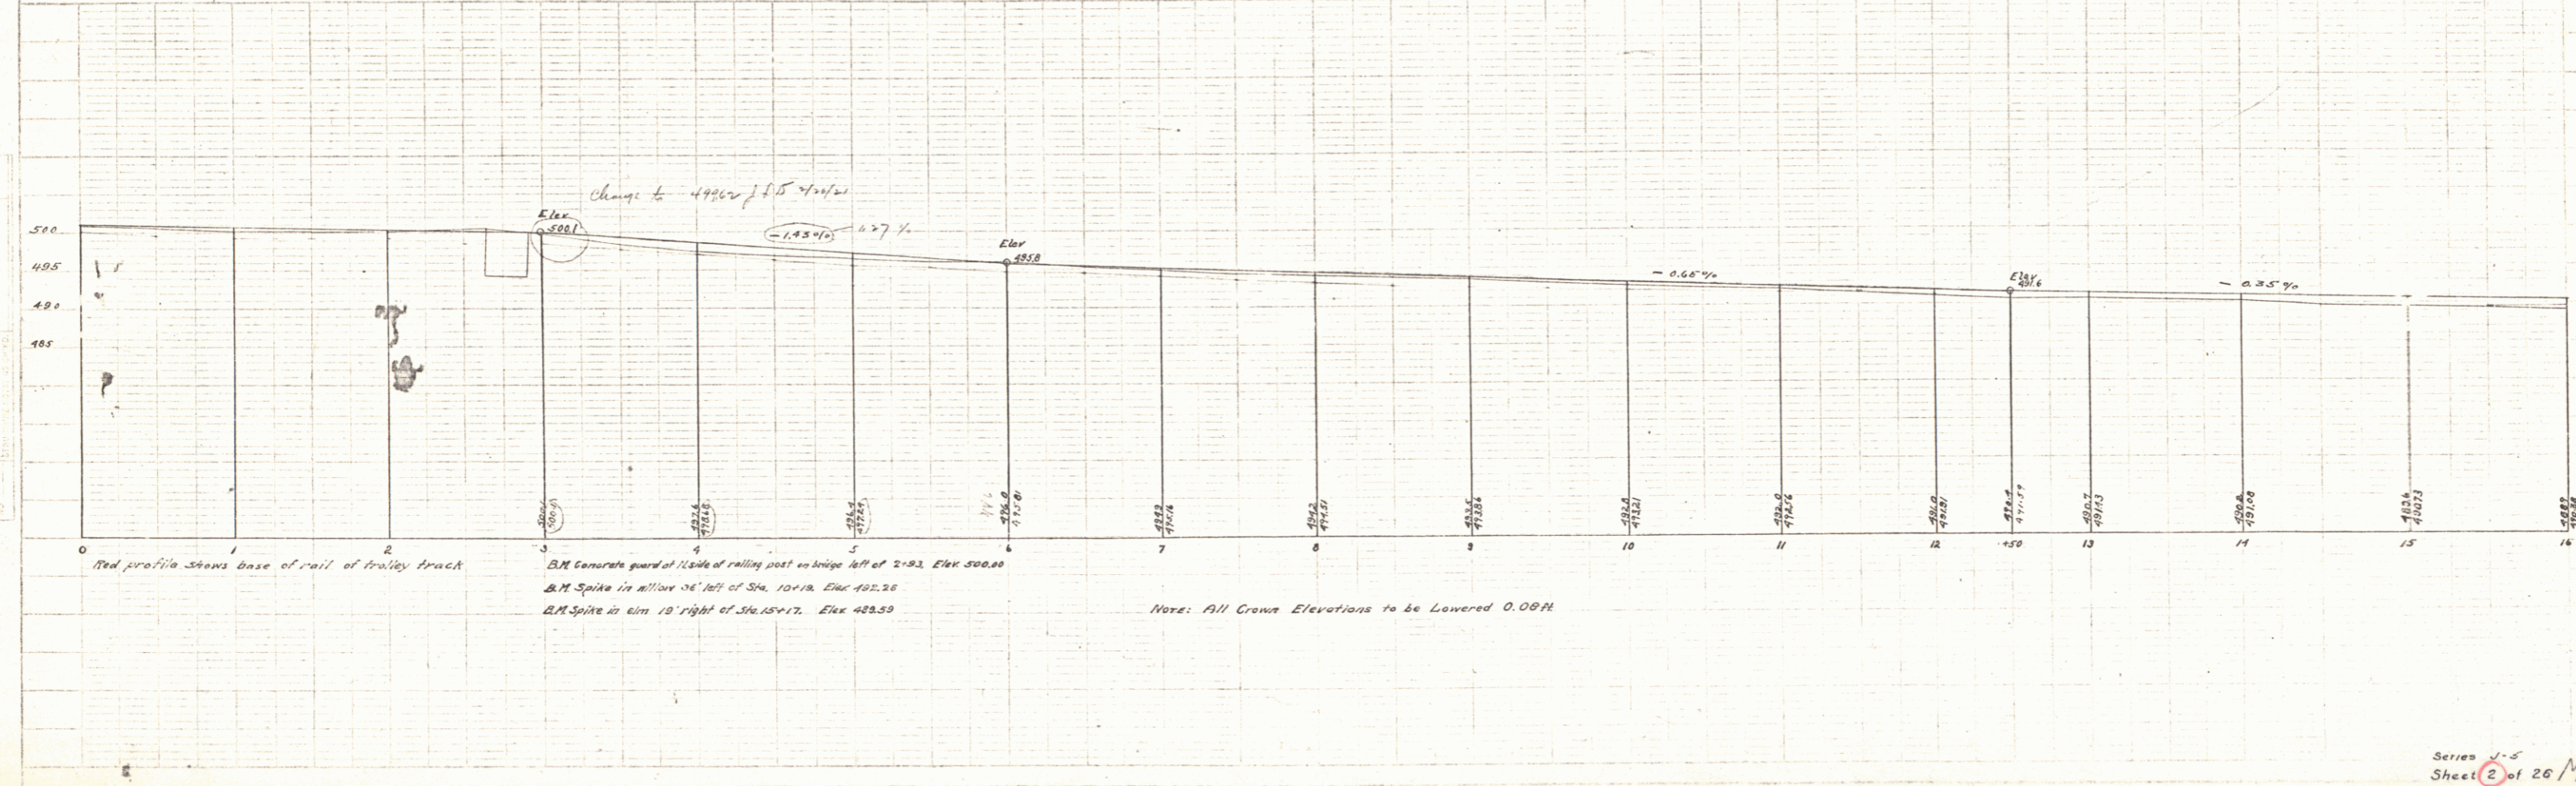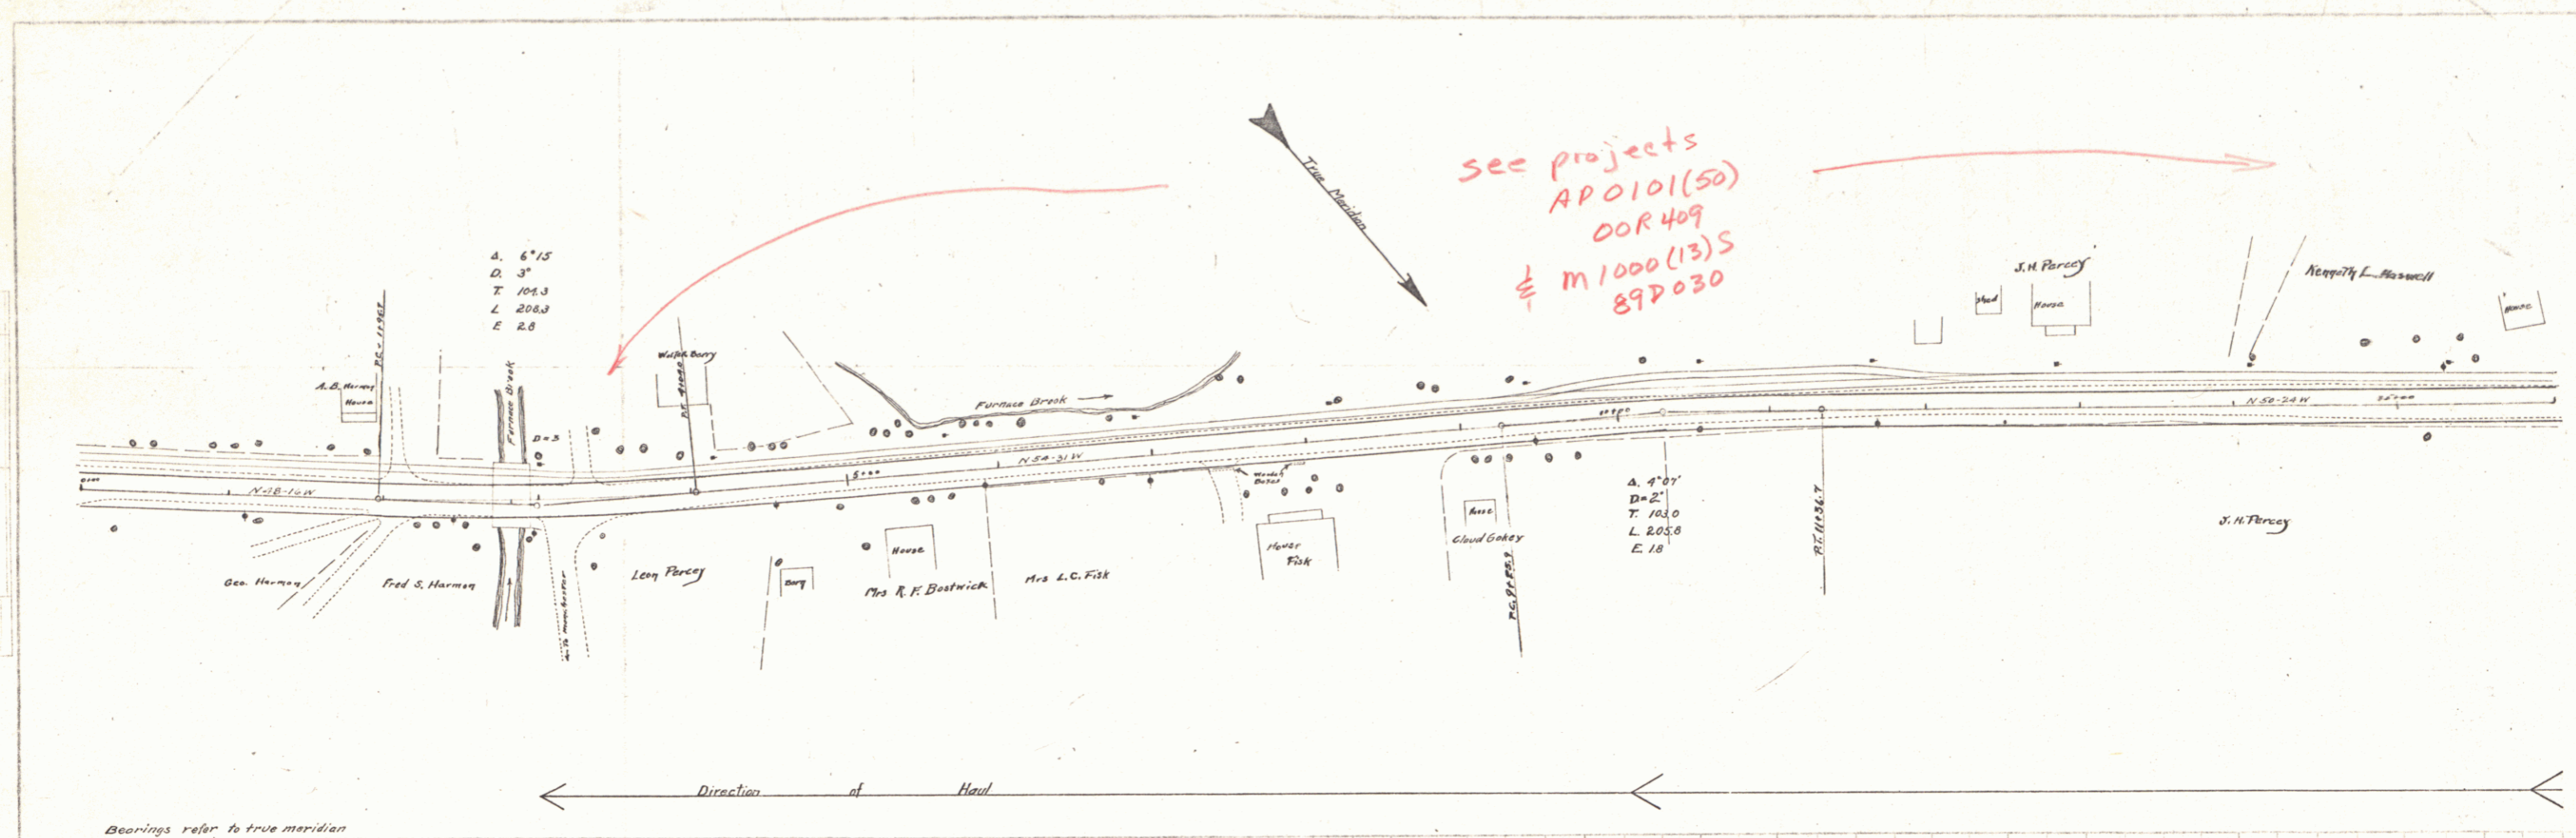

Series U-5  
 Sheet 2 of 20 M<sub>5</sub>B<sub>1</sub>



see project  
AP0101(50)  
00R409  
P.C. Cressell

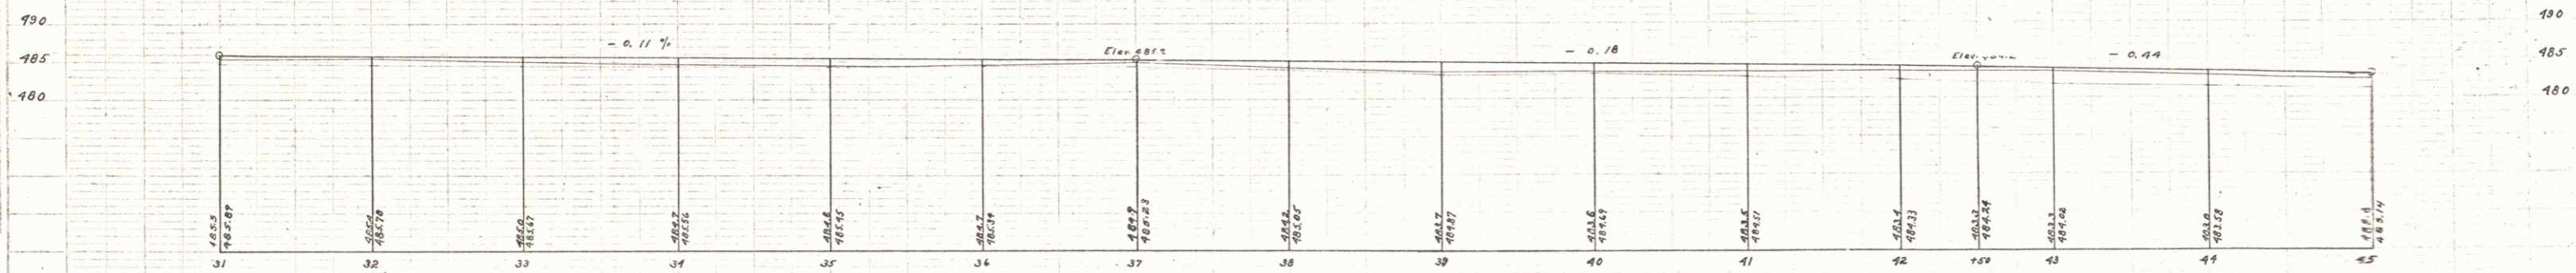

31  
32  
33  
B.M. Spike in elm 10' right of Sta. 31+00, Elev. 484.80  
B.M. Spike in elm 20.0 right of Sta. 35+00, Elev. 483.97  
B.M. Spike in stump 23' right of Sta. 39+00, Elev. 483.73  
B.M. Spike in elm 20.5 right of Sta. 44+00, Elev. 482.70

Note: All Crown Elevations to be lowered 0.08ft.

W. W. Davis  
J. L. Davis  
J. L. Davis

W. W. Davis  
J. L. Davis  
J. L. Davis

Series V-5  
Sheet 4 of 20 Ms B-15  
4

**GUARD RAIL REQUIRED ON LEFT**

Sta	17+30 to	Sta	Length	24 ft
49+33	-	49+57	-	24 -
51+14	-	51+38	-	24 -
56+82	-	57+06	-	24 -
57+30	-	57+10	-	160 -



TOTAL THIS SHEET 256 FT.

**NEW CULVERTS REQUIRED**

Sta	17+93	3x2' Reinforced Concrete	41'-6"
		1-2-4 Concrete	8.3 Cu Yds.
		1-3-6 Concrete	10.4 "
		Steel	187.0 Lbs.

**CULVERT REPAIRS REQUIRED**

Sta	19+95	3x3' Reinforced Concrete	27'-4"
		1-2-4 Concrete	5.6 Cu Yds.
		1-3-6 Concrete	8.3 "
		Steel	129.0 Lbs.
Sta. 51+26		1-2-4 Concrete Inlet Box	1.5 Cu Yds.
Sta. 56+94		" " "	1.0 "

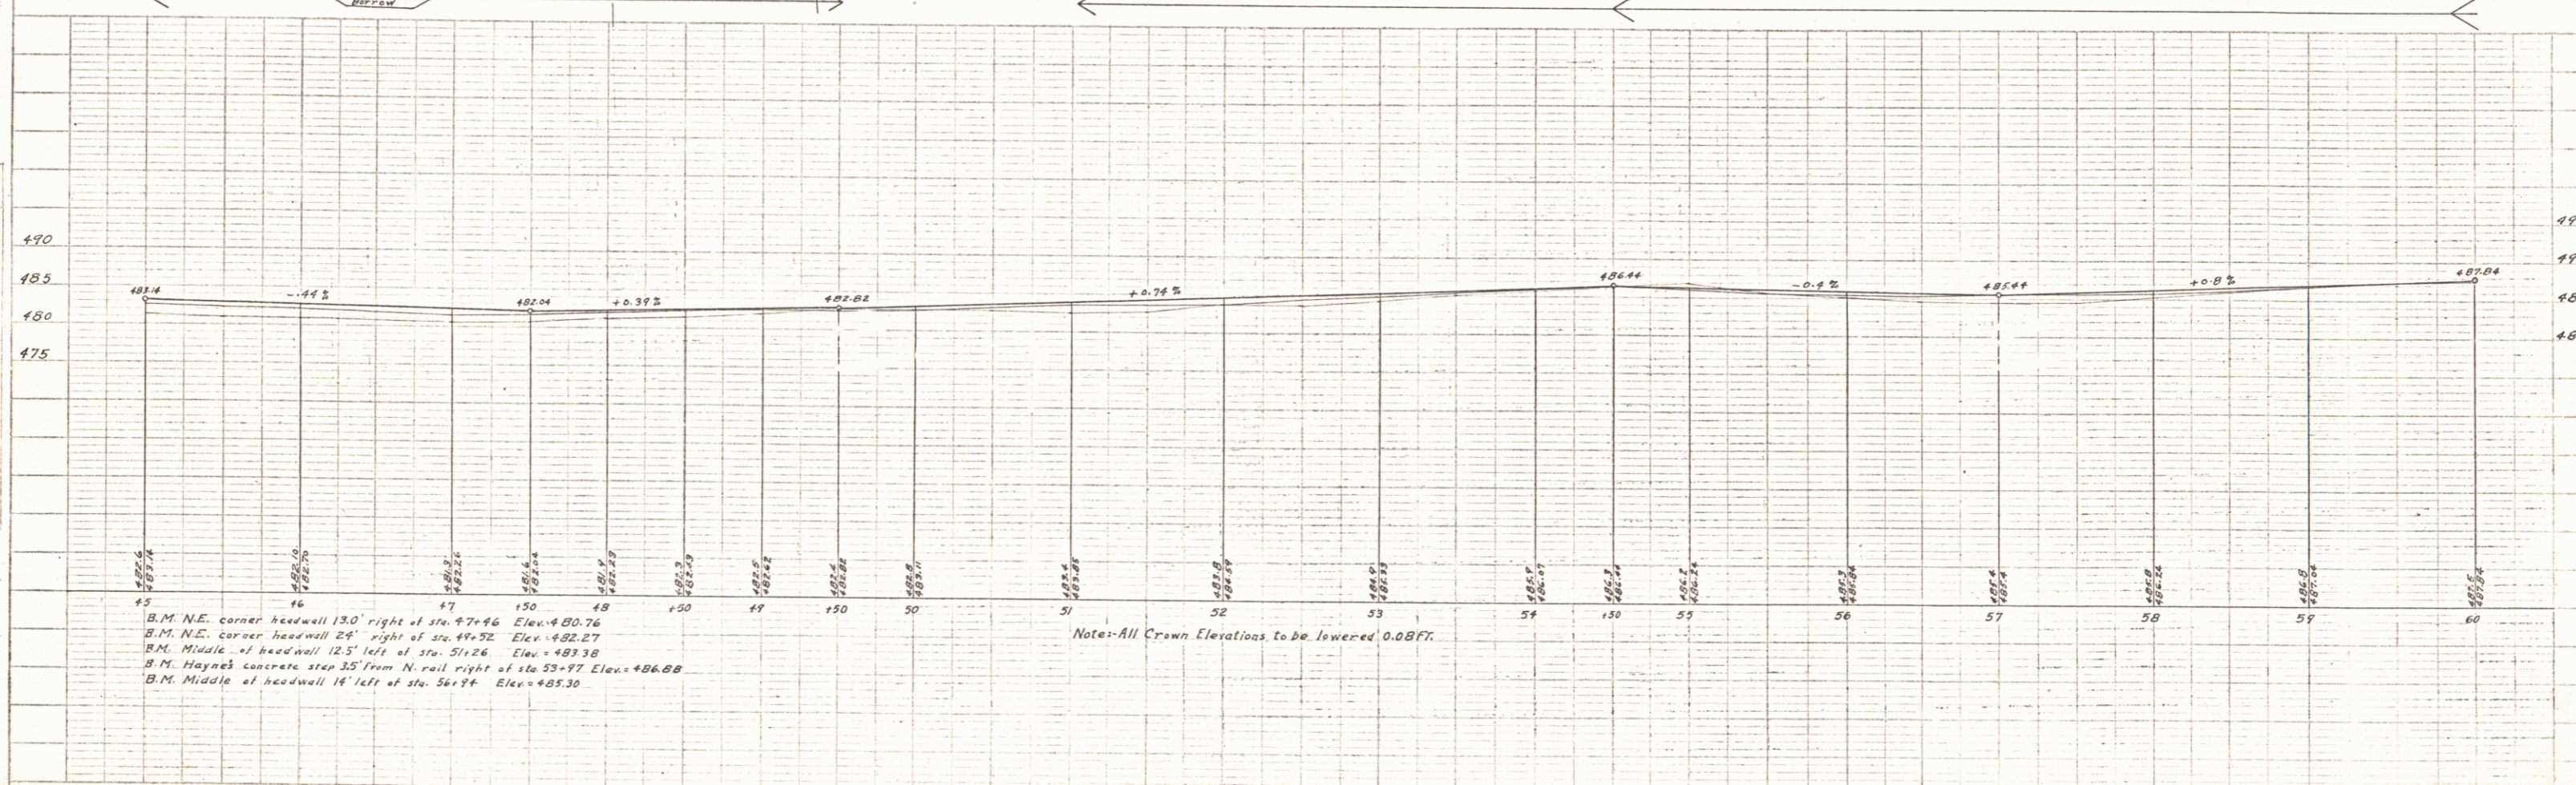
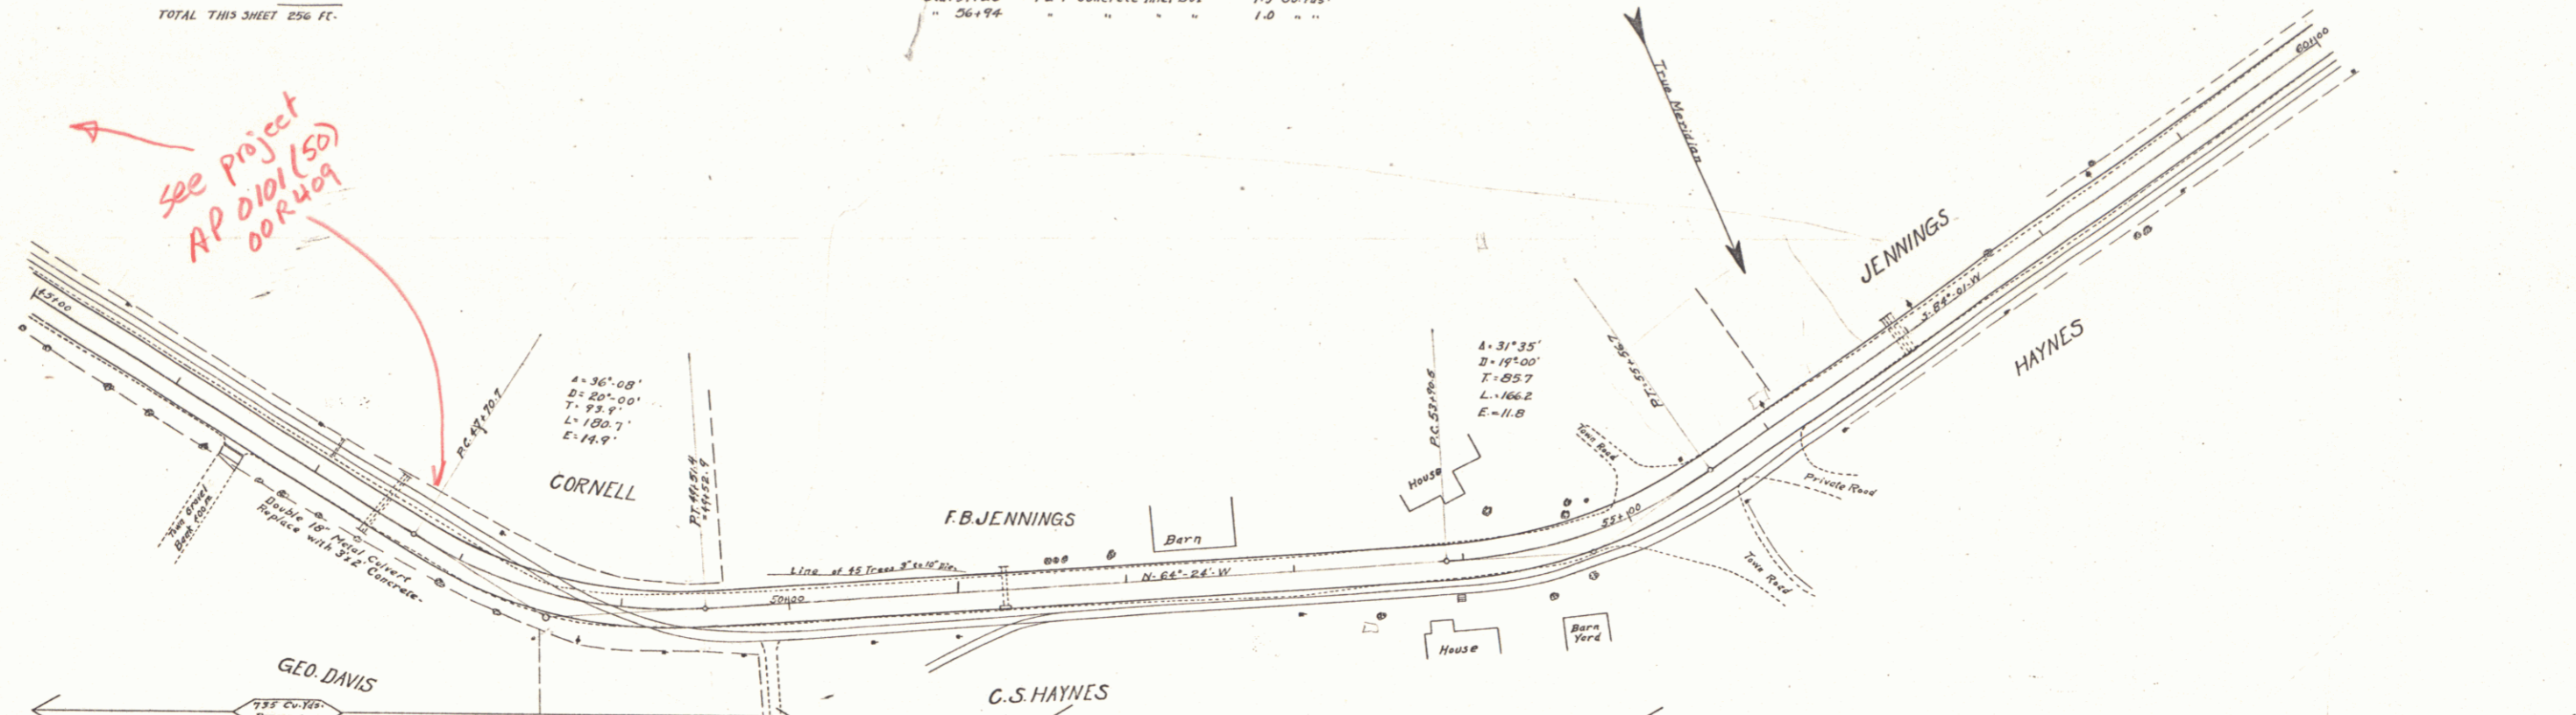


B.M. N.E. corner headwall 13.0' right of sta. 49+46 Elev. 480.76  
 B.M. N.E. corner headwall 24' right of sta. 49+52 Elev. 482.27  
 B.M. Middle of headwall 12.5' left of sta. 51+26 Elev. 483.38  
 B.M. Haynes concrete step 35' from N. rail right of sta. 53+97 Elev. 486.88  
 B.M. Middle of headwall 14' left of sta. 56+94 Elev. 485.30

Note: All Crown Elevations to be lowered 0.08 FT.

GUARD RAIL REQUIRED ON LEFT			
Sta	68714	To Sta	69126
Length	412'		
Sta	69126	To Sta	71471
Length	2345'		
TOTAL THIS SHEET 800 ft			

CULVERT REPAIRS REQUIRED			
Sta	68724	1-2-4 Concrete inlet box	10 Cu yd
"	68724	1-2-1 " " "	17 "
"	69171	1-2-4 " " "	15 "
"	69171	1-2-4 Headwall	0.5 "
"	69171	1 Small grate	1 "
Sta	71142	1-2-4 concrete inlet box	0.8 "
"	71142	1-2-4 Headwall	0.5 "
"	71142	1 Small grate	1 "

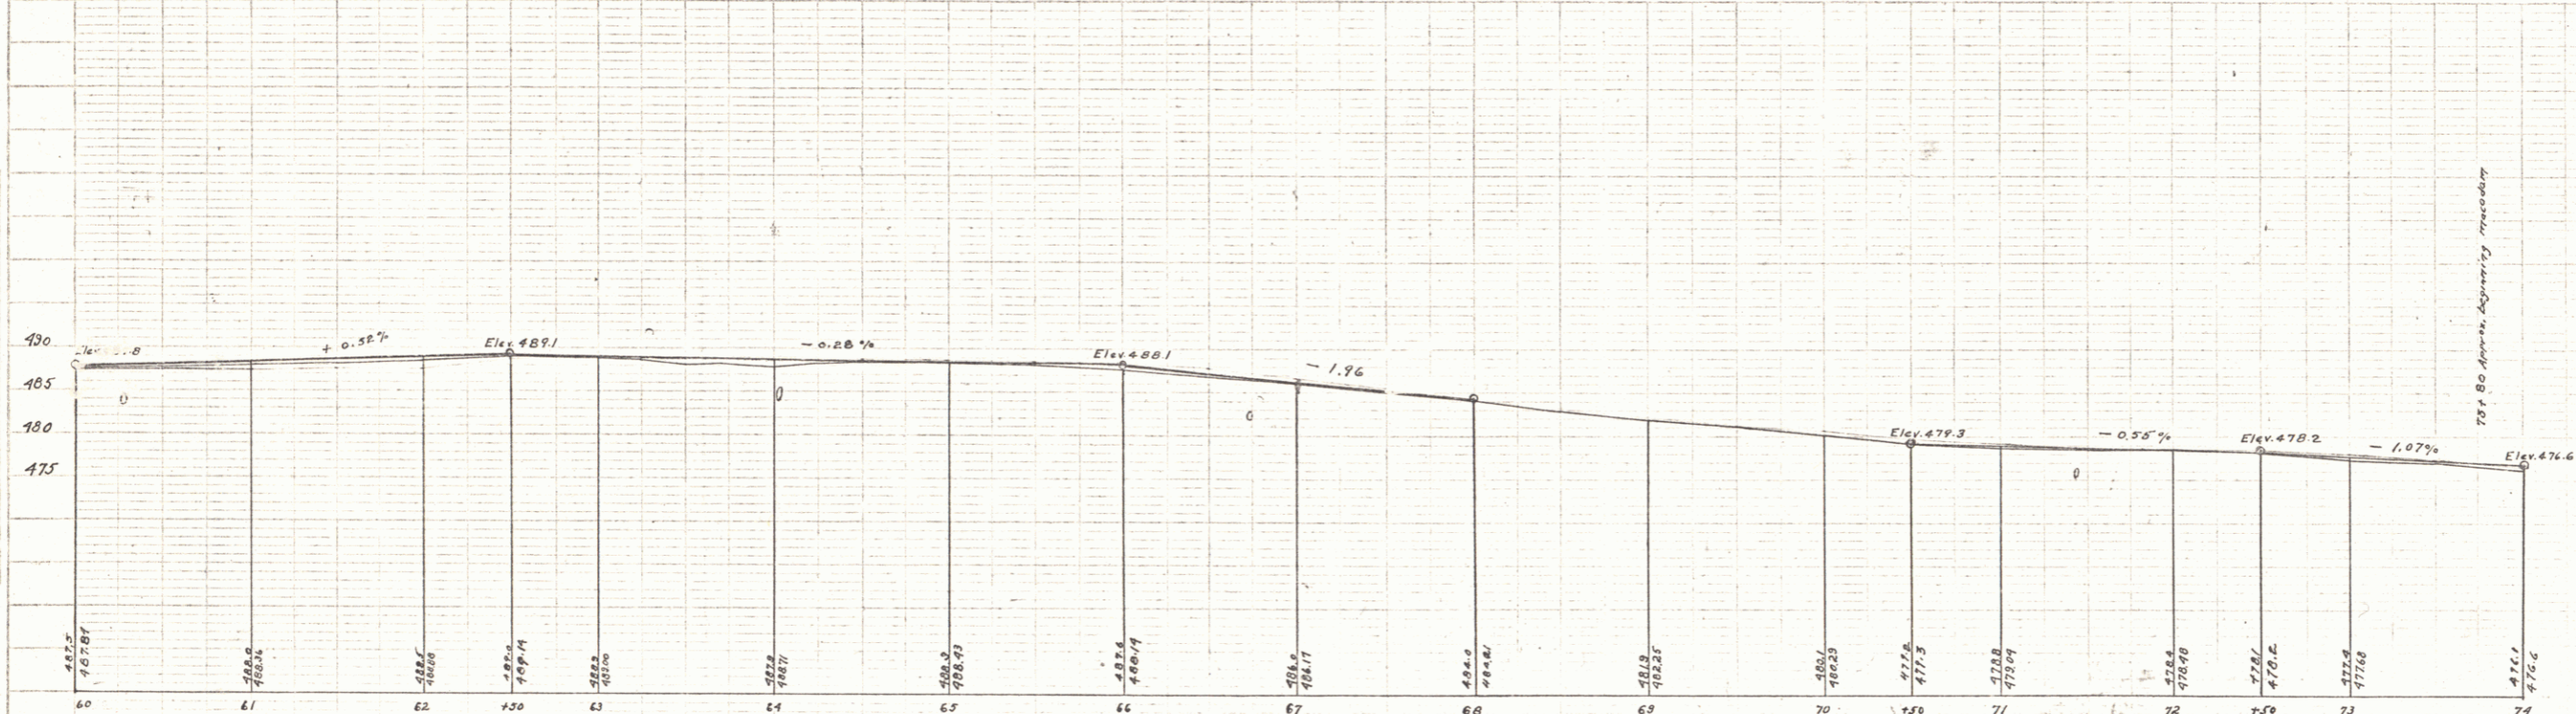
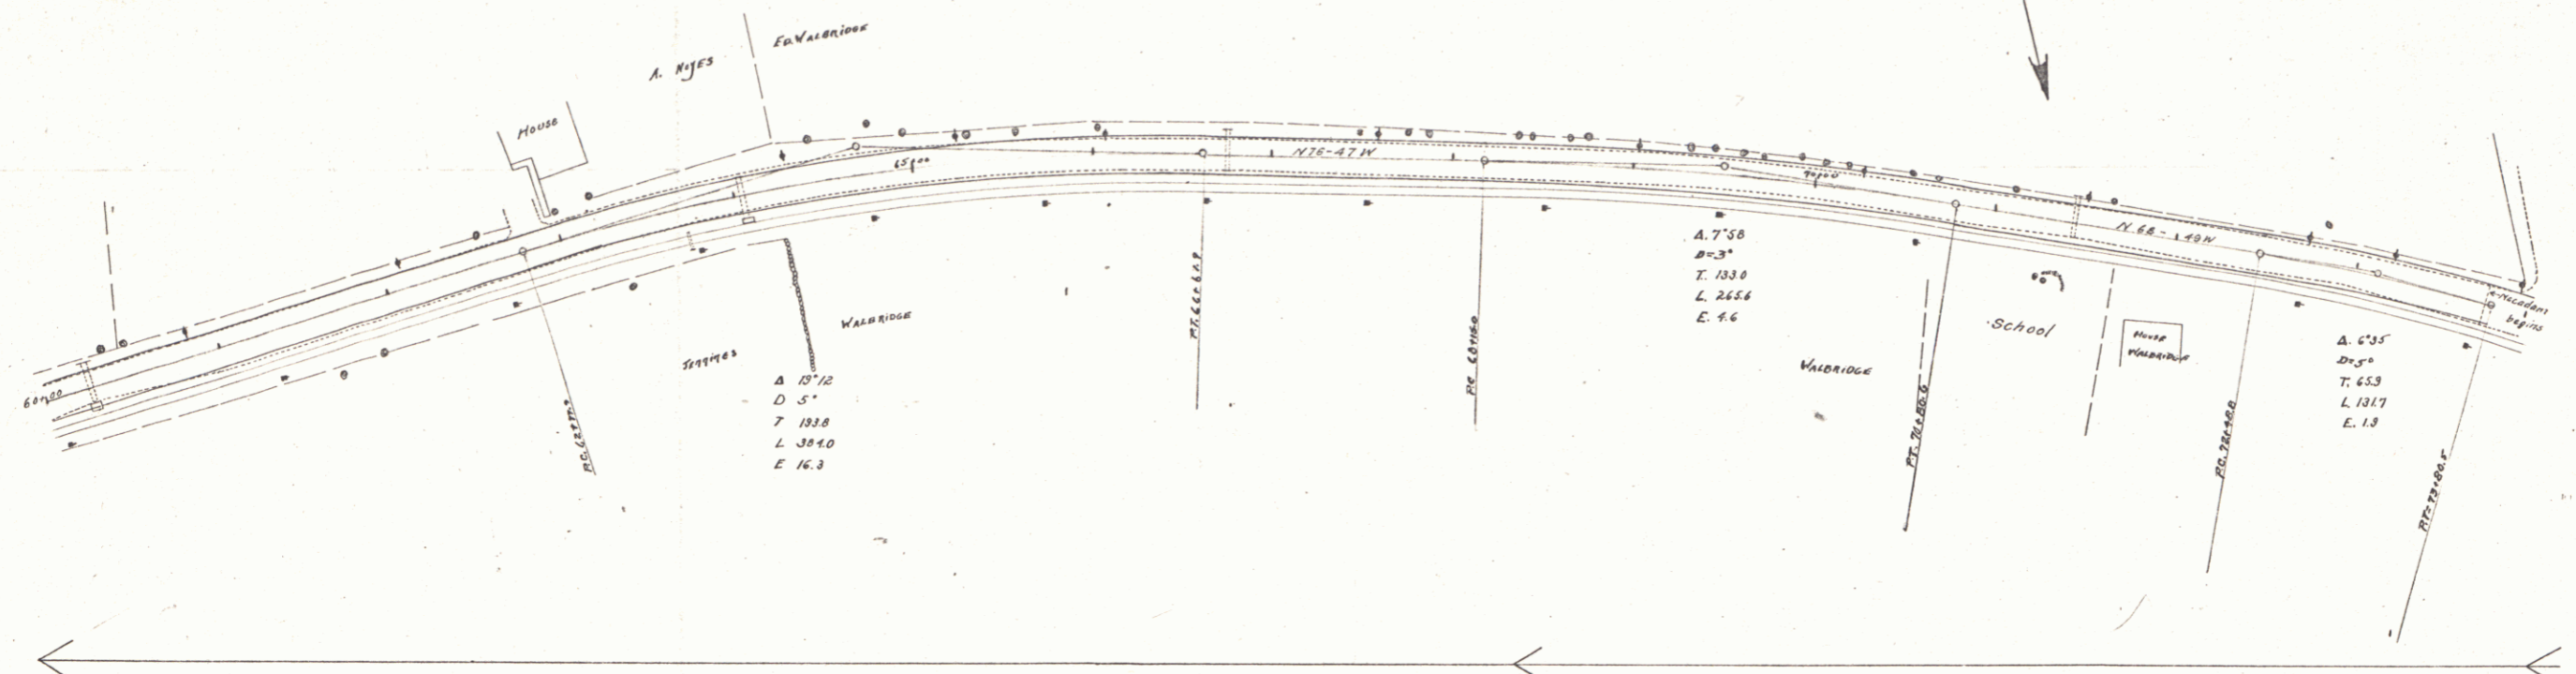


B.M. N.E. Corner of headwall 16' left of 60+20, Elev 487.96  
 B.M. N.E. Corner of headwall 16' left of 64+00, Elev 487.74  
 B.M. Nail in Elm 13.5' left of Sta 68+40, Elev 482.12  
 B.M. Spike in elm 14' left of 71+60, Elev 478.08

Note: All Crown Elevations to be lowered 0.08 ft.

GUARD RAIL REQUIRED  
ON RIGHT  
Sta 85+64 to Sta 85+88 Length 24 ft

GULVERT REPAIRS REQUIRED  
Sta 80+27 Reinforced concrete 20x15  
1-2-4 concrete 3.6 cu yds  
1-3-6 " 53 " "  
Steel 600 lbs.  
Sta 85+82 1-3-6 " 4.5 cu yds

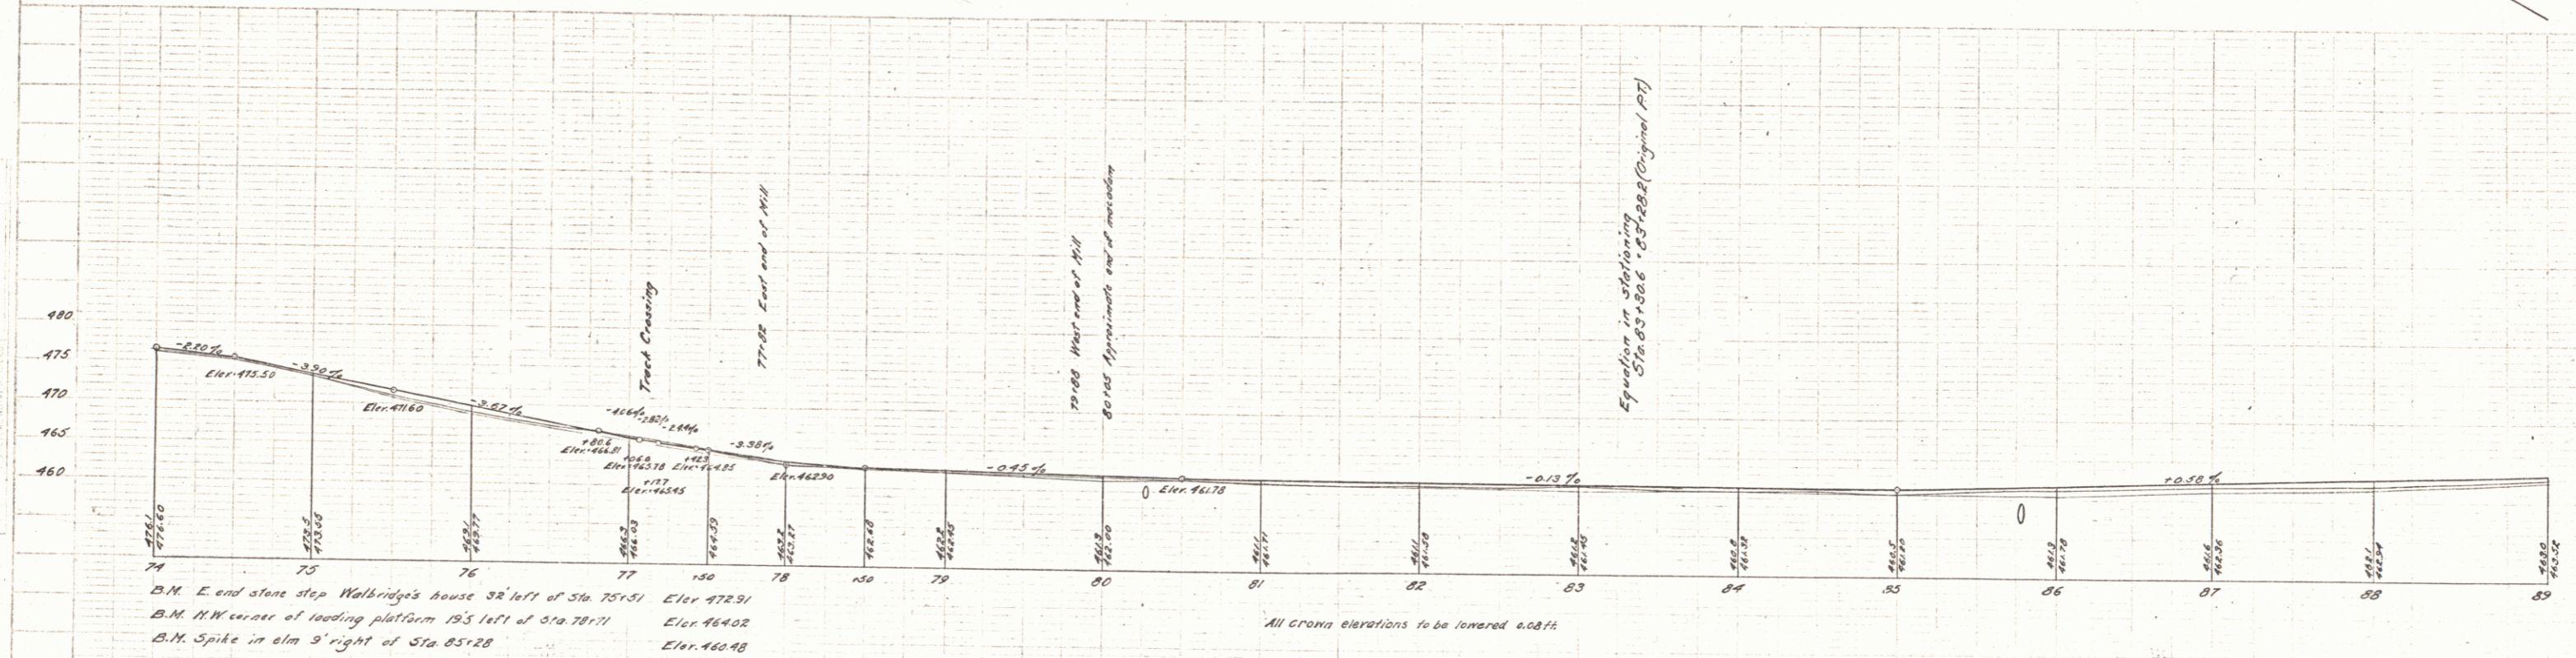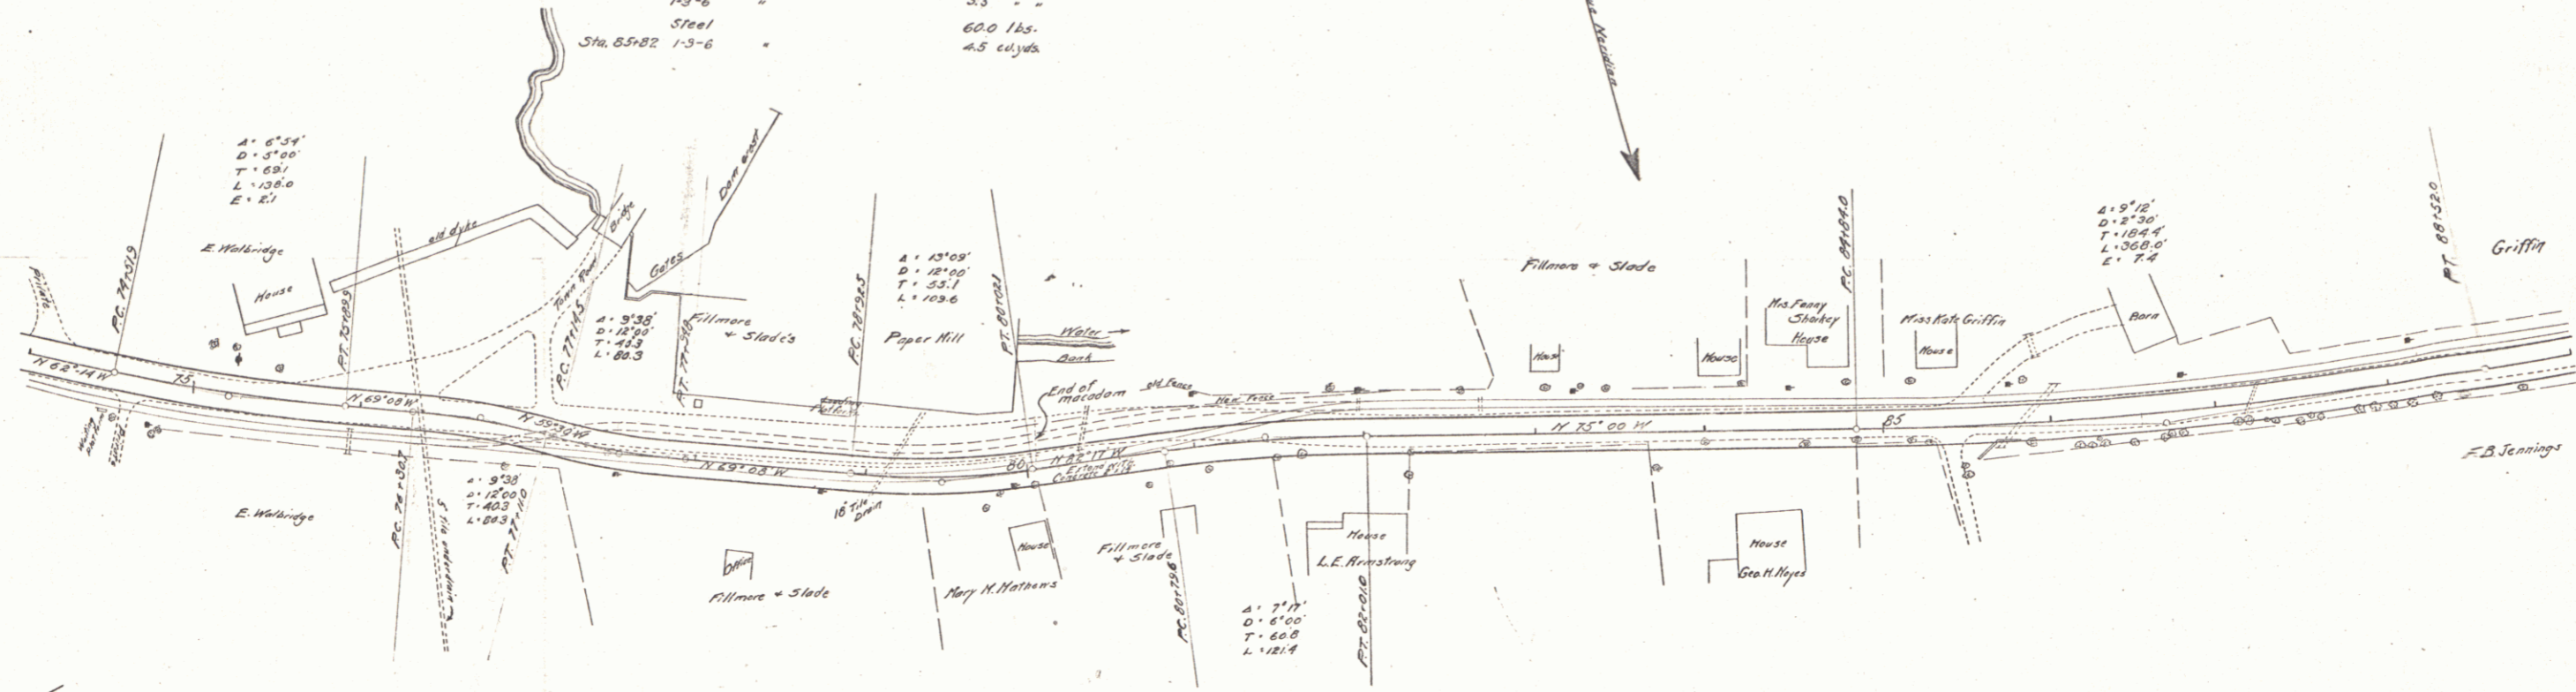

Scale  
1" = 100'  
1" = 100'

Scale  
1" = 100'  
1" = 100'

B.M. E. end stone step Walkridge's house 38' left of Sta 75+31 Elev 472.91  
B.M. N.W. corner of loading platform 19.5' left of Sta 78+71 Elev 464.02  
B.M. Spike in elm 9' right of Sta 85+28 Elev 460.48



All crown elevations to be lowered 0.08 ft.

Series J-3  
Sheet 7 of 26 MeB-15



J.L. Davis  
 C.E. Day and J.L.Z.  
 J.L.Z.

C.W. Bauger  
 P.W. White  
 J.L. Davis

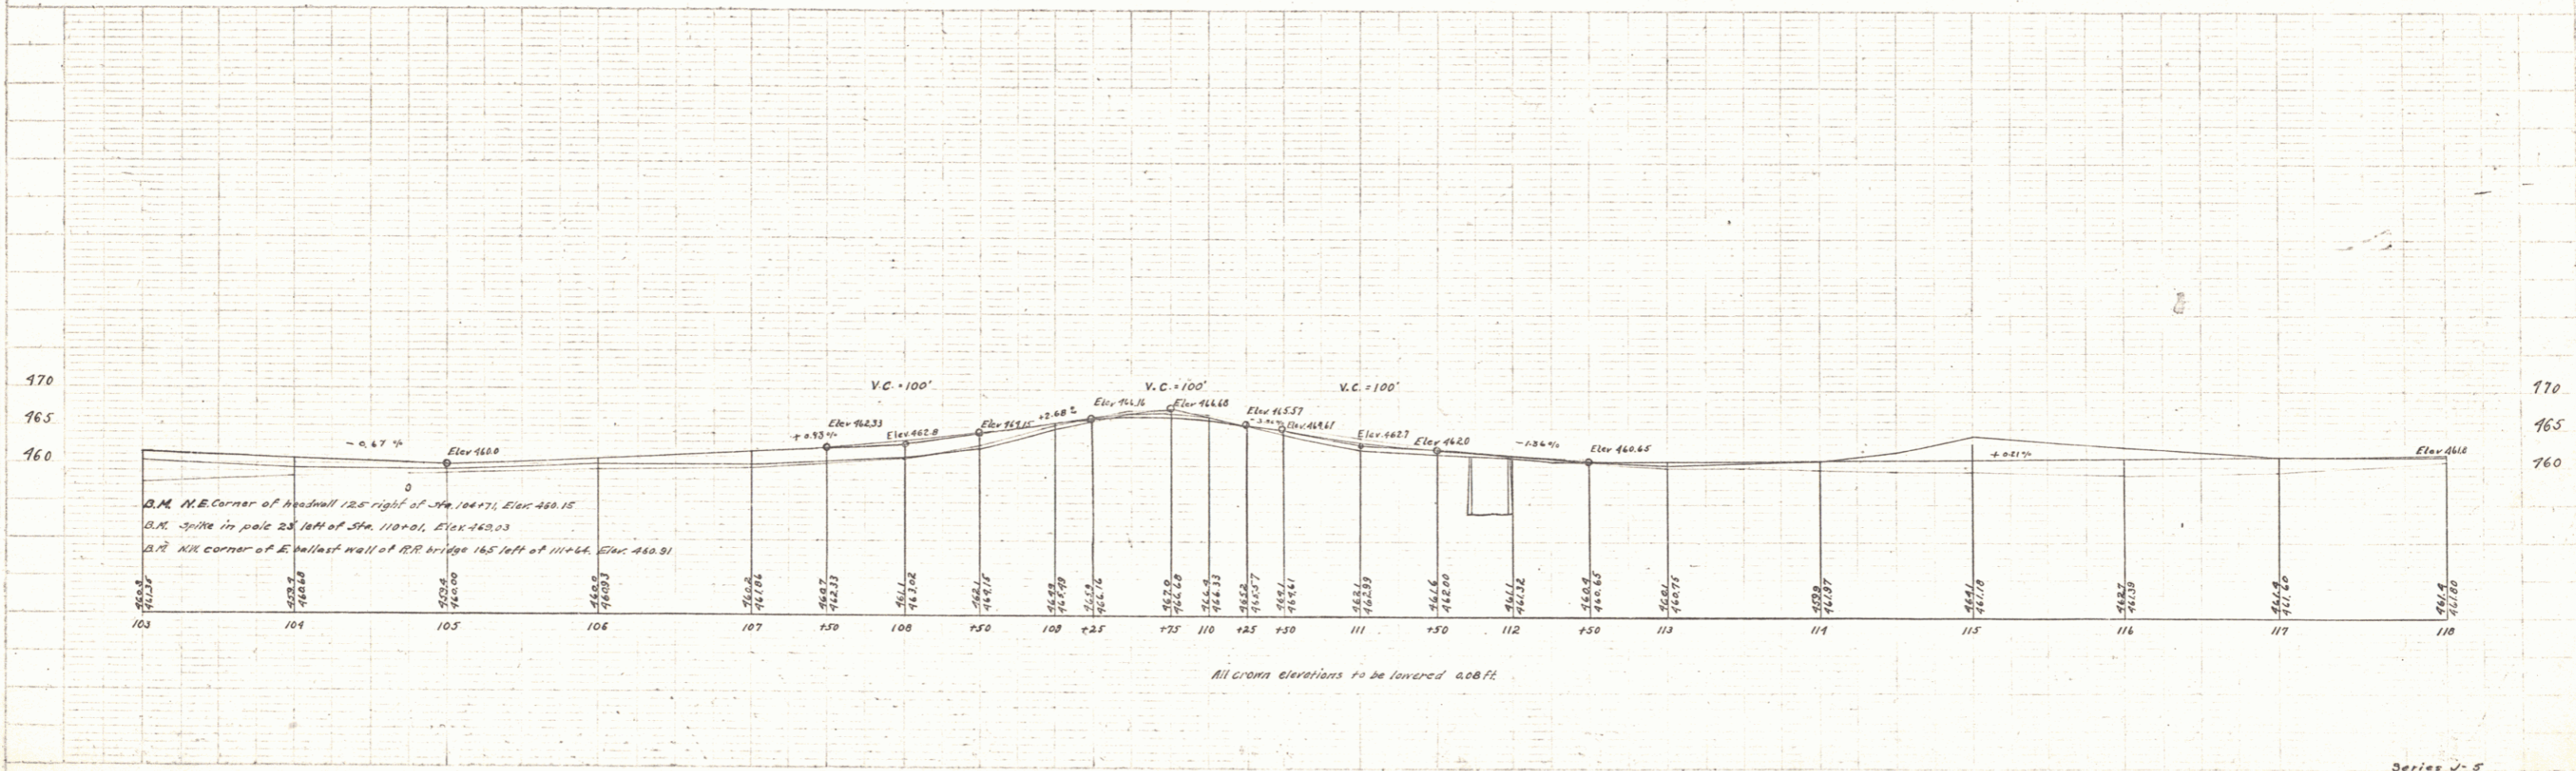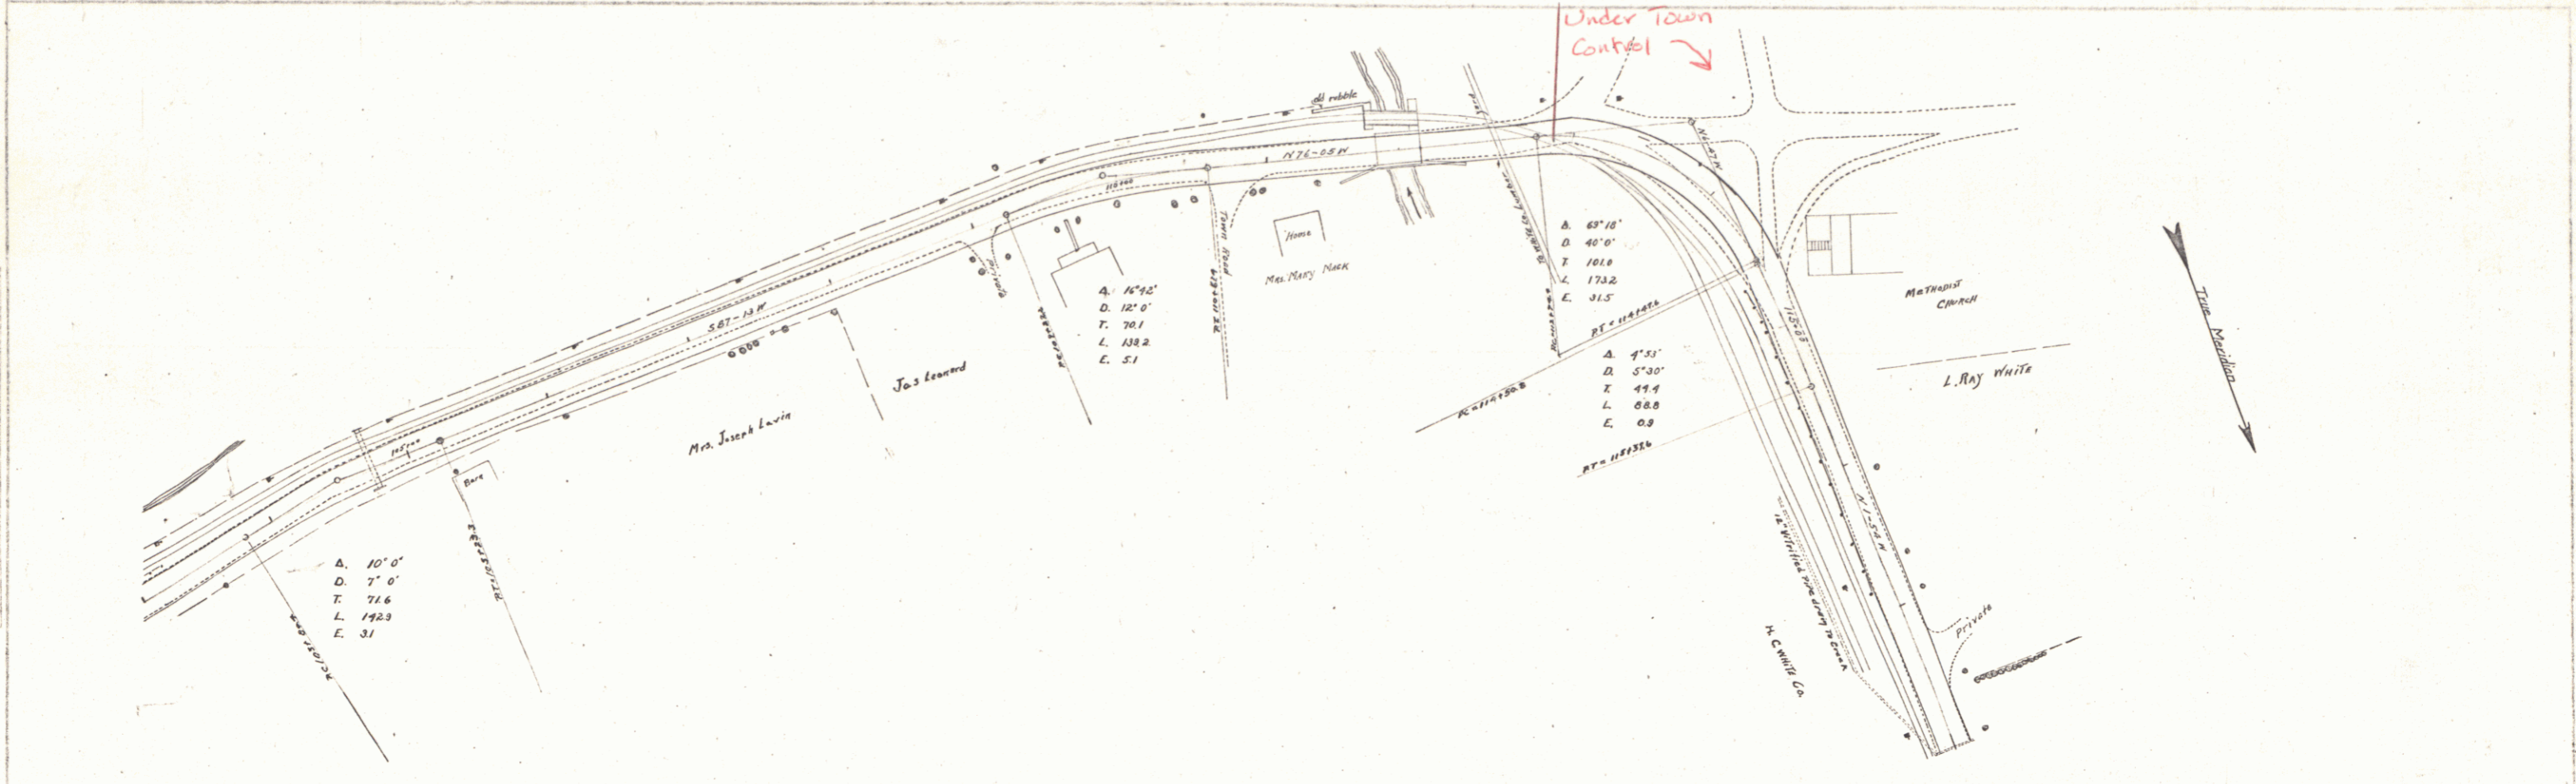



All crown elevations to be lowered 0.08 ft.

Series U-5  
 Sheet 9 of 20 MSB

GUARD RAIL REQUIRED  
ON LEFT  
Sta. 126+00 To Sta. 127+10 Length 243'

NEW CULVERTS REQUIRED  
Sta. 127+00  
2'x2' Reinforced Concrete 38.5 ft  
1'-2" Concrete 5.0 cu. yds  
1'-3" Steel 0.1  
Steel 0.4 lbs

True Meridian

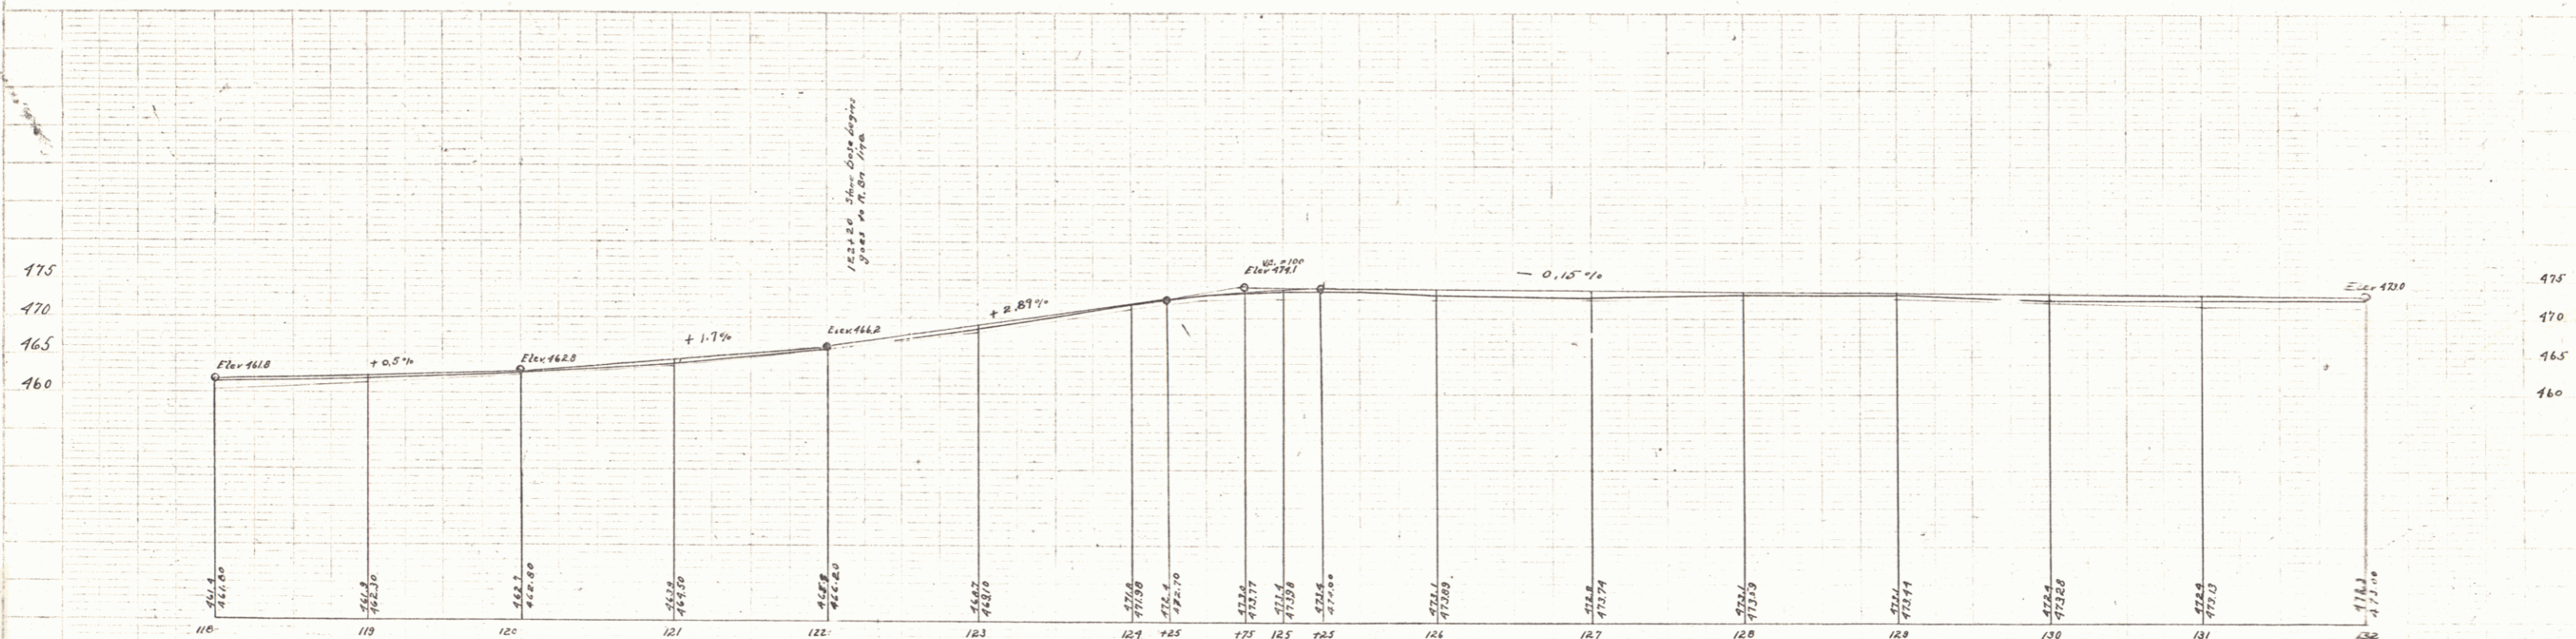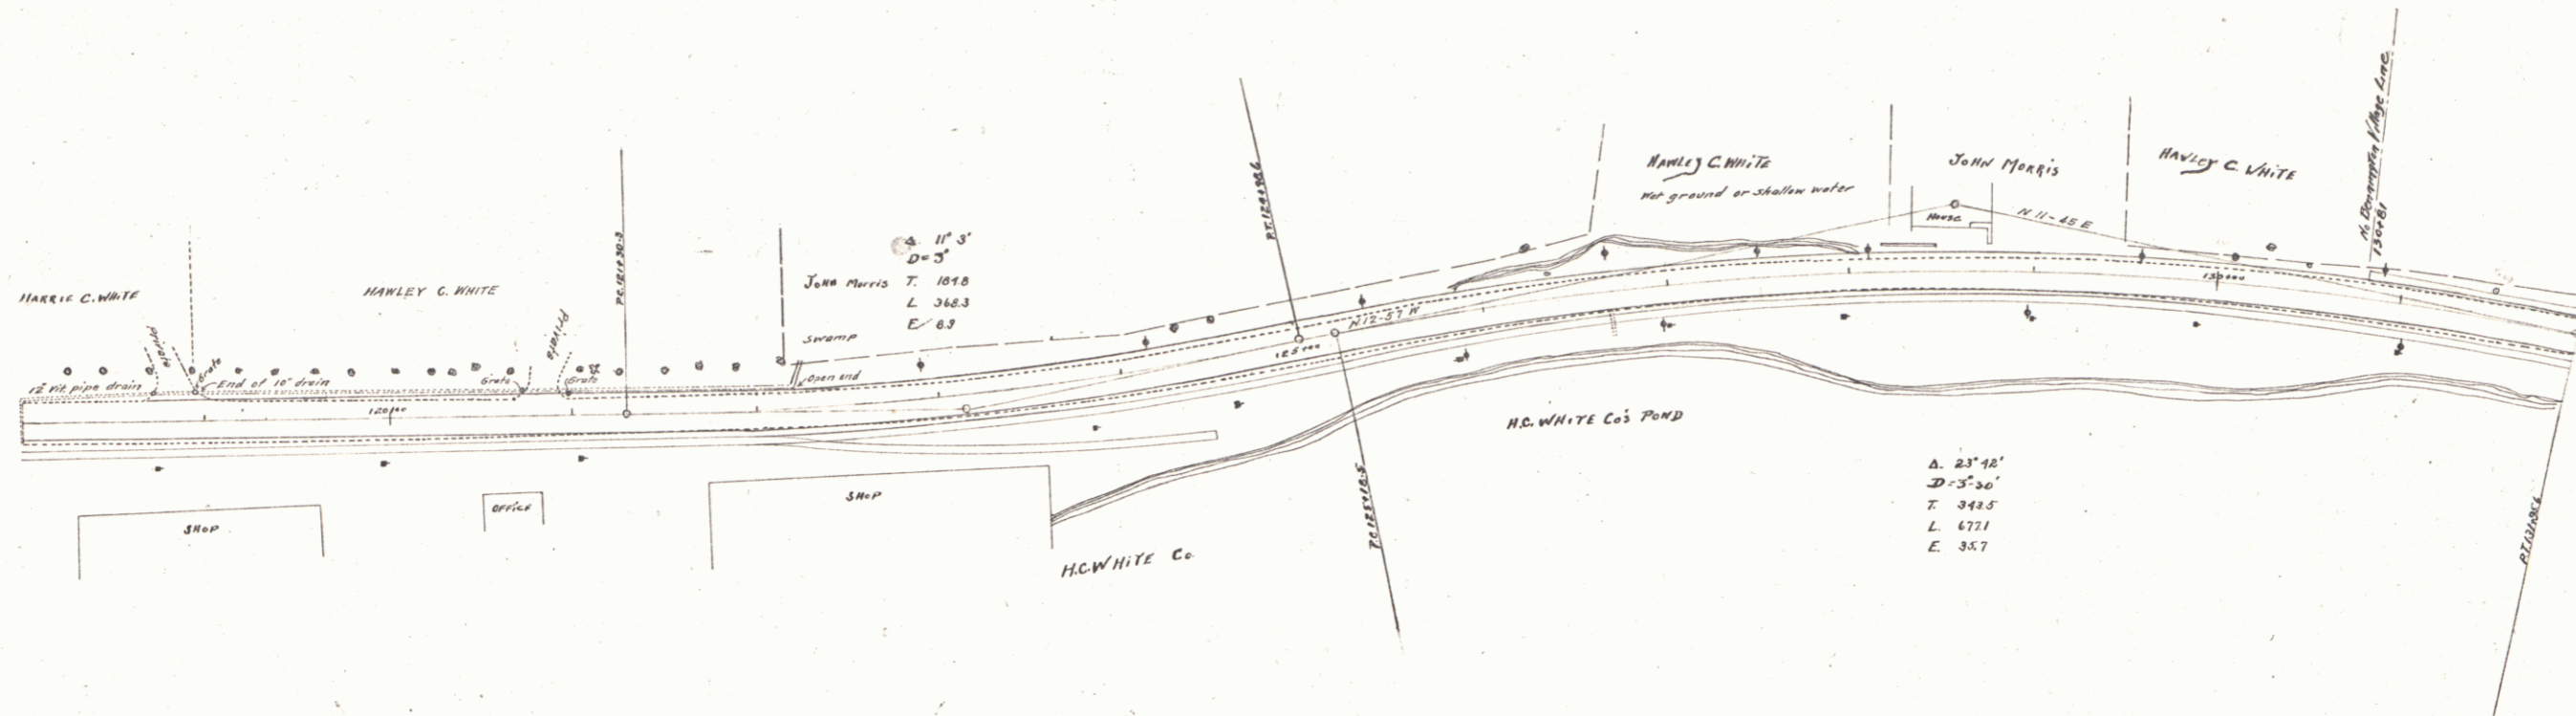

B.M. Front S.W. corner of window shaft White Co. mill 52' right of Sta. 118+32, Elev. 441.34  
B.M. S.W. corner of foundation 30' right of mill 31' right of Sta. 121+71, Elev. 465.90  
B.M. Spike in elm 28' left of Sta. 126+37, Elev. 475.43  
B.M. Spike in elm 21' left of Sta. 130+27, Elev. 473.15

All Crown elevations to be lowered 0.00 ft.

Series J-5  
Sheet 10 of 20 Ms. B-15  
10