
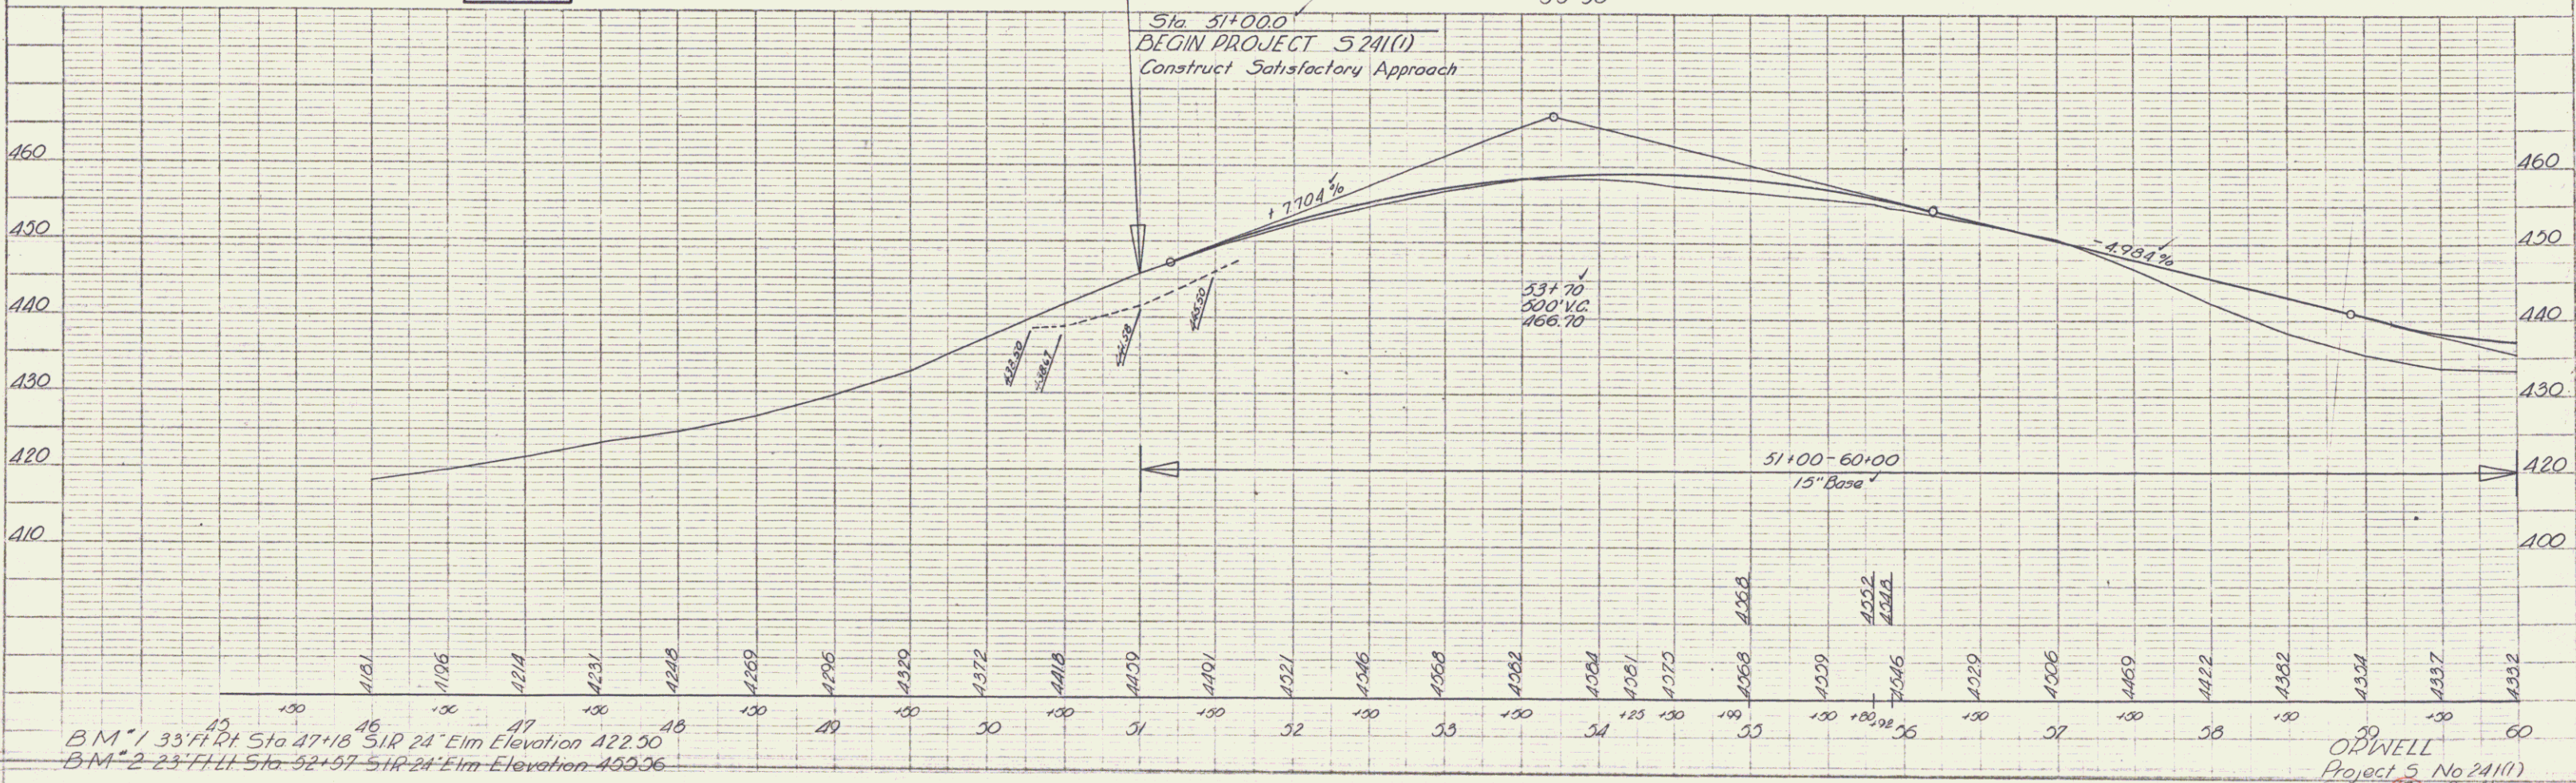


PLAN
 DRAWN BY: A. Lavin
 DATE: 12-31-34
 CHECKED BY: Palmer
 DATE: 2-22-35

PROFILE
 DRAWN BY: A. Lavin
 DATE: 12-31-34
 CHECKED BY: Palmer
 DATE: 2-22-35

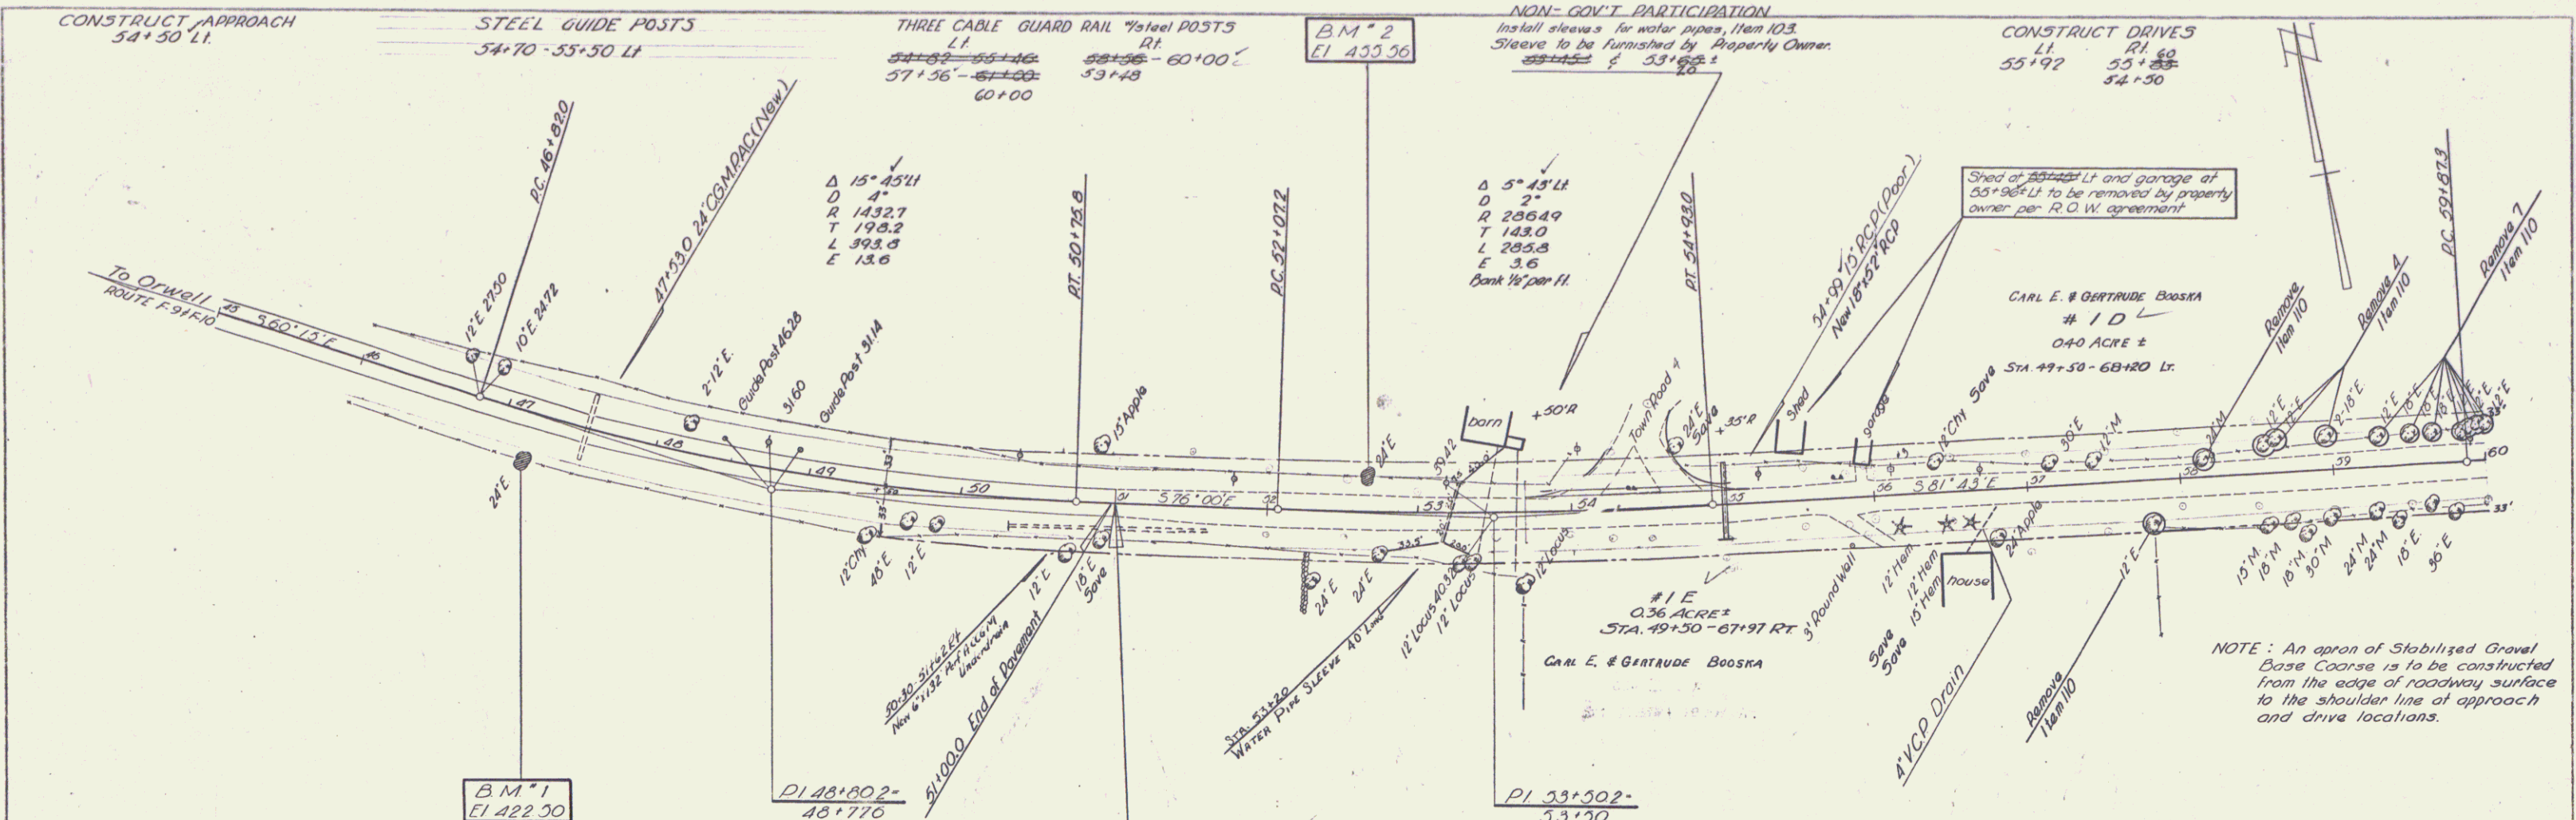

B.M. 1 33' RT Sta 47+18 51R 24' Elm Elevation 422.50
 B.M. 2 23' FLL Sta 52+57 51R 24' Elm Elevation 459.36

OPWELL
 Project 5 No 241(1)
 Sheet 8 of 41

PLATE 1 - PLAN - PROFILE
 H. E. DAVIS & SONS
 1000
 H. E. DAVIS & SONS

2