

PLAN
 A 6810
 2-32
 A. Lohr
 2-32
 A. Lohr

PROFILE
 A 6810
 2-32
 A. Lohr
 2-32
 A. Lohr

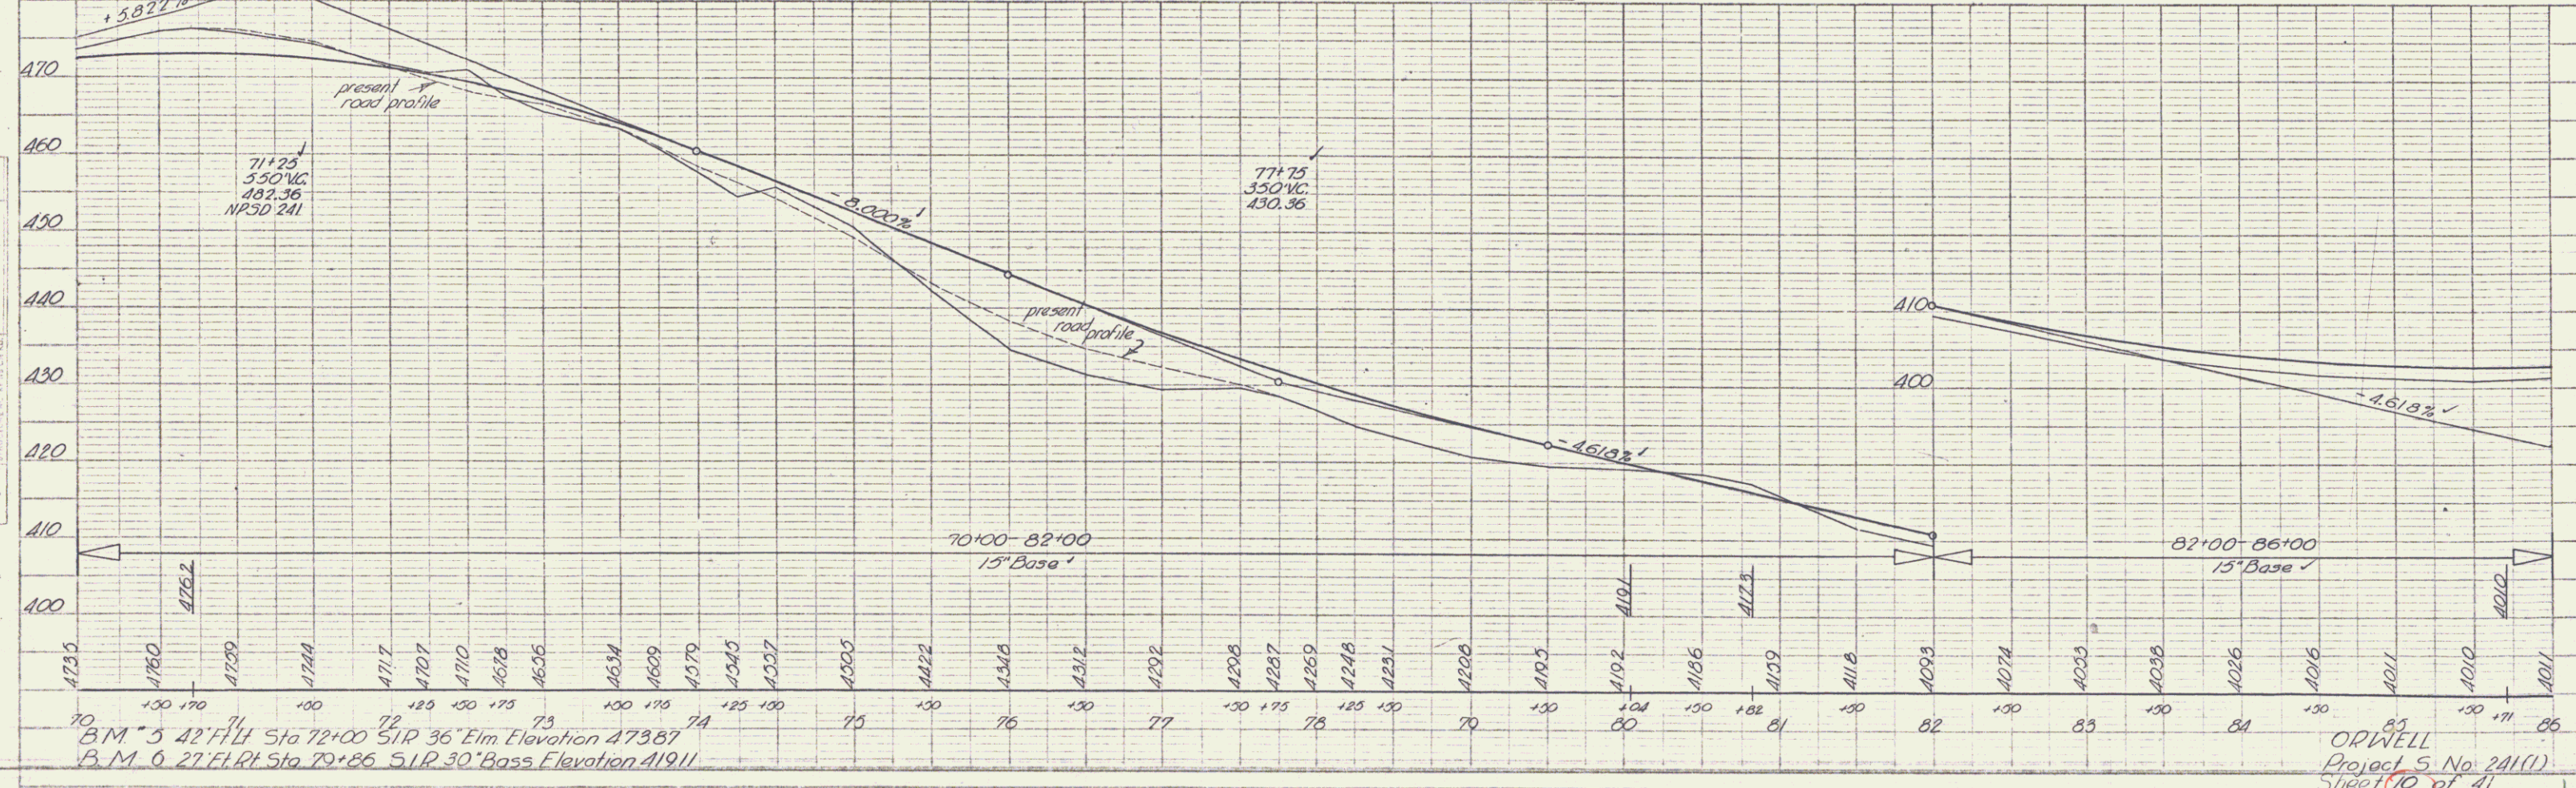
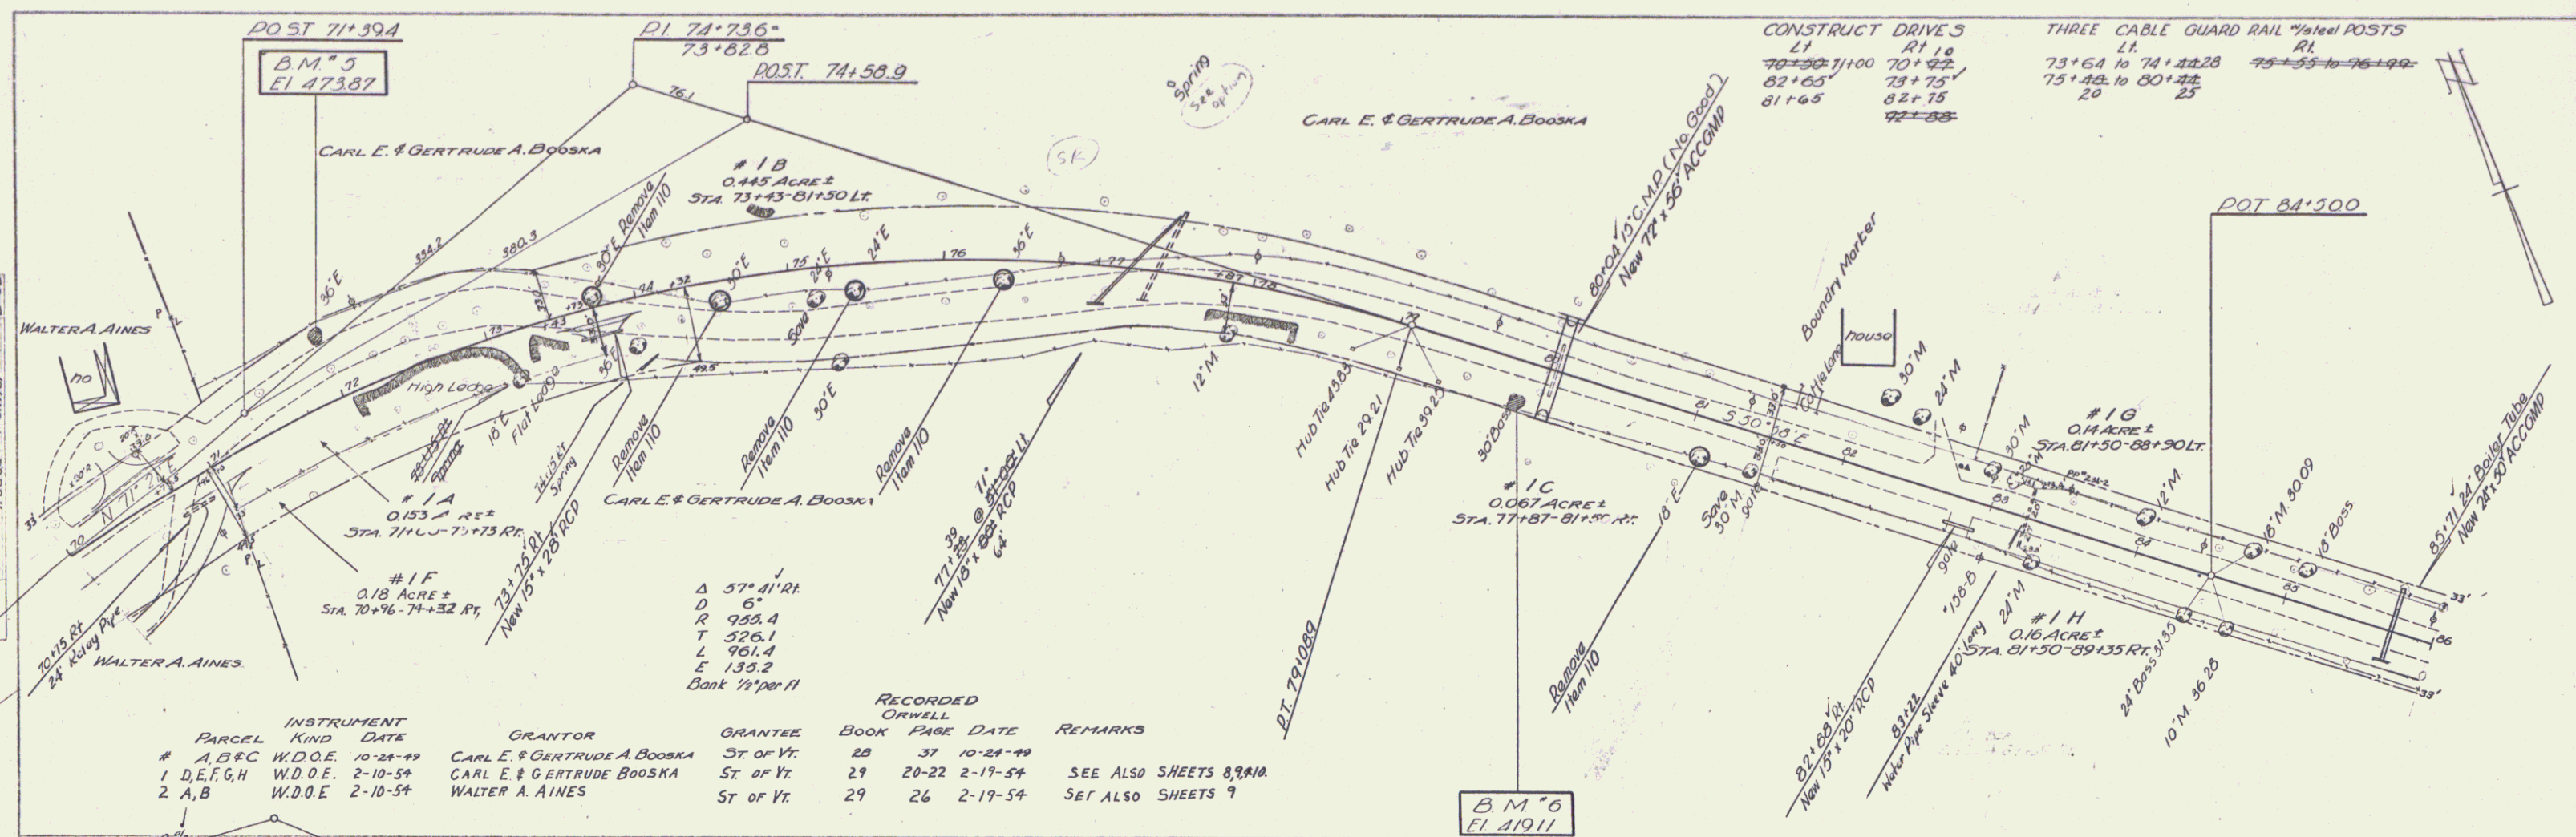


PLATE 1 - PLAN PROFILE & V.C. & E. STATIONS
 4811 & 4812 OF 4810
 U.S.G.S. No. 2481C
 1:25,000

ORWELL
 Project 5 No. 241(1)
 Street 10 of 41