


PLAN  
 DRAWN BY  
 A. Palmer  
 DATE  
 2-28  
 CHECKED BY  
 F. Palmer  
 DATE  
 2-28

PROFILE  
 DRAWN BY  
 A. Palmer  
 DATE  
 2-28  
 CHECKED BY  
 F. Palmer  
 DATE  
 2-28

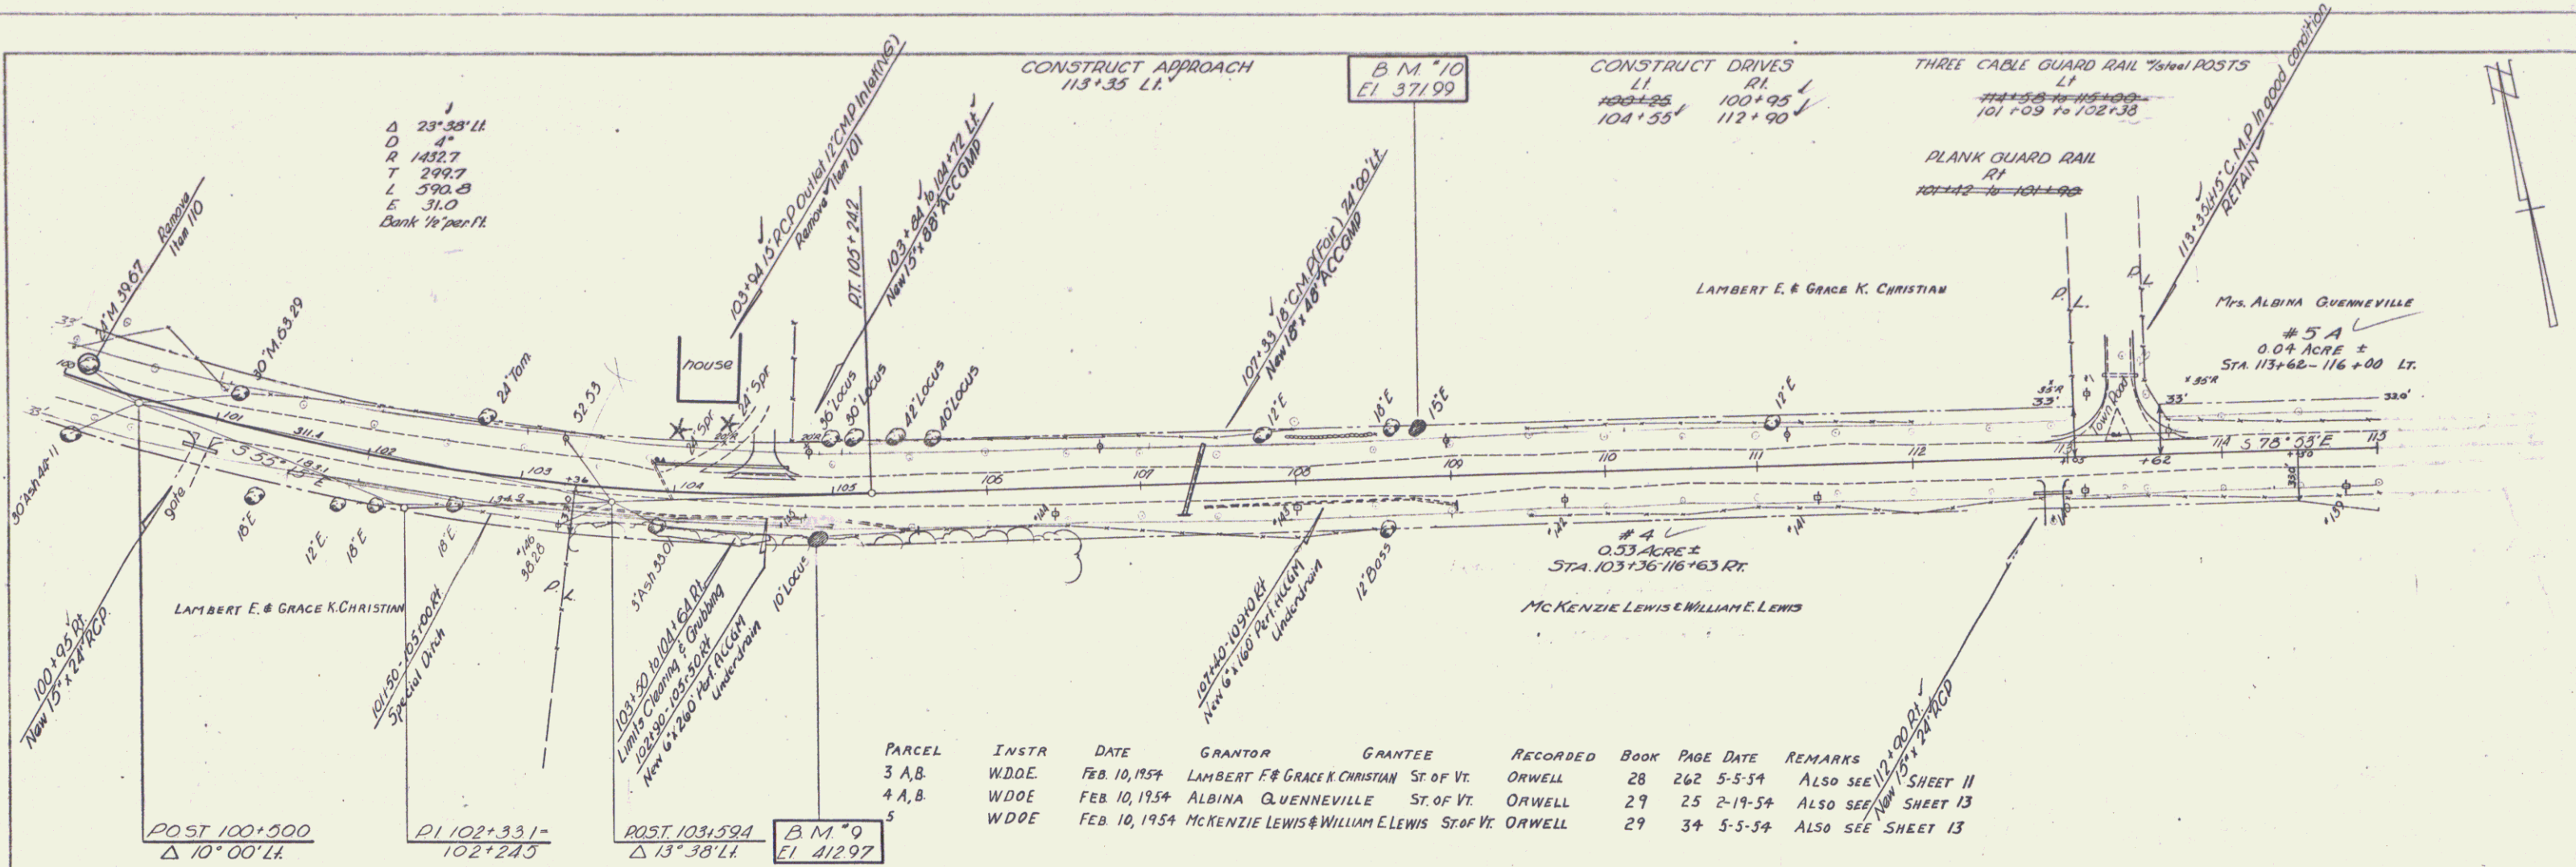

| PARCEL | INSTR    | DATE          | GRANTOR                           | GRANTEE    | RECORDED | BOOK | PAGE | DATE    | REMARKS           |
|--------|----------|---------------|-----------------------------------|------------|----------|------|------|---------|-------------------|
| 3 A,B  | W.D.O.E. | FEB. 10, 1954 | LAMBERT F. & GRACE K. CHRISTIAN   | ST. OF VT. | ORWELL   | 28   | 262  | 5-5-54  | ALSO SEE SHEET 11 |
| 4 A,B  | W.D.O.E. | FEB. 10, 1954 | ALBINA GUENNEVILLE                | ST. OF VT. | ORWELL   | 29   | 25   | 2-19-54 | ALSO SEE SHEET 13 |
| 5      | W.D.O.E. | FEB. 10, 1954 | MCKENZIE LEWIS & WILLIAM E. LEWIS | ST. OF VT. | ORWELL   | 29   | 34   | 5-5-54  | ALSO SEE SHEET 13 |

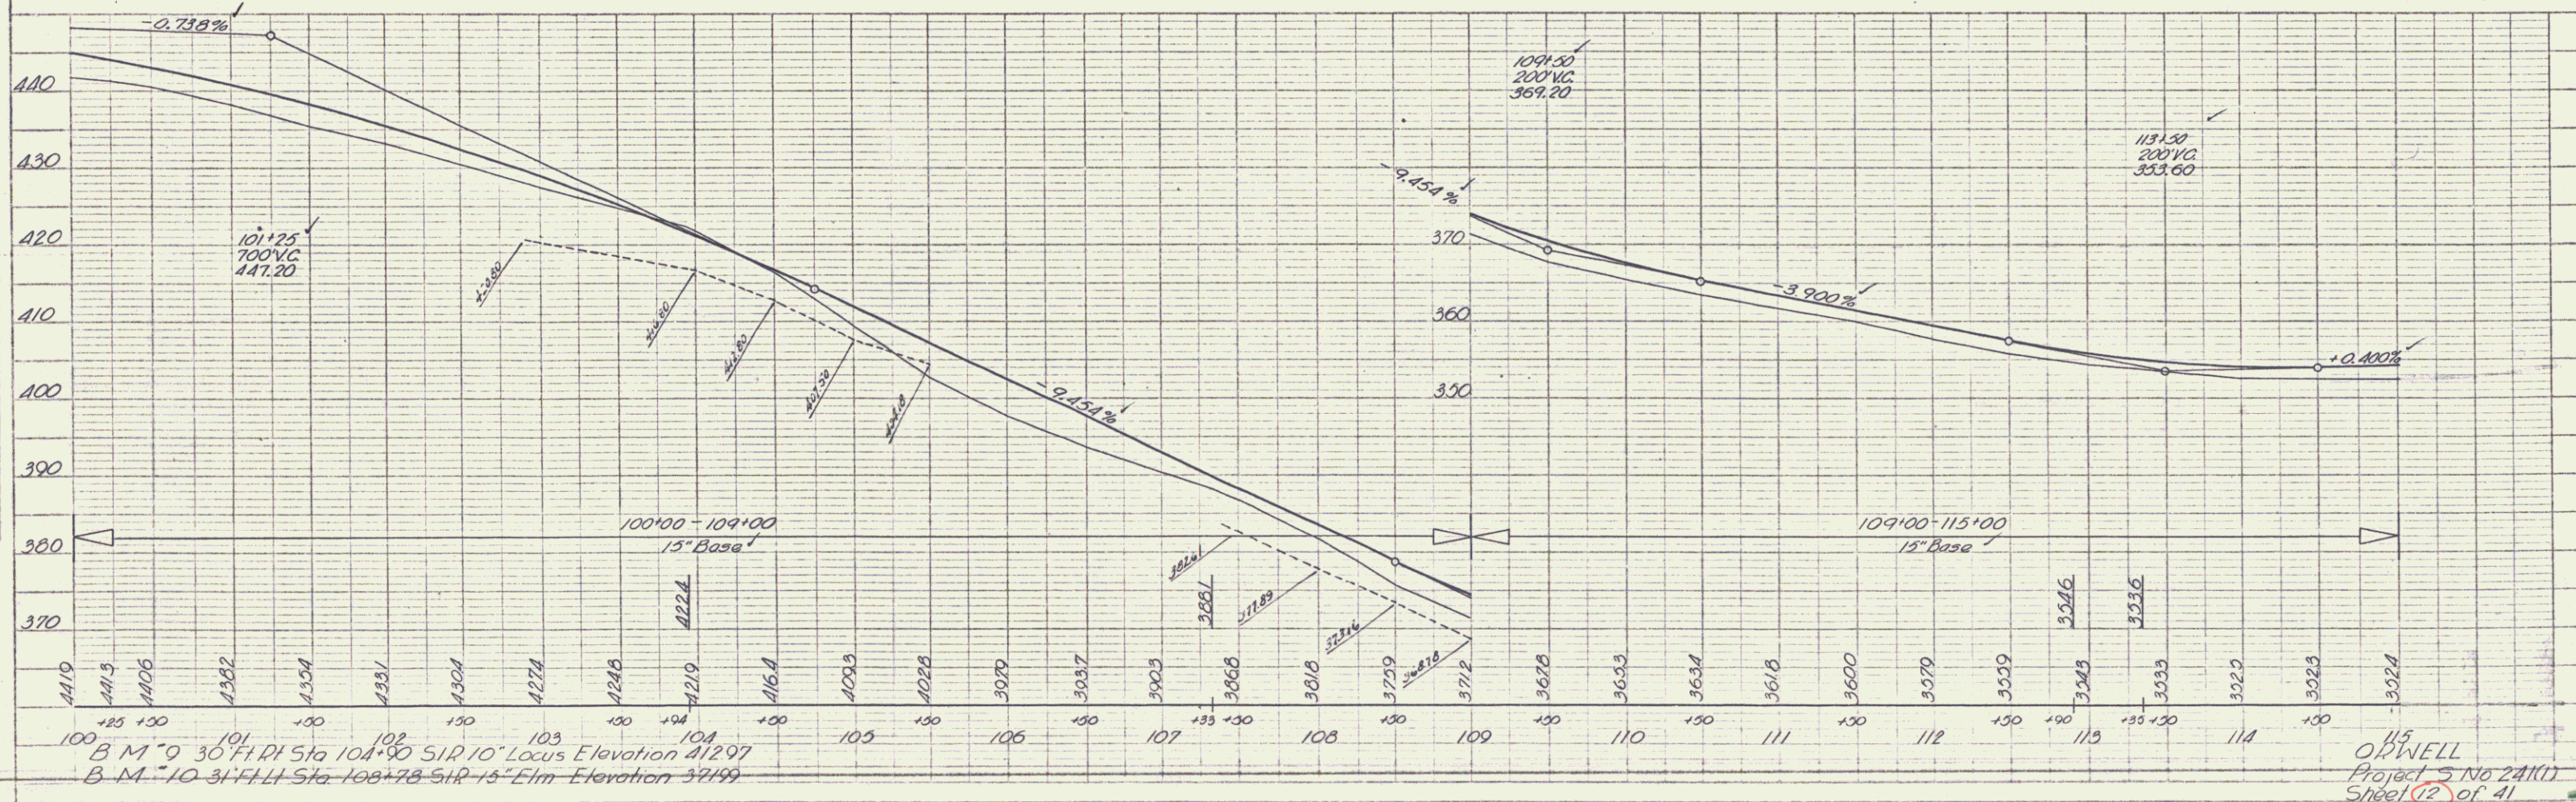


PLATE 1 - PLAN - PROFILE  
 115  
 ORWELL  
 Project No 241(1)  
 Sheet 12 of 41