
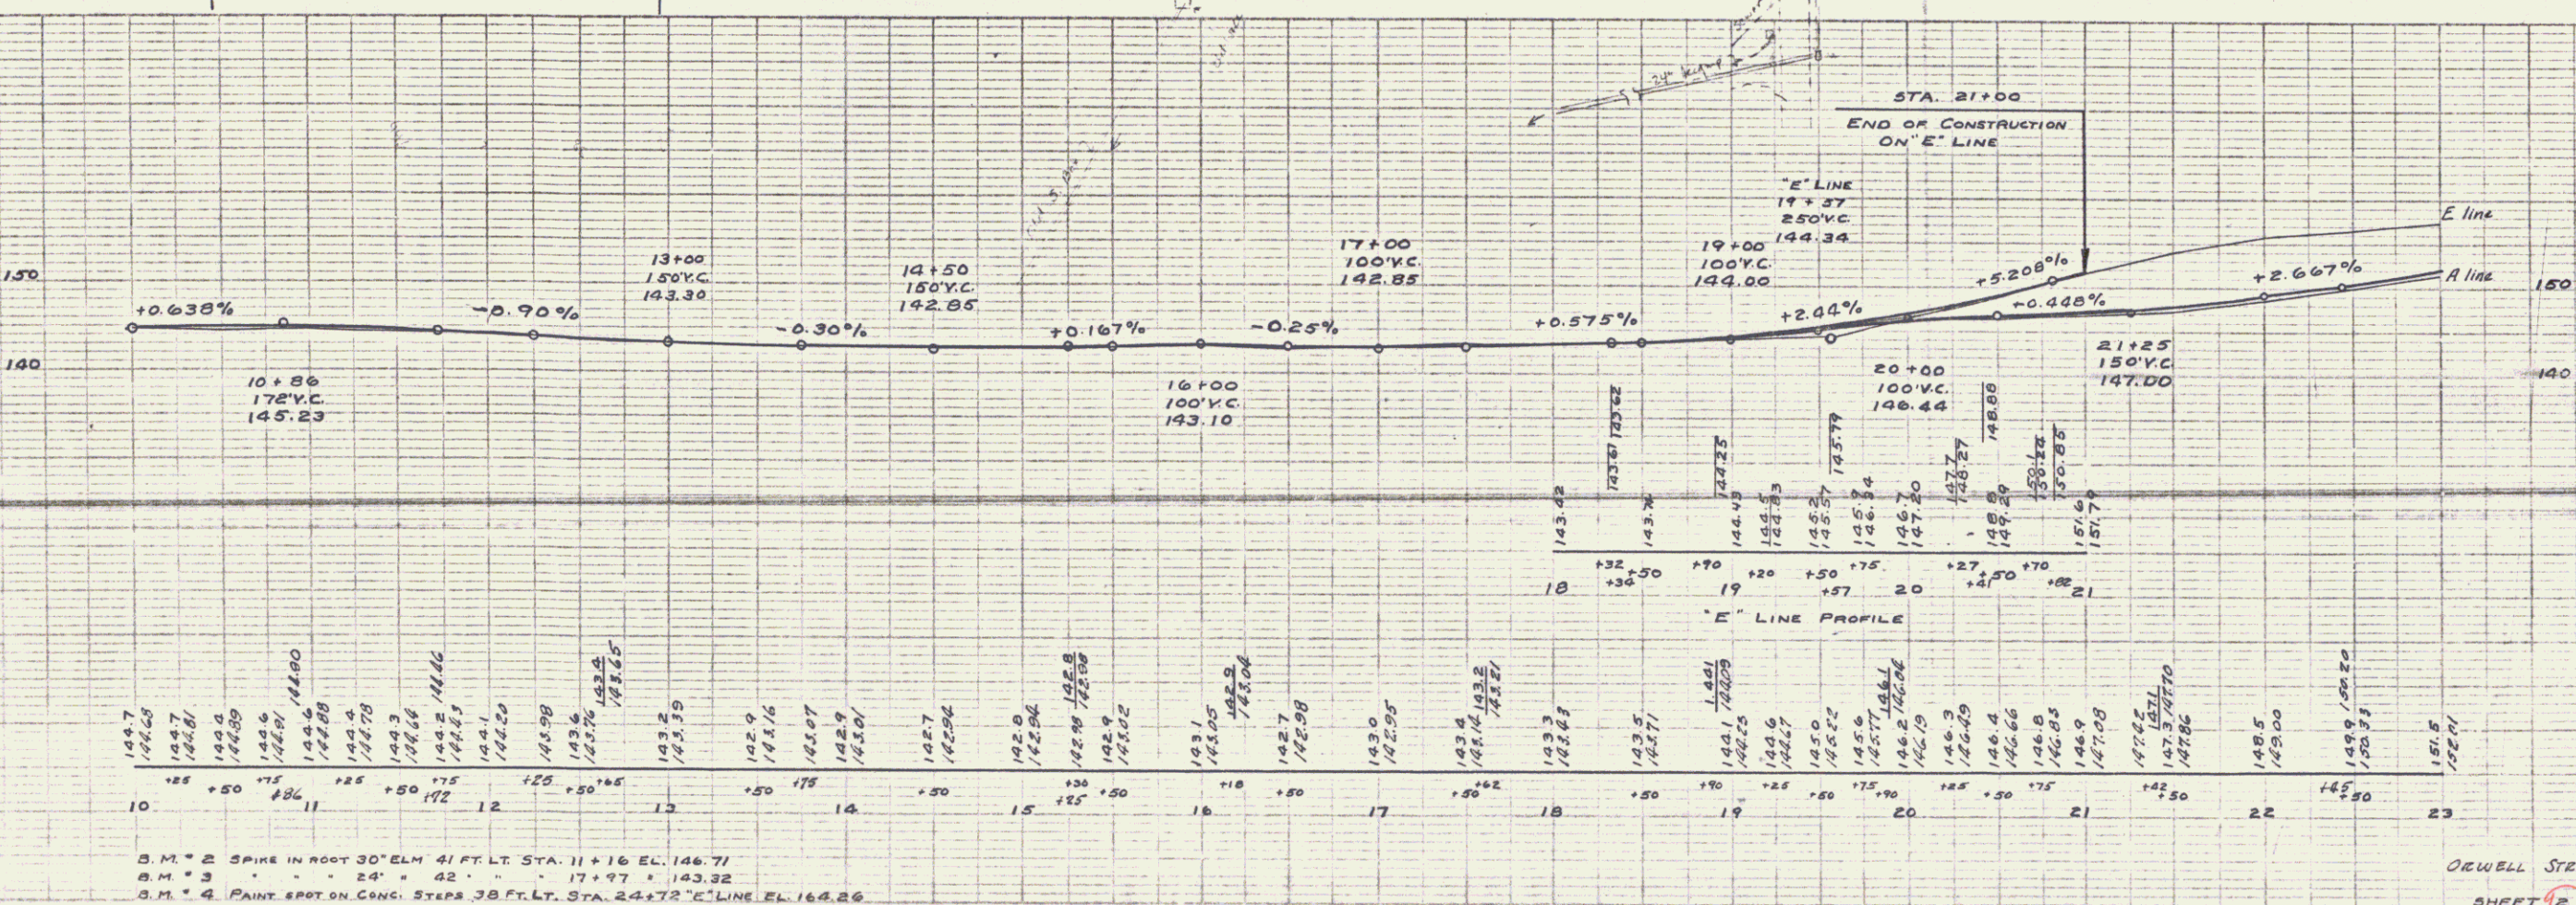


PLAN
 DATE: 6/15/78
 DRAWN BY: [illegible]
 CHECKED BY: [illegible]

DATE: 6/15/78
 DRAWN BY: [illegible]
 CHECKED BY: [illegible]

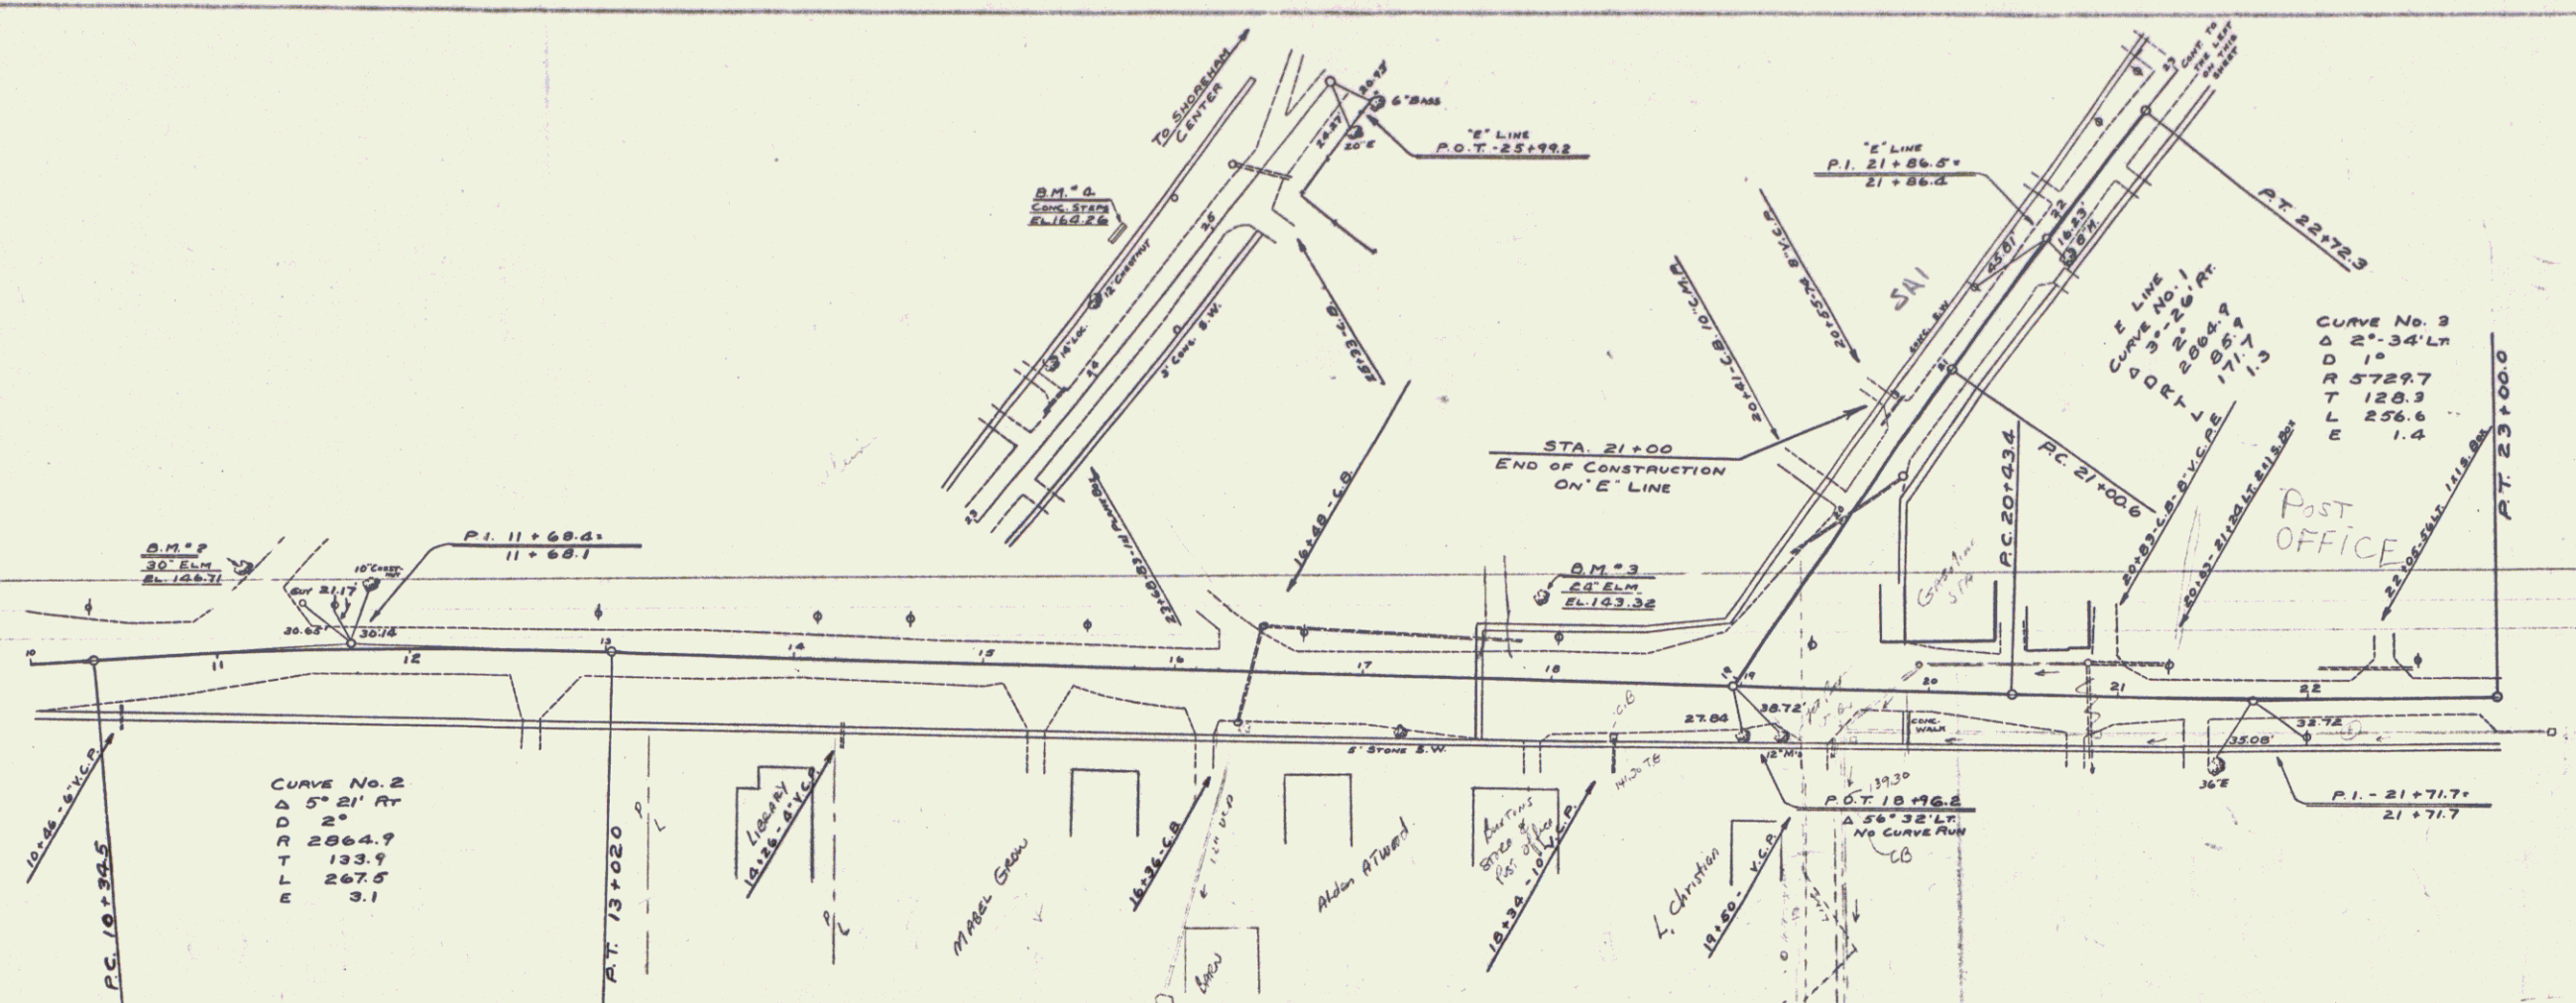

B.M. # 2 SPIKE IN ROOT 30' ELM 41 FT. LT. STA. 11+16 EL. 146.71
 B.M. # 3 " " " 24' " 42' " " 17+97 " 143.32
 B.M. # 4 PAINT SPOT ON CONC. STEPS 38 FT. LT. STA. 24+72 " E LINE EL. 146.26