
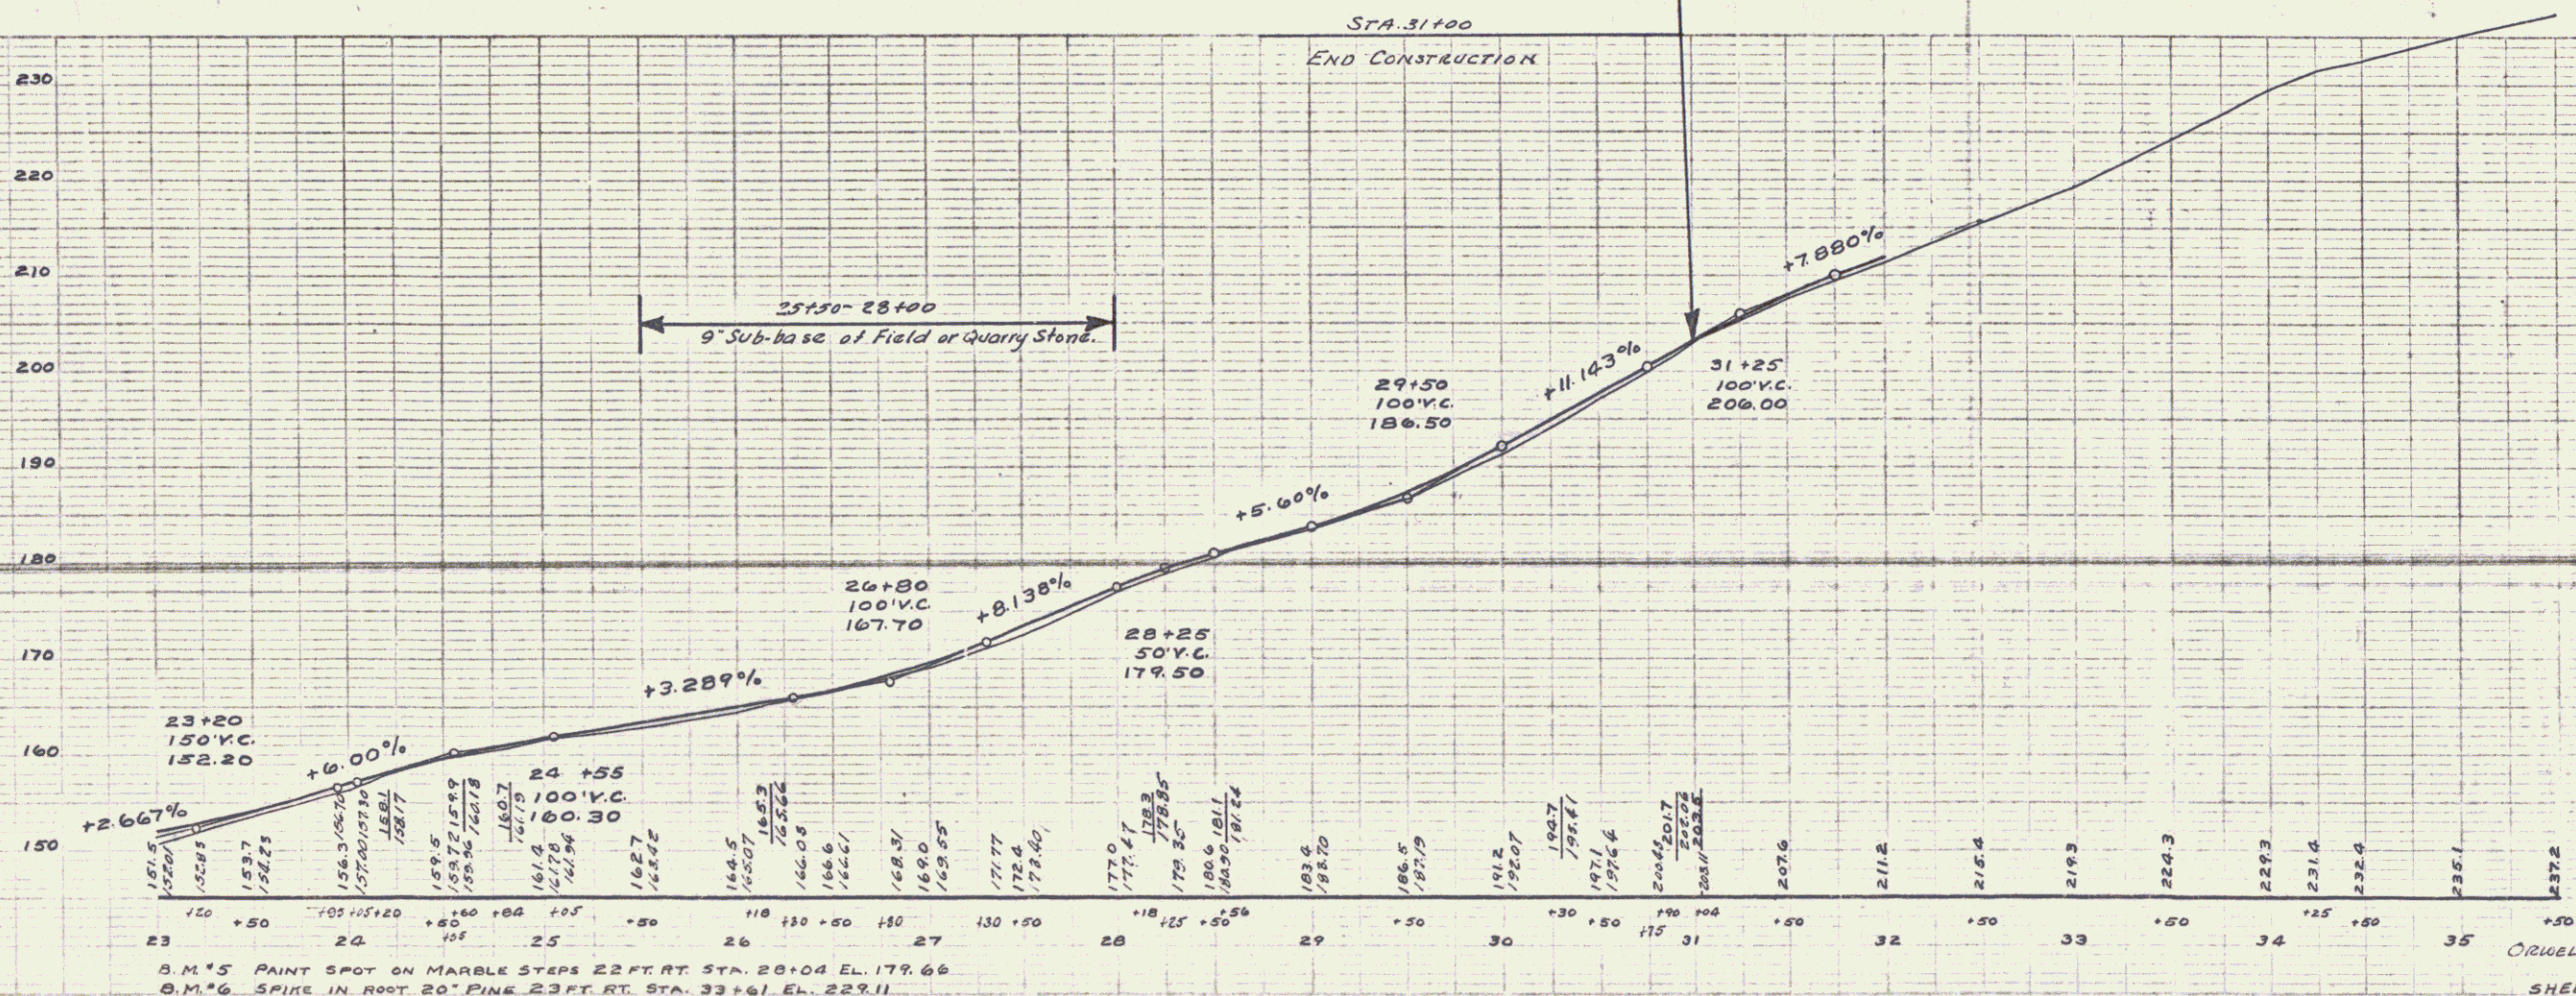


PLAN
 DATE 6/23
 DRAWN BY [illegible]
 CHECKED BY [illegible]
 NOTE: SEE ADJACENT SHEETS FOR CONTINUATION

STA. 31+00
 END CONSTRUCTION
 9" Sub-base of Field or Quarry Stone

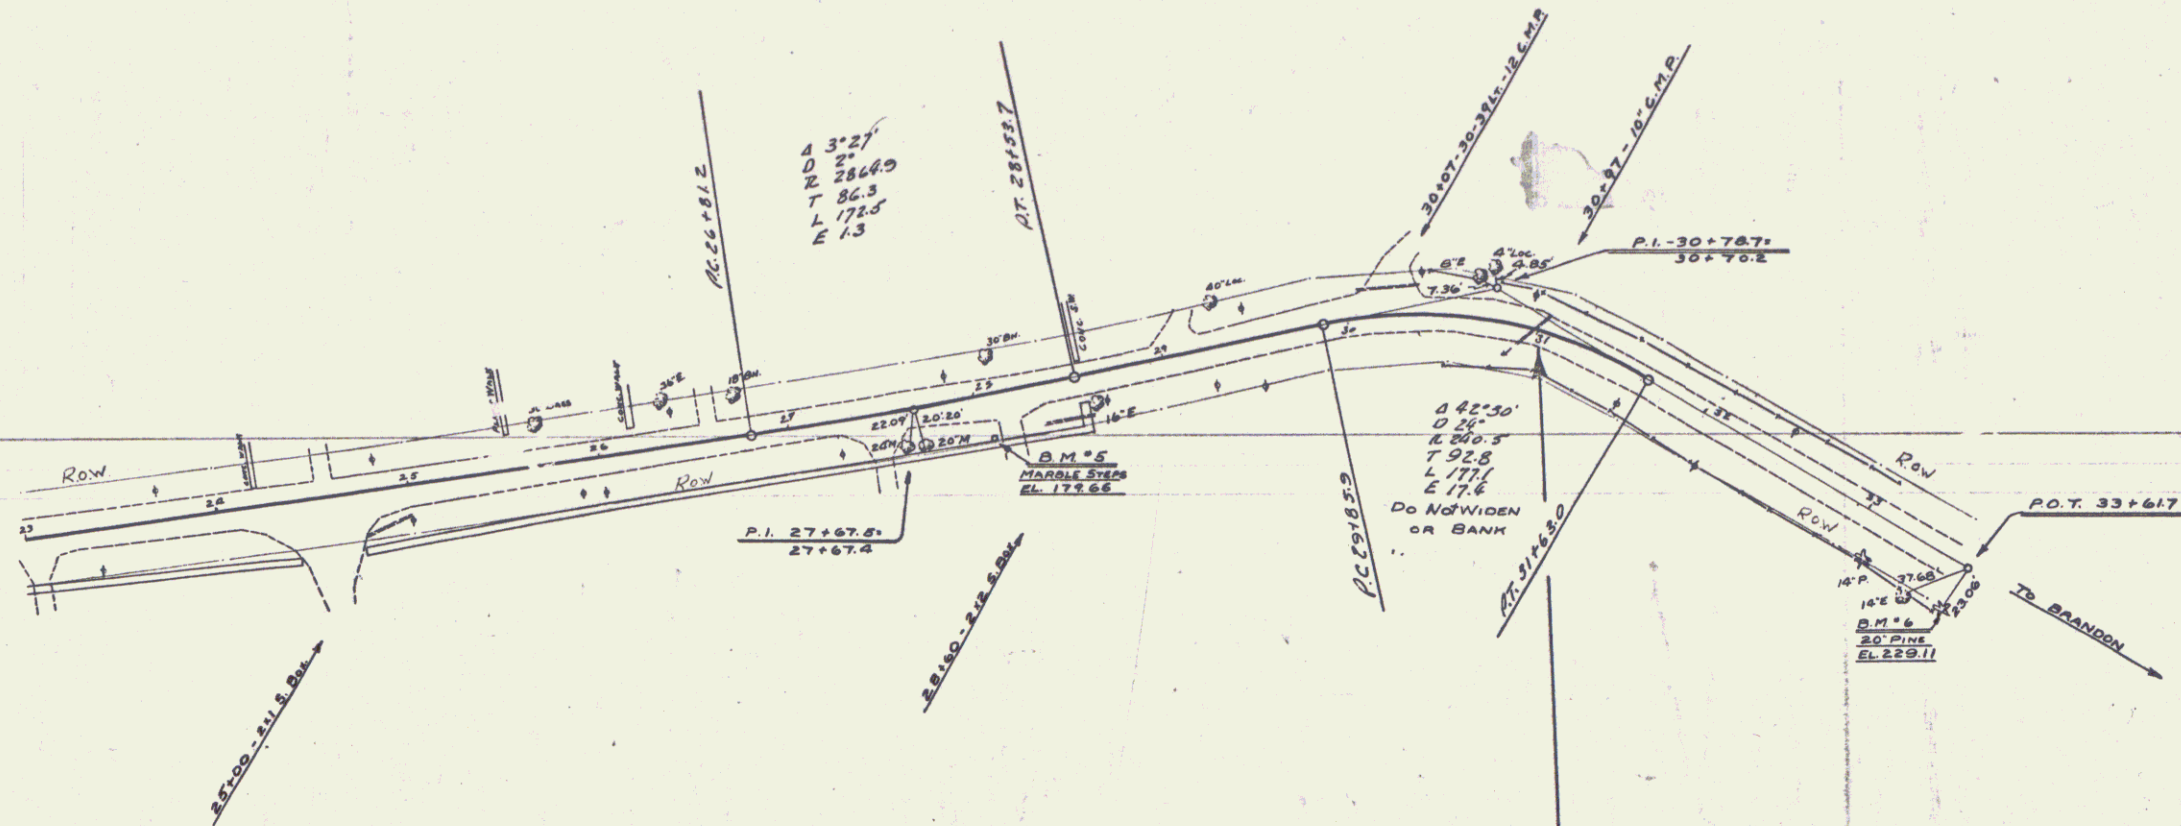

O.M.#5 PAINT SPOT ON MARBLE STEPS 22 FT. RT. STA. 28+04 EL. 179.66
 O.M.#6 SPIKE IN ROOT 20" PINE 23 FT. RT. STA. 33+61 EL. 229.11