


PLAIN GUARD RAIL LT 48+50	TWO CABLE GUARD RAIL LT 50+55-61+25 62+50-63+25 50+55-61+25 (white) 50+75-62+70	WOOD GUIDE POSTS @ 10' c/c LT 49+75-50+55 (drive)	REMOVAL AND DISPOSAL OF PRESENT GUARD RAIL LT 53+05-53+25 56+70-58+50 58+70-62+70	CONSTRUCT DRIVES LT 50+20	APPROACH 50+15 LT
---------------------------------	--	--	--	---------------------------------	----------------------

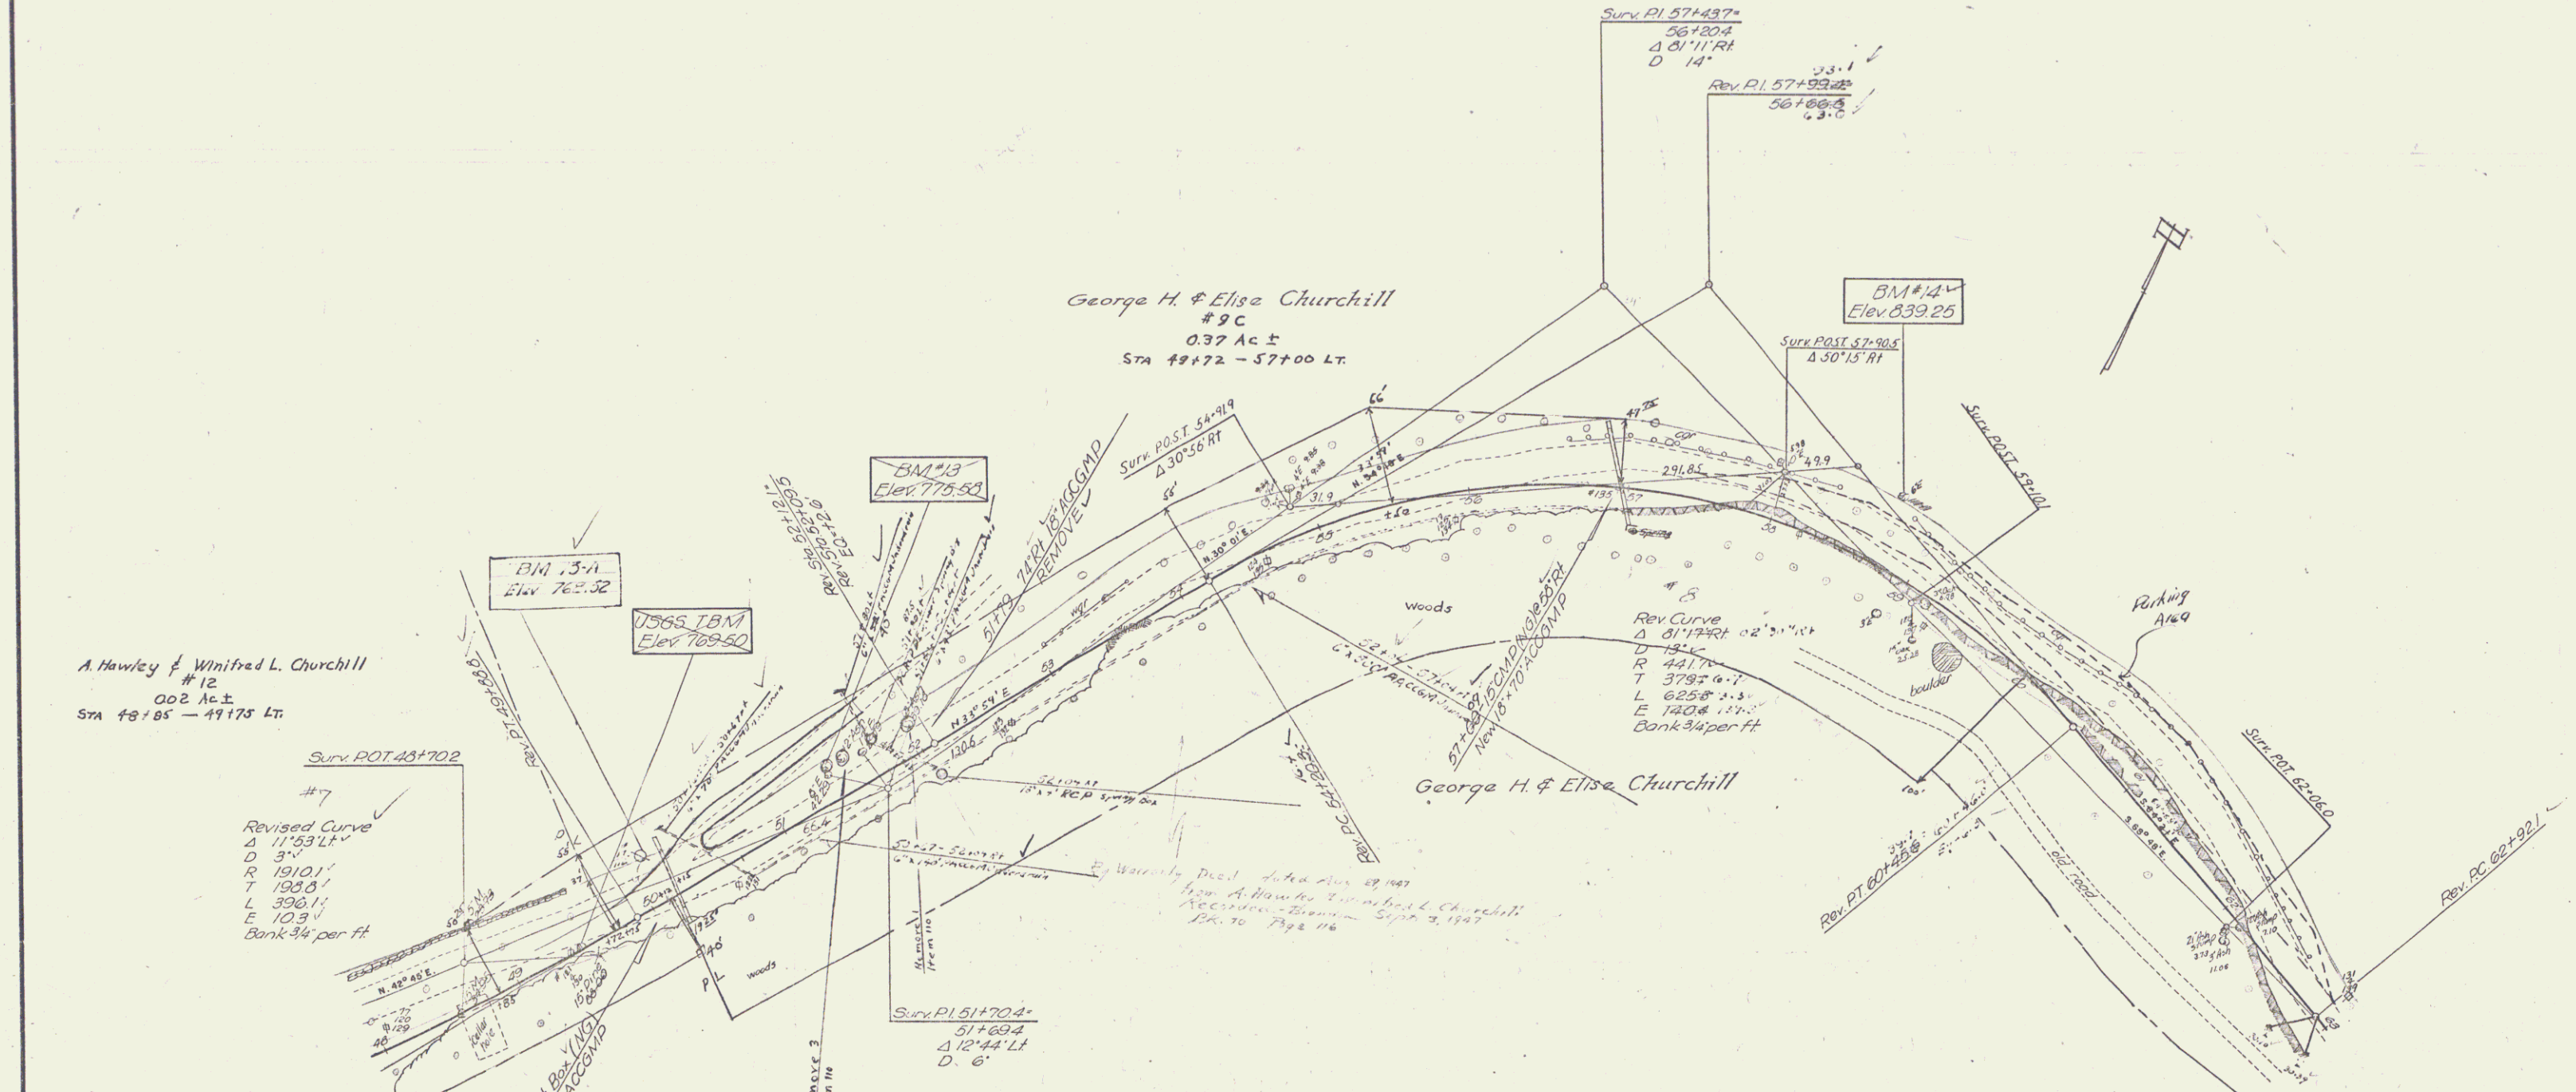

PARCEL	INSTRUMENT	DATE	GRANTOR	GRANTEE	RECORDED	BOOK	PAGE	DATE	REMARKS
12	W.D.O.E.	9-12-56	A Hawley & Winifred L. Churchill	SI of VA	Brandon	74	28	10-27-56	

BRANDON-GOSHEN
Project No. N2191 (N)
Sheet 47 of 47