


LEVY
 GOSSEN
 Standing
 1958
 TR. Gomez 5/58



LEVY
 GOSSEN
 Standing
 1958
 TR. Gomez 5/58

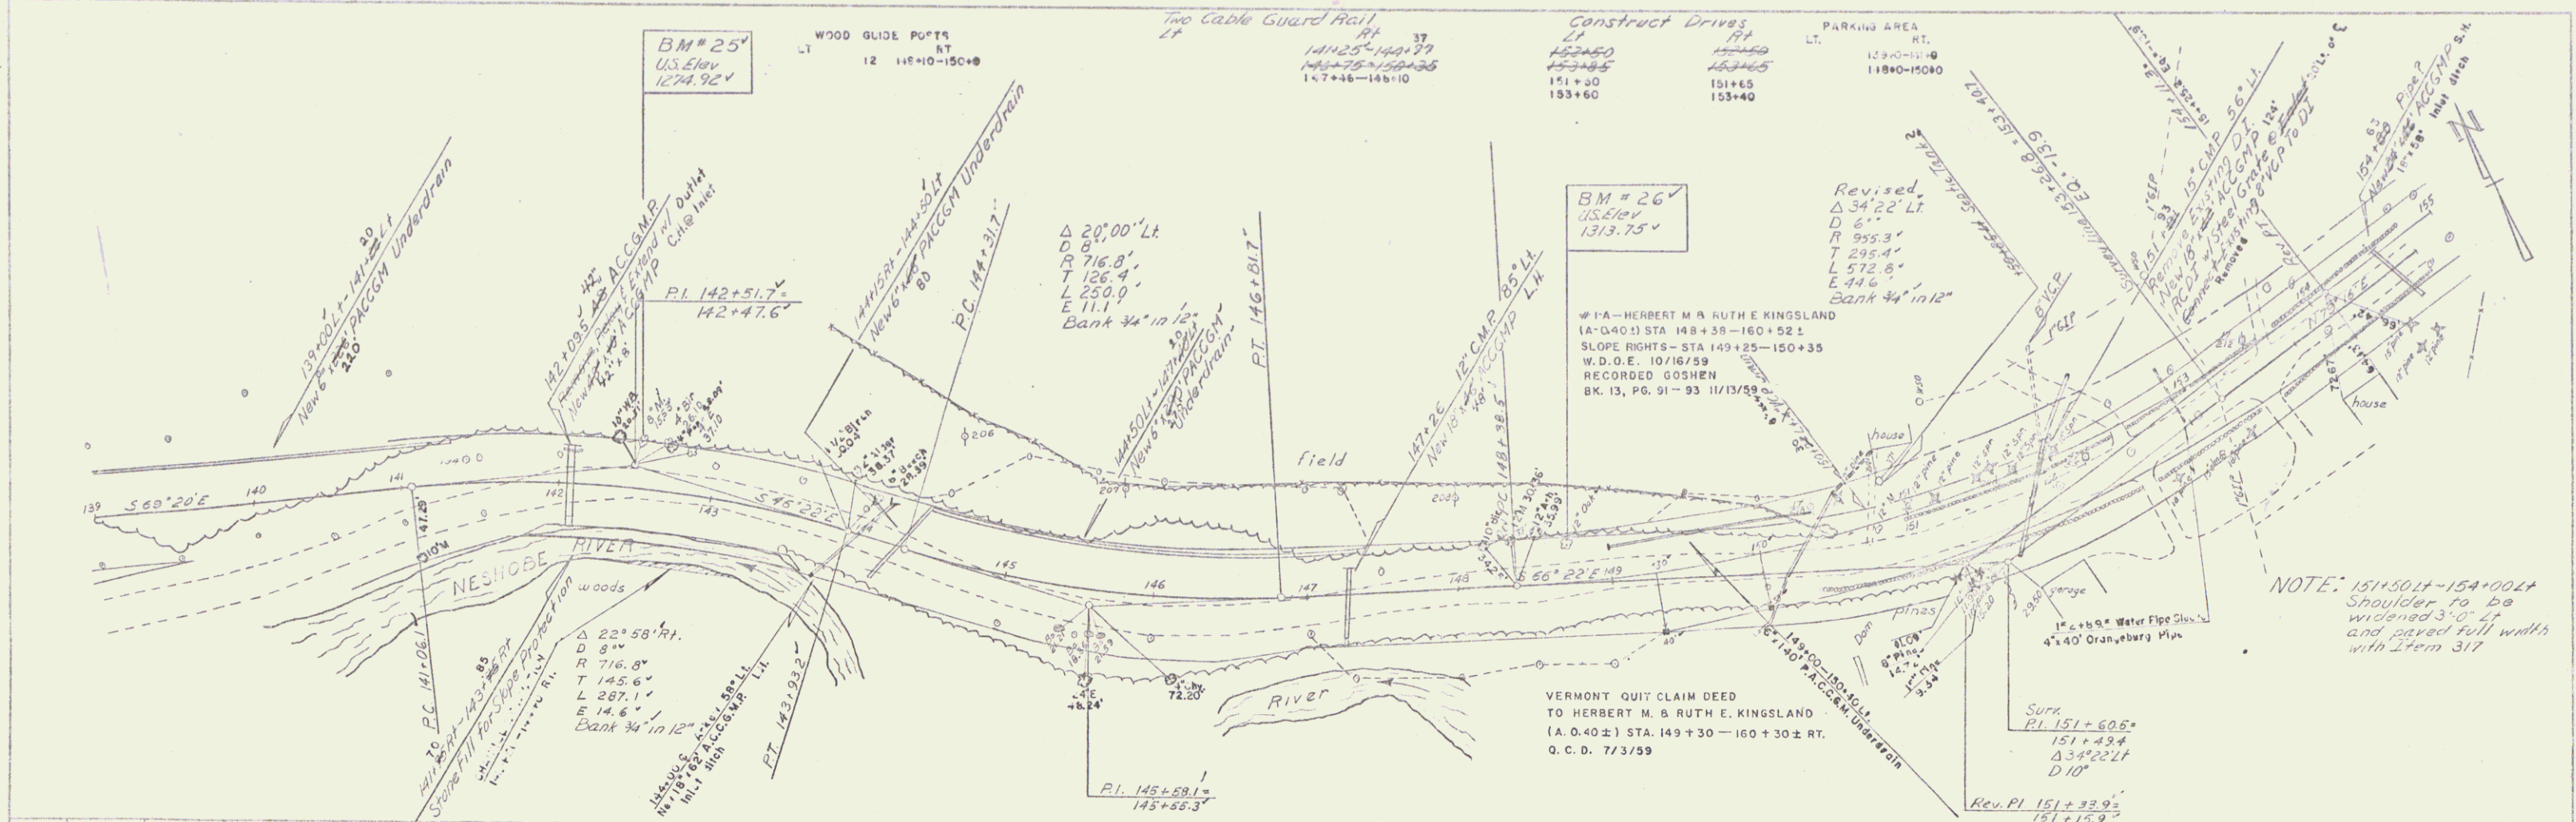