


PLAN	1:100	1:100	1:100
SECTION	1:100	1:100	1:100
DETAIL	1:100	1:100	1:100
DATE	5/13/59	5/13/59	5/13/59

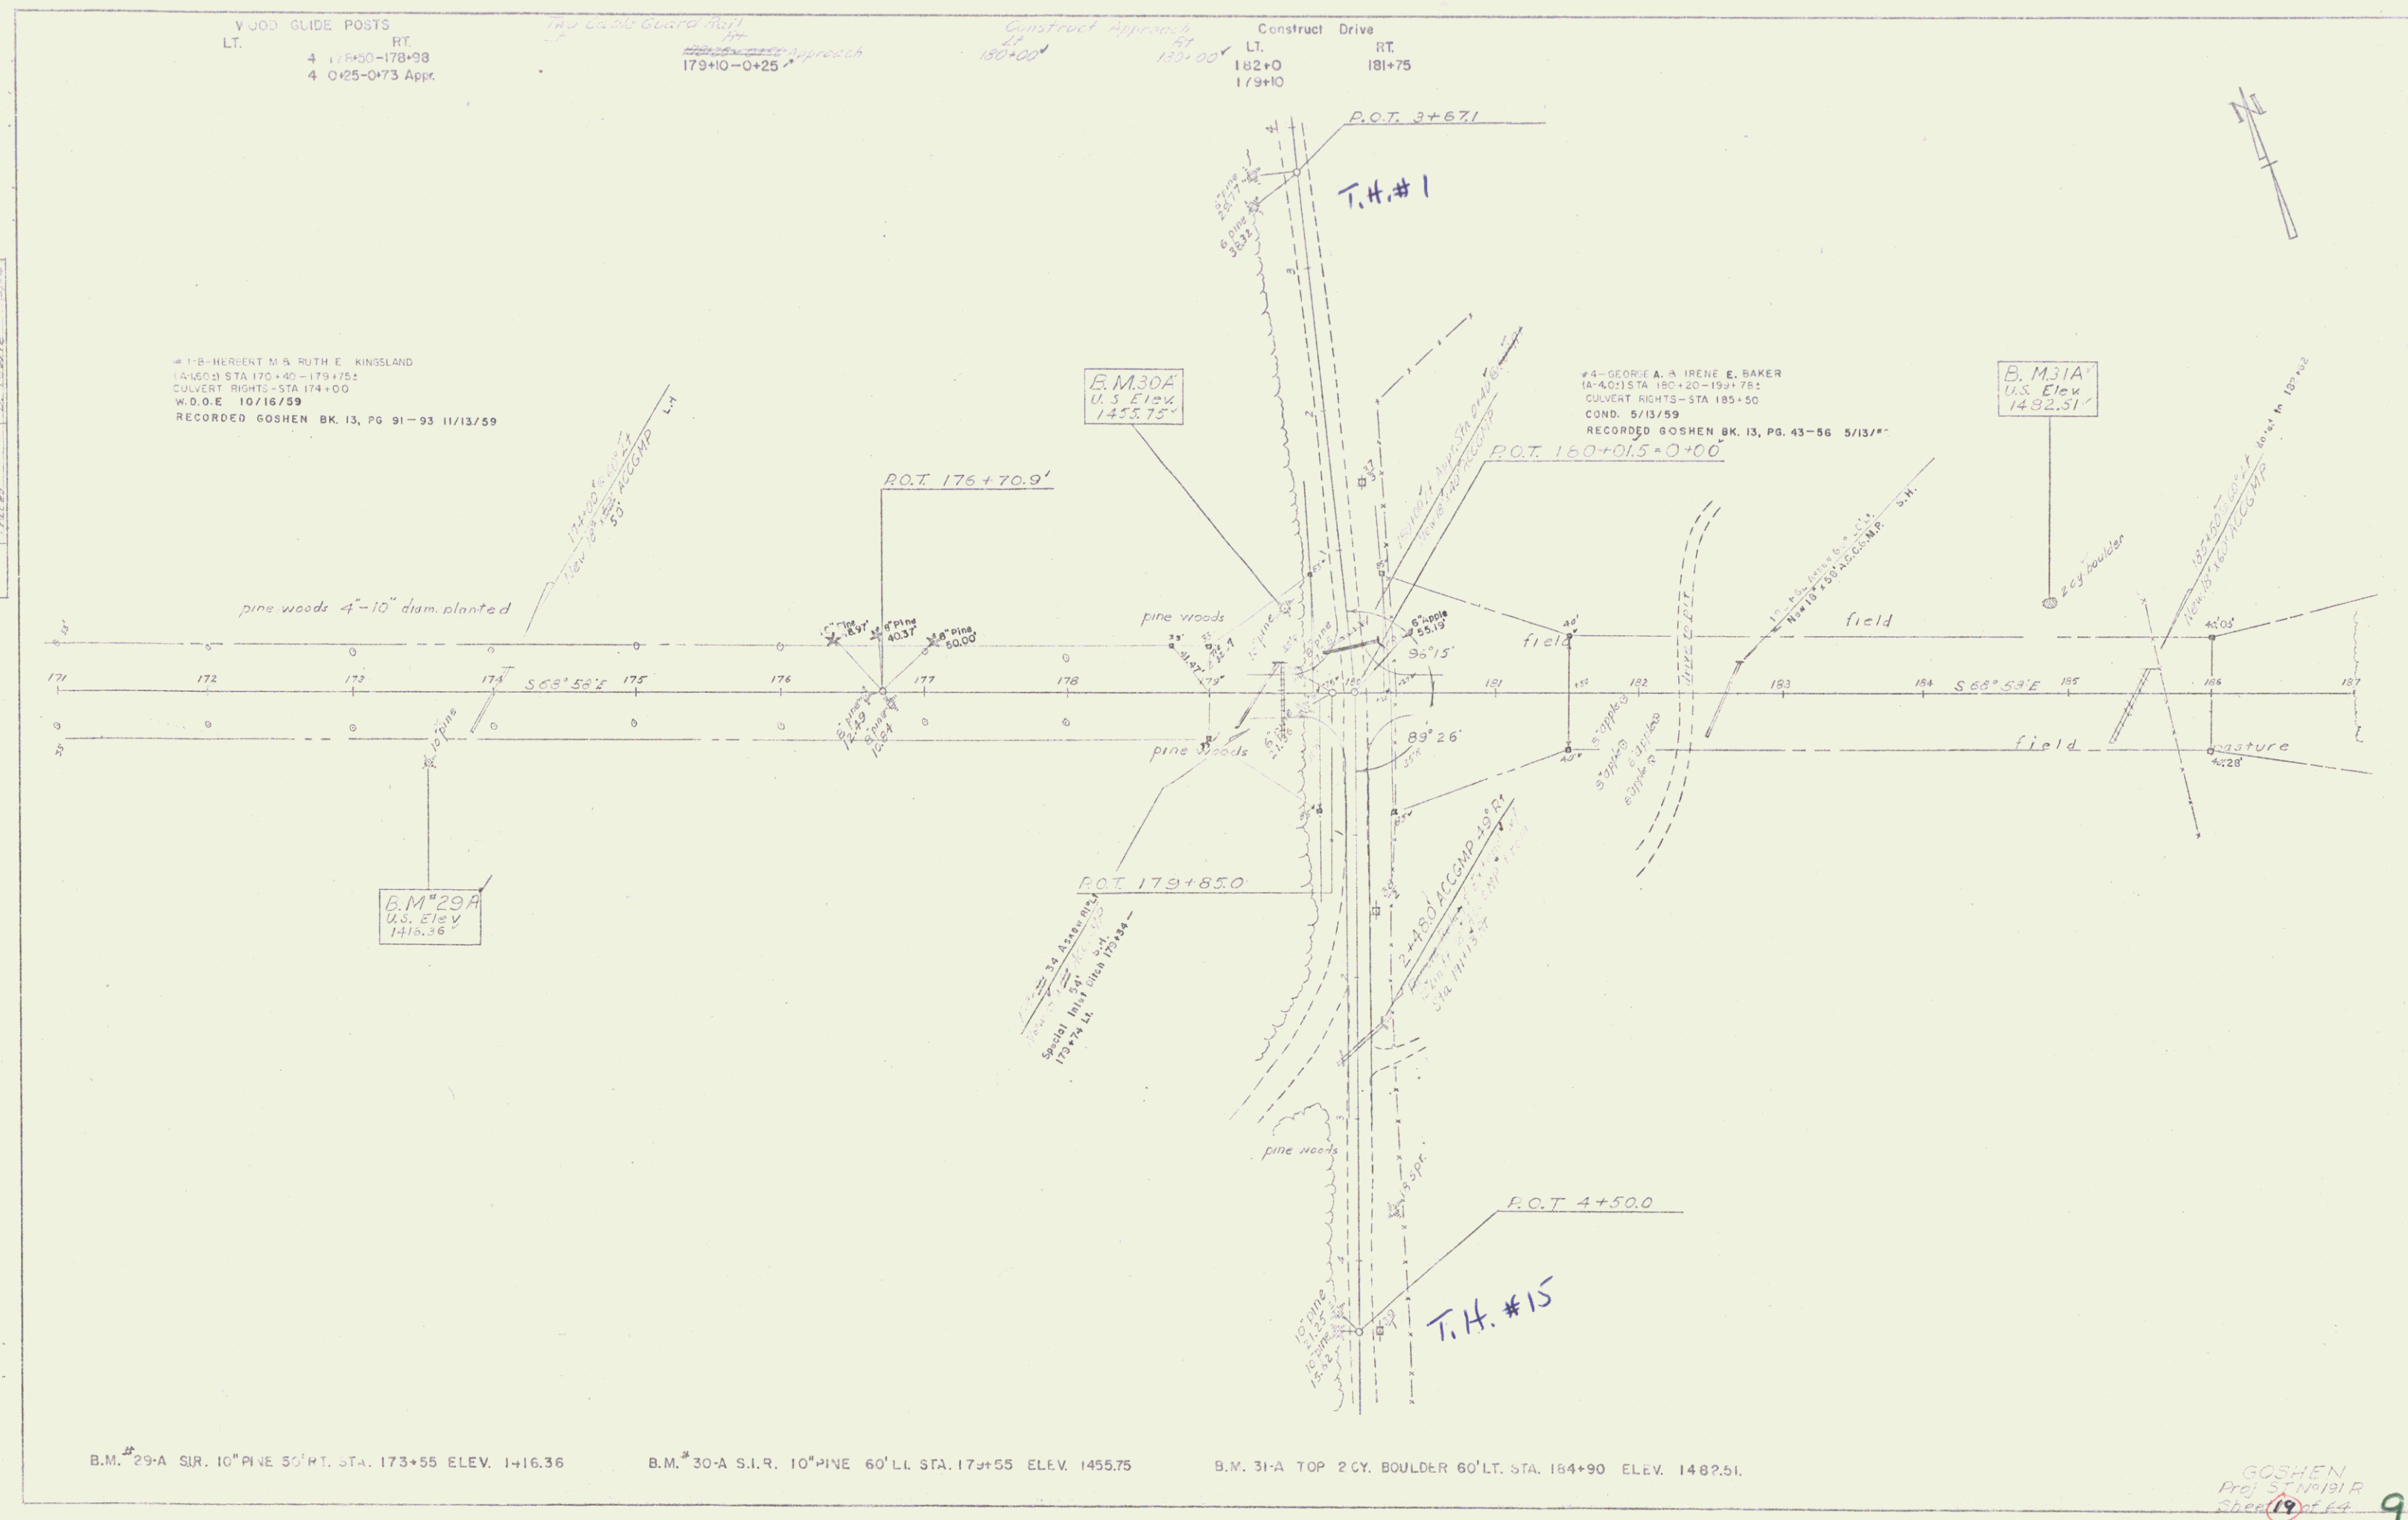

B.M. 29-A SUR. 10" PINE 50' RT. STA. 173+55 ELEV. 1416.36

B.M. 30-A S.I.R. 10" PINE 60' LL STA. 179+55 ELEV. 1455.75

B.M. 31-A TOP 2 CY. BOULDER 60' LT. STA. 184+90 ELEV. 1482.51.

GOSHEN
 Proj. 5/13/59 R
 Sheet 19 of 64 **9**