

DATE: 3/22/23
 BY: L. M. M. / J. C. C.
 CHECKED: J. C. C.
 NO.:

DATE: 12/27/22
 BY: J. M. M. / J. M. M.
 CHECKED: J. M. M.
 NO.:

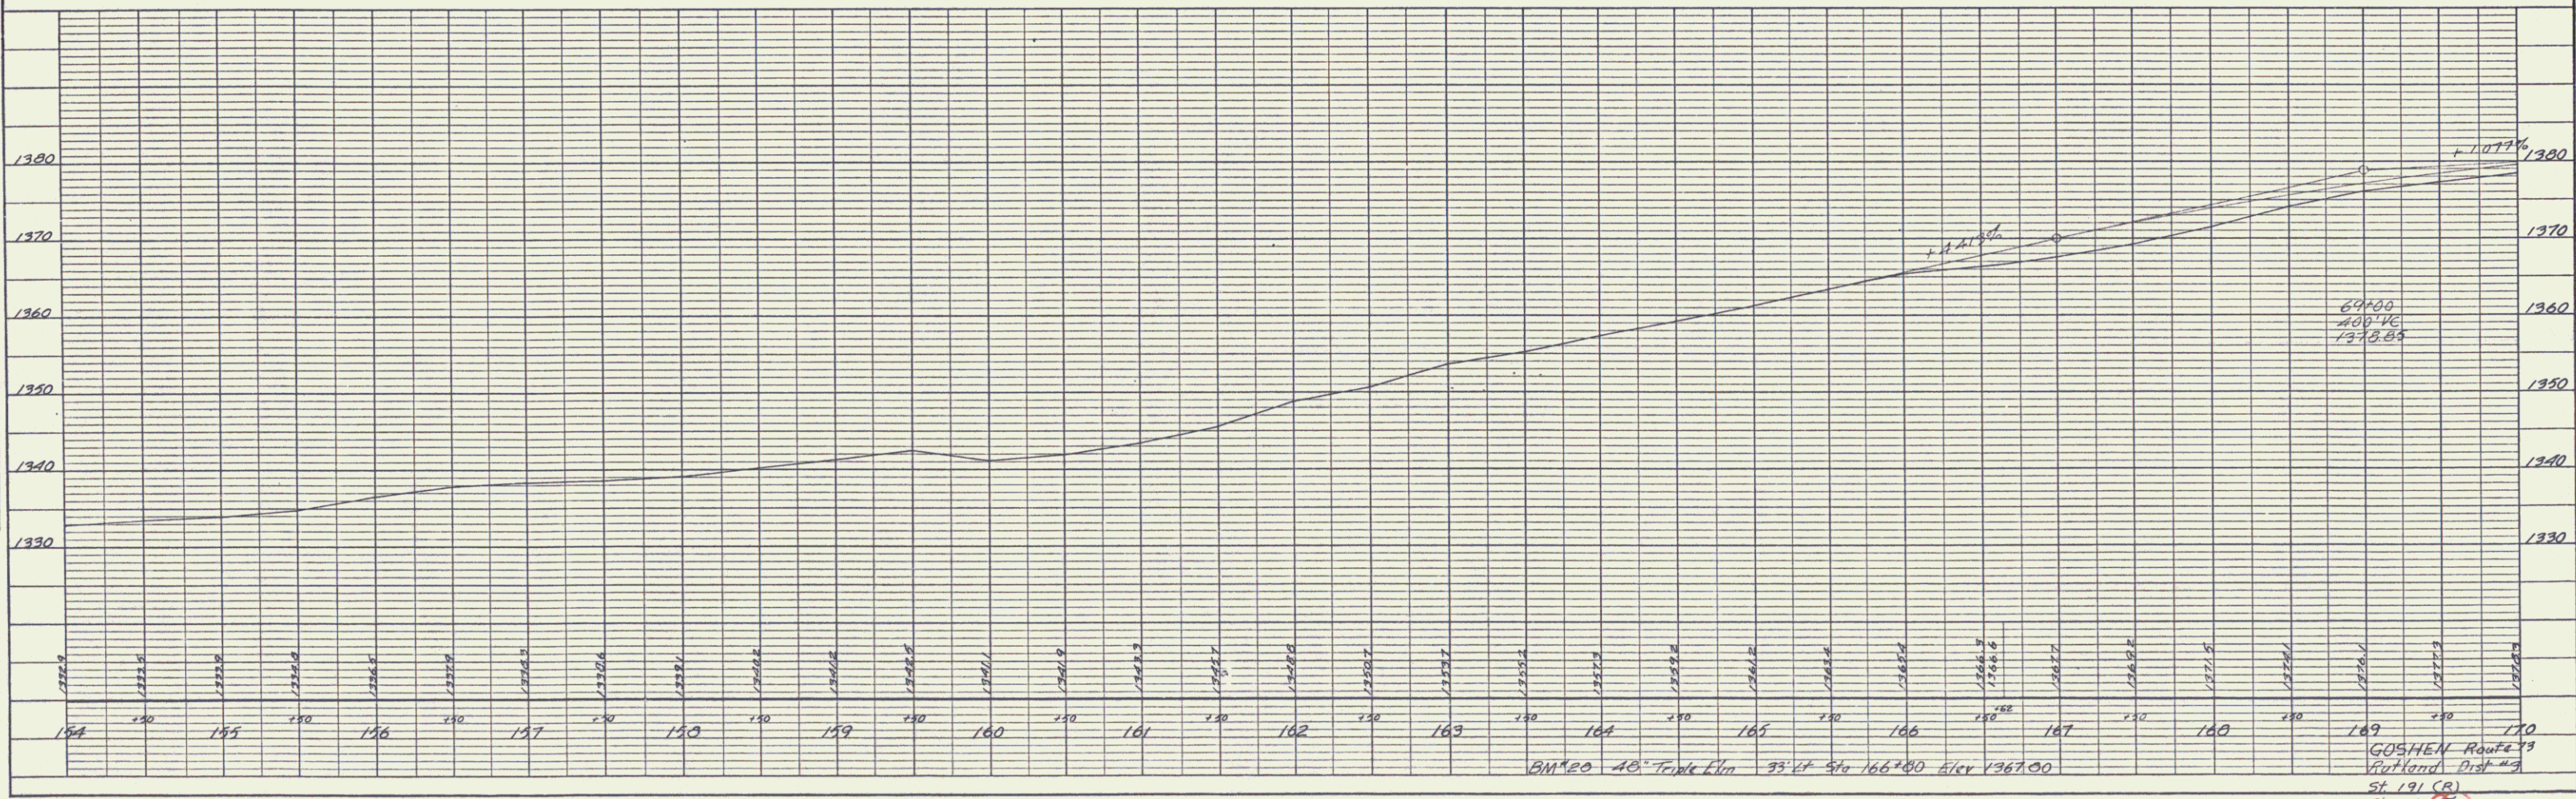
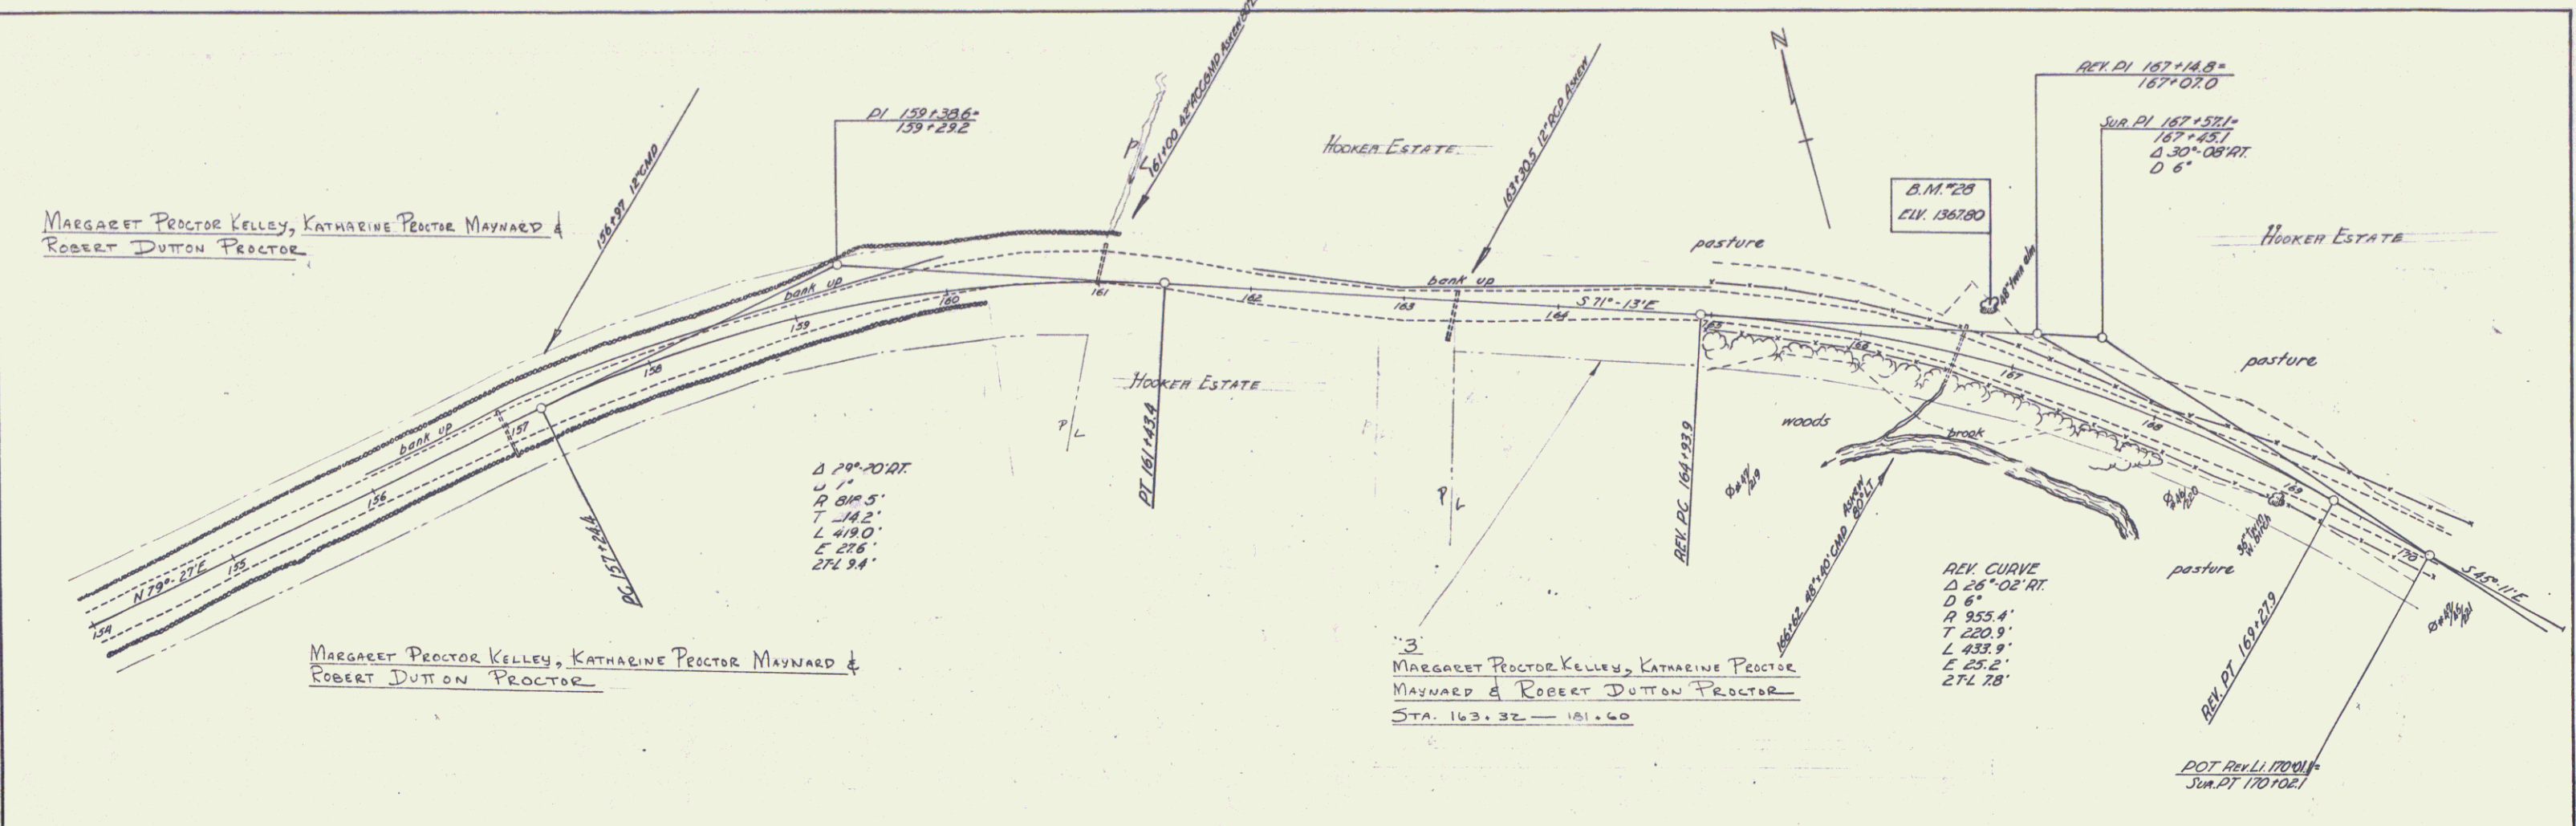


PLATE 1 - PLAN - PROFILE - D.P.R.A.E. STANDARD
 KEUFFEL & ESSIG CO., NEW YORK
 K & E CO. NO. 345-7

GOSHEN Route 49
 Station 169.229
 Sheet 5