
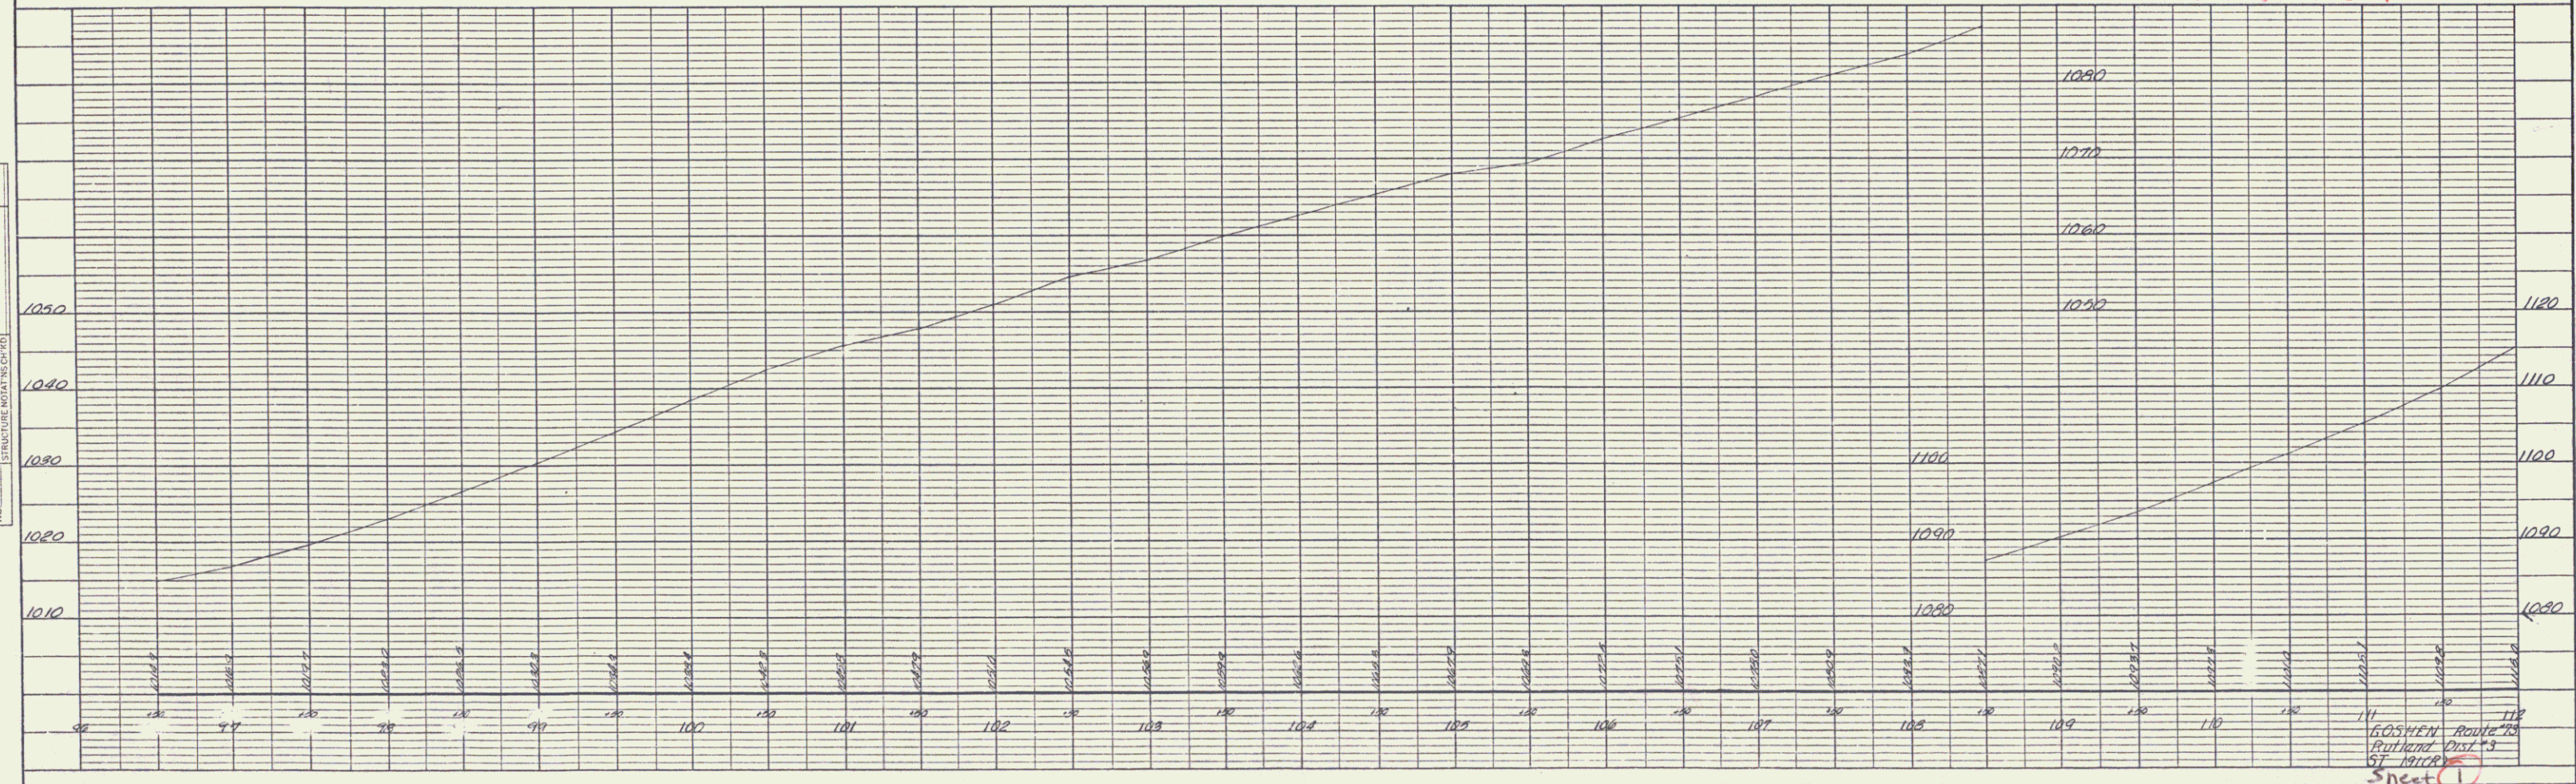


PLAN  
 SURVEYED BY  
 PLOTTED BY  
 CHECKED BY  
 DATE

PROFILE  
 SURVEYED BY  
 PLOTTED BY  
 CHECKED BY  
 DATE

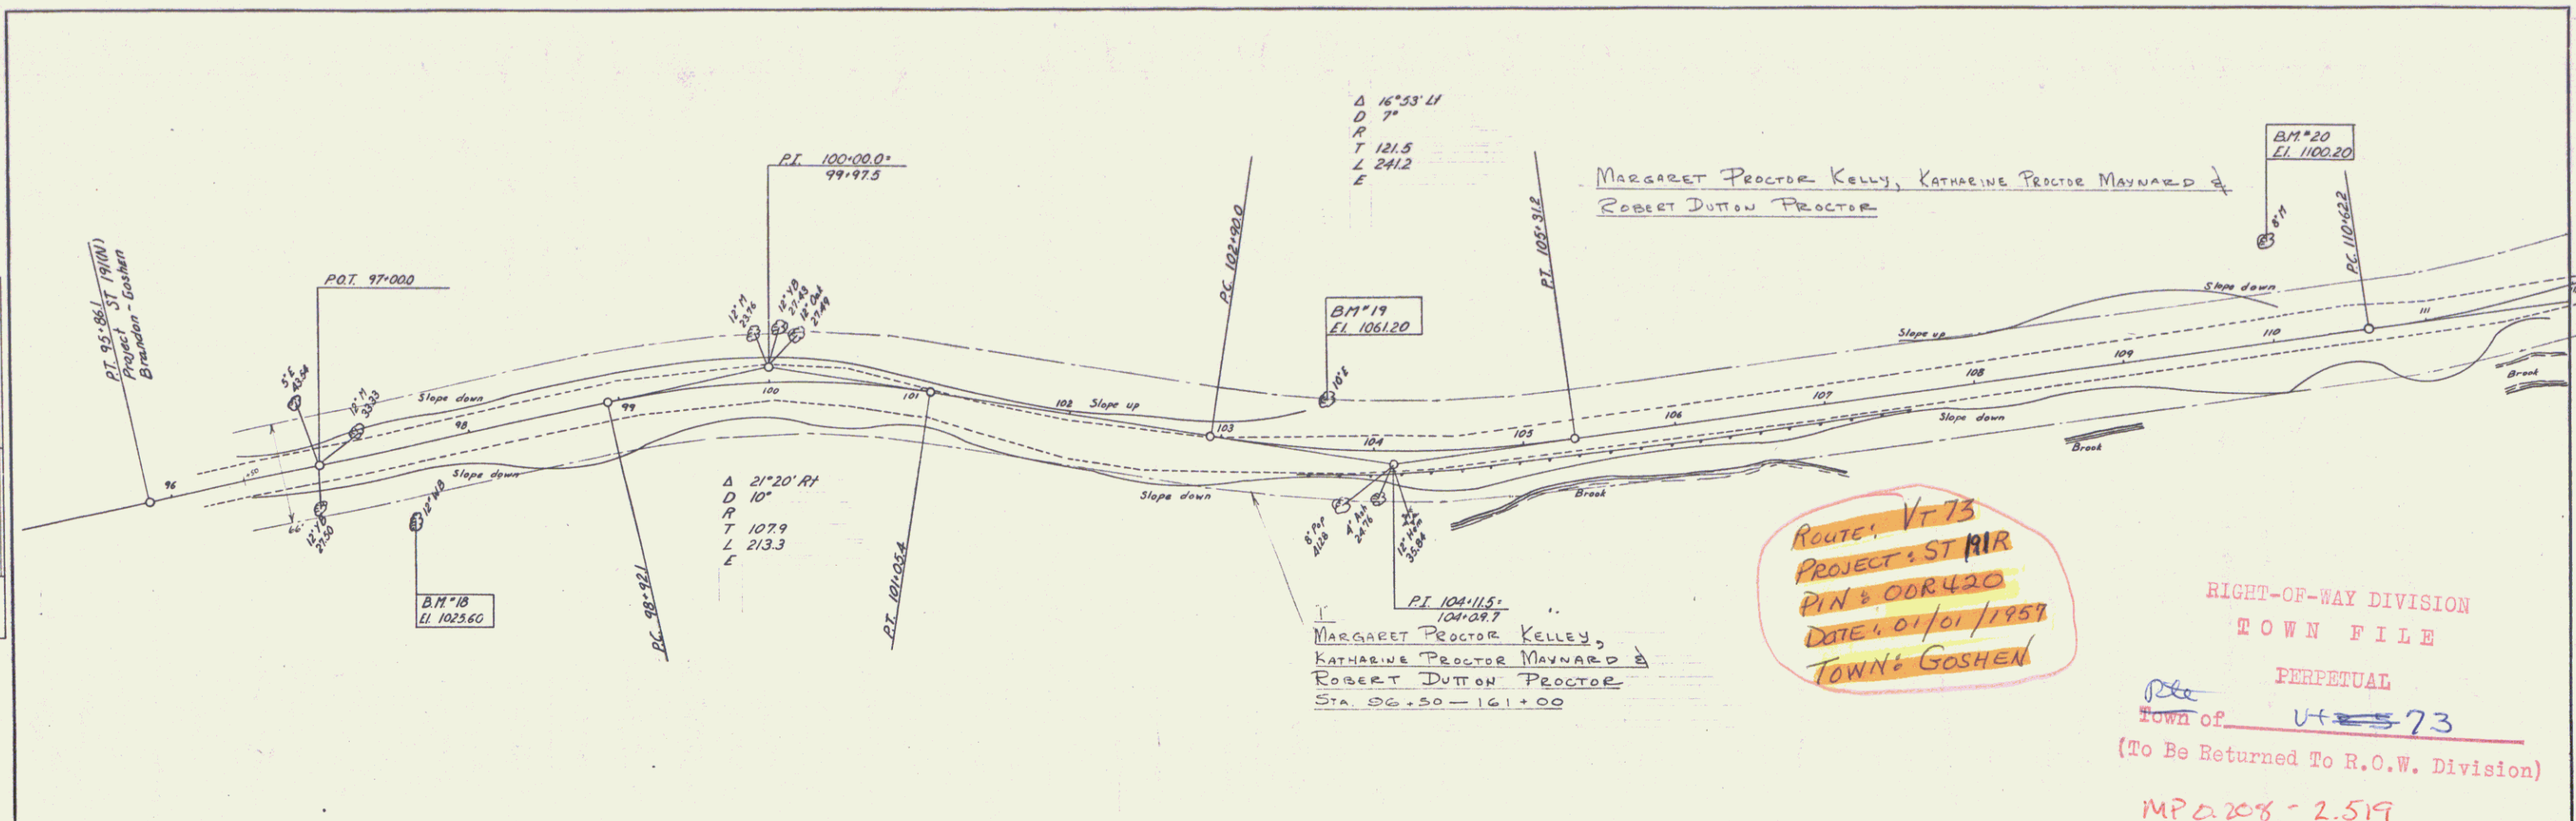

PLAN	DATE
NO.	
BY	
REVISIONS	
IN CUTTING	
NOTE BOOK	
NO. OF WAY CHECKED	
NO.	

PROFILE	DATE
NO.	
BY	
REVISIONS	
IN CUTTING	
NOTE BOOK	
NO. OF WAY CHECKED	
NO.	

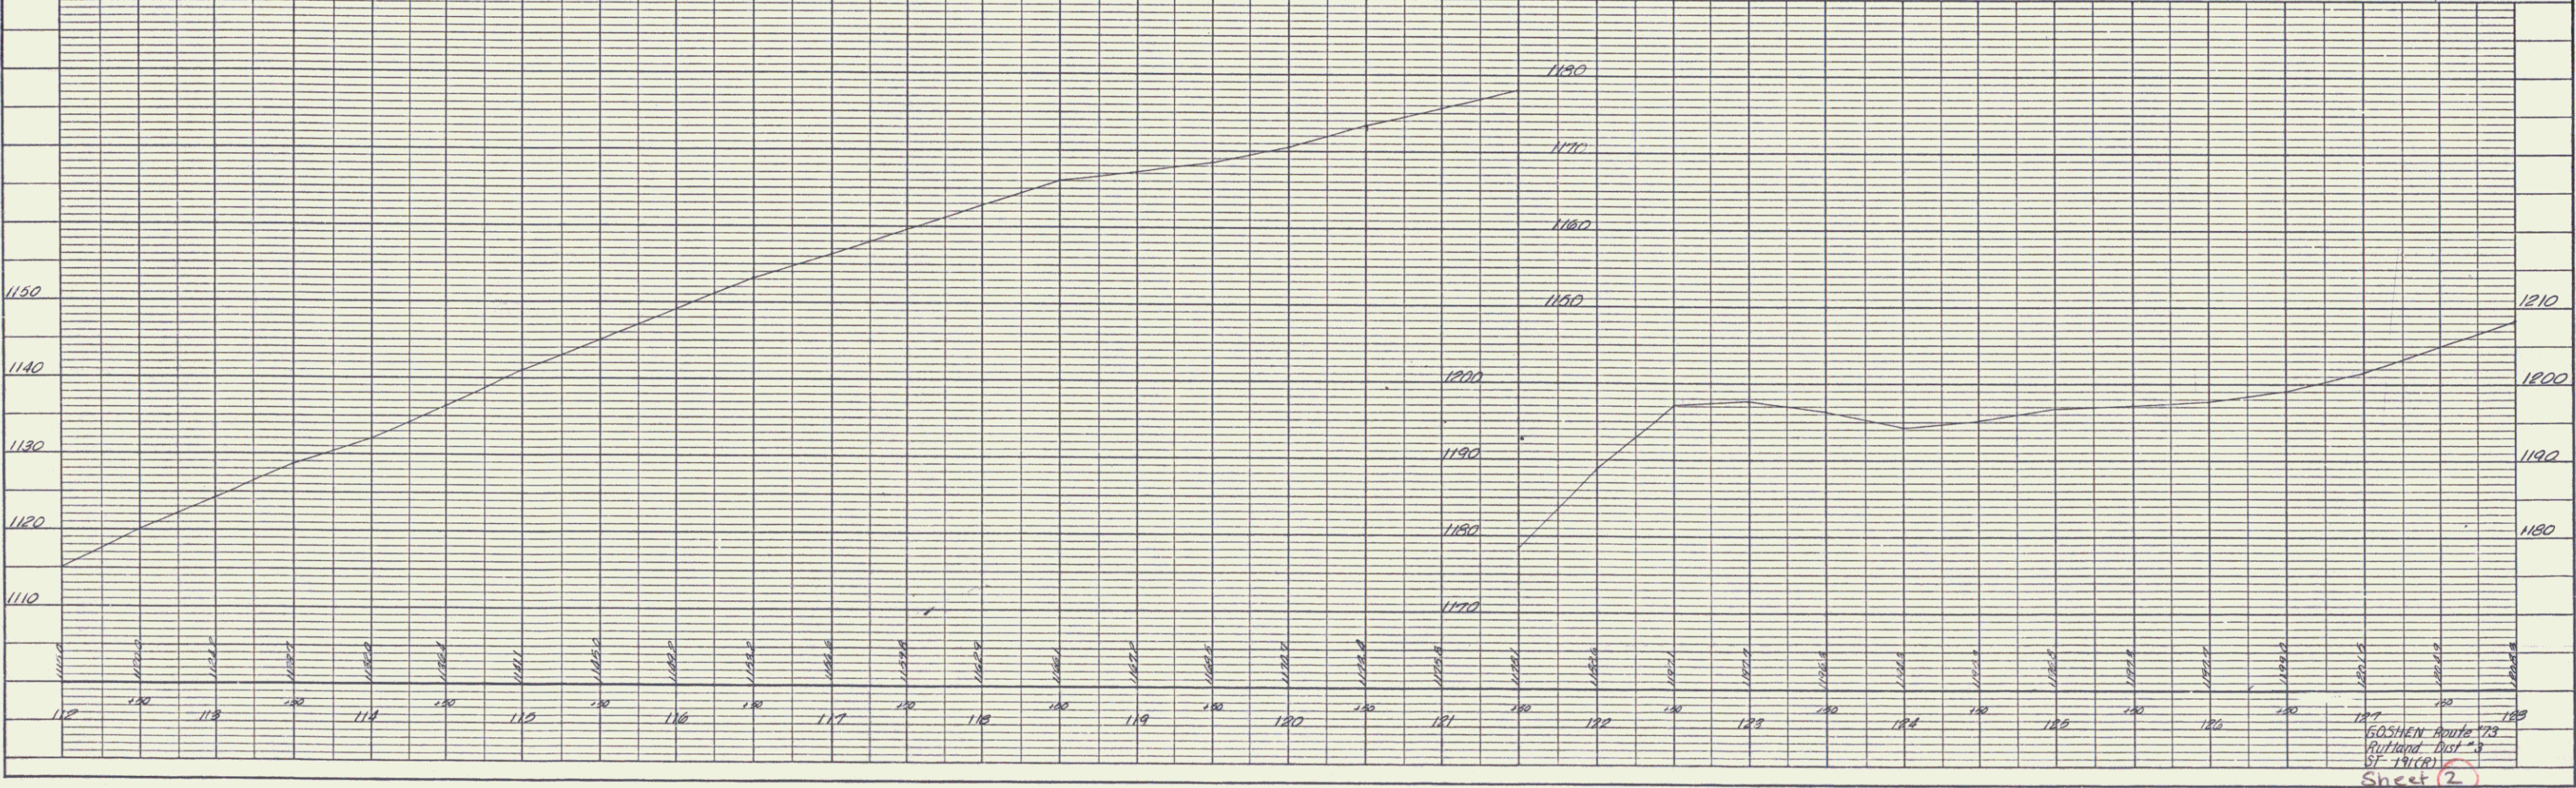
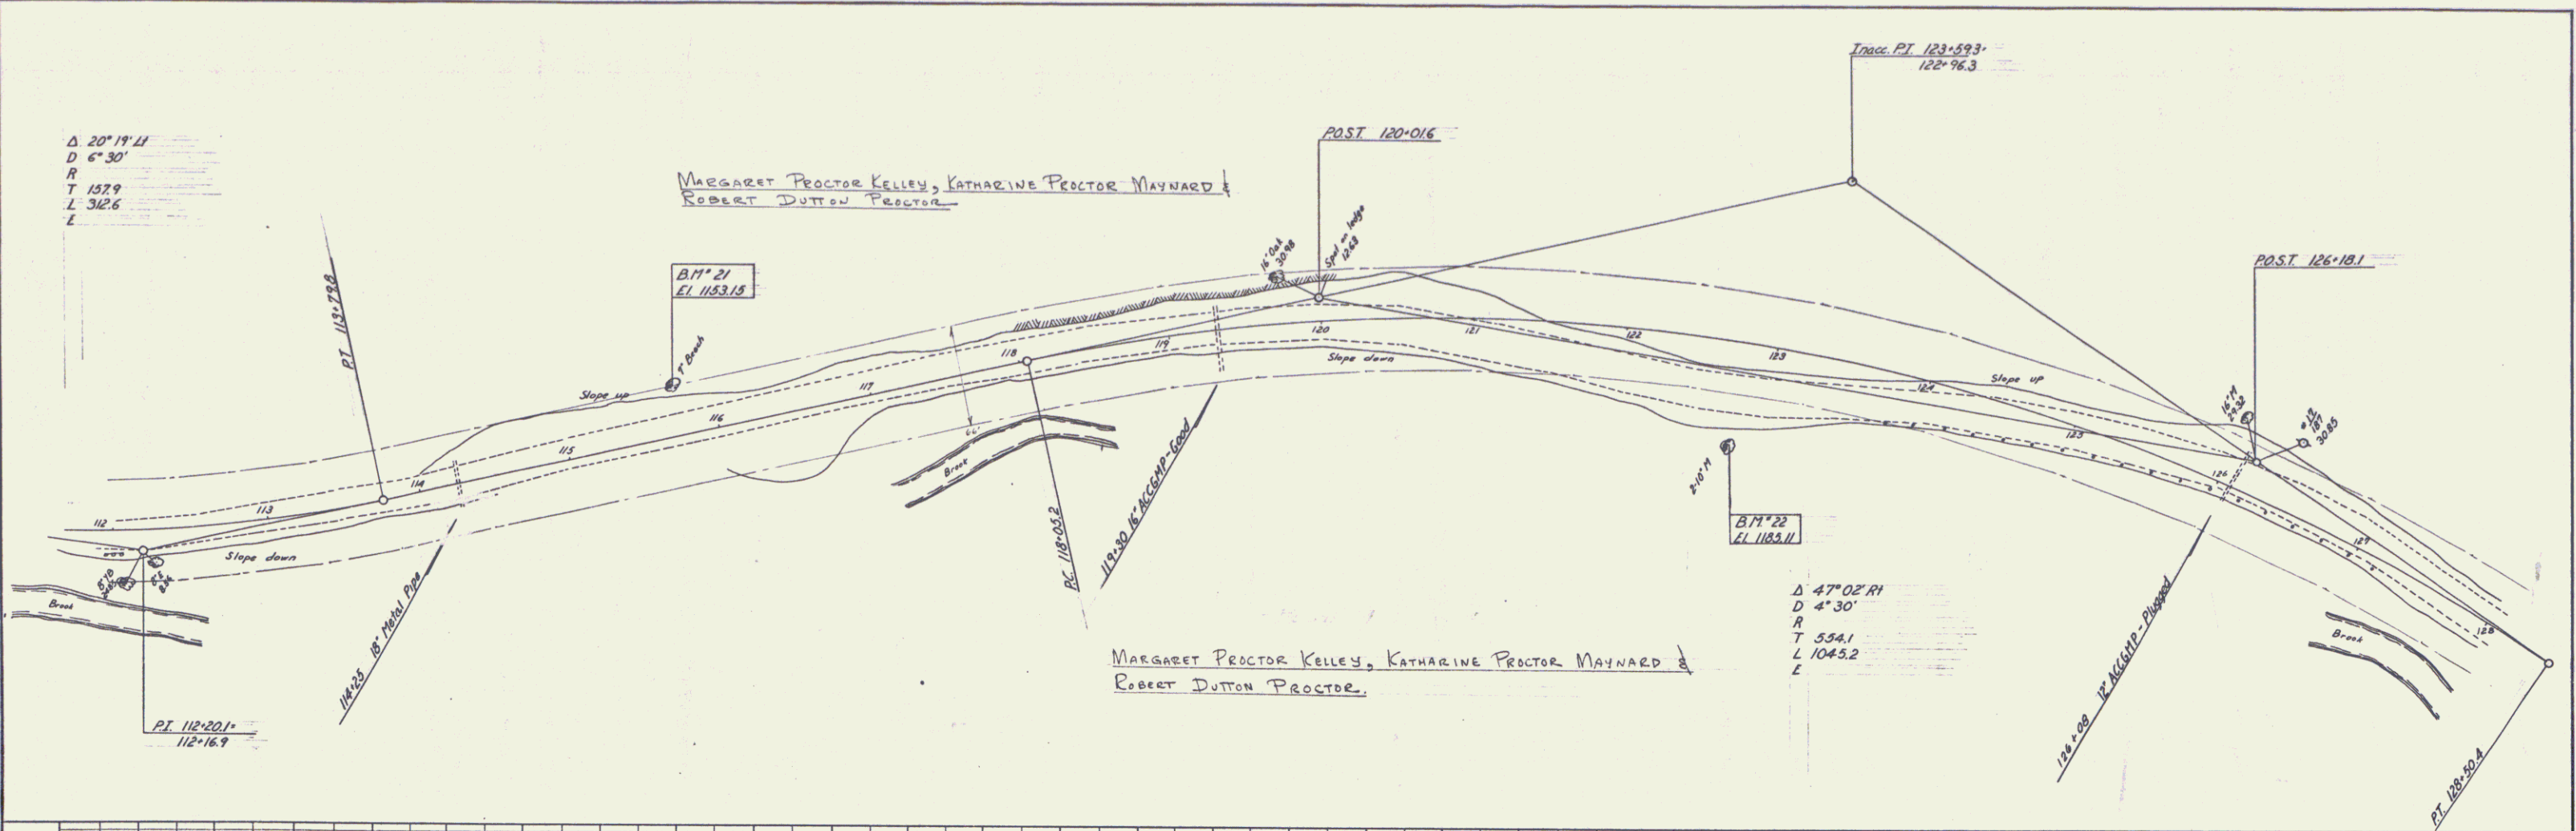


PLATE I - PLAN PROFILE - P.E. & S. STANDARD  
 KUFFEL & ESSER CO., NEW YORK.  
 K & E CO. NO. 348-1

GOSHEN Route 173  
 Rutland Dist. 3  
 ST. ALBANS  
 Sheet 2


PLAN  
 SURVEYED BY  
 DATE  
 NOTE BOOK NO.  
 ALIGNMENT CHECKED BY  
 FT. OF WAY CHECKED BY

PROFILE  
 SURVEYED BY  
 DATE  
 NOTE BOOK NO.  
 IN S. S. NOTED BY  
 STRUCTURE NOTED BY


Δ 8°10'11  
 D 4'  
 R  
 T 1023  
 L 2042  
 E

MARGARET PROCTOR KELLEY, KATHARINE PROCTOR MAYNARD &  
 ROBERT DUTTON PROCTOR

Δ 13°44'11  
 D 5'  
 R  
 T 1390  
 L 2747  
 E

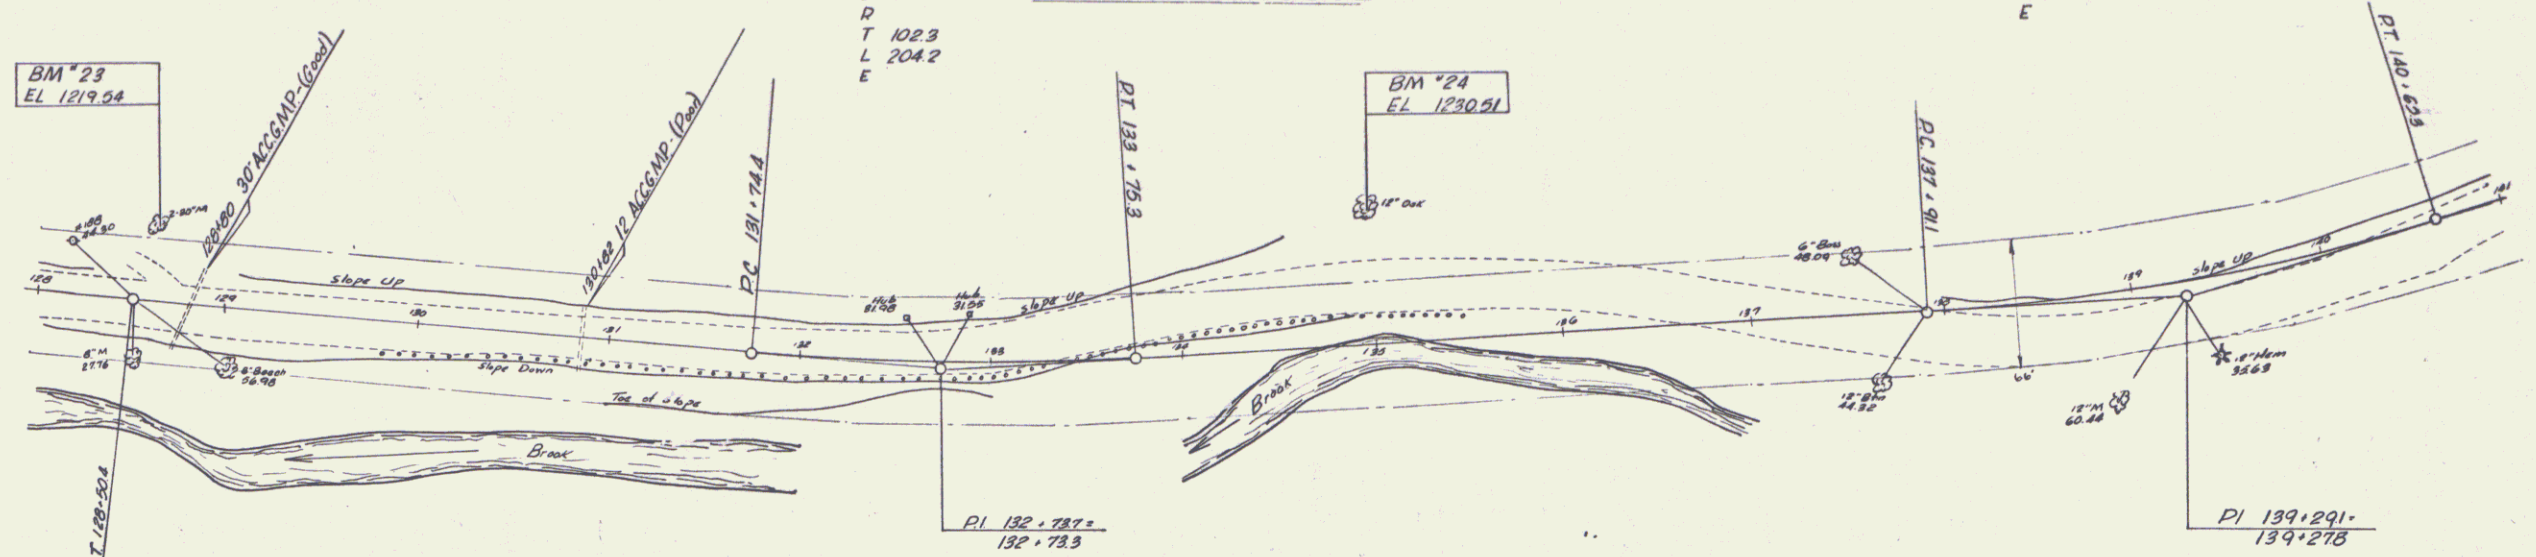

MARGARET PROCTOR KELLEY, KATHARINE PROCTOR MAYNARD &  
 ROBERT DUTTON PROCTOR

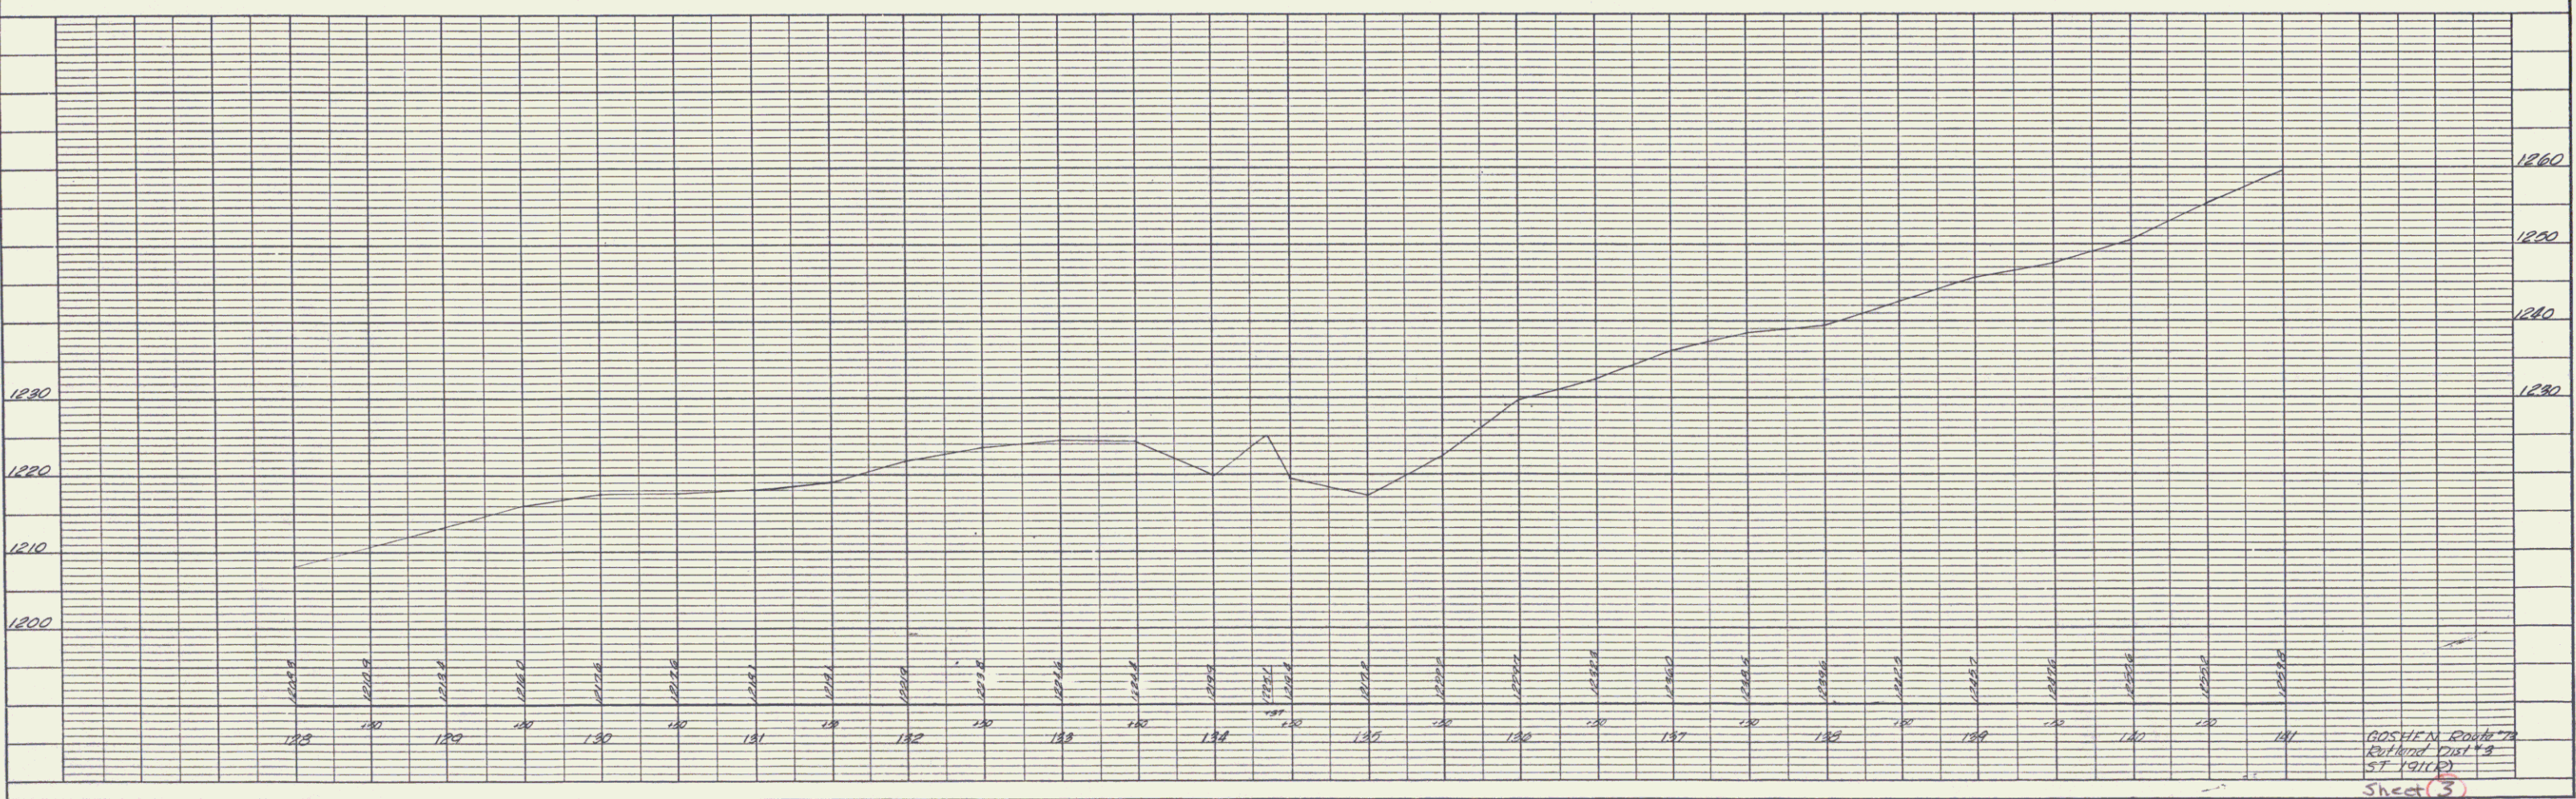

GOSHEN ROAD  
 ROUTE DIST 13  
 ST. 1471.10  
 Sheet 3

DATE: \_\_\_\_\_ BY: \_\_\_\_\_  
 SURVEYED: \_\_\_\_\_  
 NOTE BOOK: \_\_\_\_\_  
 ALIGNMENT CHECKED: \_\_\_\_\_  
 NO. OF WPT. CHECKED: \_\_\_\_\_  
 NO. OF WPT. CHECKED: \_\_\_\_\_

DATE: \_\_\_\_\_ BY: \_\_\_\_\_  
 SURVEYED: \_\_\_\_\_  
 NOTE BOOK: \_\_\_\_\_  
 ALIGNMENT CHECKED: \_\_\_\_\_  
 NO. OF WPT. CHECKED: \_\_\_\_\_  
 NO. OF WPT. CHECKED: \_\_\_\_\_




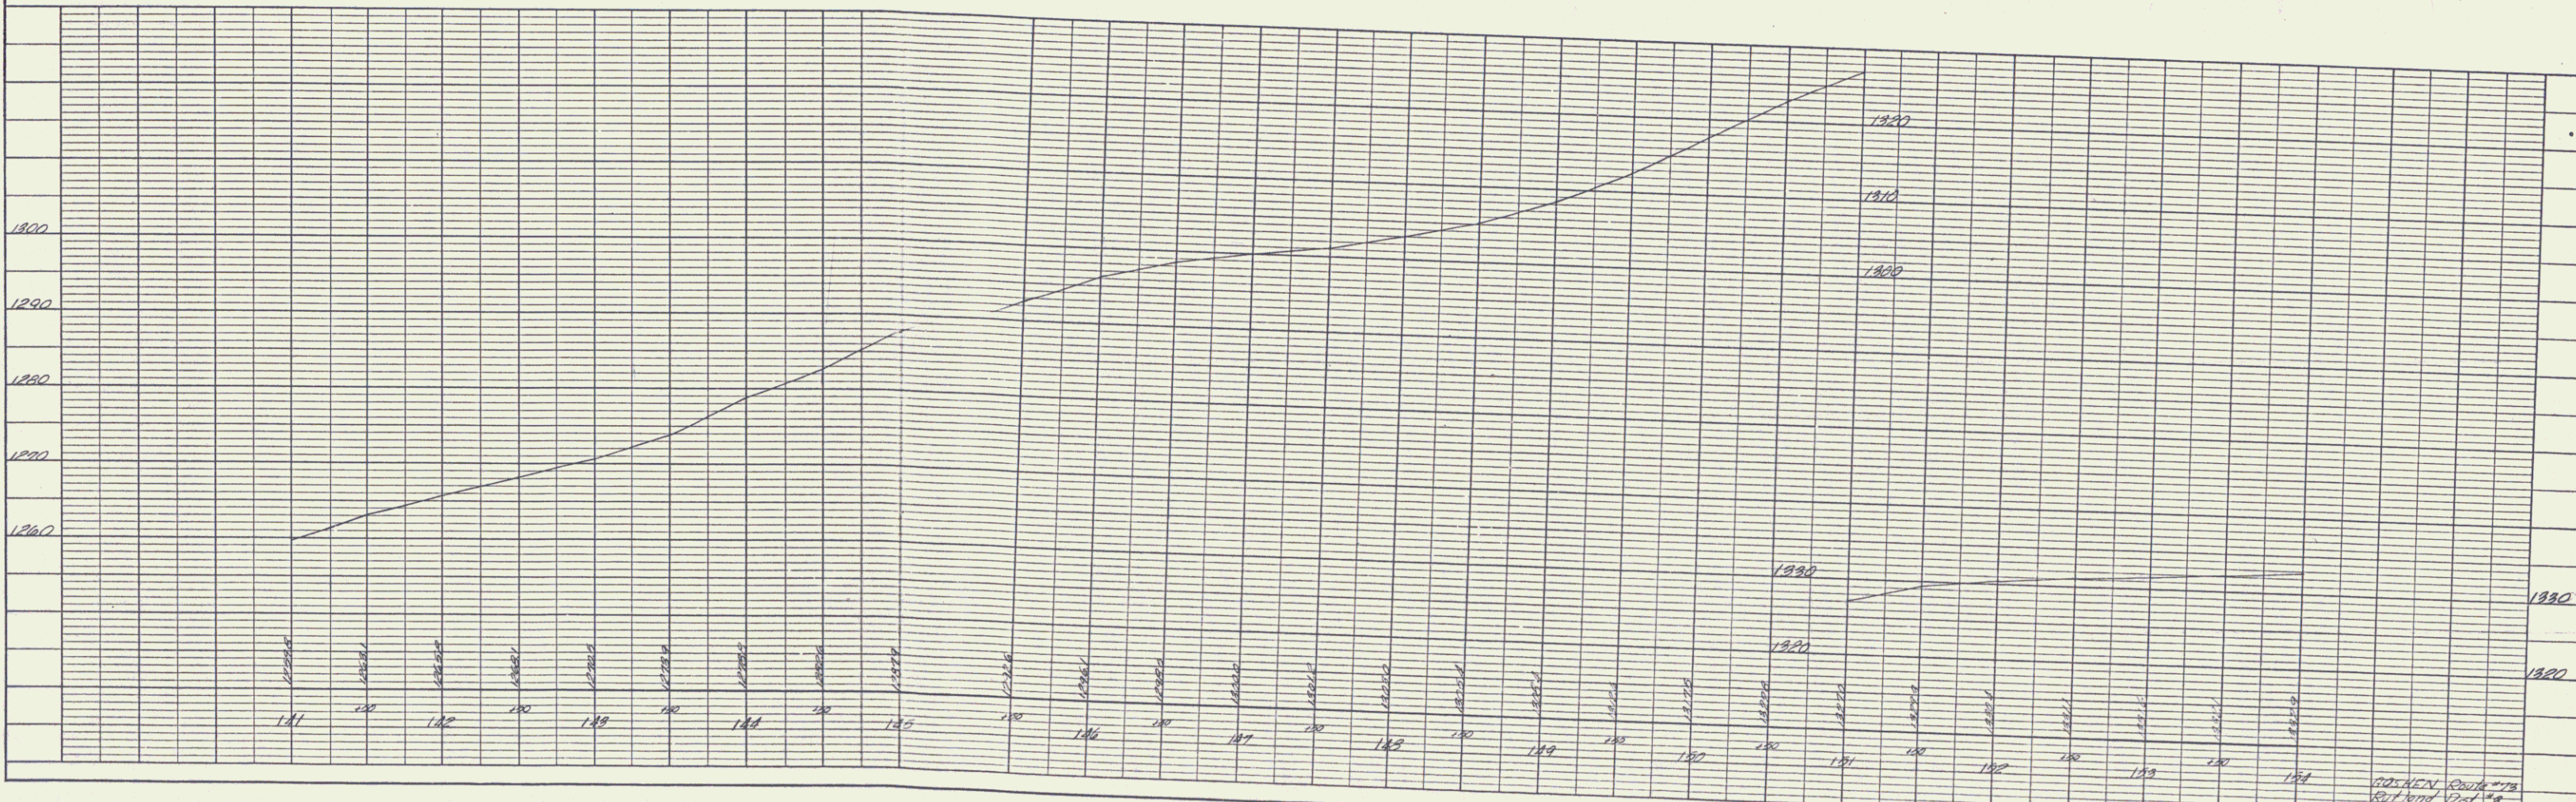


PLATE 1 - PLAN - PROFILE - D. R. R. & E. STANDARD  
 KRUFFEL & ESSER CO., NEW YORK  
 E & C. CO. NO. 345-1

GRADATION ROUTE 278  
 100' FROM DIST. 49  
 ST. 11100  
 Sheet 4

PLAN  
 DATE: 3/22/23  
 BY: L. M. M. / J. C. C.  
 CHECKED: J. C. C.  
 DRAWN: J. C. C.  
 NO. 1

PROFILE  
 DATE: 12/27/22  
 BY: J. M. M. / J. M. M.  
 CHECKED: J. M. M.  
 DRAWN: J. M. M.  
 NO. 1

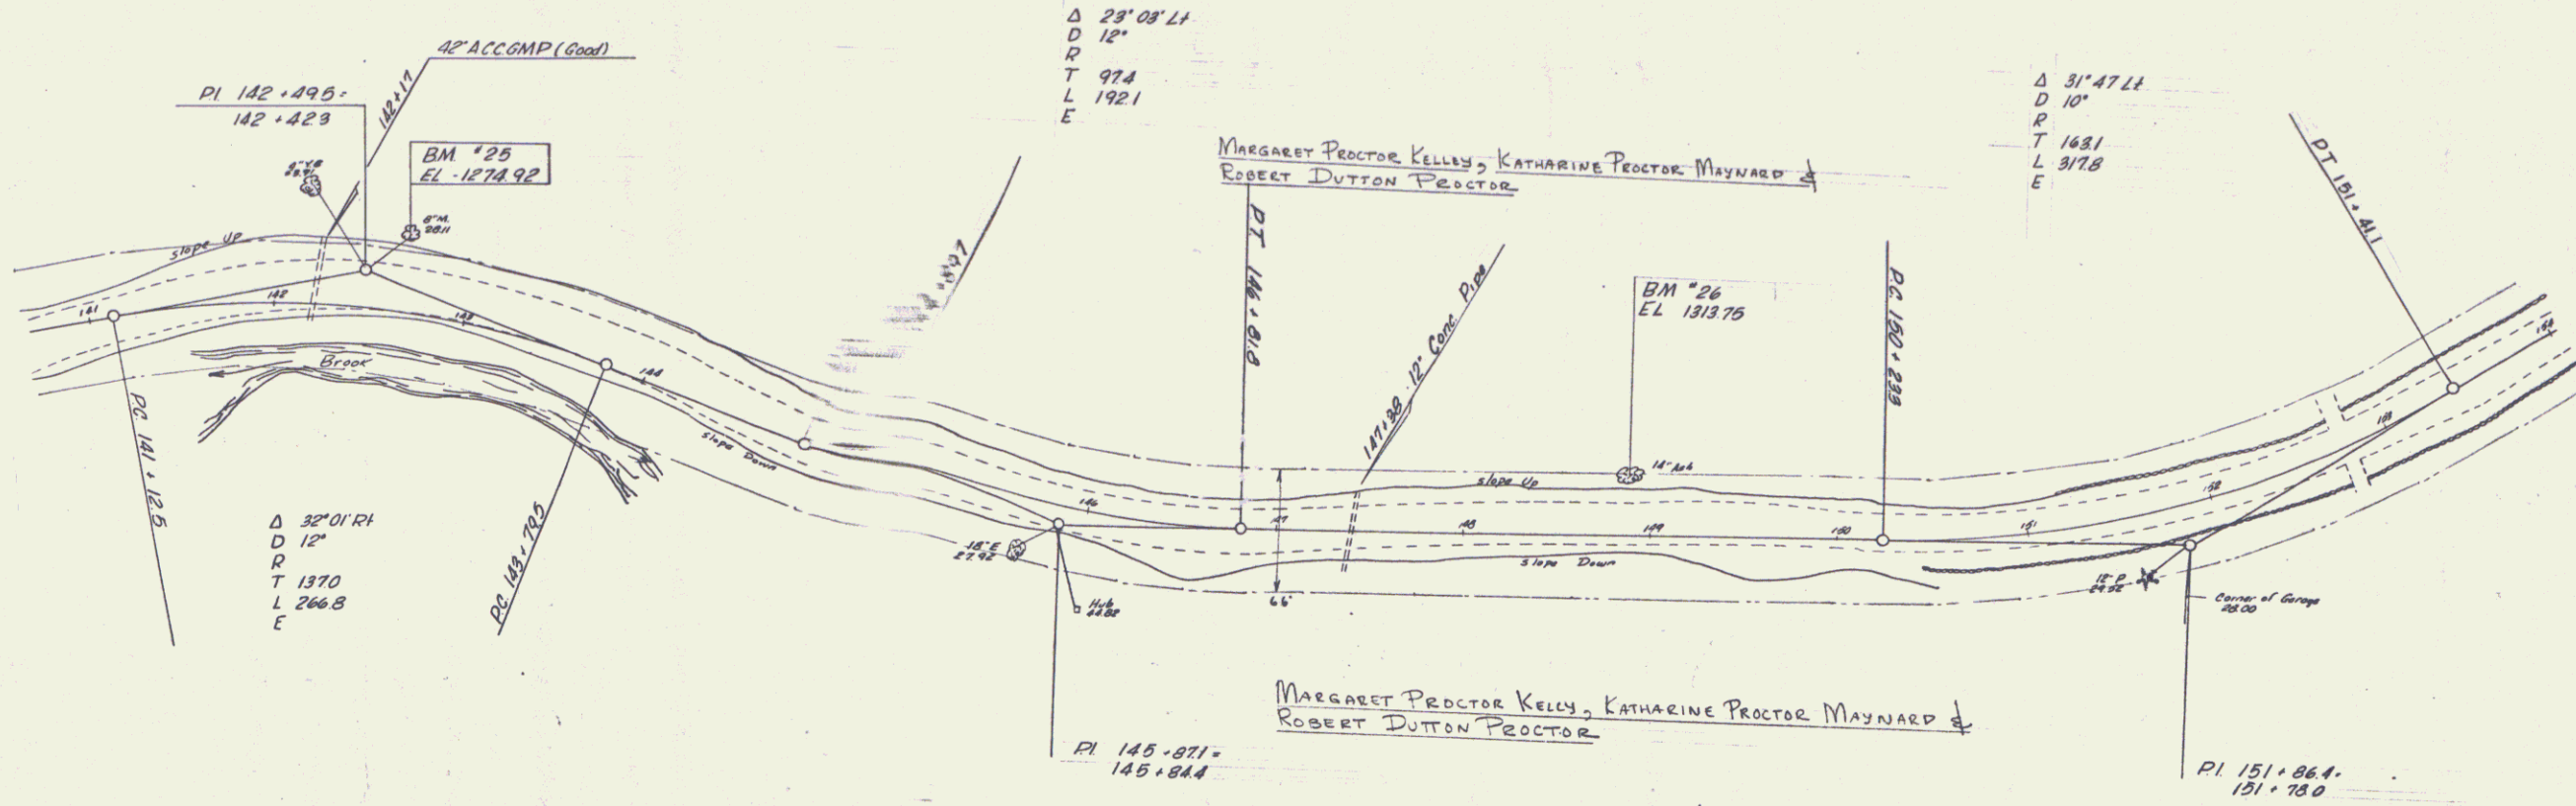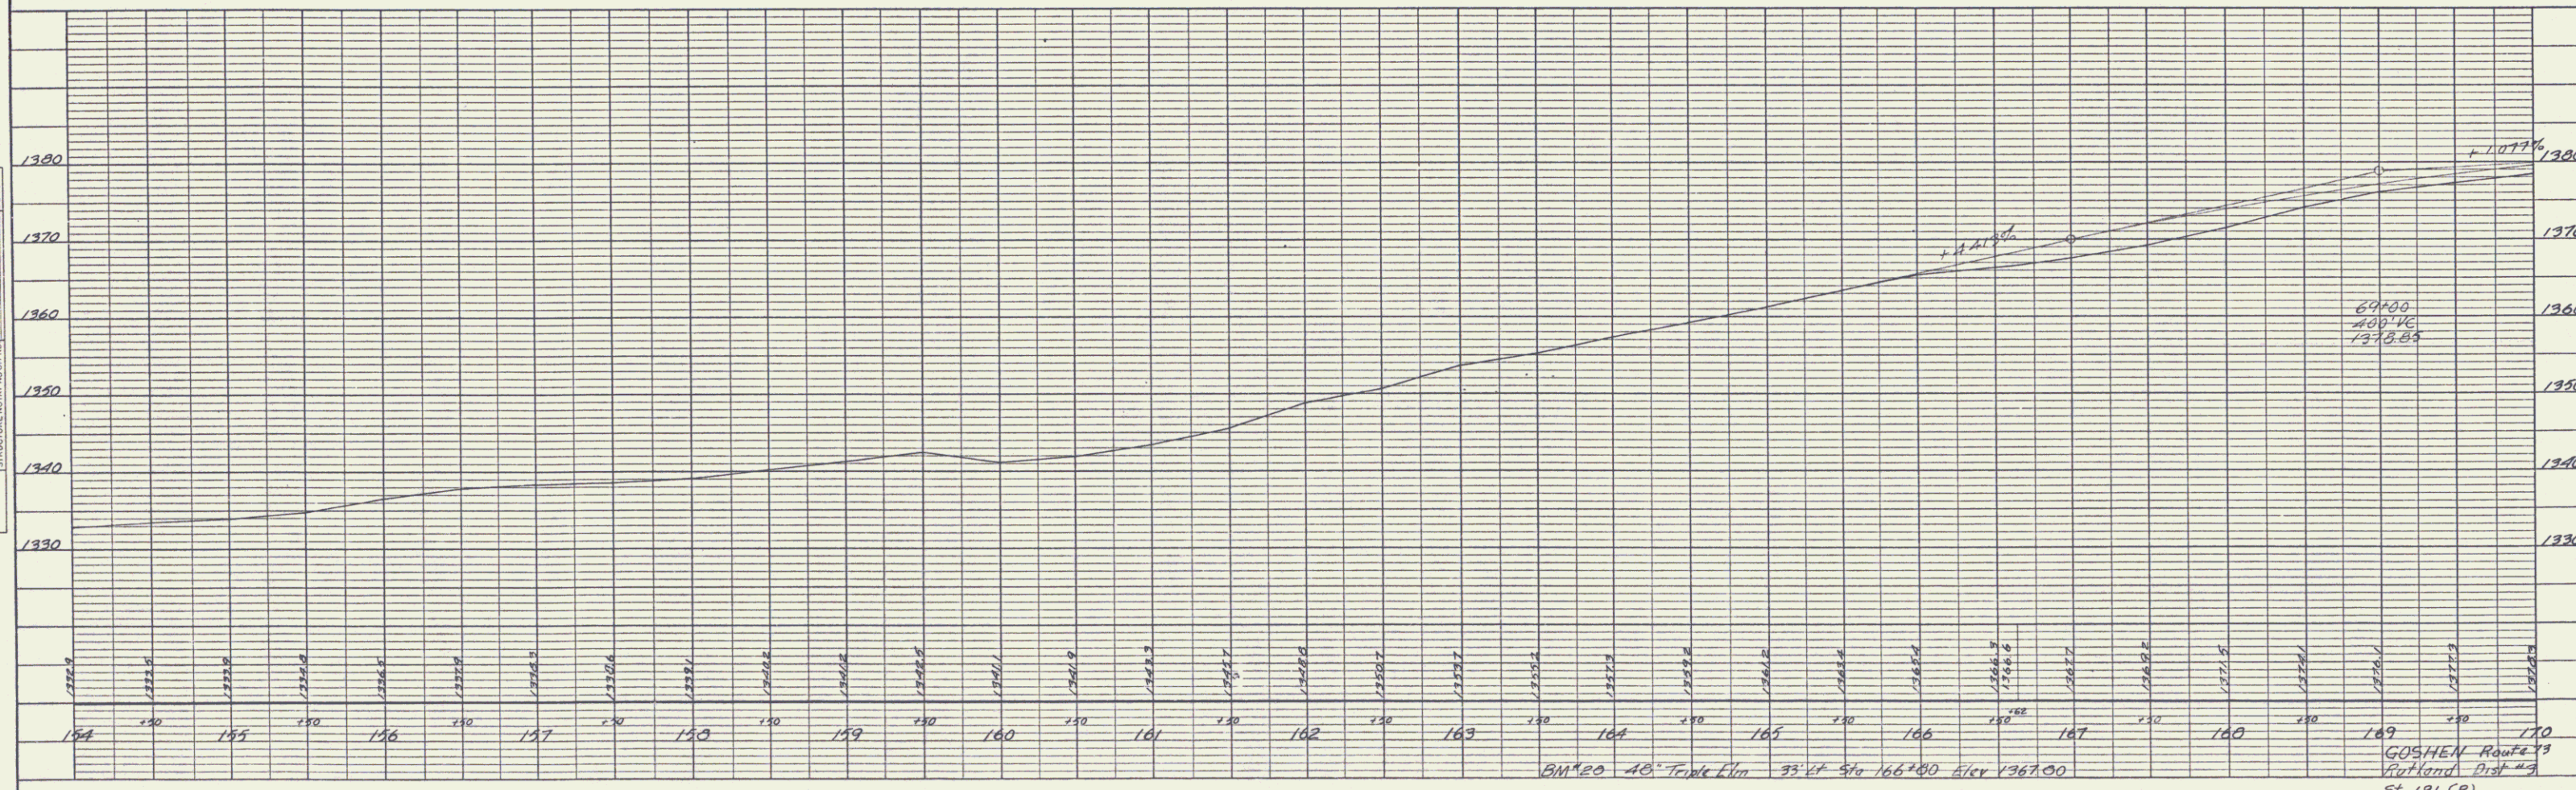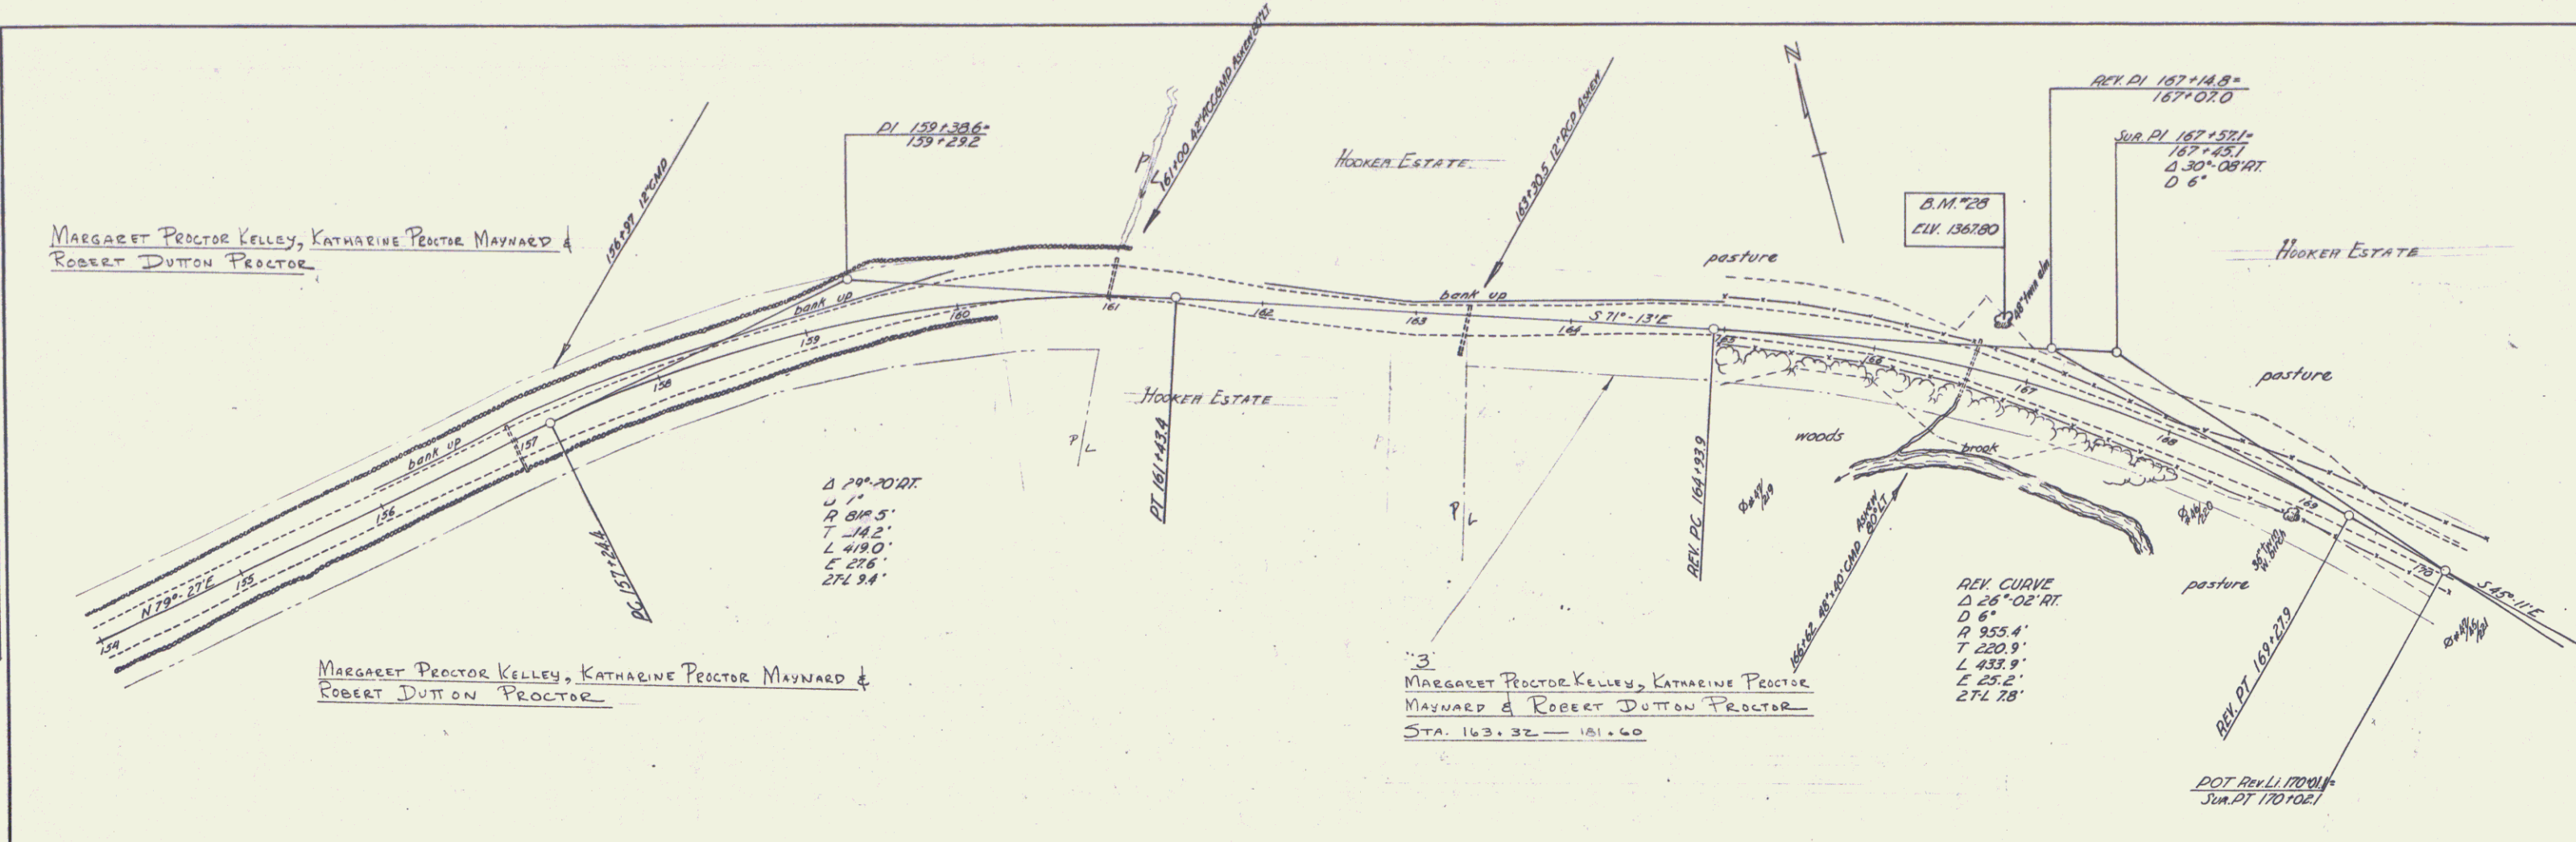

PLAN  
 SURVEYED BY  
 DATE  
 NOTE BOOK NO.  
 ALIGNMENT CHECKED BY  
 DATE  
 NO. OF WAYS CHECKED

PROFILE  
 SURVEYED BY  
 DATE  
 NOTE BOOK NO.  
 GRADES CHECKED BY  
 DATE  
 NO. OF POINTS CHECKED




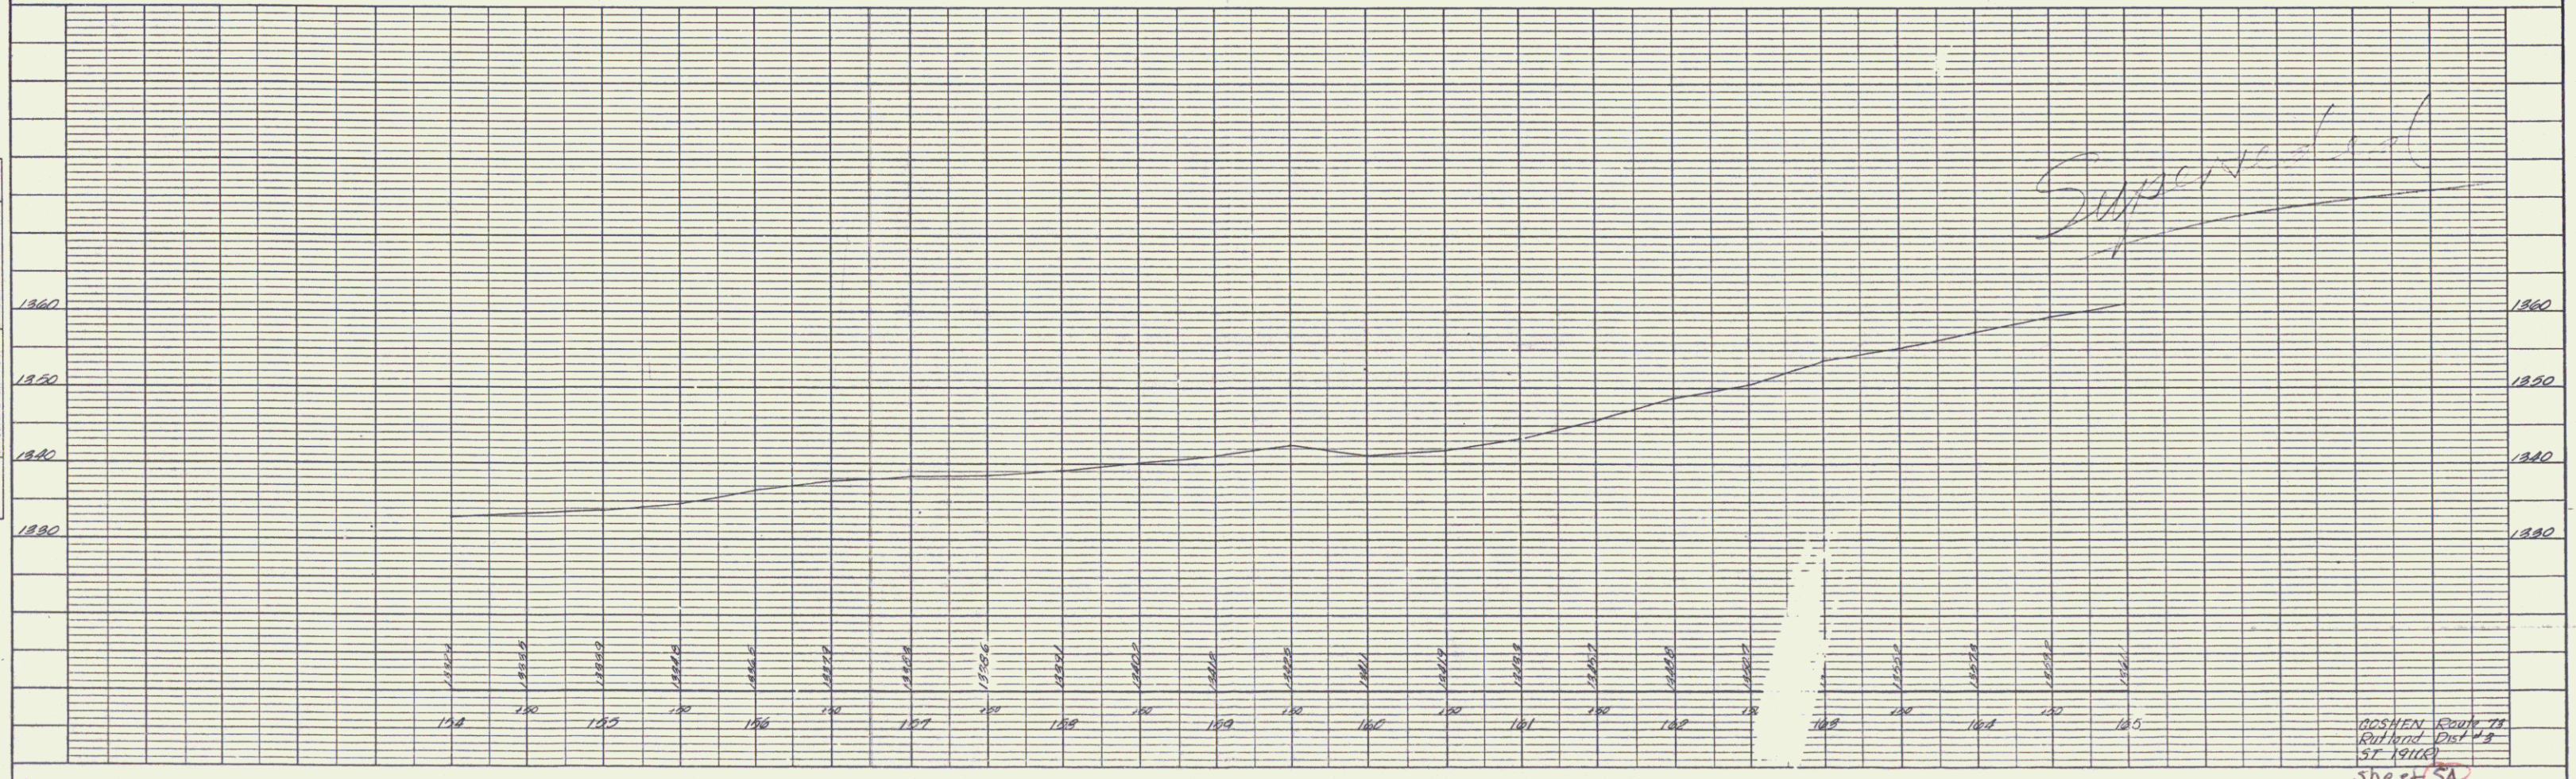


PLATE 1 - PLAN - PROFILE O.P.A.R. & STANDARD  
 REUFEL & OBER CO., NEW YORK  
 E & O CO. NO. 345-1

GOSHEN ROAD TO  
 KRIEGER DIST # 2  
 37-19143  
 Sheet SA

DATE: \_\_\_\_\_ BY: \_\_\_\_\_  
 PLAN  
 SURVEYED: \_\_\_\_\_  
 ALIGNED: \_\_\_\_\_  
 CHECKED: \_\_\_\_\_  
 NO. OF WPT. CHECKED: \_\_\_\_\_  
 NO. \_\_\_\_\_

DATE: \_\_\_\_\_ BY: \_\_\_\_\_  
 PROFILE  
 SURVEYED: \_\_\_\_\_  
 GRADES CHECKED: \_\_\_\_\_  
 NO. OF STRUCTIONS NOT RECORDED: \_\_\_\_\_  
 NO. \_\_\_\_\_

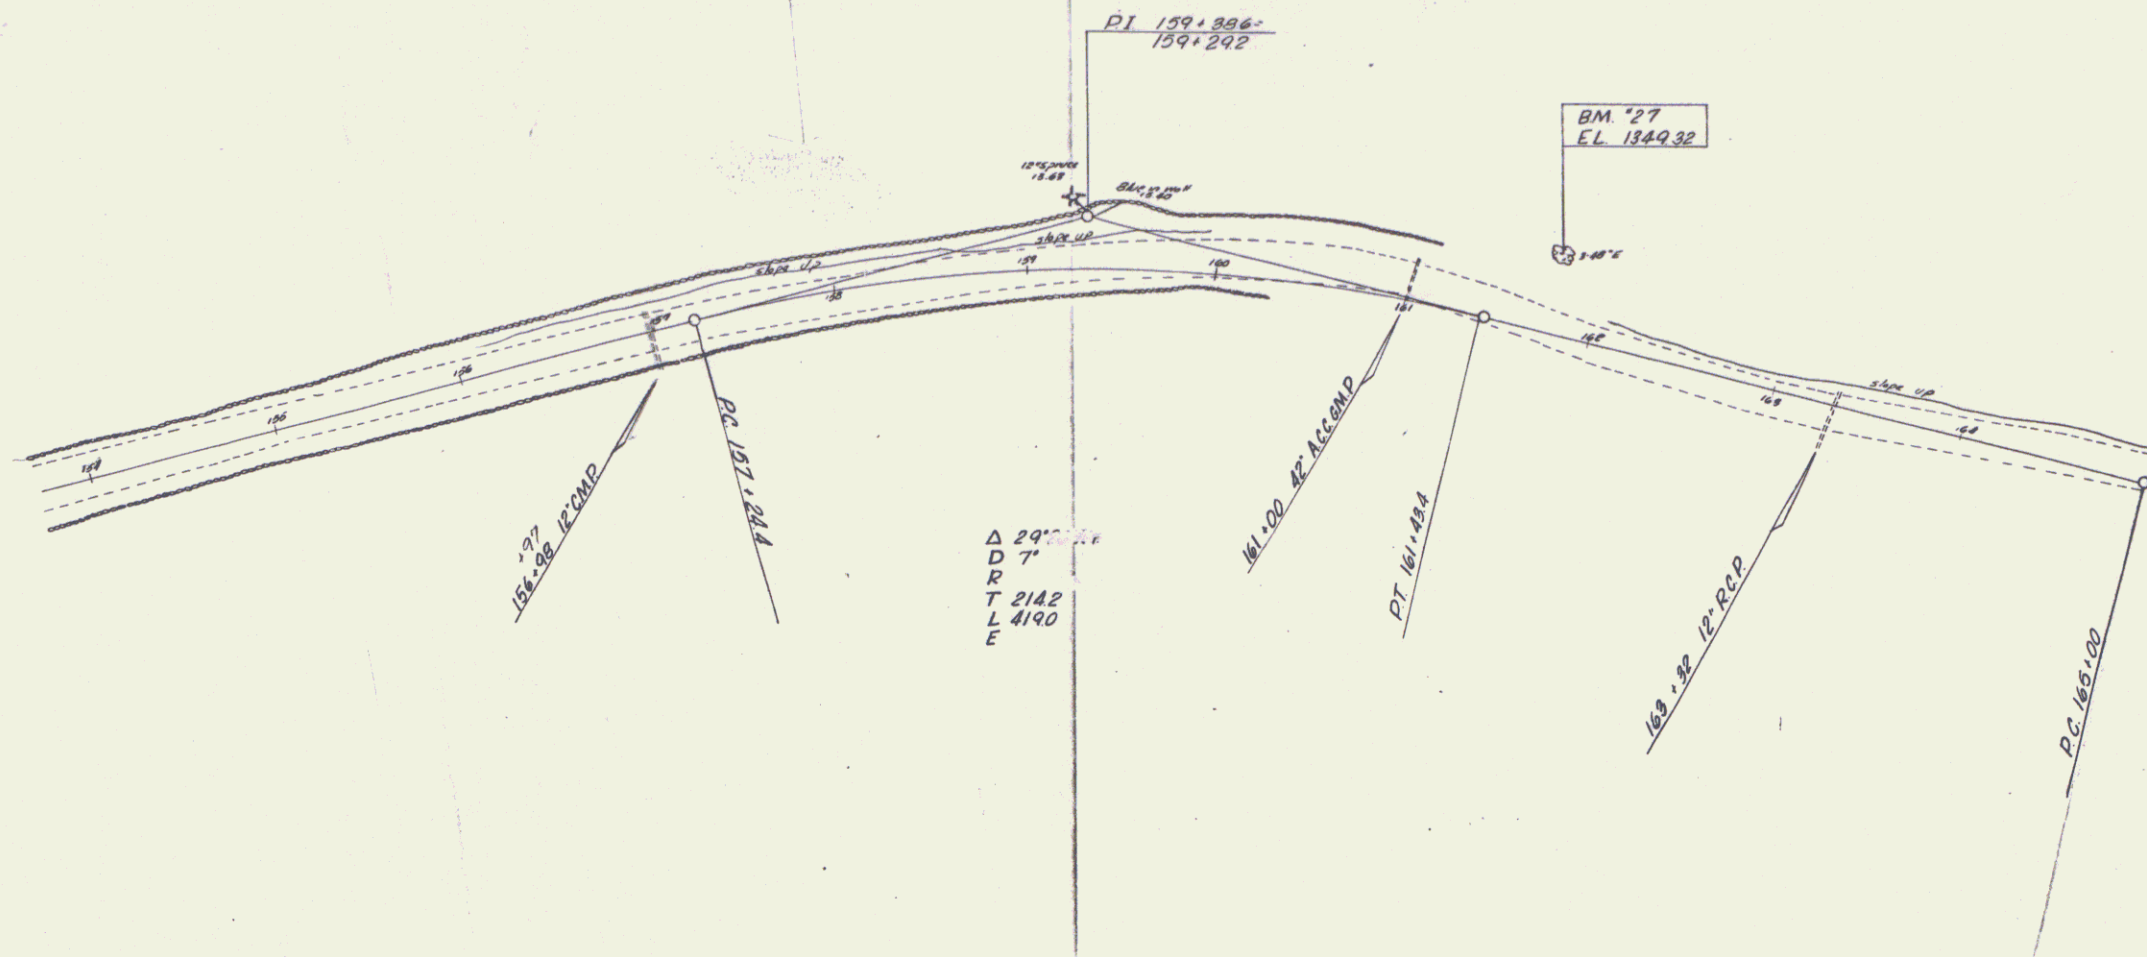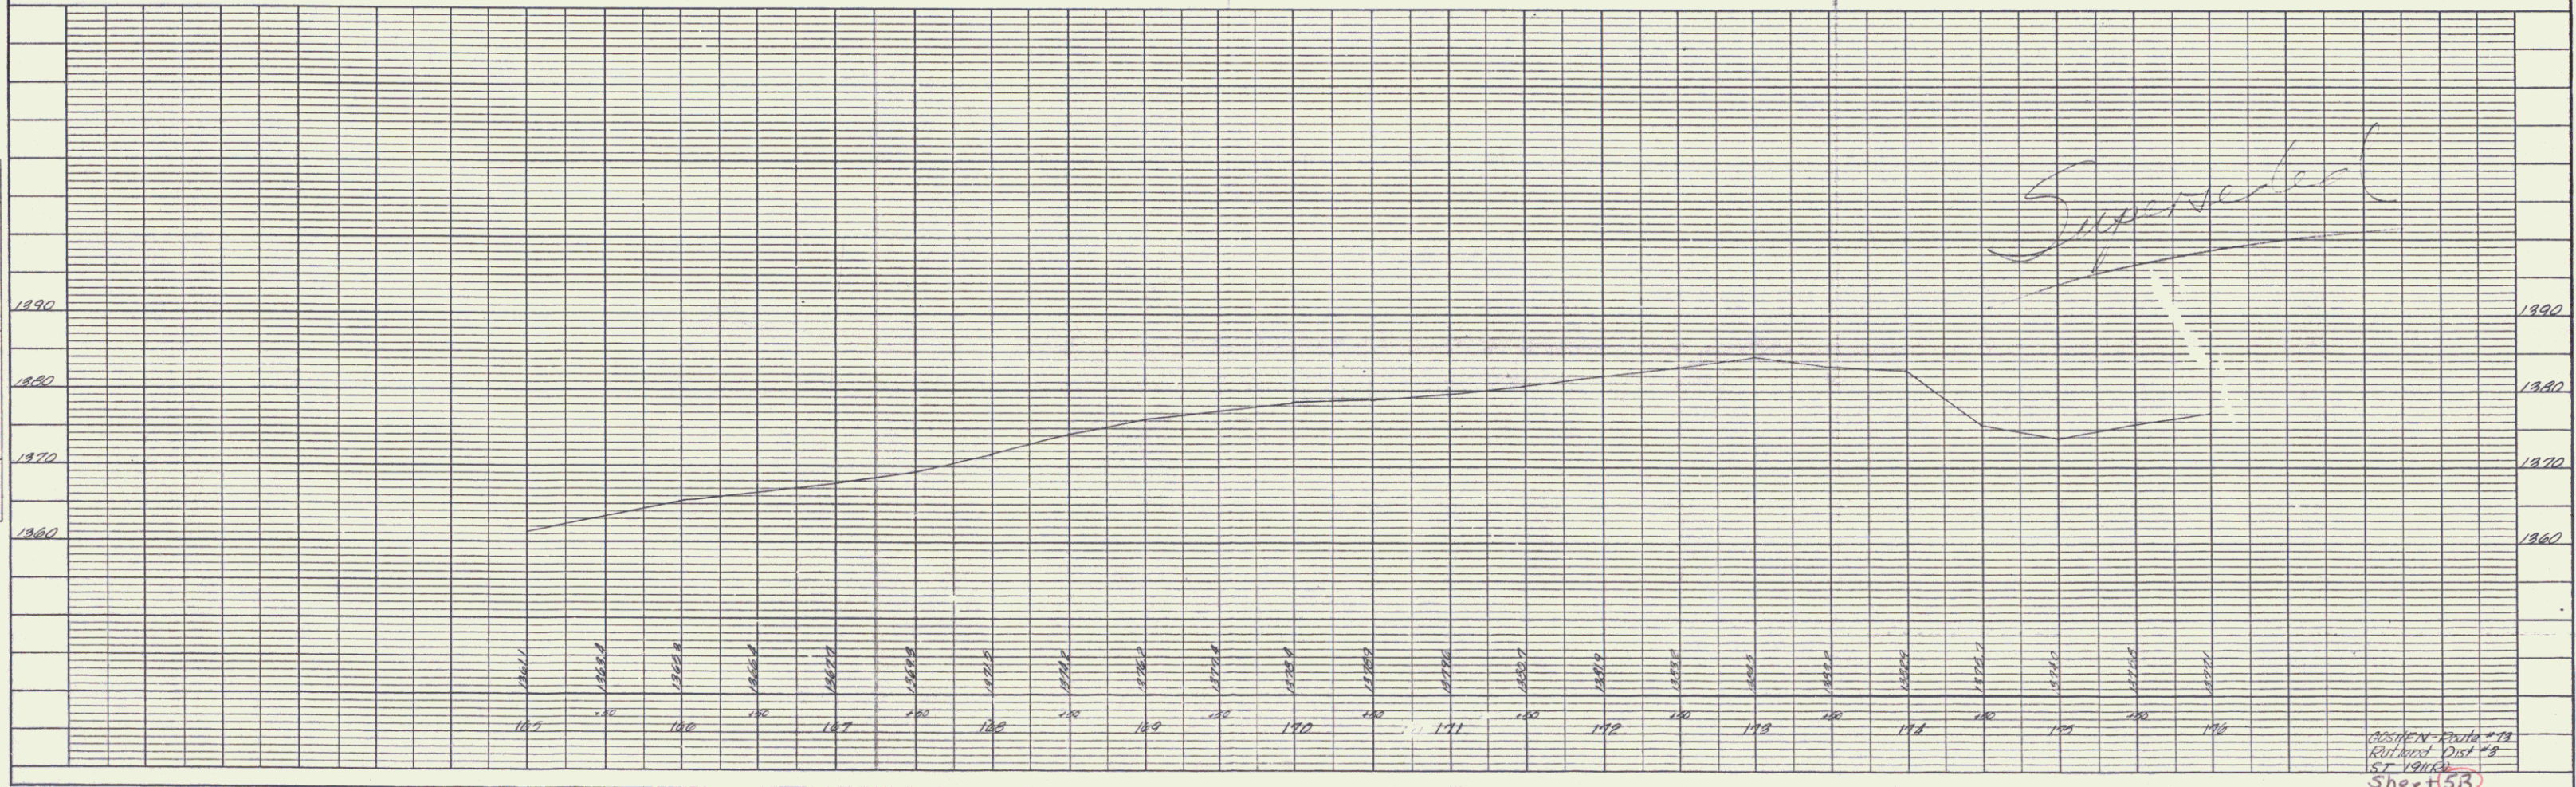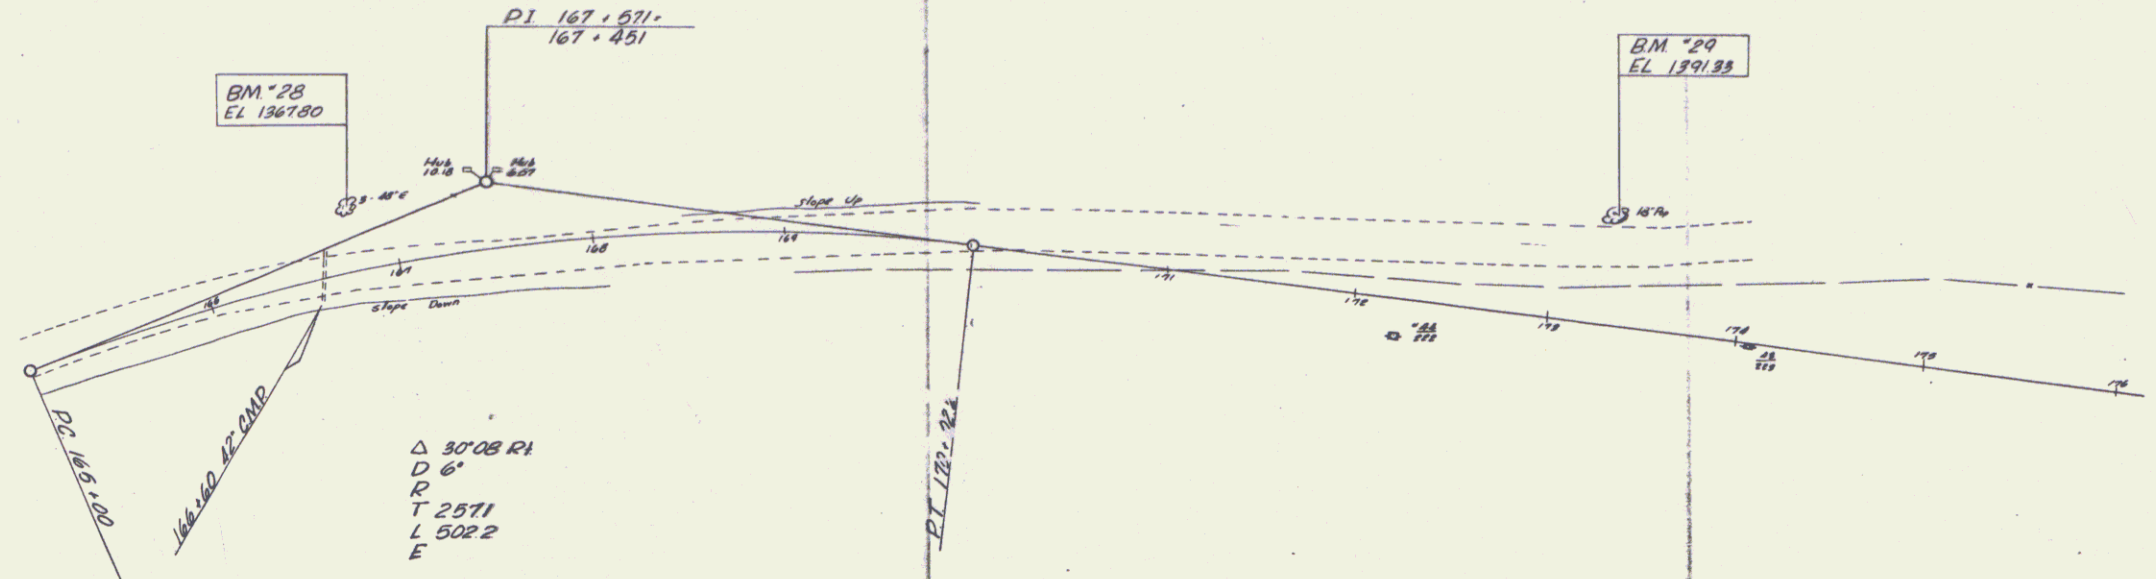

CUSTOMER BOOK # 78  
 REVISION DIST # 8  
 ST. 1906  
 Sheet 5B

DATE: 12-27-27  
 BY: L. H. CONLEY  
 CHECKED: M. H. H. H.  
 NO. OF WAYS CHECKED: 1

DATE: 12-27-27  
 BY: M. H. H. H.  
 CHECKED: M. H. H. H.  
 NO. OF WAYS CHECKED: 1


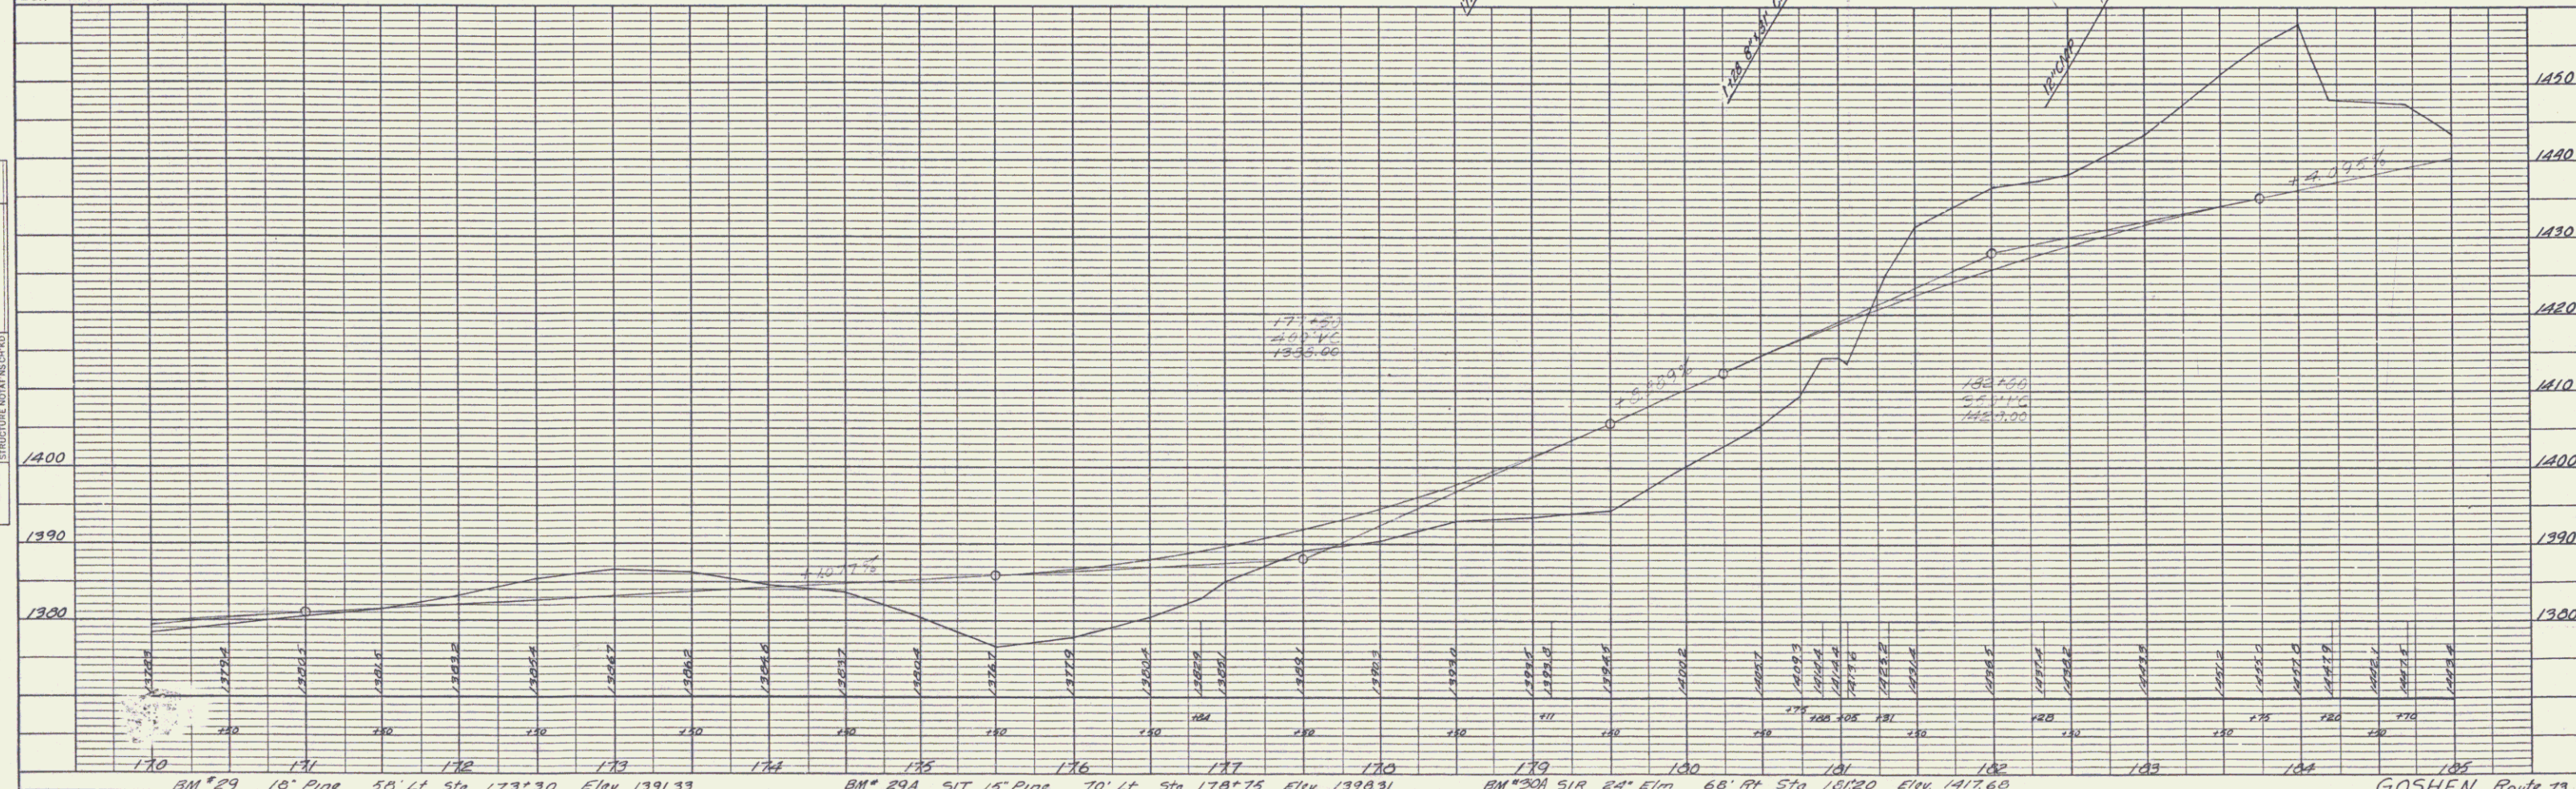




PLATE 1 - PLAN - PROFILE G. P. A. & E. STANDARD  
 KEUFFEL & ESSER CO., NEW YORK  
 E & E CO. NO. 345-1  
 GOSHEN Route 73  
 Rutland Dist #3  
 ST 191 (A)  
 Sneezer (6)



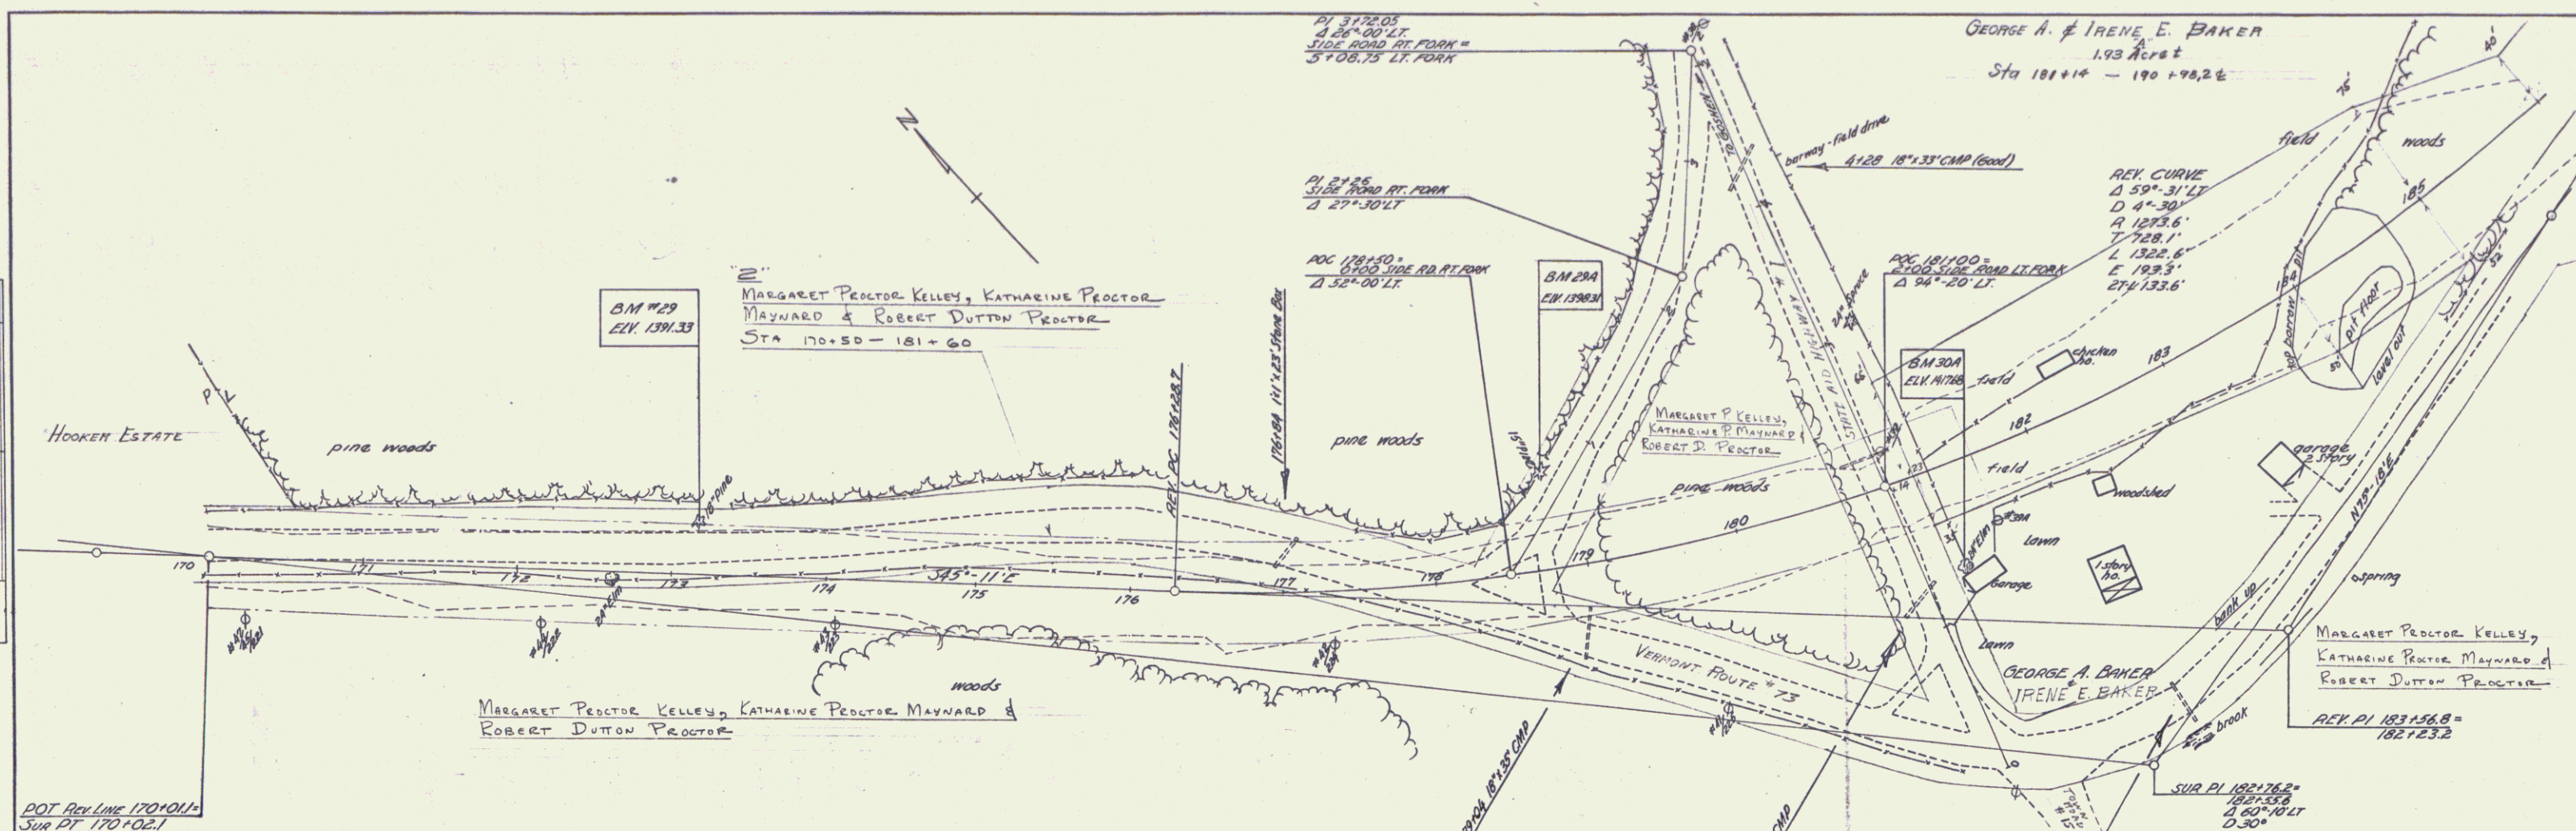

PLAN  
 SUBMITTED BY  
 PLOTTED BY  
 CHECKED BY  
 DATE



PROFILE  
 SUBMITTED BY  
 PLOTTED BY  
 CHECKED BY  
 DATE

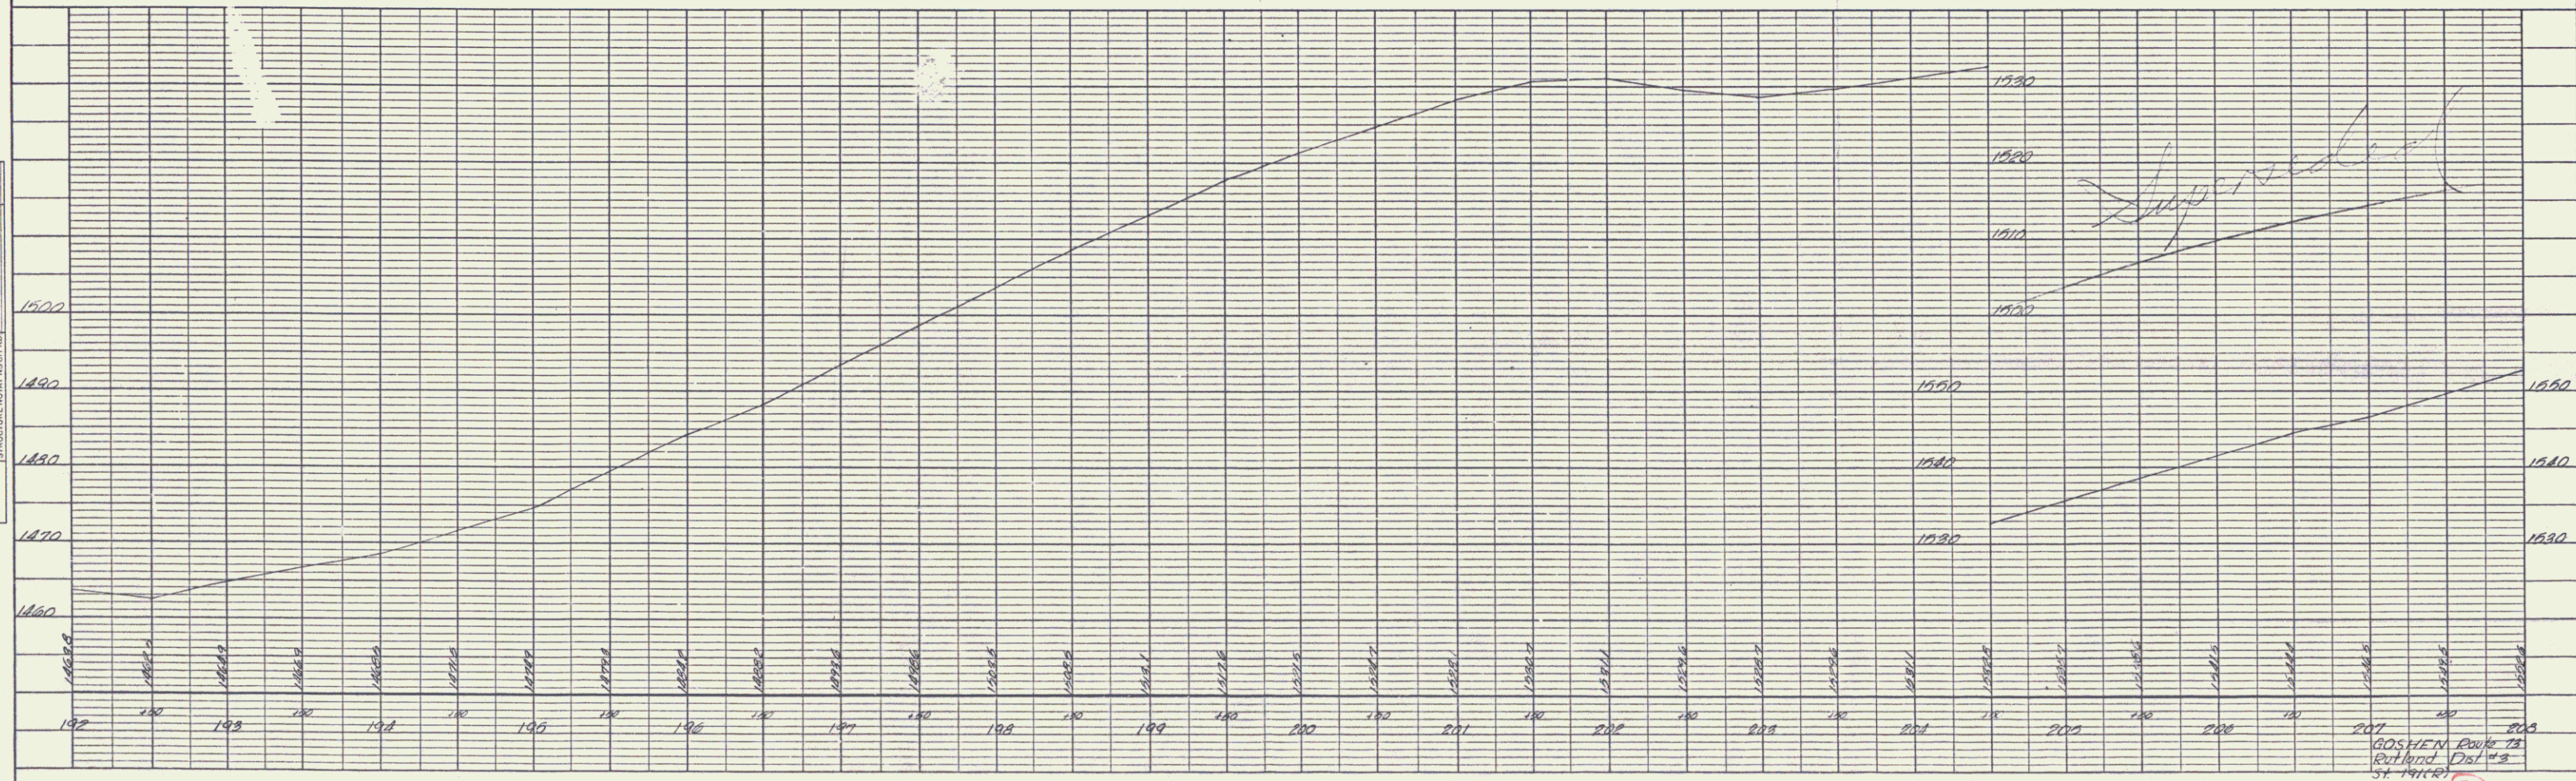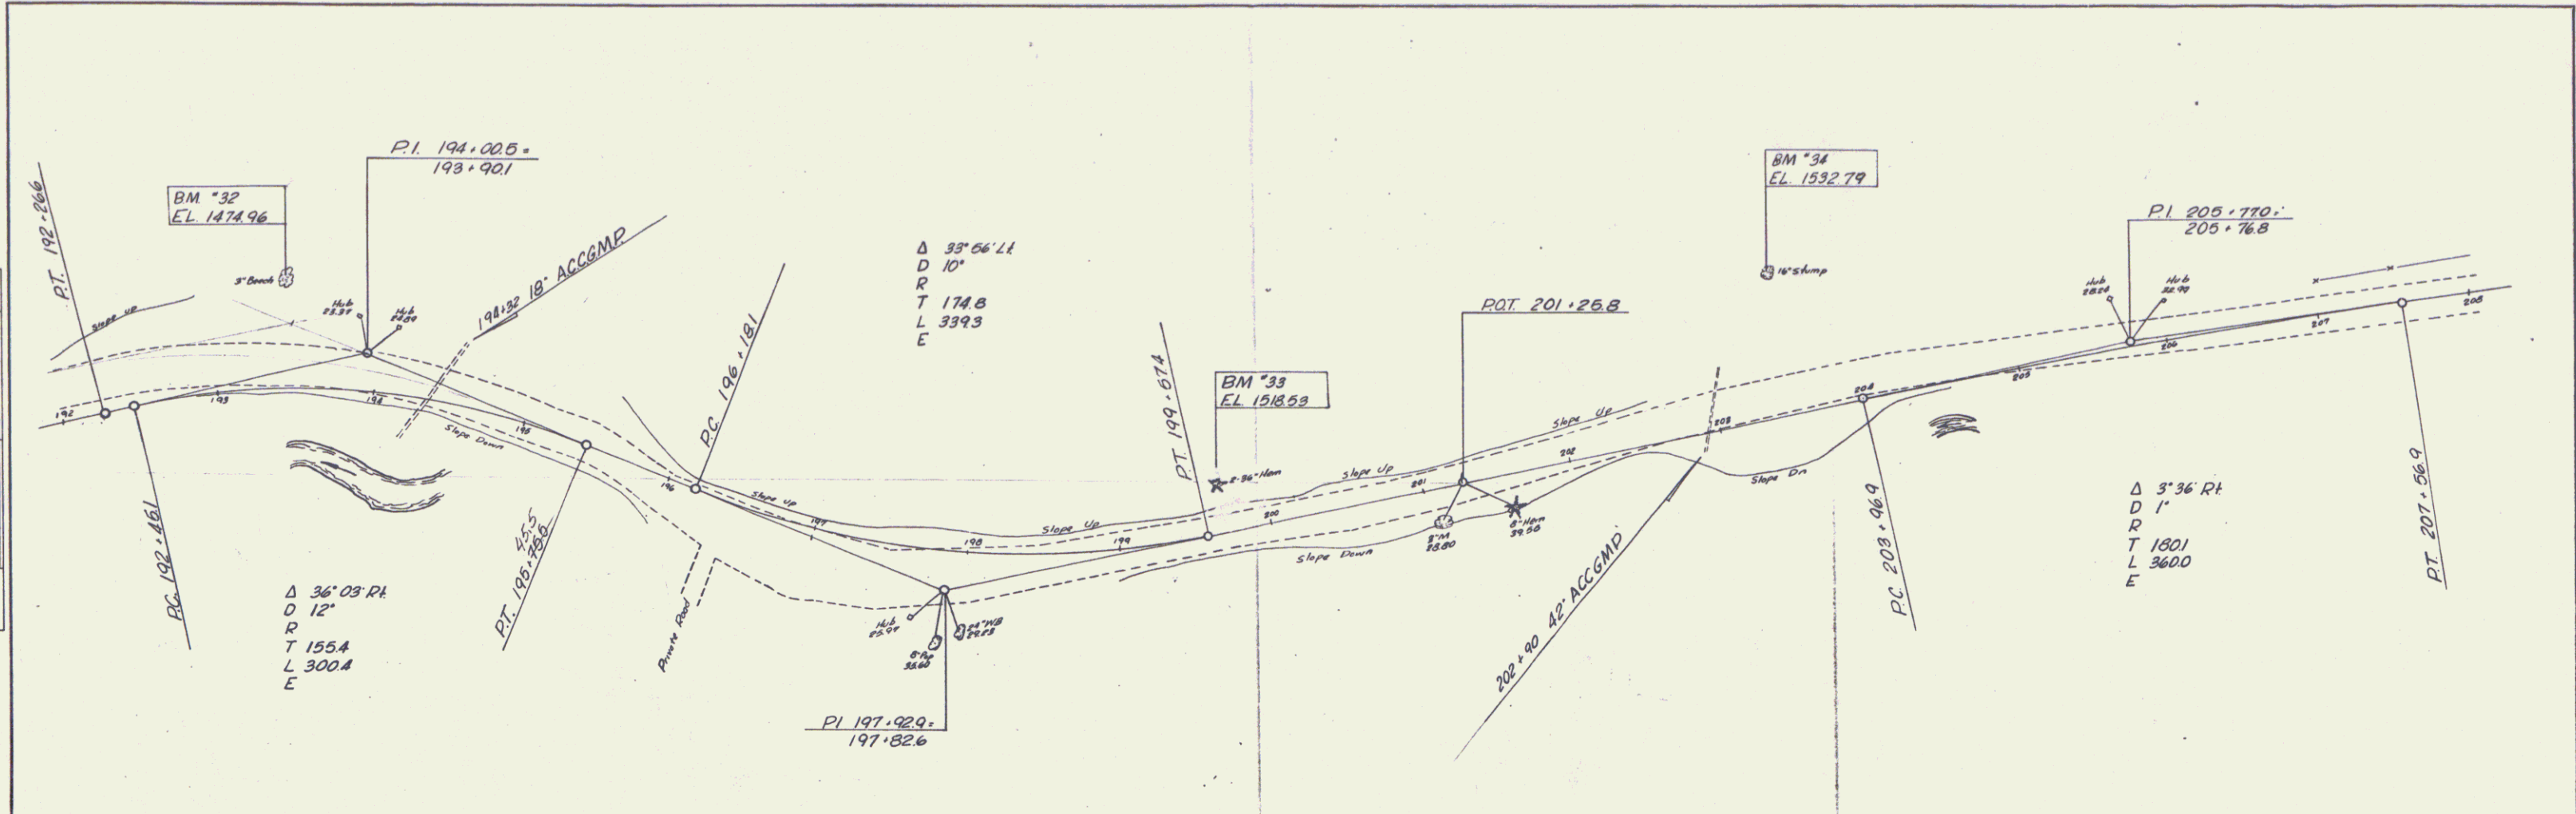

GOSHEN ROUTE 72  
 Putland Dist  
 NY STATE  
 Sheet 7A

DATE: 12/22/1925  
 BY: L. COMBES  
 DRAWN BY: L. COMBES  
 CHECKED BY: L. COMBES  
 NO. 1

DATE: 12-23-25  
 BY: WM  
 CHECKED BY: WM  
 NO. 1

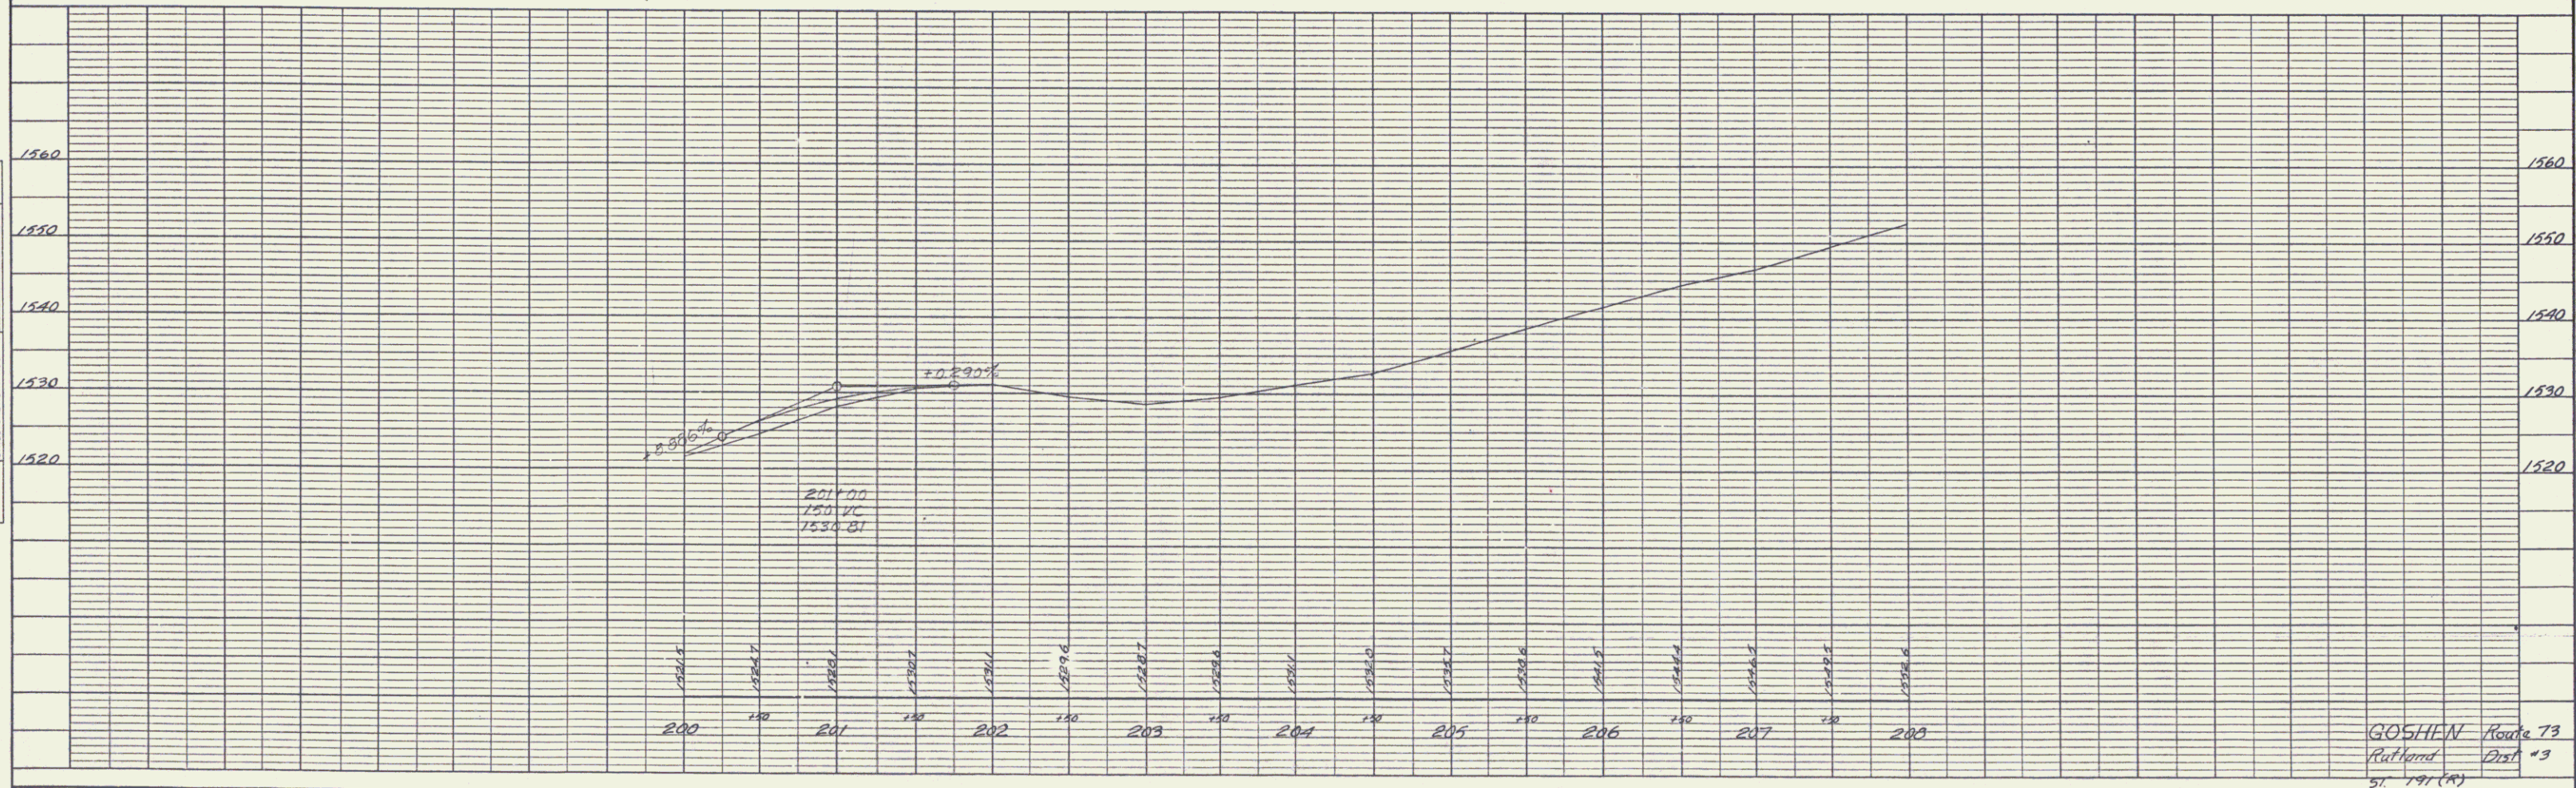
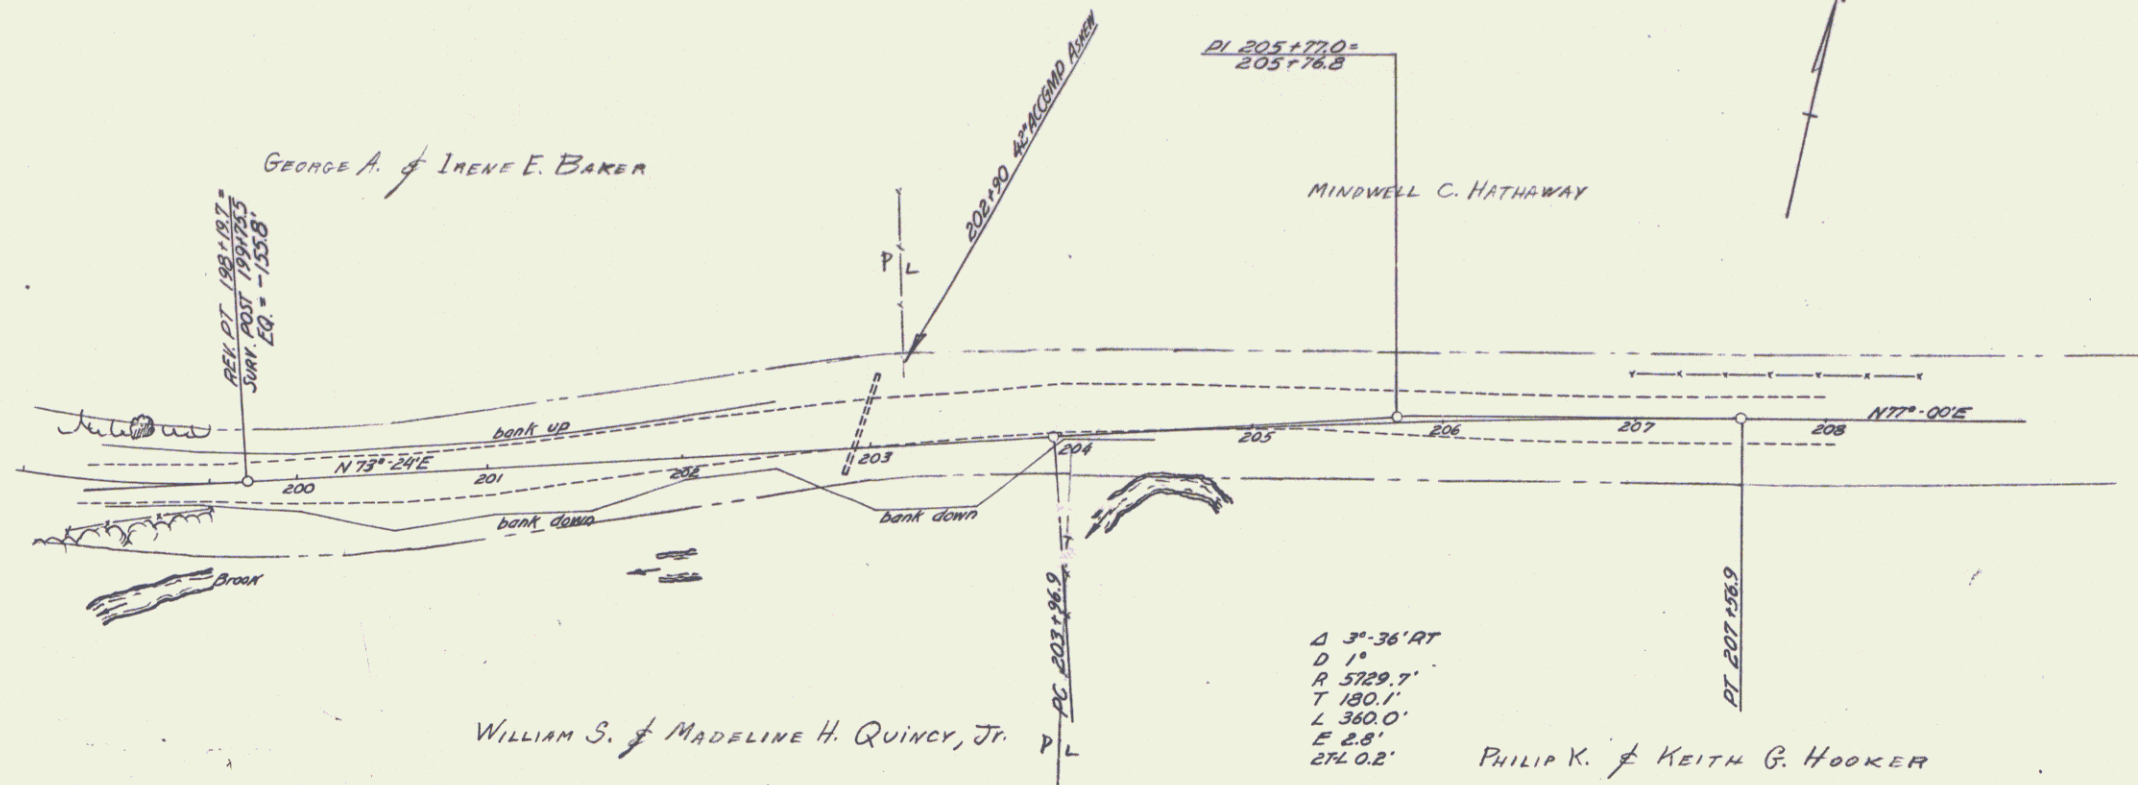


GOSHEN Route 73  
 Rutland Dist. #3  
 51-191 (A)  
 Sheet 3

PLATE 1 - PLAN, PROFILE, D.P.R. & E. STANDARD  
 KEIFFEL & ESSER CO., NEW YORK.  
 K & E CO. NO. 345-1

PLAN	
DESIGNED BY	DATE
PLANNED BY	BY
NOTED BY	CHECKED BY
DATE	DATE
NOTED BY	
DATE	
STRUCTURE NOT NOTED BY	
DATE	

PROFILE	
DESIGNED BY	DATE
PLANNED BY	BY
NOTED BY	CHECKED BY
DATE	DATE
NOTED BY	
DATE	
STRUCTURE NOT NOTED BY	
DATE	

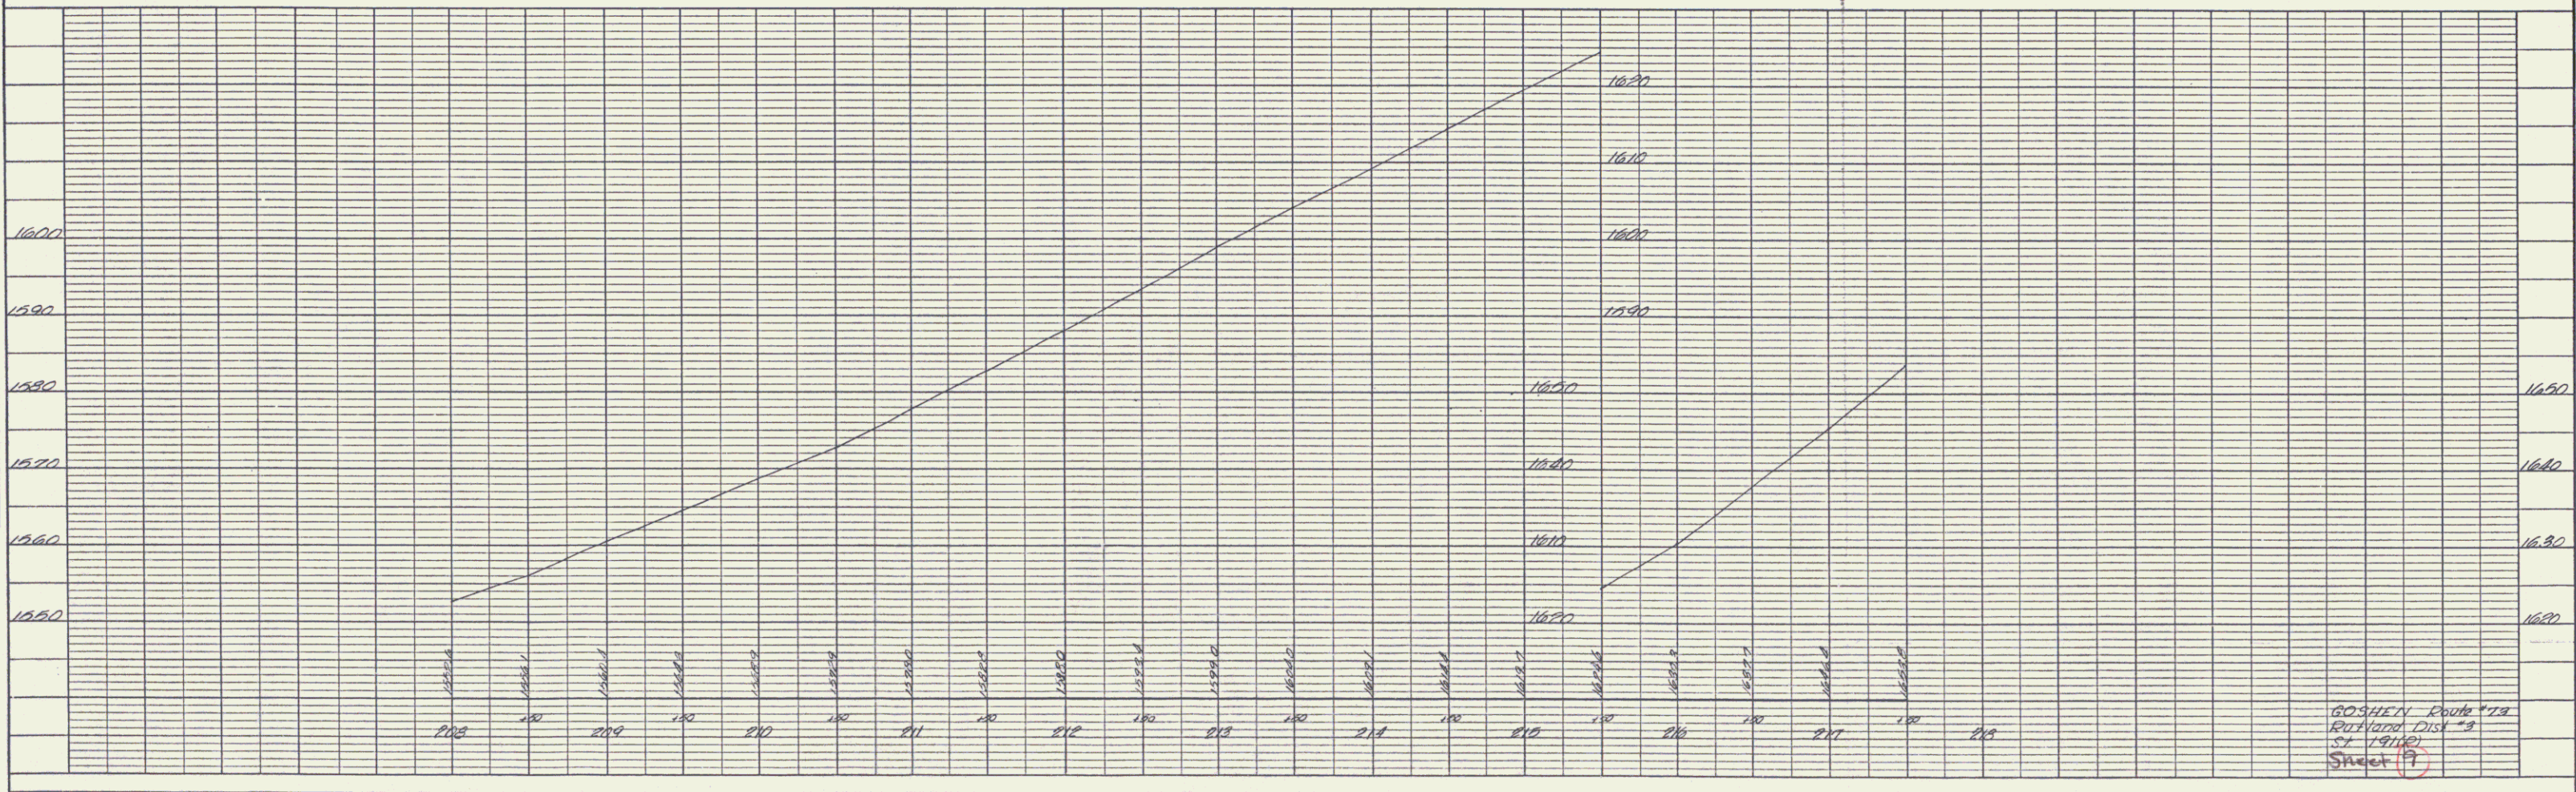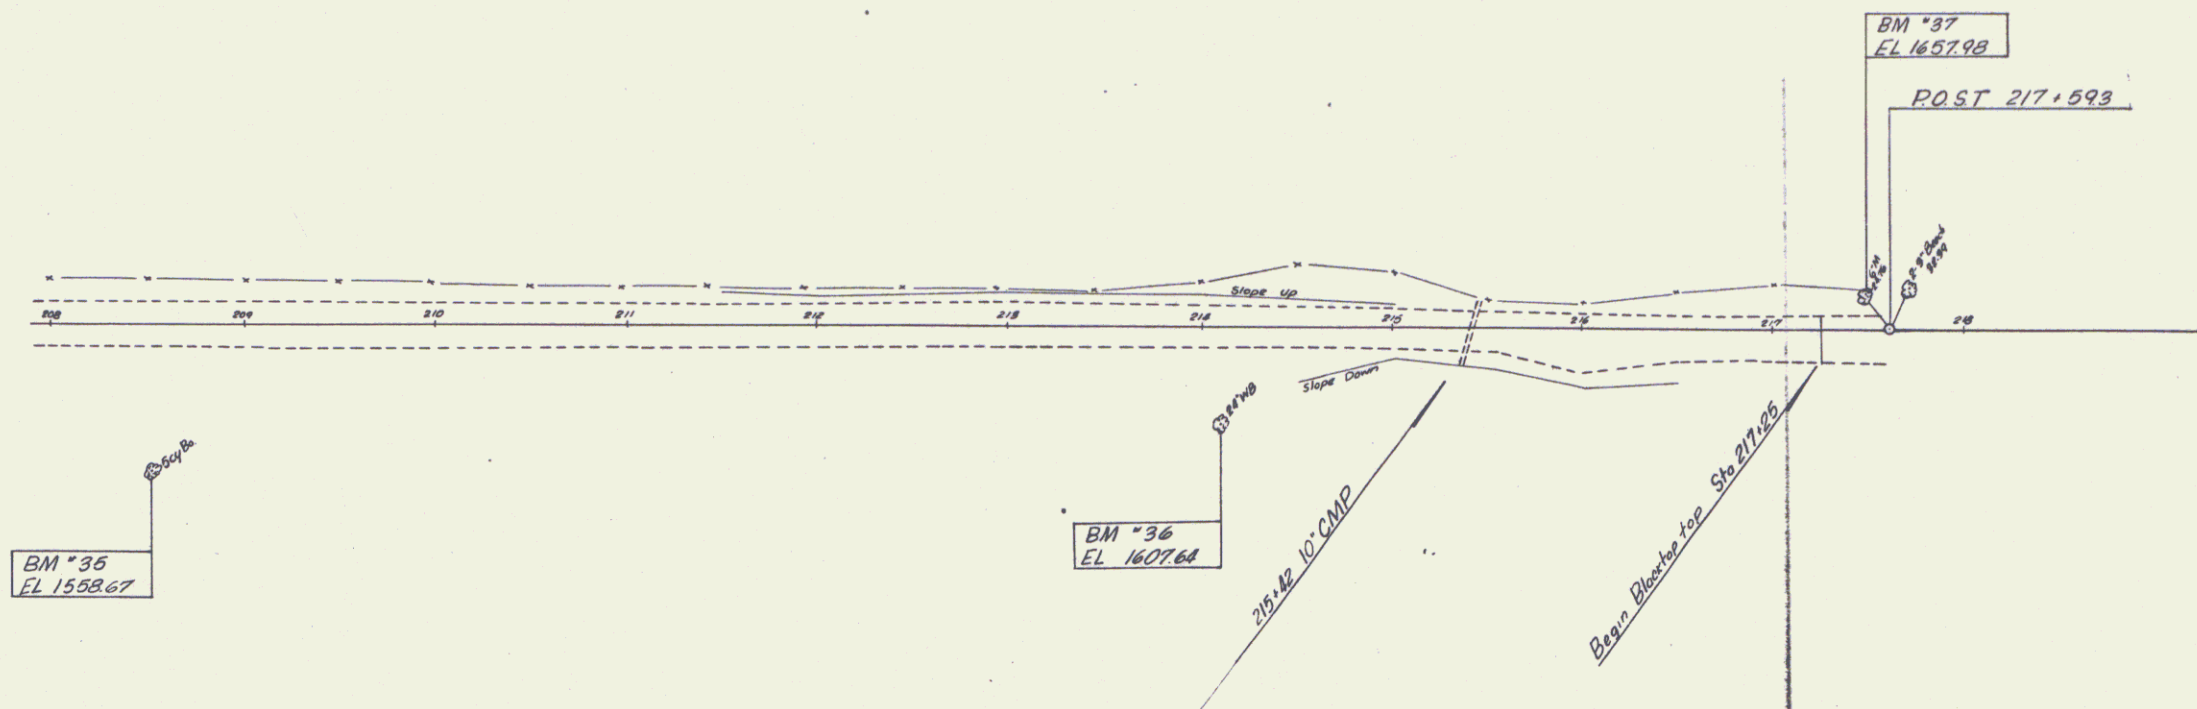

GOSHEN Route 119  
 Putnam Dist. N.Y.  
 Sta. 1598.67  
 Sheet 17

PLATE 1 - PLAN - PROFILE O. R. & R. E. STANDARD  
 KEUFFEL & ESSER CO., NEW YORK.  
 K & E CO. NO. 348-1